LUMINAIRE SCHEDULE														
SYMBOL	QTY	LABEL		ARRANGEMENT	LUMENS	LLF	DIM SETTING	ARR. WATTS	TOTAL WATTS	MANUFACTURE	DESCRIPTION			
	24	C5		Single	1720	1.030	1.000	14.107	338.575	Lithonia Lighting	RCNY LED ALO1 50K 70CRI ASYC MVOLT BZS XXXXX			
	1	E1		Single	14011	1.030	0.850	106.51	106.51	Lithonia Lighting	RSX1 LED P4 50K R3 MVOLT SPA FAO EGS XXXXX (DIM SETTINGS 6)			
	2	Q1		Single	14097	1.030	0.850	106.51	213.02	Lithonia Lighting	RSX1 LED P4 50K R4 MVOLT SPA FAO EGS XXXXX (DIM SETTINGS 6)			
	4	Q2D		2 @ 180°	14097	1.030	0.610	143.78	575.12	Lithonia Lighting	RSX1 LED P4 50K R4 MVOLT SPA FAO EGS XXXXX (DIM SETTINGS 4)			
	7	S1		Single	5546	1.030	1.000	37.48	262.36	Lithonia Lighting	SCNY LED ALO2 SWW2 PFL MVOLT DWHXD M3 (SETTING 2, CCT: 5000K) + PCNYDT XXXXX J12			
	8	W1		Single	6200	1.030	1.000	46.93	375.44	Lithonia Lighting	WPX2 LED 50K MVOLT XXXXX			

FOOTCANDLES LEVELS CALCULATED AT GRADE USING INITIAL LUMEN VALUES											
	LABEL	AVG	MAX	MIN	AVG/MIN	MAX/MIN					
	GAS CANOPY	5.84	8	2	2.92	4.00					
	PAVED AREA	2.69	17.8	0.0	N.A.	N.A.					
	PROPERTY LINE	0.00	0.0	0.0	N.A.	N.A.					
	UNDEFINED	0.76	46.5	0.0	N.A.	N.A.					

ILLUMINATION LEVELS ARE THE RESULT OF CONDITIONS OR REQUESTS BY OTHERS RED LEONARD ASSOCIATES IS NOT RESPONSIBLE FOR INCIDENTS CAUSED BY INSUFFICIENT LIGHTING AND DOES NOT RECOMMEND THESE LEVELS FOR SECURITY AND SAFETY REASONS

- AREA LIGHT POLE MOUNTED FIXTURES ARE MOUNTED ON A 17FT POLE ATOP A 3FT CONCRETE BASE. - THIS SITE IS LOCATED IN A REGION WHERE LIGHTING IS REGULATED BY LOCAL ORDINANCES.

DESCRIPTION: FIXTURE TYPE "XSPLG" SEE SCHEDULE  DESCRIPTION: FIXTURE TYPE, LAMP, WATTS, DIFFUSER AND MOUNTING AS NOTED ON "LUMINAIRE SCHEDULE". POLE HEIGHT AND FINISH AS NOTED ON "LUMINAIRE SCHEDULE"	
17 FOOT SQUARE POLE CONTRACTOR TO CONFIRM HEIGHT WITH POLE MANUFACTURER/SUPPLIER	
POLE BASE PLAN  9"-10" DIA. BOLT CIRCLE  9.75"	
GROUND WIRE LUG BOLTED TO LIGHT POLE  GROUND WIRE LUG BOLTED TO LIGHT POLE  GROUT GAP BETWEEN POLE  BASE AND SKIRT  ANCHOR BOLT FURN. BY POLE MANUFACTURER  GRADE	
GROUND CLAMP  NO. 8 COPPER GND WIRE-1/2"  RACEWAYS  AS REQ'D.  POURED CONCRETE BASE  3,000 P.S.I. MIN. – NATURAL	
CONCRETE — BROOM FINISH  VERIFY DESIGN ACCORDING TO LOCAL SOIL / FOUNDATION REQUIREMENTS	
2'-0"ø  FOUNDATION PLAN	

NOTES:
ALL CONCRETE POLE BASES TO BE INSTALLED
OF 24"-36" BEHIND BACK OF CONCRETE CURB.

POLE SHALL BE CAPABLE OF WITHSTANDING 150 MPH WIND SPEED.

 ГG. HT.
.5
.5
333
333
<sup>+</sup> 0.0	0.0	<sup>†</sup> 0.0	0.0	0.0	0.0	0.0	<sup>†</sup> 0.0	<sup>+</sup> 0.0	<sup>†</sup> 0.0	<sup>†</sup> 0.0	<sup>+</sup> 0.0	0.0	<sup>+</sup> 0.0	0.0	<sup>+</sup> 0.0	0.0	<sup>†</sup> 0.0	<sup>†</sup> 0.0	0.0	0.0	0.0	0.0		\ <sup>†</sup> 0.0\	, <sup>†</sup> O <sub>1</sub> O	$^{\uparrow}_{0}_{\uparrow}$ 0	<sup>+</sup> 0.0	<sup>†</sup> O <sub>1</sub> O	<sup>+</sup> 0.0	.0 0.0	0.0	0.0					
<sup>+</sup> 0.0	<sup>+</sup> 0.0	<sup>+</sup> 0.0	0.0	<sup>+</sup> 0.0	<sup>†</sup> 0.0	<sup>†</sup> 0.0	<sup>†</sup> 0.0	0.0	<sup>+</sup> 0.0	0.0	0.0	0.0	0.0	†0.0	<sup>†</sup> 0.0	<sup>+</sup> 0.0	<sup>+</sup> 0.0	<sup>+</sup> 0.0	<sup>+</sup> 0.0	0.0	<sup>+</sup> 0.0	<sup>†</sup> 0.0	0.0	0.0	0.0	0.0	φ.φ	0.0	0.0	0.0	0.0	<sup>†</sup> 0.0	0.0	<sup>+</sup> 0.0	0.0	0.0	
<sup>+</sup> 0.0	<sup>+</sup> 0.0	<sup>+</sup> 0.0	<sup>+</sup> 0.0	<sup>†</sup> 0.0	+ 0.0 0.0	+ 0.0 0.0	+ 0.0	+ 0.0 0.0	+ 0.0 0.0	+ <sup>†</sup> 0.0 0.0	+ 0.0 0.0	+ <sup>†</sup> 0.0 -	0.0 0.0	0.0	0.0	0.0	+ 0.0 +	0.0	+ 0.0 -	- <sup>†</sup> 0.0 +	0.0 0.0	0.0 0.0	0.0 + 0.0 0.0	0.0 + 0 0.	0.0 + 0.0 0.0	0.0 + 0.0	0.0	, , , , , , , , , , , , , , , , , , ,	, O.O.		5.0 5.0 5.0	, †O, O	0.0	<sup>+</sup> 0.0	0.0	0.0	
<sup>+</sup> 0.0	<sup>†</sup> 0.0		0.0	† 0 0		0.0									/ // /		<sup>†</sup> 0.1										0.0	\ \ \				+0 0	0.0	0.0	† 0.0	0.0	T
0.0	<sup>+</sup> 0.0	<sup>+</sup> 0.0	<sup>+</sup> 0.0	0.0 0.0	<sup>†</sup> 0.0	<sup>†</sup> 0.0	0.0	<sup>†</sup> 0.1	0.0	<sup>+</sup> 0.0	<sup>†</sup> 0.0	0.0	†0.0	0 1	<sup>†</sup> 0.1	<sup>+</sup> 0.1	<sup>+</sup> 0.1	<sup>†</sup> 0.2	<sup>+</sup> 0.2	<sup>+</sup> 0.2	<sup>†</sup> 0.1	0.1	0.1	0.1	0.0	0.1	<sup>+</sup> 0.1	0.1	†O.1	0.0	0.0	0.0 0.0	0.0	/o.o	0.0	0.0	<sup>†</sup> 0.0
0.0	<sup>+</sup> 0.0	0.0	<sup>†</sup> 0.0	0.0 0.0	<sup>†</sup> 0.0	0.0	<sup>†</sup> 0.1	<sup>†</sup> 0.1	<sup>†</sup> 0.0	14 J A	00		0.1	0.2	<sup>+</sup> 0.2	0.3	<sup>+</sup> 0.4	<sup>+</sup> 0.7	<sup>†</sup> 0.9	<sup>+</sup> 0.6	<sup>+</sup> 0.4	<sup>+</sup> 0.3	0.2	<sup>†</sup> 0.1	0.2	0.2	<sup>+</sup> 0.2	0.2	<sup>+</sup> 0.1	†O. 1	0.0	0.0	0.0	† <b>0.0</b>	<sup>†</sup> 0.0	0.0	<sup>†</sup> 0.0
0.0	0.0	<sup>+</sup> 0.0	<sup>+</sup> 0.0	0.0 0.0	0.0	<sup>†</sup> 0.1	<sup>†</sup> 0.1	0.2	0.3		· H 入	4	0.5	<sup>+</sup> 0.6	<sup>+</sup> 0.8	<sup>+</sup> 1.2	1.7	2.5 E	5 1 <sup>+</sup> 2.9	<sup>+</sup> 2.0	<sup>+</sup> 1.4	<sup>+</sup> 1.0	0.8	0.6	0.5	0.5	+ 0.4	0.3	÷ 0.1	0.1	0.0	0.0	0.0	<sup>†</sup> 0.0	<sup>†</sup> 0.0	<sup>†</sup> 0.0	0.0
0.0	0.0	0.0	<sup>+</sup> 0.0	0.0 0.0	0.0	<sup>+</sup> 0.1	<sup>†</sup> 0.1	<sup>†</sup> 0.3	0.5	0.7	0.8	0.8	1.0	1.3	<b>†</b> 1.8	<b>†</b> 2.8	4.3	<b>6</b> .4	<b>†</b> 6.9	<b>†</b> 4.9	<b>†</b> 3.4	<b>‡</b> 2.3	<b>†</b> 1.6	<b>†</b> 1.2	1.0	5.9 <b>†</b> 0.8	<b>†</b> 0.6	<b>†</b> 0.4	<b>†</b> 0.2	<b>†</b> 0.1	₽.0	0.0	.0.0	0.0	0.0	<sup>†</sup> 0.0	0.0
<sup>+</sup> 0.0	<sup>†</sup> 0.0	<sup>†</sup> 0.0	0.0	0.0 0.0	0.0	<sup>†</sup> 0.1	<sup>†</sup> 0.2	0.4	<b>†</b> 0.7	<b>†</b> 1.0	<b>†</b> 1.3	<b>†</b> 1.6	<b>†</b> 1.8	<b>‡</b> 2.1	<b>*</b> 2.7	<b>†</b> 3.6	<b>+</b> 4.2	<b>*</b> 4.6	<b>+</b> 4.8	<b>+</b> 4.5	<b>‡</b> 4.0	<b>†</b> 3.2	<b>+</b> 2.6	<b>†</b> 2.2	1.9	i.5 <b>†</b> .1	<b>†</b> 0.9	<b>†</b> 0.6	<b>†</b> 0.3	<b>†</b> 0.1	<b>†</b> 0.0	0.0	0.0 0.0	0.0	0.0	<sup>†</sup> 0.0	<sup>+</sup> 0.0
0.0	<sup>+</sup> 0.0	<sup>+</sup> 0.0	0.0	0.0 0.0	0.0	<sup>+</sup> 0.1	0.2	<b>†</b> 0.5	<b>†</b> 0.9	<b>†</b> 1.3	<b>†</b> 1.7	<b>†</b> 2.2	<b>†</b> 2.5	<b>†</b> 2.6	<b>†</b> 3.1	<b>*</b> 3.7	<b>†</b> 3.5	<b>‡</b> 3.5	<b>*</b> 3.5	<b>*</b> 3.6	<b>*</b> 3.7	<b>†</b> 3.6	<del>*</del> 3.2	<b>*</b> 3.2	2.8	2.1 <b>†</b> 1.7	<b>†</b> 1.3	<b>†</b> 0.9	<b>†</b> 0.5	0.2	<b>†</b> 0.0	0.0	0.0 0.0	0.0	<sup>†</sup> 0.0	<sup>†</sup> 0.0	0.0
<sup>+</sup> 0.0	<sup>†</sup> 0.0	<sup>+</sup> 0.0	0.0	0.0 0.0	0.0	0.1	<b>†</b> 0.2	<b>†</b> 0.6	<b>†</b> 1.1	<b>†</b> 1.7	<b>†</b> 2.5	<sup>+</sup> 4.3	4.8	<b>‡</b> 3.9	<del>*</del> 3.5	<del>*</del> 3.5	*3.2	<b>*</b> 3.0	<b>†</b> 2.9	<del>*</del> 3.1	<b>3.5</b>	<b>*</b> 3.8	<b>+</b> 4.7	6.0	5.1	3.4 <b>+</b> 2.5	<b>†</b> 2.0	<b>†</b> 1.5	<b>†</b> 0.9	<b>†</b> 0.3	<sup>+</sup> 0.1	<sup>†</sup> 0.0	0,0 0.0	<sup>†</sup> 0.0	<sup>†</sup> 0.0	<sup>†</sup> 0.0	<sup>+</sup> 0.0
<sup>+</sup> 0.0	<sup>†</sup> 0.0	<sup>+</sup> 0.0	0.0	0.0 0.0	0.1	<b>†</b> 0.1	<b>†</b> 0.3	<b>†</b> 0.7	<b>†</b> 1.3	<b>‡</b> 2.3	<b>*</b> 3.8	6.3	7.4	6.1	5.3	<sup>△</sup> <b>+</b> 5.4 <sup>△</sup>	5.0	4.3	4.0	4.1	†4.8	<b>5</b> .8	7.6	Q2D †9. <b>5</b>	±√ 8.0	<b>5</b> .4 <b>3</b> .7	<b>†</b> 2.8	<b>+</b> 2.4	<b>†</b> 1.8	0.5	0.1	<sup>†</sup> 0.0	.0 0.0	<sup>+</sup> 0.0	0.0	<sup>†</sup> 0.0	<sup>+</sup> 0.0
<sup>+</sup> 0.0	<sup>†</sup> 0.0	<sup>+</sup> 0.0	0.0	0.0 0.0	0.1	<b>†</b> 0.2	<b>†</b> 0.4	0.8	<b>†</b> 1.5	<b>†</b> 2.7	<b>+</b> 4.6	Q2D 7.5	9.8	11.8	13.4	16.8	4+17.8°	12.6°	9.8	10.0°	112	11.2°	13.8	†13.9	<sup>†</sup> 9.1	5.5 3.9	<b>†</b> 3.3	<b>*</b> 3.4	3.0	0.7	† 0.2		.0.0 0.0	0.0	0.0	<sup>†</sup> 0.0	<sup>+</sup> 0.0
<sup>+</sup> 0.0	<sup>†</sup> 0.0	<sup>+</sup> 0.0	0.0	0.0 0.0	0.1	<b>†</b> 0.2	<b>†</b> 0.3	1.4	<b>†</b> 1.9	<b>‡</b> 2.3	<b>*</b> 3.3	<b>5</b> .8	10.1	17.4	7.6	36.4	46.5	19.2	13.0	13.7	14./	12.6	10.7	± 7 7 4 A	9.6	4.9 4.1	<b>+</b> 4.2	<b>†</b> 5.3	5.0	0.9	<sup>†</sup> 0.3	†O.1	†0.0 0.0	0.0	0.0	<sup>†</sup> 0.0	<sup>+</sup> 0.0
<sup>+</sup> 0.0	<sup>+</sup> 0.0	<sup>†</sup> 0.0	<sup>+</sup> 0.0	0.0 0.0	0.0	t <sub>0</sub>		4.4	<b>*</b> 3.4	<b>*</b> 2.4	<b>‡</b> 2.6	3.9	**************************************	1 <b>6</b> 6	89 W1	S1	S1	W1		W1			W1 45	文  	9.5	4.5 4.3	<b>†</b> 5.0	<b>†</b> 7.4	Q1 6.5	<sup>†</sup> 1.3	<sup>†</sup> 0.1	<sup>†</sup> 0.0	†0.0 0.0	0.0	0.0	0.0	<sup>+</sup> 0.0
<sup>+</sup> 0.0	<sup>+</sup> 0.0	<sup>+</sup> 0.0	0.0	0.0 0.0	0.0		46	13.2	<b>†</b> 6.0	<b>*</b> 2.7	2.7	3.54	741	1 12.3	1									34	8.6	4.7 4.3	<b>+</b> 4.6	<b>†</b> 6.0	<b>†</b> 5.6	<sup>†</sup> 1.1	0.4	<sup>†</sup> 0.1	+0.0 0.0	† 0.0	0.0	0.0	0.0
<sup>+</sup> 0.0	<sup>+</sup> 0.0	<sup>+</sup> 0.0	<sup>+</sup> 0.0	0.0 0.0	0.0		W1 <b>[</b>	13.5	<b>†</b> 6.1	<b>‡</b> 2.7	<b>‡</b> 2.6	3.2	4.3	<sub>4+</sub> ₹ 5.0										5.8 4	5.5	4.4	<b>4</b> .0	<b>‡</b> 4.3	<b>†</b> 3.9	<sup>†</sup> 1.1	0.3	<sup>†</sup> 0.1	0.0	0.0	0.0	0.0	<sup>+</sup> 0.0
<sup>+</sup> 0.0	<sup>+</sup> 0.0	<sup>+</sup> 0.0	<sup>+</sup> 0.0	0.0 0.0	0.0			5.0	<b>‡</b> 3.6	<b>†</b> 2.5	<b>‡</b> 2.5	3.4	3.9	3.6								00		+4 3	4.5	<b>4</b> .0 <b>₹</b> 3.9	<b>*</b> 3.9	<b>*</b> 3.8	<b>*</b> 3.2	1.4	0.4	<sup>†</sup> 0.1	0.0 0.0	†O.O	0.0	0.0	0.0
0.0	<sup>+</sup> 0.0	<sup>+</sup> 0.0	0.0	0.0 0.0	<sup>†</sup> 0.0			1.6	<b>†</b> 1.9	<b>†</b> 2.3	<b>3</b> .1	<b>4</b> 9	<b>₹</b> 5.6∠ ₄	4.3		3	32 S1	33 S1		34 51	35 S1	36 S1	44 W1	5.8	6.1	5.0 4.0	<b>*</b> 3.7	<b>†</b> 3.5	<b>*</b> 3.1	2.3	0.6	<sup>†</sup> 0.1	0.0 0.0	0.0	0.0	<sup>†</sup> 0.0	0.0
0.0	0.0	<sup>+</sup> 0.0	0.0	0.0 0.0	0.1		0.3.	0.9	<b>†</b> 1.5	<b>‡</b> 2.7	4.5	6.9	7.6	5.7	4.4	8.6	15.4	16/2/	12.8	15.9	18.5	25.9	24.3	16.6	10.2	6.4 4.6	<b>*</b> 3.8	<b>*</b> 3.4	<b>3</b> .9	<b>‡</b> 3.6	0.9	0.2	0.1 0.1	0.0	0.0	0.0	† <sub>0.0</sub>
0.0	<sup>+</sup> 0.0	<sup>+</sup> 0.0	0.0	0.0 0.0	0.1	0 1.	<b>4</b> 0.3	0.7	<b>†</b> 1.3	<b>‡</b> 2.1	<b>†</b> 3.3	Q2D 5.4	6.1	4.2	3.0	3.1	3.4	<b>4</b> 3.4	*3.4 A	3.7	<b>1 5 1</b>	7.1	8.5	8.9	7.7	5.1 43.9	<b>†</b> 3.8	<b>4</b> .0	5.7 0	5.8	1.3	0.4	0.1 0.1	<b>Ö</b> , O	0.0	0.0	†0.0
<sup>†</sup> 0.0	<sup>†</sup> 0.0	<sup>+</sup> 0.0	<sup>+</sup> 0.0	0.0 0.0	0.1	<b>t</b> o.	<b>†</b> 0.3	<b>†</b> 0.6	<b>†</b> 1.1	<b>†</b> 1.7	<b>*</b> 2.4	<b>†</b> 3.9	4.2	<sup>+</sup> 3.2	2.4	2.1	1.9	1.7	1.8	2.1	2.7	3.3	3.9	5.1	5.0	3.8 <b>3</b> .2	<b>*</b> 3.7	<b>+</b> 4.1	6.7	Q1 6.6	1.5	0.5	0.1 0.1	0.0	0.0	0.0	
0.0	<sup>+</sup> 0.0	<sup>†</sup> 0.0	0.0	0.0 0.0	0.1	<b>t</b> 0.1	<b>†</b> 0.3	<b>†</b> 0.6	<b>†</b> 1.2	<b>†</b> 1.7	<b>†</b> 2.3	<b>‡</b> 2.9	<b>†</b> 3.2	<b>‡</b> 3.0	<b>+</b> 2.8	<b>‡</b> 2.7	<b>†</b> 2.4	<b>†</b> 2.2	<b>+</b> 2.2	<b>‡</b> 2.5	<b>+</b> 2.8	<b>*</b> 3.1	<b>*</b> 3.4	<b>3</b> .6	3.6	3.4 <b>3</b> .3	<b>†</b> 3.5	<b>†</b> 3.5	20700		1.0	0.3	0.1	0.0	0.0	0.0	
<sup>†</sup> 0.0	<sup>†</sup> 0.0	<sup>+</sup> 0.0	<sup>†</sup> 0.0	0.0 0.0	0.0	<sup>†</sup> 0.1	0.2	<b>†</b> 0.6	<b>†</b> 1.1		23	2	4	13	14	1	5	16	17	4	10	10	20	21		22	<b>*</b> 3.2	<b>+</b> 2.8	GALS 9	2.7	0.7	<sup>†</sup> 0.1	0.0	0.0	0.0	0.0)	
<sup>†</sup> 0.0	<sup>†</sup> 0.0	<sup>+</sup> 0.0	<sup>+</sup> 0.0	0.0 0.0	0.0	<sup>†</sup> 0.1	0.2	<b>†</b> 0.4	<b>†</b> 0.9		C5 5 t5	<del>-</del>	<del>5</del> <del>7</del> <del>7</del>				05 <sup>†</sup> <sup>†</sup> <del>†</del>										<b>*</b> 2.7	<b>†</b> 2.1	129 o	1.6	0.4	<sup>†</sup> 0.1	0.0	0.0	0.0		0.0
<sup>+</sup> 0.0	<sup>†</sup> 0.0	<sup>†</sup> 0.0	<sup>+</sup> 0.0	.0.0 	0.0	0.1	<b>†</b> 0.1	<b>†</b> 0.3	<b>†</b> 0.6		5 √	8 <sup>†</sup> 6	***************************************	7 8 8 8	**************************************	**************************************	**************************************	7	3 8 <sup>†</sup> 7 3 8 <sup>†</sup> 7	† <b>7</b> 0 †8 †	7 8	**************************************	**************************************	* * * * * * * * * * * * * * * * * * *	†7 <b>•</b>	6 V V 6	<b>*</b> 2.0	<b>†</b> 1.3	GAL OF	0.8	0.3	0.0	0.0	0.0	0.0	<b>1</b> 0.10	<sup>†</sup> 0.0
<sup>+</sup> 0.0	<sup>+</sup> 0.0	<sup>†</sup> 0.0	0.0	to.o 	0.0	<sup>†</sup> 0.1	0.1	<b>†</b> 0.2	<b>†</b> 0.4								7 05			5 7 7 4	7 7 7 7 4 5 F	<sup>†</sup> 4	6 + 4	†7 * * * †7 <b>*</b> * †5 * †4 * .	† 4 + + + + + + + + + + + + + + + + + +	† 5 † 3 † 3	<b>†</b> 1.2	<b>†</b> 0.7	12,000	<b>L</b>	<sup>†</sup> 0.2	<sup>†</sup> 0.0	0.0	0.0	0.0	<sup>†</sup> 0.0	<b>1</b> 0.0
<sup>†</sup> 0.0	<sup>†</sup> 0.0	<sup>+</sup> 0.0	<sup>+</sup> 0.0	<sup>†</sup> 0.0 <sup>†</sup> 0.0	0.0	· <sup>+</sup> 0.0	<b>5</b> .1	<b>†</b> 0.1	<b>†</b> 0.2		2 2 11 C5	3 3 12 C	3 3 2 5	3 3 1 C5	3 3 2 C5	3 3 3	3 3 3 3 C5	4 C5	5 C5	· · · · · · · · · · · · · · · · · · ·	6 C5	7 C5	8 C5	9 C5	3 3	10 C5	<b>†</b> 0.6	<b>†</b> 0.3	03	0.2	<sup>†</sup> 0.1	<sup>†</sup> 0.0	0.0 0.0	0.0	0.0	0.0	0.0
<sup>†</sup> 0.0	<sup>†</sup> 0.0	<sup>+</sup> 0.0	<sup>+</sup> 0.0	0.0 0.0	0.0	<sup>†</sup> 0.0	<b>†</b> 0.1	<b>†</b> 0.1	<b>†</b> 0.1	<b>†</b> 0.2	<b>†</b> 0.2	0.3	0.4	<del>+</del> 0.4	0.5	0.5	<b>†</b> 0.5	<b>†</b> 0.5	<b>†</b> 0.5	<b>†</b> 0.5	<b>†</b> 0.5	<b>†</b> 0.5	<b>†</b> 0.5	0.4	0.4	5.3 <b>†</b> 0.3	<b>†</b> 0.2	<b>†</b> 0.2	<b>†</b> 0.1	0/1	<sup>†</sup> 0.1	<sup>†</sup> 0.0	0.0	- <sup>†</sup> 0.0	0.0	0.0	<sup>+</sup> 0.0
<sup>+</sup> 0.0	<sup>+</sup> 0.0	<sup>†</sup> 0.0	0.0	<sup>†</sup> 0.0 <sup>†</sup> 0.0	0.0	<sup>†</sup> 0.0	<b>†</b> 0.0	<b>†</b> 0.0	<b>†</b> 0.1	<b>†</b> 0.1	<b>†</b> 0.1	<b>†</b> 0.1	<b>†</b> 0.2	<sup>†</sup> 0.2	<b>†</b> 0.2	<b>†</b> 0.2	0.2	0.2	<b>†</b> 0.2	<b>†</b> 0.2	<b>†</b> 0.2	<b>†</b> 0.2	0.2	0.2	0.2	5.1 <del>†</del> 0.1	<mark>†</mark> 0.1	<sup>†</sup> 0.1	<b>-t</b> 1		<sup>+</sup> 0.0	<sup>†</sup> 0.0	0.0	• O	0.0	0.0	<sup>+</sup> 0.0
0.0	<sup>+</sup> 0.0	<sup>+</sup> 0.0	<sup>†</sup> 0.0	0.0 0.0 0.0	0.0	1 ' 4		/V\vartheta.oL	<b>N</b> <sub>0</sub> 00	<sup>†</sup> 0.0	<b>†</b> 0.1	<b>t</b> 0.1	0.1	0.1	0.1	0.1	0.1	0.1	0.1	0.1	<b>0</b> .1	<b>0</b> .1	<b>†</b> 0.1	<b>†</b> 0.1	0.1		<b>†</b> 0.0	0.0	0.0	0.0	<sup>†</sup> 0.0	0.0	0.0	0.0	0.0	0.0	0.0
0.0	0.0	<sup>+</sup> 0.0	<sup>+</sup> 0.0	<sup>+</sup> 0.0	0.0	†0.0	†0.0 †0.0	0.0 0.0	0.0 0.0	+ 0.0 0.0	0.00	0.00.0	0.0	0.0 0.0	†0.0 . †0.0	<sup>†</sup> 0.1	0.1	<sup>†</sup> 0.1	0.1	<sup>†</sup> 0.1	0.1	<sup>†</sup> 0.1	0.0	0.0	0.0	0.0	0.0	0.0	0.0	-0.0 <u>Z</u>	⊕.0 □	0.0 0 0.0	0.0	40.0	0.0	0.0	0.0
<sup>+</sup> 0.0	<sup>†</sup> 0.0	<sup>+</sup> 0.0	<sup>+</sup> 0.0	<sup>+</sup> 0.0	<sup>†</sup> 0.0	<sup>†</sup> 0.0	0.0	<sup>+</sup> 0.0	0.0	<sup>†</sup> 0.0	0.0	<sup>†</sup> 0.0	<sup>†</sup> 0.0	<sup>†</sup> 0.0	†0.0	† 0.0	0.0	0.0	0.0 0.0	0.0 0.0	0.0 0.0	+ 0.0 0.8	0.8.0	0.0.0	0.0.0	0.0 0.0	0 0 0 0	· · · · · · · · · · · · · · · · · · ·	0.8.0	0.8.0.4.	0.00	†0.0 	0.0	0.0	<sup>†</sup> 0.0	0.0	
	<sup>+</sup> 0.0	<sup>+</sup> 0.0	<sup>+</sup> 0.0	<sup>+</sup> 0.0	<sup>†</sup> 0.0	<sup>†</sup> 0.0	0.0	0.0	0.0	<sup>†</sup> 0.0	0.0	<sup>†</sup> 0.0	<sup>+</sup> 0.0	<sup>+</sup> 0.0	<sup>+</sup> 0.0	0.0	<sup>+</sup> 0.0	0.0	<sup>†</sup> 0.0	<sup>†</sup> 0.0	0.0	0.0	0.0	0.0	0.0	0.0	0.0	0.0	<sup>+</sup> 0.0	<sup>+</sup> 0.0	†o.0	  0.0	<sup>†</sup> 0.0	II	(

 $\stackrel{\dagger}{0.0}$   $\stackrel{\dagger}{0.0}$ 

**INTERPLAN** CA 8660

ARCHITECTURE ENGINEERING

220 E. CENTRAL PKWY, STE 4000 ALTAMONTE SPRINGS, FL 32701 407.645.5008

THIS DOCUMENT IS NOT FOR REGULATORY APPROVAL, PERMITTING, OR CONSTRUCTION.



7-ELEVEN STORE #42659


SWC OF ST JOHNS HERITAGE PKWY & EMERSON DR PALM BAY, FL 32904

PROJECT NO: 2024.0313 DATE: APRIL 28, 2024  $\sim \sim \sim \sim$ SITE LIGHTING

1) SITE LIGHTING PLAN

CHECKED: SN DRAWN: SB

2) SITE LIGHTING POLE AND BASE

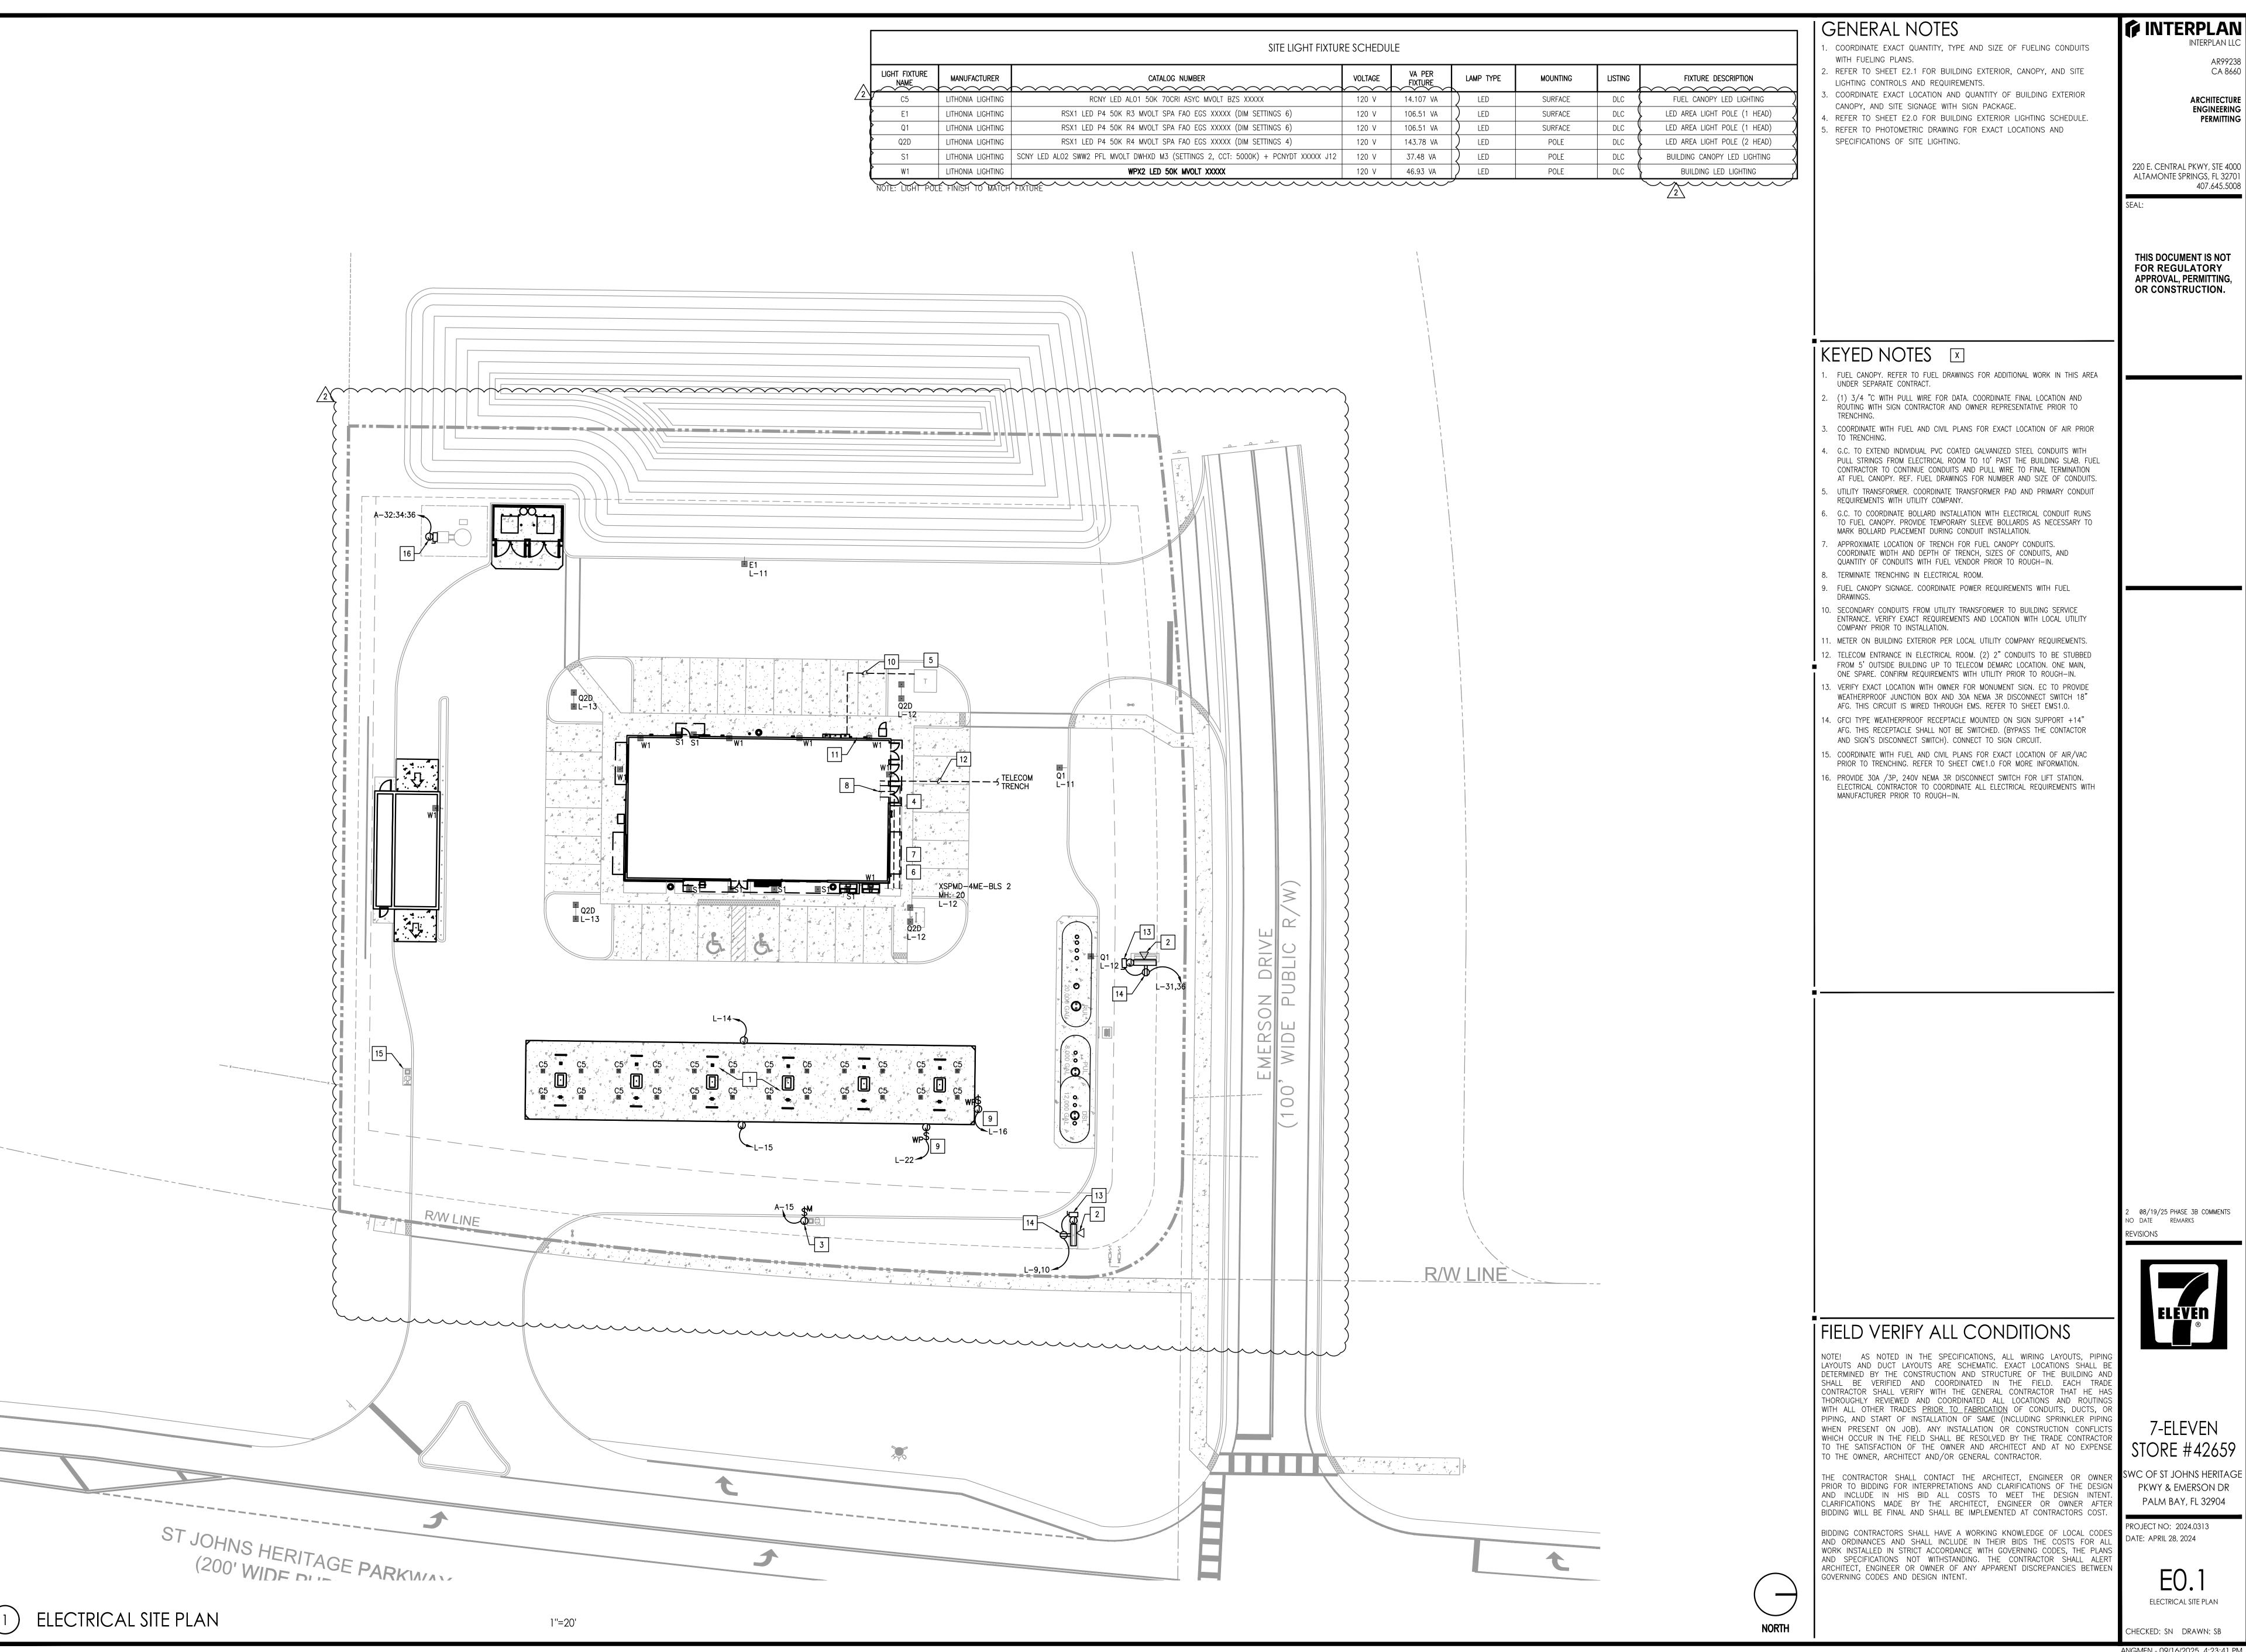

**INTERPLAN** 

**ARCHITECTURE ENGINEERING** 

220 E. CENTRAL PKWY, STE 4000 ALTAMONTE SPRINGS, FL 32701 407.645.5008

THIS DOCUMENT IS NOT FOR REGULATORY APPROVAL, PERMITTING OR CONSTRUCTION.

08/19/25 PHASE 3B COMMENTS



7-ELEVEN STORE #42659

PKWY & EMERSON DR PALM BAY, FL 32904

PROJECT NO: 2024.0313 DATE: APRIL 28, 2024

ELECTRICAL SITE PLAN

CHECKED: SN DRAWN: SB

ANGMEN - 09/16/2025 4:23:41 PM

ELECTRICAL SPECIFICATION INTRODUCTION	3.5 WIRING DEVICES:  3.5.1 INSTALL ON EACH AND EVERY OUTLET BOX, A WIRING DEVICE AND/OR COVERPLATE, ALL AS INDICATED	ALL CONDUCTORS SHALL BE COPPER, TYPE THHN. UNO. MINIMUM CONDUCTOR SIZE SHALL BE #12 AWG. CONDUCTORS #10 AWG AND LARGER SHALL BE STRANDED. INSULATION TYPE SHALL CONFORM WITH N.E.C. OR MANUFACTURER REQUIREMENTS. LIGHT FIXTURES SOMETIMES REQUIRE 90 DEGREE WIRE. FOR THE PARTICULAR	FOR AUTO—ON OCCUPANT SENSOR CONTROLS, THE LIGHTS TURN ON TO THE PERMITTED LEVEL WHEN AN OCCUPANT ENTERS THE SPACE.	
THE CONTRACTING FOR INSTALLATION OF THE ELECTRICAL SYSTEM WILL BE ACCOMPLISHED IN THE FIELD AT THE DIVISION LEVEL. THESE SPECIFICATIONS ARE TO AID IN PREPARATION OF DIVISION LEVEL STORE PLANS AND CONTRACT DOCUMENTS. IN CASE OF A CONFLICT BETWEEN THIS SPECIFICATION AND THE CONTRACT DOCUMENTS	BY SYMBOL ON THE DRAWINGS.  3.5.1.1 SINGLE POLE SWITCHES:  SINGLE POLE WALL SWITCHES SHALL BE SIMILAR AND EQUIVALENT TO "LEVITON" #CS120-2W  20A, 120-277VAC TOGGLE SWITCH (WHITE) WITH COVERPLATE FOR SINGLE GANG OR (WHITE)	APPLICATION. USE TYPE THWN IN WET LOCATIONS.  3.9.1 NM CABLE (ROMEX) SHALL NOT BE USED.  3.9.2 ALUMINUM CONDUCTORS SHALL NOT BE USED U.N.O.	<ul> <li>FOR MANUAL—ON OCCUPANT SENSOR CONTROLS, THE LIGHTS TURN ON ONLY WHEN MANUALLY ACTIVATED.</li> <li>THE LIGHTS ARE NOT INCORRECTLY TURNED ON BY MOVEMENT IN ADJACENT AREAS OR BY HVAC OPERATION.</li> </ul>	AR El
PROVIDED BY THE DIVISION CONSTRUCTION MANAGER, THE DIVISION'S PLANS AND SPECIFICATIONS SHALL PREVAIL.  DEFINITIONS THE FOLLOWING DEFINITIONS APPLY TO THIS PROJECT.	COVERPLATE FOR DOUBLE GANG.  3.5.1.2 3-WAY SWITCHES:	3.9.3 METAL—CLAD CABLE (MC) SHALL BE PERMITTED FOR USE AS BRANCH CIRCUITS IN WALL, CEILING OR CABINETRY.	7.2.3 TIME—SWITCH CONTROLS:	
FURNISH — TO SUPPLY THE MATERIAL NECESSARY TO PERFORM THE TASK. INSTALL — TO SUPPLY THE LABOR NECESSARY TO COMPLETE THE TASK. PROVIDE — TO FURNISH AND INSTALL MATERIAL AND LABOR TO COMPLETE THE TASK.	3-WAY SWITCHES SHALL BE SIMILAR AND EQUIVALENT TO "BRYANT" #4503-1 20A, 120-277VAC 3-WAY SWITCH (WHITE HANDLE) AND (WHITE) COVERPLATE FOR SINGLE GANG OR (WHITE) COVER PLATE FOR DOUBLE GANG.	4. TESTING AND INSPECTION 4.1 TESTING:	WHERE TIME-SWITCH CONTROLS ARE PROVIDED, THE FOLLOWING PROCEDURES SHALL BE PERFORMED:  • CONFIRM THAT THE TIME-SWITCH CONTROL IS PROGRAMMED WITH ACCURATE WEEKDAY, WEEKEND	220 E. CENTRAL PKV ALTAMONTE SPRING
1. SCOPE	3.5.1.3 SINGLE THROW, DOUBLE POLE EVAPORATOR SWITCH SINGLE THROW, DOUBLE POLE SWITCHES SHALL BE SIMILAR AND EQUIVALENT TO "BRYANT" #30322D 120-600VAC NEMA 3R ENCLOSED AC MANUAL MOTOR CONTROLLER/DISCONNECT.	4.1.1 THE E.C. SHALL TEST, PRIOR TO ENERGIZING FOR THE FIRST TIME, ALL PIECES OF ELECTRICAL EQUIPMENT TO ASSURE THEY HAVE THE PROPER PHASE TO PHASE AND PHASE TO GROUND INSULATION AND TO BE FREE OF SHORTS. AFTER ENERGIZING, EACH LUMINAIRE SHALL BE LIT AND	AND HOLIDAY SCHEDULES.  PROVIDE DOCUMENTATION TO THE OWNER OF TIME—SWITCH CONTROLS PROGRAMMING INCLUDING	SEAL:
<ul> <li>1.1 E.C. TO PROVIDE ALL LABOR, MATERIALS AND EQUIPMENT (U.N.O.) REQUIRED TO EXECUTE WORK PER NEC AND ALL APPLICABLE ELECTRICAL CODES IN FORCE AT THE TIME OF PROJECT COMPLETION.</li> <li>1.2 THIS WORK INCLUDES, BUT IS NOT LIMITED TO: ELECTRICAL SERVICE AND DISTRIBUTION SYSTEMS, PANELBOARDS, DISCONNECT SWITCHES, LIGHTING FIXTURES, POWER AND CONTROL WIRING WITH FINAL CONNECTIONS TO ALL EQUIPMENT REQUIRED FOR A COMPLETE SYSTEM.</li> </ul>	3.5.2 NOT USED.  3.5.3 CONVENIENCE OUTLET (20A):	TESTED.  4.1.2 THE VARIOUS CIRCUITS SERVED FROM THE PANELBOARDS VARY IN LOADING. THE E.C. SHALL CAREFULLY BALANCE THE LOAD ON EACH LEG OF THE SERVICE. WHEN ALL LOAD IS TURNED ON AND	WEEKDAY, WEEKEND, HOLIDAY SCHEDULES, AND SET-UP AND PREFERENCE PROGRAM SETTINGS.  • VERIFY THE CORRECT TIME AND DATE IN THE TIME SWITCH.	TUIO DOCUMENT
CONNECTIONS TO ALL EQUIPMENT REQUIRED FOR A COMPLETE SYSTEM.  1.3 E.C. TO VERIFY TYPE OF POWER SERVICE AVAILABLE (UNDERGROUND OR OVERHEAD) AND MAXIMUM SHORT CIRCUIT CURRENT PRIOR TO SUBMITTING A PROPOSAL.	20A CONVENIENCE OUTLETS SHALL BE SIMILAR AND EQUIVALENTS TO "LEVITON" #CR20-W 2 POLE, 3 WIRE. 20A 125V, DUPLEX GROUNDING RECEPTACLE WITH (WHITE) COVERPLATE SIMILAR AND EQUIVALENT TO "LEVITON" #88003 FOR SINGLE DUPLEX OR "LEVITON" #88016 FOR DOUBLE DUPLEX (QUAD).	THE SYSTEM IS OPERATING AT 100%, THE INITIAL UNBALANCE SHALL NOT EXCEED 10%.  NOTE:WITH 3 PHASE DELTA, PHASES A AND C SHALL BE BALANCED WITHIN 10% PHASE B (HIGH LEG) SHALL BE BALANCED AS CLOSELY AS POSSIBLE.	VERIFY THAT ANY BATTERY BACK-UP IS INSTALLED AND ENERGIZED.	THIS DOCUMENT FOR REGULAT APPROVAL, PER OR CONSTRUC
<ul> <li>1.4 E.C. TO VERIFY TYPE OF TELEPHONE SERVICE AVAILABLE (UNDERGROUND OR OVERHEAD) PRIOR TO SUBMITTING A PROPOSAL.</li> <li>1.5 E.C. TO VERIFY METERING, IN ACCORDANCE WITH LOCAL ELECTRIC UTILITY COMPANY REQUIREMENTS, FOR GENERAL SERVICE SCHEDULE.</li> </ul>	3.5.4 OUTLET, ISOLATED GROUND (20A): ISOLATED GROUND OUTLETS SHALL BE SIMILAR AND EQUIVALENT TO "LEVITON" #5362—IG 2 POLE, 3 WIRE, 20A, 125V, SINGLE, ISOLATED GROUND RECEPTACLE (ORANGE) WITH (WHITE) COVERPLATE.	4.2 INSPECTION: E.C. SHALL FURNISH AT THE COMPLETION OF THE PROJECT OR EACH INSPECTION POINT OF THE PROJECT,	<ul> <li>VERIFY THAT THE OVERRIDE TIME LIMIT IS SET TO NOT MORE THAN 2 HOURS.</li> <li>SIMULATE OCCUPIED CONDITION. VERIFY AND DOCUMENT THE FOLLOWING:</li> </ul>	
THE E.C. SHALL NOTIFY 7—ELEVEN, IN WRITING PRIOR TO SUBMITTING OF PROPOSAL (U.N.O.).	3.5.5 GFCI CONVENIENCE OUTLETS (INDOOR & OUTDOOR): OUTDOOR GFCI OUTLETS SHALL BE WEATHER RESISTANT (WR) LABELED, EQUIVALENT TO "LEVITON" #WR899-W, 20A OUTLET WITH OUTDOOR COVERPLATE #4500B AND BACK PLATE #63101. INDOOR GFCI	AN INTERMEDIATE OR FINAL INSPECTION CERTIFICATE FROM THE LOCAL INSPECTING AUTHORITY.  4.3 PERFORMANCE REQUIRED:	<ul> <li>ALL LIGHTS CAN BE TURNED ON AND OFF BY THEIR RESPECTIVE AREA CONTROL SWITCH.</li> <li>THE SWITCH ONLY OPERATES LIGHTING IN THE ENCLOSED SPACE IN WHICH THE SWITCH IS LOCATED.</li> </ul>	
<ul><li>1.7 E.C. TO PROVIDE PANELBOARD NAMEPLATES. PROVIDE LAMINATED PLASTIC NAMEPLATES WITH 3/4 INCH MINIMUM CONTRASTING—COLOR ENGRAVED LETTERS IDENTIFYING EACH PANELBOARD.</li><li>2. INSTALLATION</li></ul>	OUTLETS SHALL BE EQUIVALENT TO "LEVITON" #7899-W, 20A WITH (WHITE) COVERPLATE.  3.5.6 NOT USED.	<ul><li>4.3.1 ALL EQUIPMENT AND FIXTURES SHALL BE PROPERLY CONNECTED WITH ADEQUATE POWER AND CHECKED THOROUGHLY FOR PROPER OPERATION.</li><li>4.3.2 ALL EXPOSED EQUIPMENT SHALL BE INSTALLED AS PER DRAWINGS AND IS SUBJECT TO INSPECTION</li></ul>	SIMULATE UNOCCUPIED CONDITION. VERIFY AND DOCUMENT THE FOLLOWING:	
2.1 THE INSTALLATION SHALL COMPLY WITH ALL LAWS IN EFFECT AT THE TIME OF CONSTRUCTION APPLYING TO ELECTRICAL INSTALLATION, AND WITH THE REGULATIONS OF THE NEC, WHERE SUCH REGULATIONS DO NOT CONFLICT WITH THE LAWS IN EFFECT, AND WITH THE PUBLIC UTILITY COMPANY FURNISHING THE SERVICE.	3.5.7 SAFETY SWITCHES:  SAFETY SWITCHES SHALL BE UL APPROVED GENERAL DUTY SAFETY SWITCHES WITH LOCK OFF HANDLES SIMILAR AND EQUIVALENT TO THOSE MANUFACTURED BY "SQUARE-D". SWITCHES WILL BE FUSIBLE OR	FOR WORKMAN-LIKE APPEARANCE.  5. INDUSTRY-STANDARDS:	<ul> <li>NONEXEMPT LIGHTING TURNS OFF.</li> <li>MANUAL OVERRIDE SWITCH ALLOWS ONLY THE LIGHTS IN THE ENCLOSED SPACE WHERE THE</li> </ul>	
2.1.1 THE E.C. SHALL UPGRADE THESE SPECIFICATIONS AS REQUIRED TO MEET COMPLIANCE WITH ALL APPLICABLE CODES IN EFFECT; HOWEVER, WHERE THESE SPECIFICATIONS MAKE STIPULATIONS OVER AND ABOVE THE MINIMUM REQUIREMENTS OF APPLICABLE CODES, THE CONTRACTOR SHALL NOT	NON-FUSIBLE AS INDIACTED ON PLANS/LOCAL CODES AND WILL BE NEMA TYPE A FOR INDOOR (DRY) INSTALLATION OR NEMA TYPE 3R ENCLOSURE FOR OUTDOOR INSTALLATION. FUSED SWITCHES SHALL HAVE REJECTION STYLE FUSE HOLDERS TO MATCH LPN-RK CLASS RK1 FUSES.	5.1 THE FOLLOWING IS A LIST OF ABBREVIATIONS USED IN THE ELECTRICAL NOTES AND SPECIFICATIONS.  NECNATIONAL ELECTRIC CODE. REFERENCE COVERSHEET FOR APPLICABLE VERSION NEMANATIONAL ELECTRICAL MANUFACTURERS ASSOCIATION	OVERRIDE SWITCH IS LOCATED TO TURN ON OR REMAIN ON UNTIL THE NEXT SCHEDULED SHUTOFF OCCURS.  • ADDITIONAL TESTING AS SPECIFIED BY THE REGISTERED DESIGN PROFESSIONAL.	
DOWN-GRADE THESE SPECIFICATIONS TO MINIMUM CODE REQUIREMENTS WITHOUT PRIOR WRITTEN APPROVAL FROM 7-ELEVEN.	3.5.8 NOT USED.  3.5.9 PHOTO CELL (OUTDOOR):  ELECTRONIC LIGHT SENSOR SHALL BE THE TORK EPC—1. ENCLOSED IN A LEXAN HOUSING WITH A	ULUNDERWRITERS LABORATORIES, INC HVACHEATING, VENTILATING AND AIR CONDITIONING IEEE INSTITUTE OF ELECTRICAL AND ELECTRONICS ENGINEERS	7.2.4 DAYLIGHT RESPONSIVE CONTROLS:  WHERE DAYLIGHT RESPONSIVE CONTROLS ARE PROVIDED, THE FOLLOWING SHALL BE VERIFIED:	
2.2 E.C. SHALL PROVIDE ALL REQUIRED ELECTRICAL CONDUIT AND WIRING FOR ALL MOTORS, MOTOR STARTERS AND ELECTRICAL CONTROLS, U.N.O. E.C. SHALL MAKE ALL LINE VOLTAGE ELECTRICAL CONNECTIONS AS REQUIRED FOR HVAC SYSTEMS.	1/2" CONDUIT MOUNTING AND 180 DEGREE SWIVEL. INSTALL IN A WEATHER TIGHT JUNCTION BOX ON THE ROOF PER MANUFACTURER'S RECOMMENDATIONS. SET SENSOR TO 100 FOOT—CANDLE LEVEL.	GFCIGROUND FAULT CIRCUIT INTERRUPTER A.I.CAMPERES INTERRUPTING CAPACITY U.N.O. UNLESS NOTED OTHERWISE A.CELECTRICAL CONTRACTOR	<ul> <li>CONTROL DEVICES HAVE BEEN PROPERLY LOCATED, FIELD CALIBRATED AND SET FOR ACCURATE SETPOINTS AND THRESHOLD LIGHT LEVELS.</li> </ul>	
2.3 E.C. SHALL INSTALL THE CONNECTIONS TO ALL RECEPTACLES, SALES COUNTERS, GONDOLAS AND FINAL CONNECTIONS TO ALL FIXTURES AFTER FIXTURES ARE IN PLACE.	3.5.9.1 LIGHTING CONTROLLER (OUTDOOR LIGHTING CONTROL):  THE LIGHTING CONTROLLER SHALL BE THE TORK LC—200 IN A NEMA 1 ENCLOSURE. THE  LC—200 IS USED IN CONJUNCTION WITH THE TORK EPC—1 PHOTOCELL. LIGHTING CONTROLLER  HAS A 2 TO 100 FOOT—CANDLE LIGHT ADJUSTMENT.	G.CGENERAL CONTRACTOR  6. UTILITY ACCOUNT OPEN PROCESS	<ul> <li>DAYLIGHT CONTROLLED LIGHTING LOADS ADJUST TO LIGHT LEVEL SET POINTS IN RESPONSE TO AVAILABLE DAYLIGHT.</li> </ul>	
2.4 E.C. SHALL VERIFY EXACT LOCATION OF ALL SIGNS WITH 7—ELEVEN REPRESENTATIVE. PROVIDE ALL CONDUITS AND WIRES WITH STUB—UPS AS DIRECTED BY THE 7—ELEVEN CORPORATION AND INSTALL FINAL CONNECTIONS AS REQUIRED.	3.5.10 CONTACTOR (OUTDOOR LIGHTING CONTROL): THE LIGHTING CONTACTORS FOR USE WITH THE OUTDOOR PHOTOCELLS SHALL BE SIMILAR AND	<ul><li>6.1 GENERAL CONTRACTOR (G.C.) WORKS WITH THE UTILITY COMPANIES TO SET UP ALL REQUIRED METERS AND ACCOUNTS (ELECTRIC, NATURAL GAS, WATER) UNTER THE GC COMPANY NAME.</li><li>6.2 FOR CORPORATE AND NON BCP FRANCHISEE, G.C. OBTAINS OPEN FACILITY REQUEST FORM FROM</li></ul>	THE LOCATIONS OF CALIBRATION ADJUSTMENT EQUIPMENT ARE READILY ACCESSIBLE ONLY TO AUTHORIZED PERSONNEL.	
2.5 WIRING  2.5.1 ALL WORK SHALL BE COMPLETED IN A NEAT AND WORKMAN-LIKE MANNER. THE E.C. SHALL CONTACT  THE 7-ELEVEN CORPORATION REPRESENTATIVE SHOULD THIS PLAN REQUIRE MODIFICATION TO COMPLY	EQUIVALENT TO "SQUARE—D" ELECTRICALLY HELD LIGHT CONTACTOR CLASS 8903 TYPE LG—80 FORM F WITH 120V CONTROL COIL, NORMALLY OPEN CONTACTS RATED AT 30 AMPS CONTINUOUS, IN NEMA TYPE 1 ENCLOSURE WITH FUSED CONTROL CIRCUIT. REFERENCE LIGHTING CONTACTOR DETAIL.	DEVELOPMENT PROJECT MANAGER (D.P.M.). BLANK FORM IS LOCATED AT 7-ELEVEN HUB/OPERATIONS/DEVELOPMENT PROGRAM MANAGEMENT QUICK LINKS.	8. DOCUMENTATION REQUIREMENTS: THE CONSTRUCTION DOCUMENTS SHALL SPECIFY THAT DOCUMENTS CERTIFYING THAT THE INSTALLED LIGHTING CONTROLS MEET DOCUMENTED PERFORMANCE CRITERIA OF SECTION C405 ARE TO BE PROVIDED TO THE BUILDING	
WITH LOCAL CODES.  2.5.2 ALL CONDUCTORS SHALL BE RUN IN APPROVED METALLIC RACEWAY OR CONDUIT AND SHALL BE	3.5.11 PHOTO CELL BYPASS SWITCH: THE PHOTOCELL BYPASS SWITCH SHALL BE A "BRYANT" #4801—L SINGLE POLE LOCK TYPE 15A 120—277 VOLT SWITCH WITH KEY #6006 AND COVERPLATE (WHITE).	<ul> <li>6.3 AT LEAST FIFTEEN (15) DAYS PRIOR TO THE STORE OPEN DATE, G.C. MAILS COMPLETED OPEN FACILITIES REQUEST FORM TO ECOVA AT 7-ELEVENOPCL@ECOVA.COM WITH A COPY TO THE D.P.M.</li> <li>6.4 BCP FRANCHISEES SET UP THEIR OWN UTILITES AND THIS SET UP DOES NOT GO THROUGH 7-ELEVEN, INC.</li> </ul>	OWNER WITHIN 90 DAYS FROM THE DATE OF RECEIPT OF THE CERTIFICATE OF OCCUPANCY.	
UNIFORMLY COLOR CODED THROUGHOUT THE ENTIRE SYSTEM. SPLICES, TAPS, AND TERMINALS SHALL BE MADE ONLY IN J BOXES, OUTLET BOXES AND PANELBOARDS.  2.5.3 THE E.C. SHALL ENSURE THE CONDUCTORS UTILIZED ARE IN KEEPING WITH GOOD PRACTICE FOR THE	<ul> <li>3.5.12 HEAT TRACE — FREEZER PIPE FREEZE PROTECTION (WHEN REQUIRED):</li> <li>HEATING CABLE: FURNISH RAYCHEM 5XL1—CR WITH RAYCLIC—PC ELECTRICAL CONNECTION. XL TRACE BY TYCO THERMAL CONTROLS, LLC. FOR EXTRA INFORMATION CONCERNING HEAT TRACE SYSTEM</li> </ul>	7. ELECTRICAL POWER AND LIGHTING SYSTEMS 7.1 ELECTRICAL POWER (COMPLETEION REQUIREMENTS):		
CIRCUIT/PROTECTIVE DEVICES EMPLOYED. THE NEUTRAL CONDUCTOR (WHERE USED) SHALL HAVE THE SAME AMPACITY AS THE ASSOCIATED PHASE.	CONTACT SAN PETERSEN WITH INDUSTRIAL HEATER (901–382–4761).  • CIRCUIT BREAKER: PROVIDE "SQUARE-D" Q0120EPD OR EQUIVALENT GFCI CIRCUIT BREAKER WITH 30mA TRIP.	7.1.1 DRAWINGS  CONSTRUCTION DOCUMENTS SHALL REQUIRE THAT WITHIN 30 DAYS AFTER THE DATE OF SYSTEM  ACCEPTANCE, RECORD DRAWINGS OF THE ACTUAL INSTALLATION SHALL BE PROVIDED TO THE BUILDING		
2.5.4 THE E.C. SHALL ENSURE THAT CIRCUIT AMPACITY AND SHORT CIRCUIT/OVERLOAD PROTECTION IS APPROPRIATE FOR THE EQUIPMENT BEING INSTALLED. UL LISTING CONDITIONS SHALL BE OBSERVED.  2.5.5 TO COMPLY WITH NEC/UL LISTING CONDITIONS, ROOFTOP UNITS MAY BE SHOWN WITH FUSED	NOTE:MECHANICAL CONTRACTOR TO INSTALL SELF REGULATING HEATING CABLE PER MANUFACTERER'S REQUIREMENTS ON CONDENSATE DRAIN LINES INSIDE FREEZER BOXES THAT ARE TO	OWNER, INCLUDING:  • A SINGLE-LINE DIAGRAM OF THE BUILDING ELECTRICAL DISTRIBUTION SYSTEM		
DISCONNECT SWITCHES:  2.5.5.1 ALL FUSES SERVING MOTOR LOADS WILL BE OF THE DUAL ELEMENT TYPE.	OPERATE AT OR BELOW 32 DEGREES F.  3.6 SERVICE/DISTRIBUTION EQUIPMENT: PANEL AND DISTRIBUTION PANEL SHALL BE "SQUARE—D", ALL SWITCH GEAR TO BE FURNISHED FROM	• FLOOR PLANS INDICATING LOCATION AND AREA SERVED FOR ALL DISTRIBUTION. 7.1.2 MANUALS		
2.5.5.2 DUE TO DIFFERENT INTERRUPTING CHARACTERISTICS, PANELBOARD CIRCUIT BREAKERS MAY BE RATED HIGHER THAN THE DUAL ELEMENT FUSES THEY SUPPLY TO ENSURE SUFFICIENT STARTING CURRENT.	GRAYBAR, U.N.O. FOR PRICING AND PLACING ORDERS, CONTACT '7-ELEVEN' FOR THE APPROPRIATE SALES DEPARTMENT.  3.6.1 MAIN POWER SWITCHES:	CONSTRUCTION DOCUMENTS SHALL REQUIRE THAT AN OPERATING MANUAL AND MAINTENANCE MANUAL BE PROVIDED TO THE BUILDING OWNER. THE MANUALS SHALL INCLUDE, AT A MINIMUM, THE FOLLOWING:		
2.5.6 WIRE SIZES LISTED ARE MINIMUM. CONDUCTORS SHALL BE SELECTED SUCH THAT THE MAXIMUM VOLTAGE DROP (AT FULL LOAD AMPS) SHALL NOT EXCEED THE FOLLOWING GUIDELINES:	THE MAIN PANEL POWER SWITCHES/CIRCUIT BREAKERS SHALL BE "SQUARE-D" TYPE I LINE, RATED AT 65,000 A.I.C. (MIN.) SWITCHES OR CIRCUIT BREAKERS SHALL BE LISTED AS INDICATED ON PLANS.	SUBMITTAL DATA STATING EQUIPMENT RATING AND SELECTED OPTIONS FOR EACH PIECE OF EQUIPMENT REQUIRING MAINTENANCE.		
2.5.6.1 PANEL FEEDERS2% OF CIRCUIT VOLTAGE AT SERVICE.  2.5.6.2 ALL BRANCH LOADS3% OF CIRCUIT VOLTAGE AT SERVICE.	NOTE:PANEL RATINGS REQUIRED FOR HIGHER A.I.C. REQUIREMENTS SHALL BE PRESENTED TO THE DISTRIBUTOR FOR MODIFICATIONS TO THE GEAR SUBMITTAL.  3.6.2 PANELBOARDS:	<ul> <li>OPERATION MANUALS AND MAINTENANCE MANUALS FOR EACH PIECE OF EQUIPMENT REQUIRING MAINTENANCE. REQUIRED ROUTINE MAINTENANCE ACTIONS SHALL BE CLEARLY IDENTIFIED.</li> <li>NAMES AND ADDRESSES OF AT LEAST ONE QUALIFIED SERVICE AGENCY.</li> </ul>		
2.5.6.3 TOTAL VOLTAGE DROP (SERVICE TO LOAD) 5% OF CIRCUIT VOLTAGE AT SERVICE.  2.5.7 SPECIAL NOTES ON SERVICES:	"SQUARE-D" PANELBOARDS USED IN SERIES WITH I-LINE CIRCUIT BREAKERS AND FITTED WITH "SQUARE-D" BRANCH CIRCUIT BREAKERS AS INDICATED ON PLANS. USE AN APPROPRIATE "SQUARE-D" CIRCUIT BREAKER WITH EACH PANEL. CIRCUIT BREAKERS SHALL BE TYPE QOXXX-"QO"-FRAME.	NOTE:ENFORCEMENT AGENCIES SHOULD ONLY CHECK TO BE SURE THAT THE CONSTRUCTION DOCUMENTS REQUIRE THIS INFORMATION TO BE TRANSMITTED TO THE OWNER AND SHOULD NOT EXPECT COPIES OF ANY OF THE MATERIAL.		
2.5.7.1 120/208V, 3—PHASE, WYE: THE E.C. SHALL CHECK THE REQUIREMENTS OF ALL EQUIPMENT AND WILL INSTALL AUTOTRANSFORMERS (BUCK AND BOOST TRANSFORMERS) AS REQUIRED.  2.5.8 THE E.C. SHALL PROVIDE DEDICATED CIRCUITS WITH ISOLATED GROUND FOR ALL CIRCUITS ORIGINATING	3.6.2.1 PANEL 'F', IF REQUIRED SHALL BE FED BY A "SQAURE—D" NO. 8903SQG2V02 CONTACTOR AND SHALL BE WIRED FOR EMERGENCY SHUT DOWN.  3.6.2.2 UPON COMPLETION OF WORK, E.C. SHALL PROVIDE A TYPED DIRECTORY IN EACH PANELBOARD.	7.2 LIGHTING SYSTEM FUNCTIONAL TESTING CONTROLS FOR AUTOMATIC LIGHTING SYSTEMS SHALL COMPLY WITH THIS SECTION.		
FROM PANEL S. THE PURITY OF THE ISOLATED GROUND SHALL BE MAINTAINED BY USING ONLY INSULATED GROUNDING CONDUCTORS AND ISOLATED GROUND. THE GROUNDING CONDUCTOR FOR THE ISOLATED GROUND SHALL NOT MAKE ELECTRICAL CONTACT WITH THE COMMON EQUIPMENT GROUND OR	INCLUCE SYSTEM VOLTAGE, PHASING, CIRCUIT NUMBERING AND DESCRIPTIONS.  3.6.3 WIREWAY: THE WIREWAY SHALL BE SIMILAR AND EQUIVALENT TO "SQUARE—D COMPANY" WIREWAY WITH	<ul> <li>7.2.1 FUNCTIONAL TESTING:</li> <li>PRIOR TO PASSING FINAL INSPECTION, THE REGISTERED DESIGN PROFESSIONAL SHALL PROVIDE EVIDENCE THAT THE LIGHTING CONTROL SYSTEMS HAVE BEEN TESTED TO ENSURE THAT CONTROL</li> </ul>		
ANY ITEM CONNECTED TO THE COMMON EQUIPMENT GROUND (I.E. CONDUITS, "J"-BOXES, SWITCH BOXES, ETC.) AT ANY POINT OTHER THAN AT THE SERVICE GROUNDING TERMINAL. SEE NEC 250.96(B).  2.6 WHEN REQUIRED, E.C. TO ENSURE INTEGRITY OF FIRE RATED WALLS WHERE ELECTRICAL EQUIPMENT	APPROPRIATE FITTING FOR THE PARTICULAR INSTALLATION. E.C. SHALL SIZE TO INSTALLATION IN ACCORDANCE WITH NEC, GOOD PRACTICE AND CODES IN EFFECT AT TIME OF INSTALLATION.  3.7 OVERCURRENT/SHORT CIRCUIT PROTECTIVE DEVICES:	HARDWARE AND SOFTWARE ARE CALIBRATED, ADJUSTED, PROGRAMMED AND IN PROPER WORKING CONDITION IN ACCORDANCE WITH THE CONSTRUCTION DOCUMENTS AND MANUFACTURER'S INSTRUCTIONS. FUNCTIONAL TESTING SHALL BE IN ACCORDANCE WITH SECTIONS C408.3.1.1 AND C408.3.1.2 FOR THE APPLICABLE CONTROL TYPE.		
PENETRATES WALLS. SEAL PER SPECIFICATIONS FOR FIRE STOPPING.  2.7 ALL PENETRATIONS THROUGH EXTERIOR WALLS ARE TO BE MADE WITH LB CONDUITS OF THE APPROPRIATE SIZE PER NEC. ALL PENETRATIONS ARE TO BE SEALED PER NEC. HORIZONTAL OR VERTICAL SUPPORTS FOR	3.7.1 PANELBOARD BRANCH/FEEDER CIRCUIT BREAKERS: ALL DOWNSTREAM BREAKERS MUST BE "SQUARE—D" TO MAINTAIN SERIES LISTING. IF FUSIBLE DISCONNECTS ARE USED, "SQUARE—D" PANEL BOARDS AND CIRCUIT BREAKERS SHALL BE USED.	7.2.2 OCCUPANT SENSOR CONTROLS: WHERE OCCUPANT SENSOR CONTROLS ARE PROVIDED, THE FOLLOWING PROCEDURES SHALL BE		
RACEWAYS ARE TO COMPLY WITH NEC. WIRE TIES ARE NOT TO BE USED, U.N.O.  3. MATERIALS: ALL MATERIALS AND DEVICES SHALL BE UL APPROVED AND SHALL CONFORM TO THE STANDARDS OF NEMA, NEC	3.7.2 GROUND FAULT CIRCUIT INTERRUPTER (GFCI) BREAKERS:  GROUND FAULT CIRCUIT INTERRUPTER (GFCI) TYPE CIRCUIT BREAKERS SHALL BE SIMILAR TO THE PANELBOARD CIRCUIT BREAKERS BUT WITH GROUND FAULT PROTECTION WITH MATCHING A.I.C. RATING.	<ul> <li>PERFORMED:</li> <li>CERTIFY THAT THE OCCUPANT SENSOR HAS BEEN LOCATED AND AIMED IN ACCORDANCE WITH MANUFACTURER RECOMMENDATIONS.</li> </ul>		
AND IEEE.  3.1 LIGHT FIXTURES: PER SCHEDULE ON ELECTRICAL PLAN.	GFCI BREAKERS SHALL BE UL APPROVED AS CLASS A DEVICES IN ACCORDANCE WITH UL STANDARD *943.	<ul> <li>FOR PROJECTS WITH SEVEN OR FEWER OCCUPANT SENSORS, EACH SENSOR SHALL BE TESTED.</li> <li>FOR PROJECTS WITH MORE THAN SEVEN OCCUPANT SENSORS, TESTING SHALL BE DONE FOR EACH</li> </ul>		
3.2 RACEWAYS: ALL CONDUIT SHALL BE EITHER RIGID STEEL OR ELECTRICAL METALLIC TUBING (EMT). FOR IN SLAB AND UNDERGROUND INSTALLATIONS, PVC OR RIGID STEEL SHALL BE USED. REFER TO FUELING SHEETS FOR APPROVED FUELING SYSTEMS CONDUIT. INSTALL PER NEC.	3.7.3 FUSES, MAIN SWITCHBOARD:  MAIN SWITCHBOARD FUSES, IF REQUIRED, SHALL BE CLASS "J" CURRENT LIMITING FUSES AS INDICATED  ON PLANS.	UNIQUE COMBINATION OF SENSOR TYPE AND SPACE GEOMETRY, WHERE MULTIPLES OF EACH UNIQUE COMBINATION OF SENSOR TYPE AND SPACE GEOMETRY ARE PROVIDED, NOT LESS THAN 10%, BUT IN NO CASE LESS THAN ONE OF EACH COMBINATION SHALL BE TESTED UNLESS THE CODE OFFICIAL OR DESIGN PROFESSIONAL REQUIRES A HIGHER PERCENTAGE TO BE TESTED.		
3.3 FITTINGS AND BUSHINGS: ALL REQUIRED BENDS, FITTINGS, JUNCTION BOXES, ETC., WHETHER OR NOT THEY ARE SHOWN ON THE DRAWINGS, SHALL BE INSTALLED TO SATISFY ALL APPLICABLE ELECTRICAL CODES AND STANDARDS OF GOOD PRACTICE. ALL CONDUCTORS ENTERING/LEAVING A CONDUIT OR RACEWAY SHALL BE	3.7.4 FUSES, EQUIPMENT: EQUIPMENT FUSES, IF REQUIRED, SHALL BE OF THE DUAL ELEMENT, TIME DELAY VARIETY AS INDICATED ON PLANS. FUSES FOR HVAC/REFRIGERATION SHALL BE SIMILAR AND EQUIVALENT TO COOPER BUSSMANN FUSE TYPE LPN-RK-SP, CLASS RK1 FOR THE APPROPRIATE AMPERAGE.	FOR OCCUPANT SENSOR CONTROLS TO BE TESTED, VERIFY THE FOLLOWING:		no date remarks
AFFORDED ABRASION PROTECTION BY AN ADEQUATE BUSHING OR OTHER APPROVED MEANS.  3.4 OUTLET BOXES: SHALL BE STANDARD, STAMPED GALVANIZED STEEL BOXES; "J"-BOXES AND OUTLET BOXES USED AS A PULL BOX SHALL BE PROVIDED WITH A SUITABLE COVER OF SAME MATERIALS AS BOX.	3.8 SPD SHALL BE PROVIDED BY GRAYBAR.  3.9 CONDUCTORS:	<ul> <li>WHERE OCCUPANT SENSOR CONTROLS INCLUDE STATUS INDICATORS, VERIFY CORRECT OPERATION.</li> <li>THE CONTROLLED LIGHTS TURN OFF OR DOWN TO THE PERMITTED LEVEL WITHIN THE REQUIRED TIME.</li> </ul>		REVISIONS
				7-ELEV
				STORE #4
				SWC OF ST JOHNS PKWY & EMERS PALM BAY, FL
				PROJECT NO: 2024.03 DATE: APRIL 28, 2024
				E3.0 ELECTRICAL SPECIFI

INTERPLAN INTERPLAN LLC

AR99238 CA 8660

ARCHITECTURE ENGINEERING PERMITTING

NTRAL PKWY, STE 4000 NTE SPRINGS, FL 32701 407.645.5008

CUMENT IS NOT GULATORY AL, PERMITTING, STRUCTION.



ELEVEN E #42659

JOHNS HERITAGE & EMERSON DR

BAY, FL 32904

: 2024.0313 28, 2024

AL SPECIFICATIONS

CHECKED: SN DRAWN: SB ANGMEN - 09/16/2025 4:23:45 PM