

ALDI Inc. - Coconut Crossing, FL

Store No. 50
12850 Northlake Boulevard
Coconut Crossing, FL 33412

ARCHITECT'S JOB NUMBER: 22-0267A
ISSUE DATE: 07/08/24



SITE PLAN APPROVAL

COUNTY PROJECT NUMBER: ADMN-23-09-0033
AMENDMENT NUMBER: ADMN-25-05-0058

PROJECT SUMMARY

THIS PROJECT CONSISTS OF THE CONSTRUCTION OF A GROUND-UP ONE STORY BUILDING FOR OCCUPANCY BY ALDI FOOD MARKET.

CIVIL ENGINEER OF RECORD:

Thomas Engineering Group
Ryan O. Thomas, PE
6300 NW 31ST Ave.
Fort Lauderdale, FL 33309
(954) 202-7000
(954) 202-7070 Fax
Contact: Frank Youngman, PE
(954) 202-7000
fyoungman@thomaseg.com

STRUCTURAL ENGINEER OF RECORD:

APD Engineering & Architecture, PLLC
615 Fishers Run
Victor, NY 14564
Brent Powell, PE, LEED AP
(585) 742-2222
(585) 924-4914 Fax
Contact: Steven Flint, PE
(585) 742-0235
sflint@apd.com

MECHANICAL ENGINEER OF RECORD:

APD Engineering & Architecture, PLLC
615 Fishers Run
Victor, NY 14564
Kenneth Rea, PE
(585) 742-2222
(585) 924-4914 Fax
Contact: Kenneth Rea, PE
(585) 869-9649
krea@apd.com

ELECTRICAL ENGINEER OF RECORD:

APD Engineering & Architecture, PLLC
615 Fishers Run
Victor, NY 14564
Kenneth Rea, PE
(585) 742-2222
(585) 924-4914 Fax
Contact: Kenneth Rea, PE
(585) 869-9649
krea@apd.com

LOCATION MAP:

PROJECT LATITUDE: 26.8118
PROJECT LONGITUDE: -80.2374



NOTES

NOTE: THESE DRAWINGS ARE PART OF THE CONTRACT DOCUMENTS AS DESCRIBED IN THE PROJECT MANUAL. IN ANY AND ALL CONFLICTS BETWEEN THE DRAWINGS AND THE TECHNICAL SPECIFICATIONS, THE MOST STRINGENT REQUIREMENT WILL GOVERN AND THE G.C. SHALL COORDINATE WITH THE ALDI REPRESENTATIVE.

THESE DOCUMENTS ARE FOR THE SOLE PURPOSE OF INITIAL BUILDING PERMIT SUBMITTAL ONLY. ANY COMMENTS, REVISIONS OR CORRECTIONS BASED ON BUILDING DEPARTMENT REVIEW AND/OR BUILDING CODE INTERPRETATION ITEMS ARE THE SOLE RESPONSIBILITY OF THE OWNER AND REGIONAL ARCHITECT WILL NOT BE HELD LIABLE FOR ANY CHANGE ORDERS RESULTING FROM THESE ITEMS. FINAL BID PRICES SHOULD NOT BE SUBMITTED UNTIL THE BUILDING PERMIT HAS BEEN ISSUED.

DRAWINGS ARE BASED ON ALDI VERSION 7.0ER PROTOTYPE RELEASED ON 05.30.24

Drawing Index

SHEET #	SHEET NAME	REVISION DATE							SHEET #	SHEET NAME	REVISION DATE								
		10/02/24	10/08/24	11/18/24	12/20/24	07/29/25	XX/XX/XX	XX/XX/XX			10/02/24	10/08/24	11/18/24	12/20/24	07/29/25	XX/XX/XX	XX/XX/XX		
G-001	Cover Sheet	X	X	X	X	X			P-001	Plumbing Schedules				X					
G-002	Code Review	X				X			P-101	Plumbing Floor Plan				X					
G-003	Accessibility Details					X			P-102	Plumbing Drainage Location Plan				X					
G-004	Accessibility Details					X			P-201	Enlarged Plumbing Plans				X					
G-005	Responsibility Schedule - Volume 2					X			P-301	Isometric Diagrams				X					
G-006	Responsibility Schedule - Appendix A			X		X			P-401	Plumbing Details				X					
G-007	Responsibility Schedule - Appendix B					X			FP-101	Fire Protection Floor Plan				X					
									FP-201	Fire Protection Legend & Details									
S-001	General Structural Notes (GSN)					X													
S-101	Foundation Plan					X			H-001	HVAC Schedules, Symbols & Notes	X			X					
S-102	Slab Plan								H-101	HVAC Floor Plan				X					
S-111	Roof Framing Plan					X													
S-112	High Roof & Canopy Framing Plans								SE-101	Site Lighting Electrical Plan									
S-301	Foundation Details					X			E-001	Electrical Material List & Notes			X	X					
S-302	Foundation Details					X			E-101	Lighting Plan	X	X	X	X					
S-303	Foundation Details					X			E-102	Lighting Schedules & Diagrams			X	X					
S-304	Foundation Details								E-201	Electrical Plan			X	X					
S-401	Steel Framing Sections & Details					X			E-301	Enlarged Electrical Plans			X	X					
S-402	Steel Framing Sections & Details								E-401	One-Line Diagram & Details			X	X					
S-403	Steel Framing Sections & Details								E-402	Electrical Panel Schedules			X	X					
S-404	Steel Framing Sections & Details					X			E-501	Electrical Details			X	X					
S-405	Steel Framing Sections & Details								E-502	Electrical Details			X	X					
S-406	Steel Framing Sections & Details					X													
S-407	Steel Framing Sections & Details					X			CLP-101	Fire Alarm Conduit Plan				X					
A-001	General Notes, Symbols, & Abbrev.					X			Deferred Submittals										
A-101	Floor Plan	X		X	X	X													
A-102	Keyed Notes Plan			X	X	X							Fire Suppression System Drawings						
A-111	Reflected Ceiling Plan			X	X	X							Fire Alarm System Drawings						
A-121	Roof Plan			X	X	X				Security System Drawings									
A-131	Operations Plan			X	X	X													
A-201	Exterior Elevations		X		X	X			Reference Drawings										
A-202	Exterior Elevations		X		X	X													
A-211	Interior Elevations					X						R0.0	General Notes and Specifications						
A-212	Interior Elevations					X						R1.0	Fixture Floor Plan						
A-213	Interior Elevations					X			R2.0	Refrigeration Plumbing Floor Plan									
A-214	Interior Elevations					X			R3.0	Refrigeration Mechanical Floor Plan									
A-215	Interior Elevations					X			R3.1	Piping Floor Plan, Legend, Roof Detail									
A-216	Interior Elevations			X		X			R4.0	Refrigeration Electrical Floor Plan									
A-301	Wall Sections					X			R4.1	EMS Ethernet Cabling									
A-302	Wall Sections					X			R4.2	EMS RS485 Cabling									
A-303	Wall Sections					X			R4.3	EMS Details									
A-304	Wall Sections					X			R4.4	EMS Details									
A-305	Wall Sections					X			R5.0	Case and Box Evaporator Details									
A-306	Wall Sections					X			R6.0	Fluid Cooler & Pump Station Details									
A-307	Wall Sections					X			R6.1	Pump Station Details									
A-401	Enlarged Plans			X		X			R7.0	Refrigeration Piping Details									
A-402	Enlarged Plans					X			R7.1	Refrigeration Piping Details									
A-501	Exterior Details					X													
A-502	Exterior Details					X													
A-503	Exterior Details					X													
A-504	Exterior Details					X													
A-505	Exterior Details					X													
A-506	Exterior Details					X													
A-507	Exterior Details					X													
A-511	Interior Details			X		X													
A-512	Interior Details					X													
A-513	Interior Details					X													
A-601	Door Schedules & Details	X				X													
A-602	Window Elevations & Details	X		X		X													
A-603	Finish Schedules & Notes			X		X													



Copyright © 2024
APD Engineering & Architecture
03/27/19 1224

Drawing Alteration

It is a violation of law for any person, unless acting under the direction of licensed Architect, Professional Engineer, Landscape Architect, or Land Surveyor to alter any item on this document in any way. Any licensee who alters this document is required by law to affix his or her seal and to add the notation "Altered By" followed by his or her signature and the specific description of the alteration or revision.

DO NOT SCALE PLANS

Copying, Printing, Software and other processes required to produce these prints can stretch or shrink the actual paper or layout. Therefore, scaling of this drawing may be inaccurate. Contact APD E&A with any need for additional dimensions or clarifications.

Issued: Date:

A Issued for Permit 07/08/24

B Issued for Bid 07/29/25

C

D

E

Revisions: Date:

1 AHJ Responses 10/02/24

2 AHJ Responses 10/08/24

3 Owner Changes 11/18/24

4 AHJ Responses 12/20/24

5 Owner Changes 07/29/25

6

7

8

9

10

11

12

PROJECT ARCHITECT/ENGINEER


Daniel Sargent

PROJECT LEAD

John Lynch

NOT FOR
CONSTRUCTION

Seal Seal

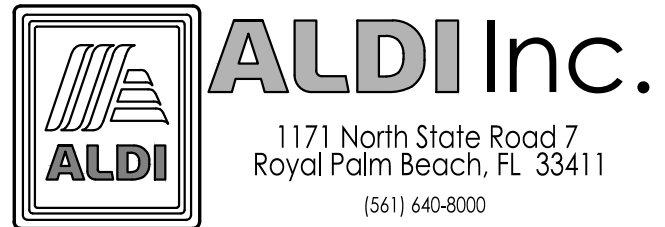

ALDI Inc. Store #: 50
Coconut Crossing, FL
12850 Northlake Boulevard
Palm Beach Gardens, FL 33412
Palm Beach County
Project Name & Location:

Cover Sheet

Drawing Name:

Prototype: Project No.

V7.08 LHRD 22-0267A

Type: GROUND UP

Drawn By: JWJ

Scale: G-001

As Noted Drawing No.

PROJECT INFORMATION:

THE BUILDING IS IN COMPLIANCE WITH THE:
FLORIDA BUILDING CODE 8TH EDITION (2023) BUILDING
FLORIDA BUILDING CODE 8TH EDITION (2023) ACCESSIBILITY
FLORIDA BUILDING CODE 8TH EDITION (2023) ENERGY CONSERVATION
FLORIDA BUILDING CODE 8TH EDITION (2023) MECHANICAL
FLORIDA BUILDING CODE 8TH EDITION (2023) PLUMBING
FLORIDA BUILDING CODE 8TH EDITION (2023) FUEL GAS
2020 NATIONAL ELECTRICAL CODE (NFPA 70)
FLORIDA FIRE PREVENTION CODE 8TH EDITION (2023)
NFPA 101, 2021 - WITH FLORIDA AMENDMENTS
NFPA 241, 2019

BUILDING PLANNING (CHAPTER 3.4.5.6):		
OCCUPANCY CLASSIFICATION (302.0 - 312.0)	MIXED OCCUPANCY GROUP M & S-2	
	(ALLOWABLE)	(ACTUAL)
NUMBER OF STORIES (TABLE 504.4):	2	1
BUILDING HEIGHT (TABLE 504.3):	60'-0"	28'-10"
BUILDING AREA - S1 (TABLE 506.2):	36,000	
FRONTAGE INCREASE (1i) (506.3.3):	1,899	
MAXIMUM ALLOWABLE SQUARE FOOTAGE (A1):	37,899	20,387

BUILDING AREA (506):

STREET FRONTAGE INCREASE:

- BUILDING PERIMETER: 612'-7"
- BUILDING PERIMETER FRONTING ON A STREET OR UNOCCUPIED SPACE: 282'-5"
- INCREASE TO MAX. ALLOWABLE AREA (1i): 21.1%

AREA INCREASE CALCULATOR			
BASE AREA		AREA INCREASE	
A ₁	A ₂	(NS * I ₁) / 100	
A ₁	36,000	1,899	

TYPES OF CONSTRUCTION (CHAPTER 6)

CONSTRUCTION CLASSIFICATION: VB

FIRE-RESISTANCE RATING REQUIREMENTS: (TABLE 601)

PRIMARY STRUCTURAL FRAME: 0 HR.

BEARING WALLS: 0 HR.

EXTERIOR: 0 HR.

INTERIOR: 0 HR.

NONBEARING WALLS AND PARTITIONS: 0 HR.

EXTERIOR: 0 HR.

INTERIOR: 0 HR.

FLOOR CONSTRUCTION: 0 HR.

ROOF CONSTRUCTION: 0 HR.

FIRE SEPARATION DISTANCE = X (feet) (TABLE 705.5)

- LESS THAN 5': 2 HR.
GREATER THAN OR EQUAL TO 5', LESS THAN 10': 1 HR.
GREATER THAN OR EQUAL TO 10', LESS THAN 30': 0 HR.
EQUAL TO OR GREATER THAN 30': 0 HR.

FIRE AND SMOKE PROTECTION FEATURES: (CHAPTER 7)

FIRE-RESISTANCE RATING OF STRUCTURAL MEMBERS (704):

EXTERIOR WALLS (705):

FIRE WALLS (706):

FIRE BARRIERS(707):

FIRE PARTITIONS (708):

SMOKE BARRIERS (709):

SMOKE PARTITIONS (710):

FLOOR AND ROOF ASSEMBLIES (711):

VERTICAL OPENINGS (712):

SHAFT ENCLOSURES (713):

PENETRATIONS (714):

JOINTS AND VOIDS (715):

OPENING PROTECTIVES (716):

DUCTS AND AIR TRANSFER OPENINGS (717):

CONCEALED SPACES (718):

FIRE-RESISTANCE REQUIREMENTS FOR PLASTER (719):

THERMAL-AND SOUND-INSULATING MATERIALS(720):

NOT REQUIRED

NOT REQUIRED

INTERIOR FINISHES AND DECORATIVE MATERIALS (CHAPTER 8)

INTERIOR WALL AND CEILING FINISH REQUIREMENTS BY OCCUPANCY (TABLE 803.1.1)						
OCCUPANCY/ GROUP	SPRINKLERED			NONSPRINKLERED		
	INTERIOR EXIT STAIRWAYS AND PASSAGEWAYS	CORRIDORS AND ACCESS STAIRWAYS AND RAMPS	ROOMS AND ENCLOSED SPACES	INTERIOR EXIT STAIRWAYS AND PASSAGEWAYS	CORRIDORS AND ACCESS STAIRWAYS AND RAMPS	ROOMS AND ENCLOSED SPACES
B, E, M, R-1	B	C	C	A	B	C
S	C	C	C	B	B	C

FIRE PROTECTION SYSTEMS (CHAPTER 9)

AUTOMATIC SPRINKLER SYSTEMS (903):

STANDPIPE SYSTEM (905):

PORTABLE FIRE EXTINGUISHERS (906):

FIRE ALARM AND DETECTION SYSTEMS(907):

EMERGENCY ALARM SYSTEMS (908):

SMOKE CONTROL SYSTEMS (909):

SMOKE AND HEAT REMOVAL(910):

FIRE COMMAND CENTER (911):

FIRE DEPARTMENT CONNECTIONS (912):

(REQUIRED) YES (PROVIDED) YES

(REQUIRED) NO (PROVIDED) NO

(REQUIRED) YES (PROVIDED) YES

(REQUIRED) NO (PROVIDED) YES

(REQUIRED) NO (PROVIDED) NO

(REQUIRED) NO (PROVIDED) NO

(REQUIRED) NO (PROVIDED) NO

(REQUIRED) NO (PROVIDED) NO

(REQUIRED) YES (PROVIDED) YES

MEANS OF EGRESS (CHAPTER 10)

OCCUPANT LOAD (1004):

OCCUPANCY LOADS (FBC 1004.0 TABLE 1004.5 & NFPA 101 TABLE 7.3.1.2)			
OCCUPANCY USE	SQUARE FEET/ OCCUPANT	TOTAL OCCUPANCY SQUARE FOOTAGE	OCCUPANTS
MERCANTILE	30	12,935	432
BUSINESS	150	1,004	7
STORAGE / STOCK	300	4,553	16
TOTAL OCCUPANT LOAD			455

MEANS OF EGRESS SIZING (1005):

USE GROUP OR SPACE DESCRIPTION	(A) OCCUPANT LOAD BY USE	(B) EGRESS WIDTH PER OCCUPANT (SECTION 1005.3)		EXIT WIDTH (IN.)*		REQUIRED WIDTH (SECTION 1005) (A X B)		ACTUAL WIDTH SHOWN ON PLANS	
		STAIR	LEVEL	STAIR	LEVEL	STAIR	LEVEL	STAIR	LEVEL
MERCANTILE	432	0.3	0.2	129.6	86.4				
BUSINESS	7	0.3	0.2	2.1	1.4				
STORAGE	16	0.3	0.2	4.8	3.2				
TOTAL:	455	0.3	0.2	136.5	91.0				

* Where more than one exit, or access to more than one exit, is required, the means of egress shall be configured such that the loss of one exit or access to one exit shall not reduce the available capacity to less than 50 percent of the total required capacity (Section 1005.5)

NUMBER OF EXITS AND EXIT ACCESS DOORWAYS (1006):

COMMON PATH OF EGRESS TRAVEL (TABLE 1006.2.1):

ACCESSIBLE MEANS OF EGRESS (1009) &

FBC ACCESSIBILITY CODE:

DOOR WIDTH (1010.1.1):

MINIMUM CLEAR OPENING:

MAXIMUM DOOR LEAF:

PANIC AND FIRE EXIT HARDWARE (1010.2.9):

EXIT SIGNS (1013.1):

HANDRAILS (1014.2):

GUARDS (1015.3):

MAXIMUM TRAVEL DISTANCE TO AN EXIT (TABLE 1017.2):

MINIMUM CORRIDOR WIDTH (1020.3):

MAXIMUM DEAD END CORRIDOR DISTANCE (1020.5):

(REQUIRED) 3 (PROVIDED)4
75' MERCANTILE 100' STORAGE

(REQUIRED) YES (PROVIDED) YES

32"

48"

(REQUIRED) NO (PROVIDED) YES

(REQUIRED) YES (PROVIDED) YES

34" H. MIN., 38" H. MAX.

42" H. IF ADJACENT GRADE IS GREATER THAN 30"

250' MERCANTILE 400' STORAGE (SRPINKLERED)

44" / 60" FOR H.C. TURN AROUND (AT 200' INTERVALS)

50' (SPRINKLERED) WHEN MORE THAN ONE EXIT IS REQUIRED

ACCESSIBILITY (FBC-A CHAPTERS 2 & 9)

CHECK-OUT AISLES (TABLE 227.2 & 904):

EMPLOYEE MANNED: (REQUIRED) 1 (PROVIDED) 4

SELF CHECKOUT (SCO): (REQUIRED) 2 (PROVIDED) 6

PLUMBING FIXTURE REQUIREMENTS:

MINIMUM NO. OF REQUIRED PLUMBING FIXTURES (FBCPC TABLE 2902.1)						
OCCUPANCY/ GROUP	WATER CLOSETS (URINALS)		LAVATORIES		BATHUBS/ SHOWERS	DRINKING FOUNTAINS
	MALE	FEMALE	MALE	FEMALE		
MERCANTILE (REQUIRED)	1 PER 500		1 PER 750		--	1 PER 1,000
MERCANTILE (PROVIDED)	1+1	1+1	1	1	--	2
						1 SERVICE SINK

AREA SUMMARY (FOR REFERENCE ONLY)


COCONUT CROSSING, FL AREA SUMMARY		
OCCUPANCY USE	ROOM NAME	SQUARE FOOTAGE
MERCANTILE (M)	SALES / VESTIBULE	12,623
	UNISEX 2	96
	UNISEX 1	96
	HALL	120
SUBTOTAL (MERCANTILE)		12,935
BUSINESS (B)	OFFICE	258
	BREAK ROOM	309
	eCOMMERCE	401
	CLOSET	36
SUBTOTAL (BUSINESS)		1004
STORAGE / STOCK (S-2)	BACKROOM	2,568
	COOLER	1,338
	FREEZER	647
SUBTOTAL (STORAGE / STOCK)		4,553
SUBTOTAL (OCCUPANCIES)		18,492
EXTERIOR / INTERIOR WALLS / UNOCCUPIED SPACE		908
BUILDING SQUARE FOOTAGE		19,400
EXTERIOR CANOPY		987
TOTAL SQUARE FOOTAGE (INCLUDING CANOPY)		20,387

NOTE:
THIS FACILITY DOES NOT CONTAIN A BAKERY, A BUTCHER, A DELI, OR A FISH COUNTER. ALL FOOD IS PREPACKAGED AND THERE IS NO ON-SITE FOOD PREPARATION.

NOTE:
A RADIO SIGNAL STRENGTH SURVEY IS TO BE PROVIDED PRIOR TO FINAL TO VERIFY MINIMUM EMERGENCY RESPONDER RADIO COVERAGE HAS BEEN MET. IF A BDA SYSTEM IS DEEMED TO BE NEEDED, A SEPARATE PERMIT IS REQUIRED FOR THE INSTALLATION.

NOTE:
SEPARATE PERMITS ARE REQUIRED FOR FIRE ALARM, FIRE SPRINKLER, AND ACCESS CONTROL/CARD READER SYSTEMS.

NOTE:
A TRUSS PLACARD WILL BE PROVIDED IN ACCORDANCE WITH FLORIDA STATUE 633.01 (1).

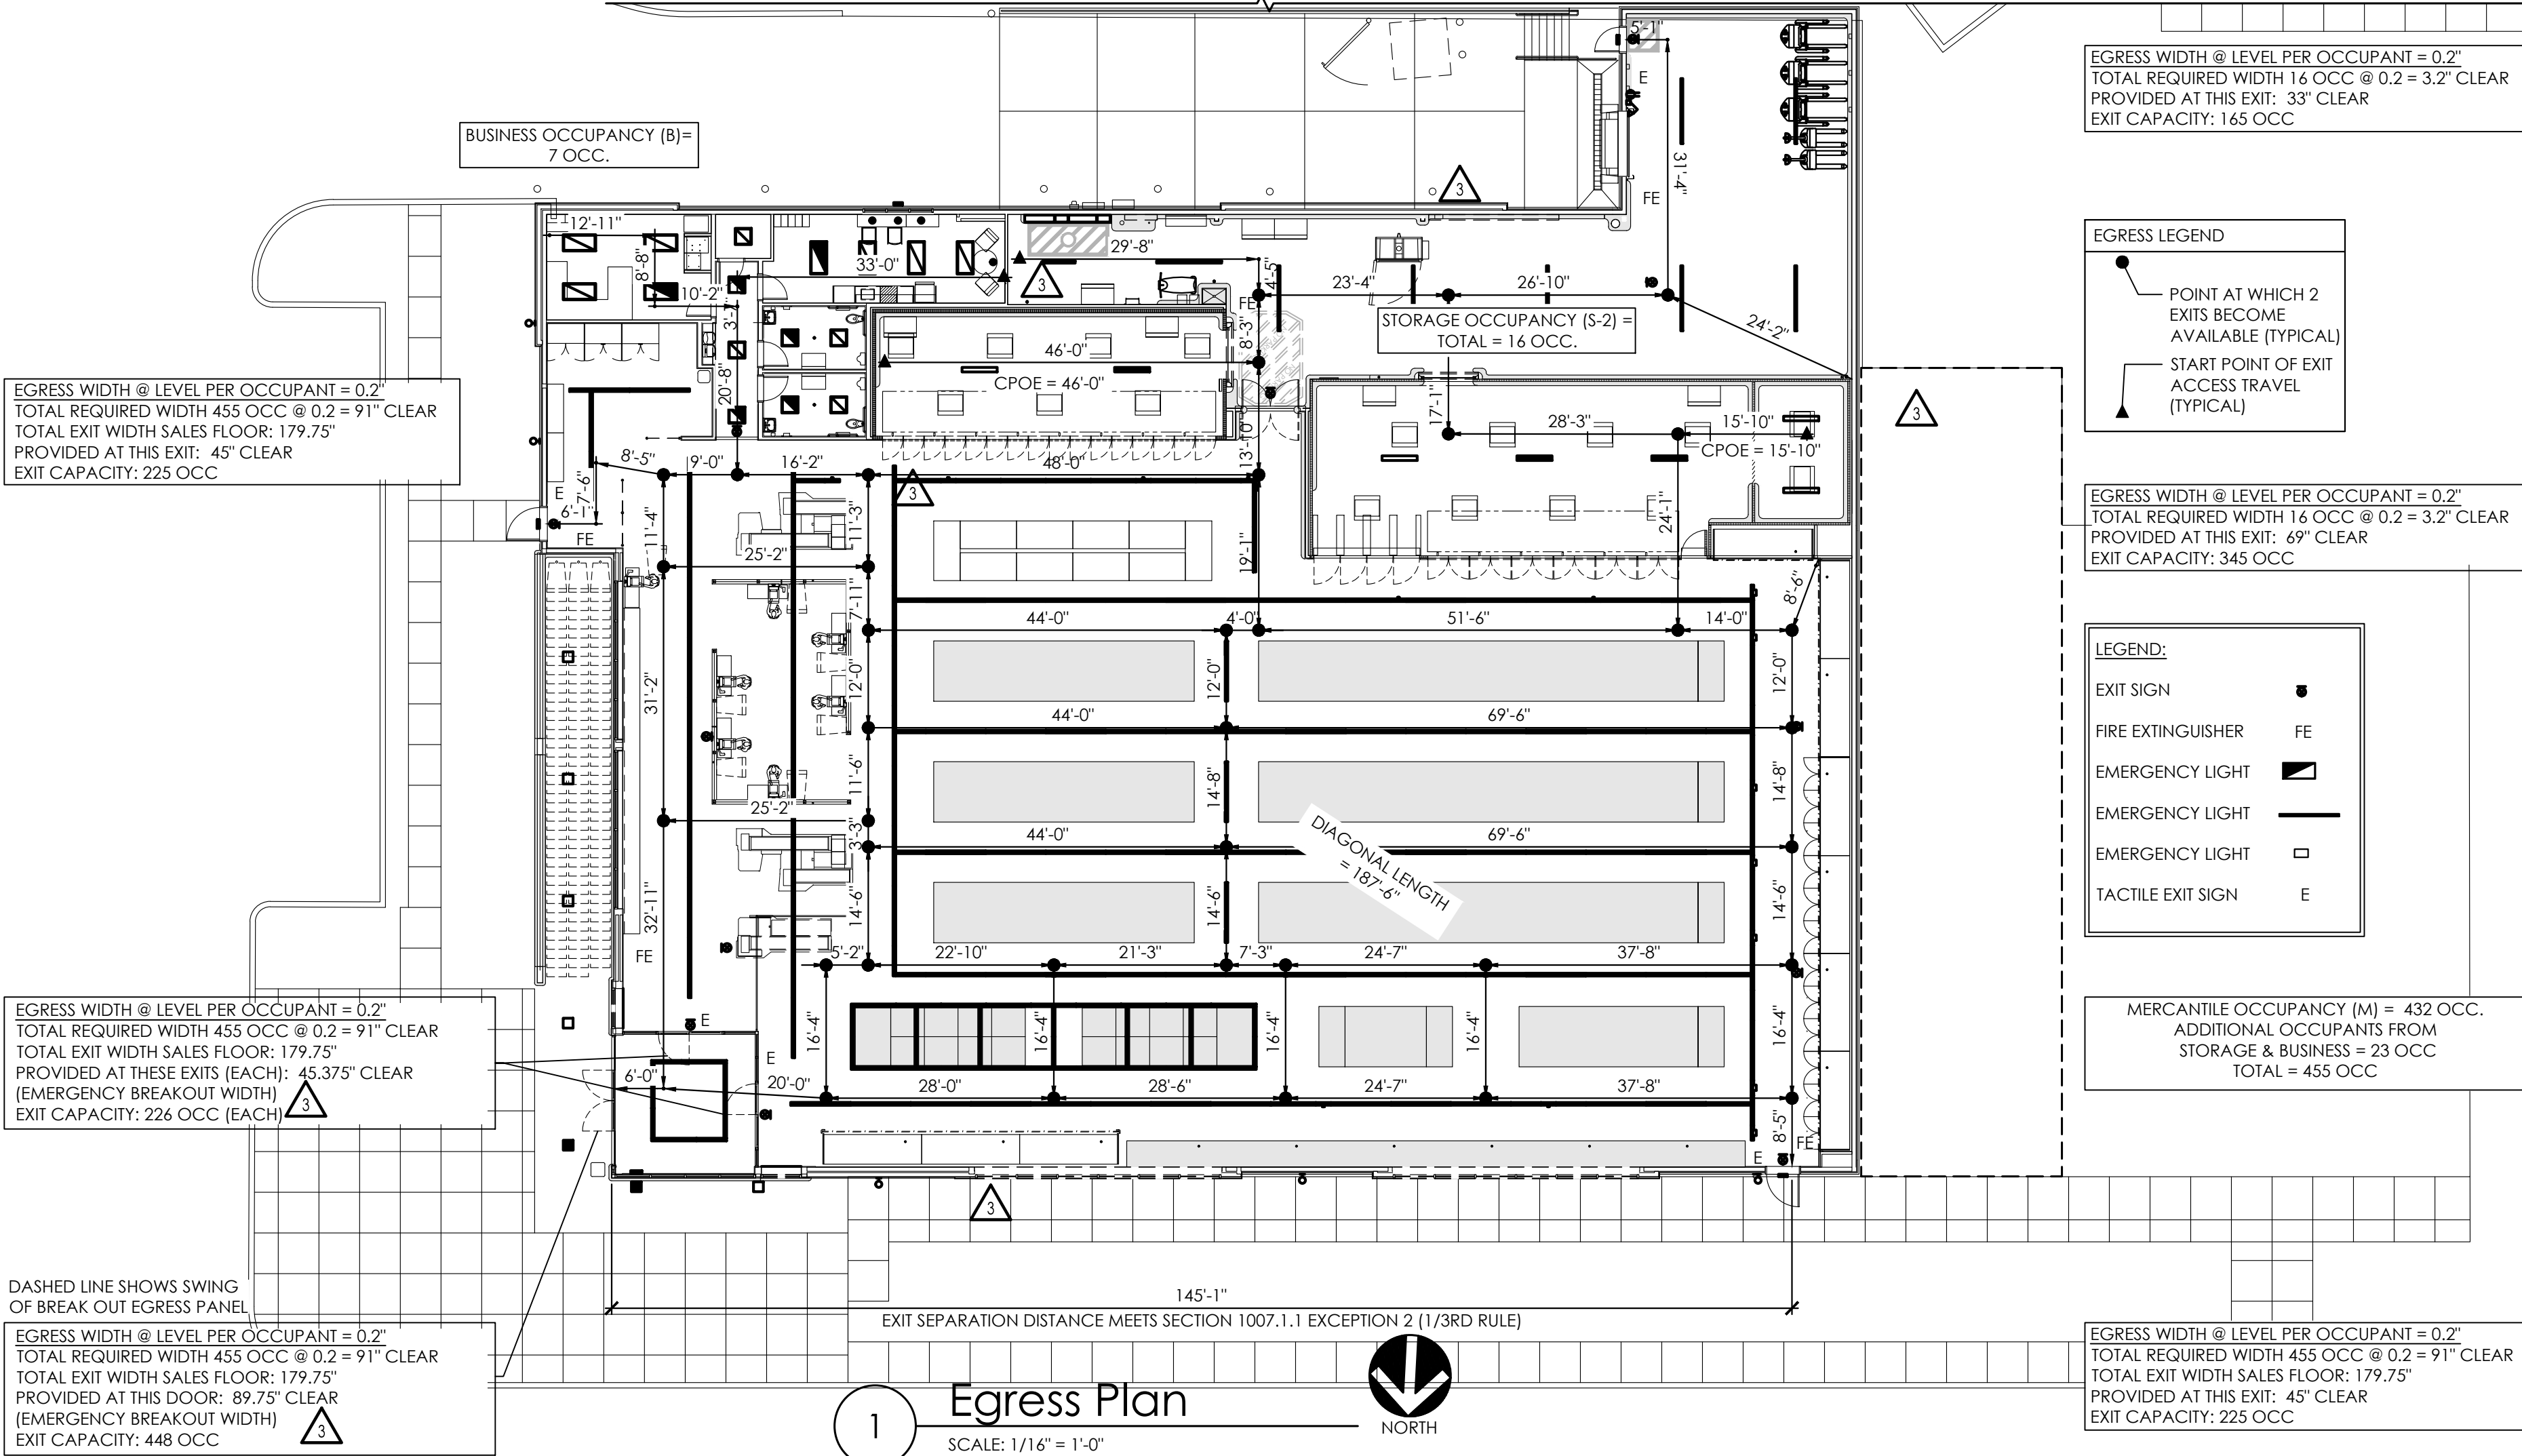

Egress Plan

SCALE: 1/16" = 1'-0"



APD
ENGINEERING
ARCHITECTURE
615 Fishers Run Victor, NY 14564
585.742.2222 - www.apd.com

Copyright © 2024

APD Engineering & Architecture
03/17/2019

Drawing Alteration

It is a violation of law for any person, unless acting under the direction of licensed Architect, Professional Engineer, Landscape Architect, or Land Surveyor to alter any item on this document in any way. Any licensee who alters this document is required by law to affix his or her seal and to add the notation "Altered By" followed by his or her signature and the specific description of the alteration or revision.

DO NOT SCALE PLANS

Copying, Printing, Software and other processes required to produce these prints can stretch or shrink the actual paper or layout. Therefore, scaling of this drawing may be inaccurate. Contact APD E&A with any need for additional dimensions or clarifications.

Issued: Date:

A Issued for Permit 07/08/24

B Issued for Bid 07/29/25

C

D

E

Revisions: Date:

1 AHJ Responses 10/02/24

2 Owner Changes 11/18/24

3 Owner Changes 07/29/25

4

5

6

7

8

9

10

11

12

PROJECT ARCHITECT/ENGINEER

Daniel Sargent

PROJECT LEAD

John Lynch

NOT FOR CONSTRUCTION

Seal Seal



ALDI Inc.
1171 North State Road 7
Royal Palm Beach, FL 33411
(561) 640-8000

ALDI Inc. Store #: 50

Coconut Crossing, FL

12850 Northlake Boulevard

Palm Beach Gardens, FL 33412

Palm Beach County

Project Name & Location:

Code Review

Drawing Name:

Prototype:

V7.08 LHRD

Type:

GROUND UP

Drawn By:

JWL

Scale:

As Noted


Project No.

22-0267A


G-002

Drawing No.



CODE REFERENCES ARE PER 2023 FBC - ACCESSIBILITY 8TH EDITION. REFER TO NOTED SECTIONS FOR MORE INFORMATION.

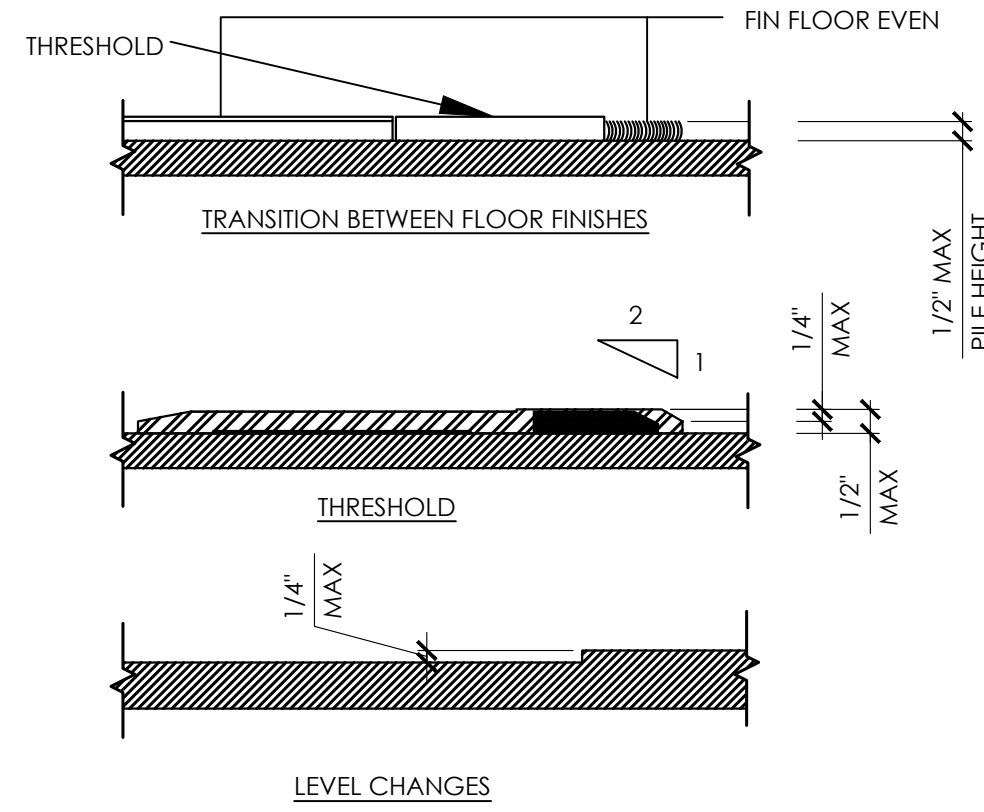


11 Threshold Requirements
SECTIONS 302; 303; 404.2.5

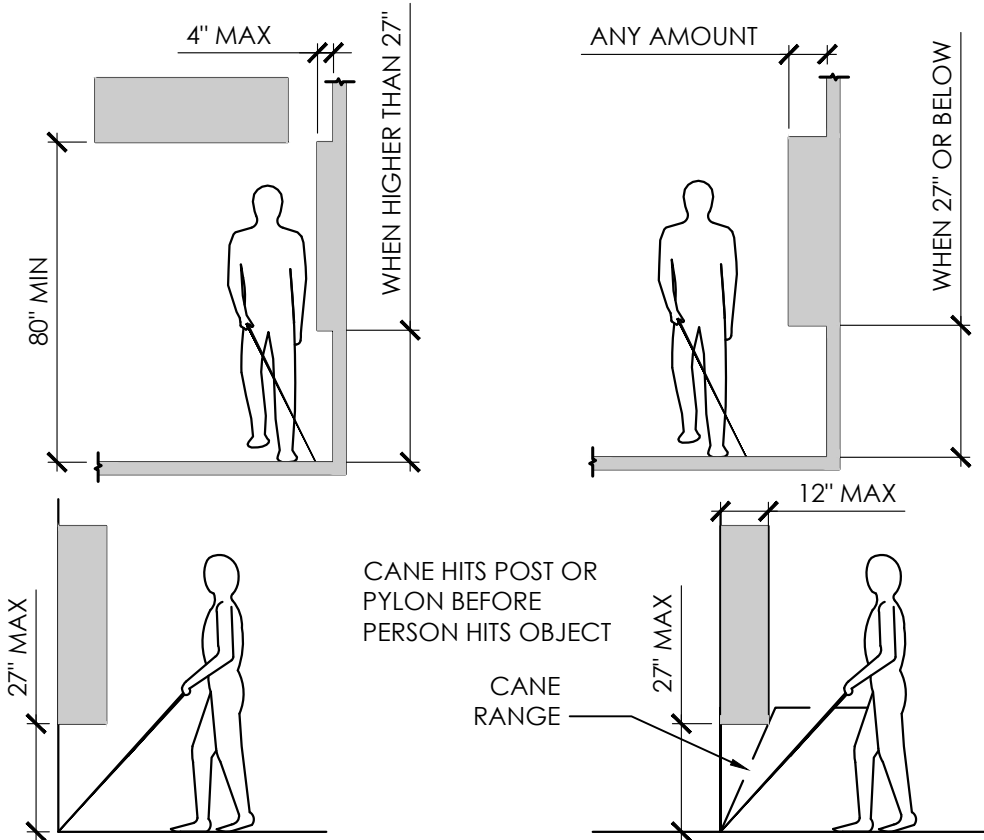


10 Protruding Objects
SECTIONS 307

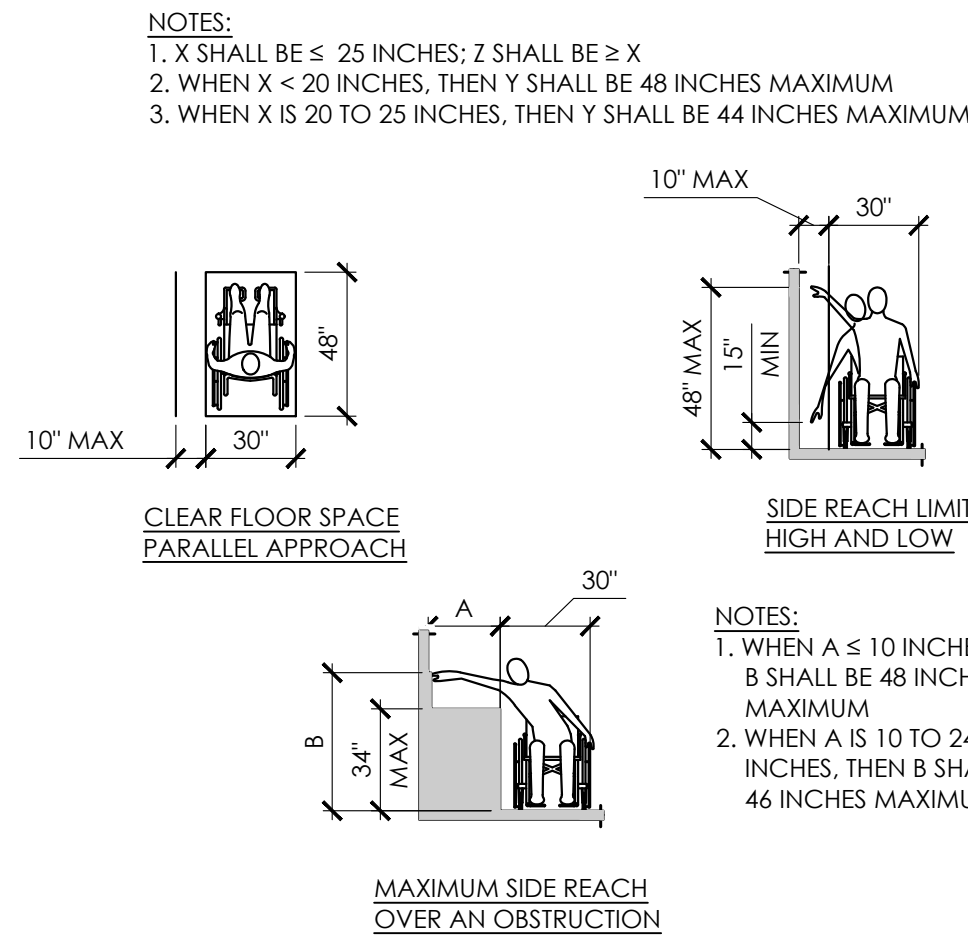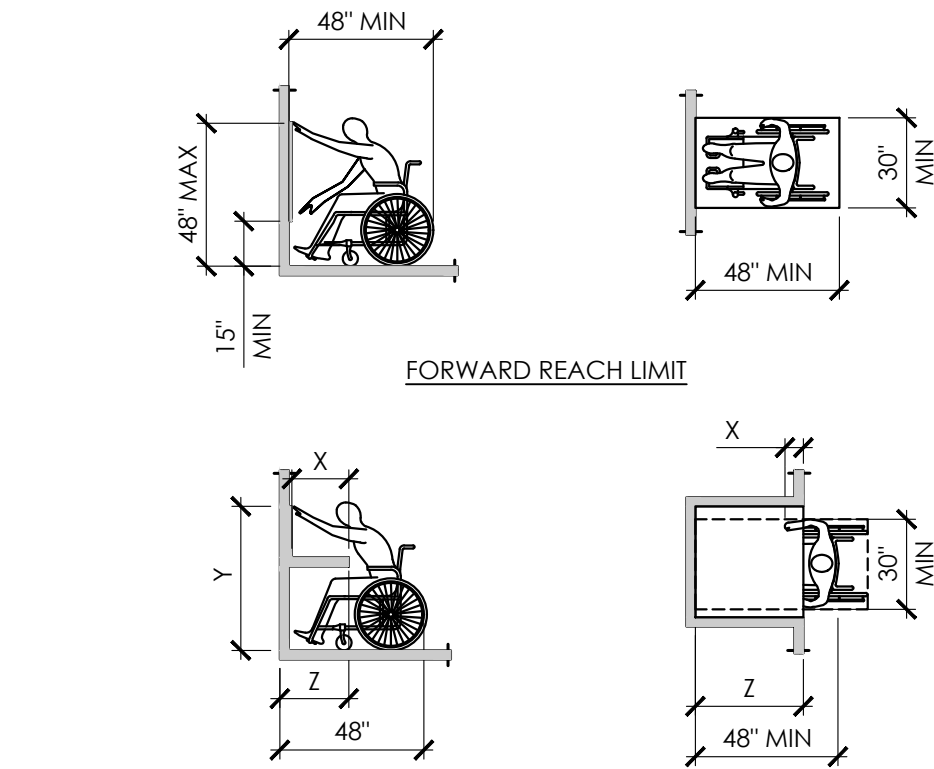


8 Reach Ranges
SECTION 308

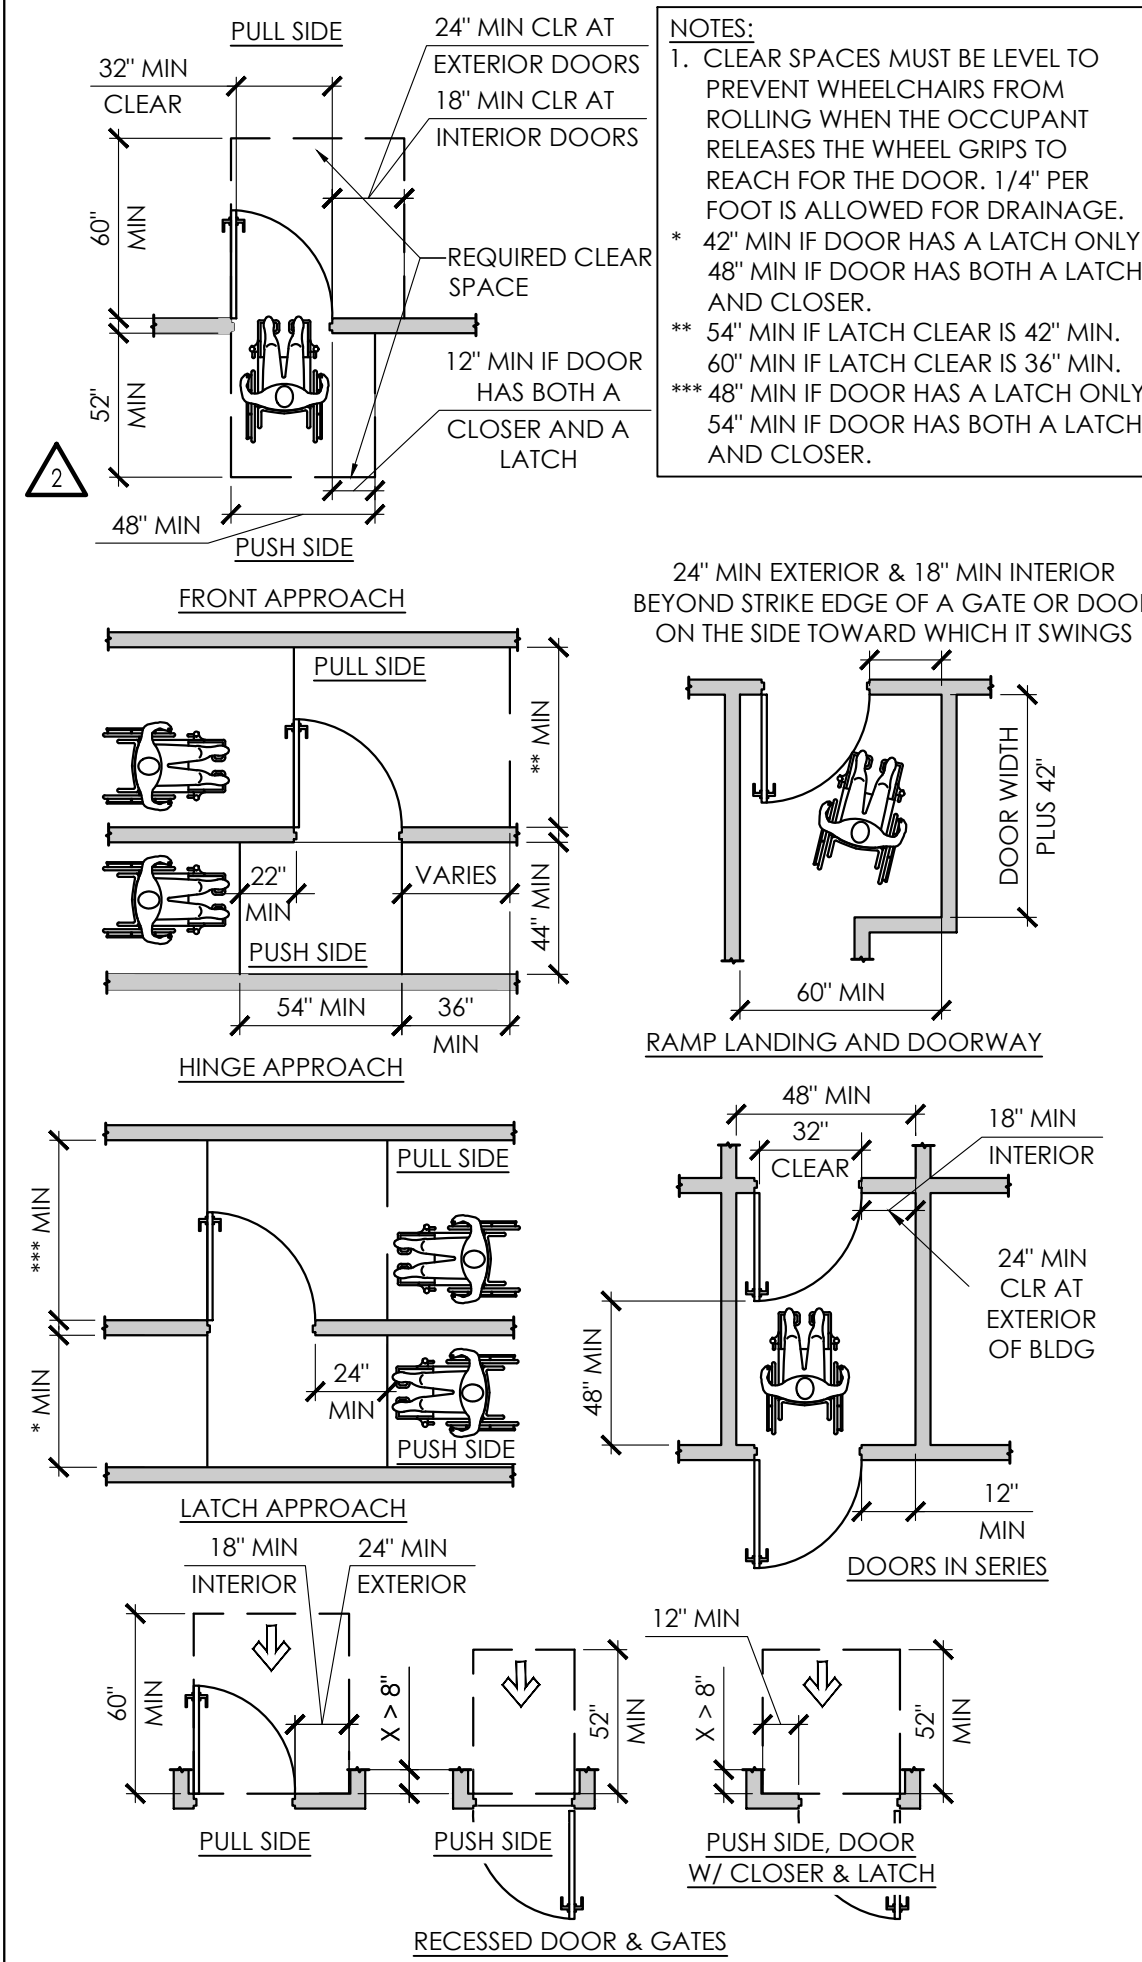

6 Door Clearances
SECTIONS 404.2.4; 404.3.2

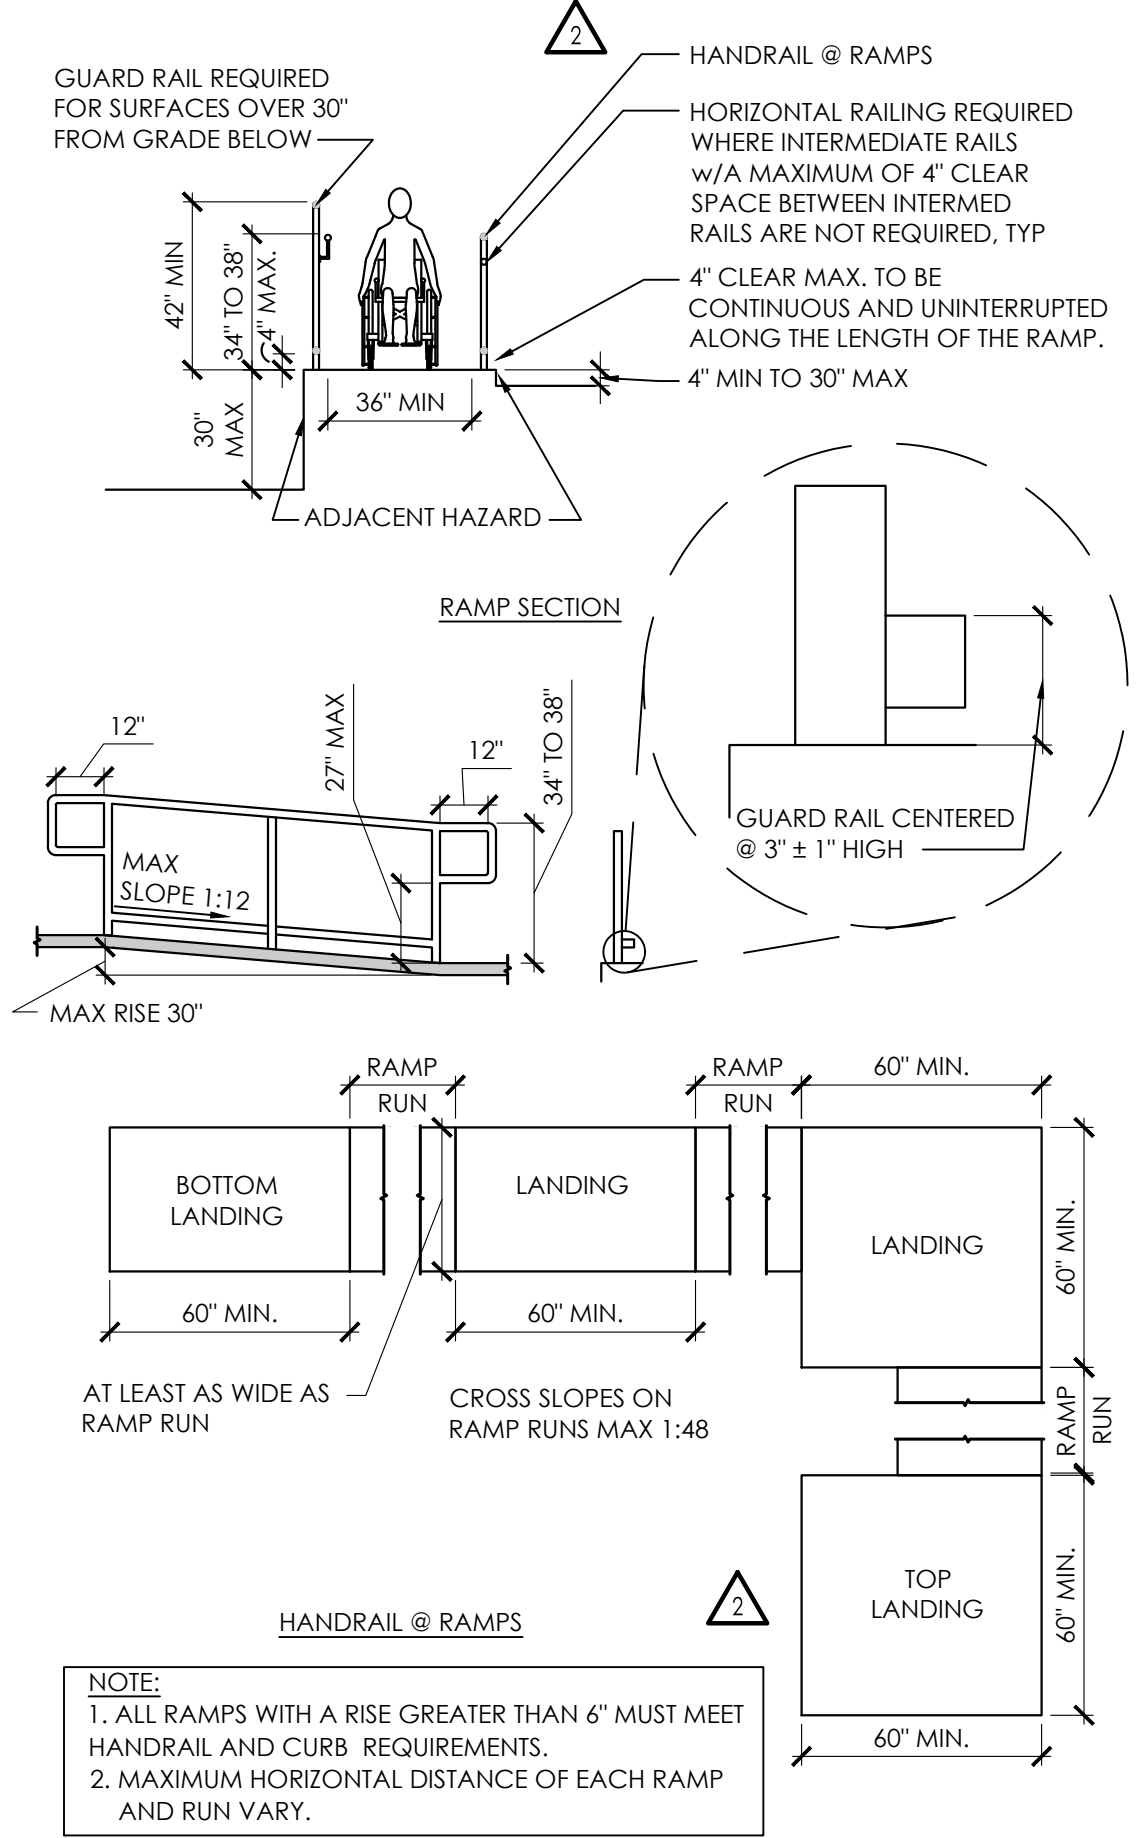


3 Ramp Requirements
SECTION 405

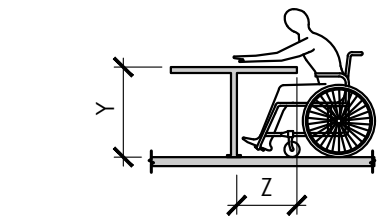


NOTES:
1. Y SHALL BE 28 INCHES MINIMUM 34 INCHES MAXIMUM HEIGHT ABOVE THE FLOOR
2. Z SHALL BE 25 INCHES MINIMUM


13 Dining Surfaces
Section 902.3

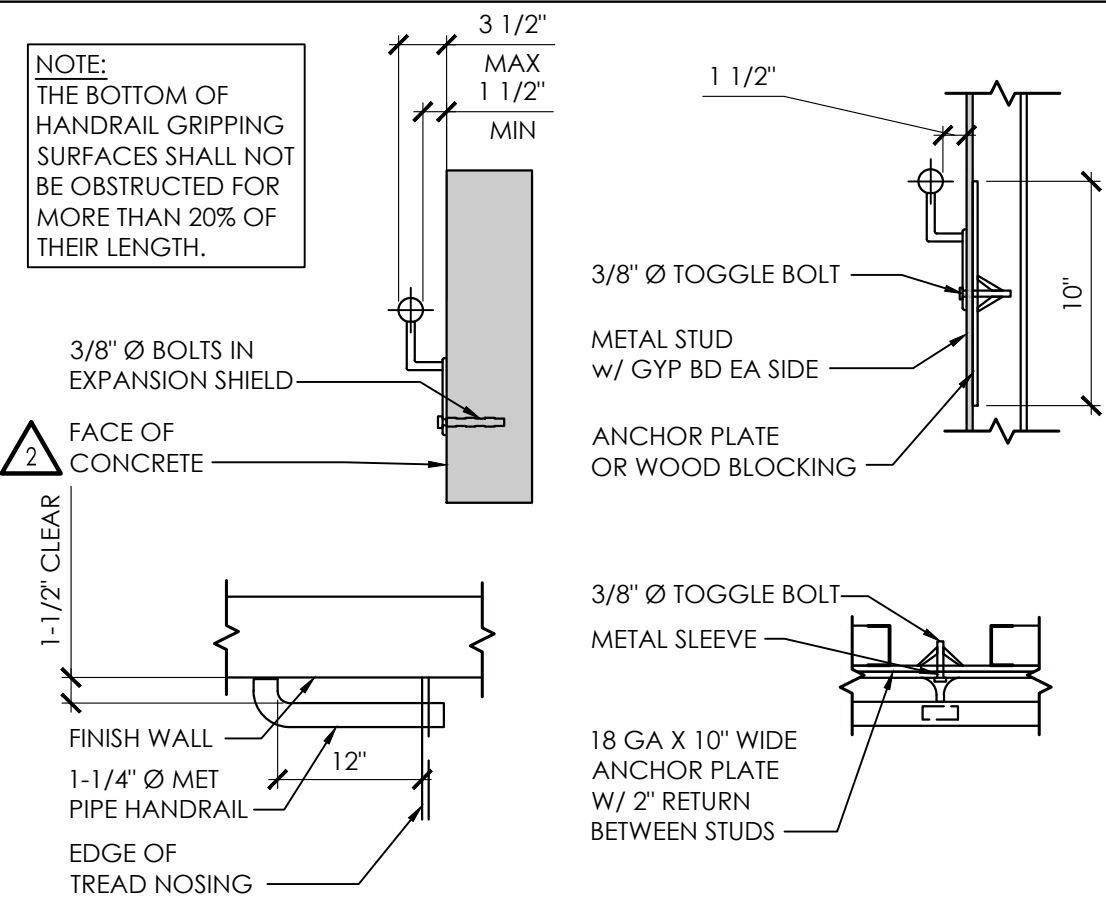


12 Handrail Requirements
SECTION 505

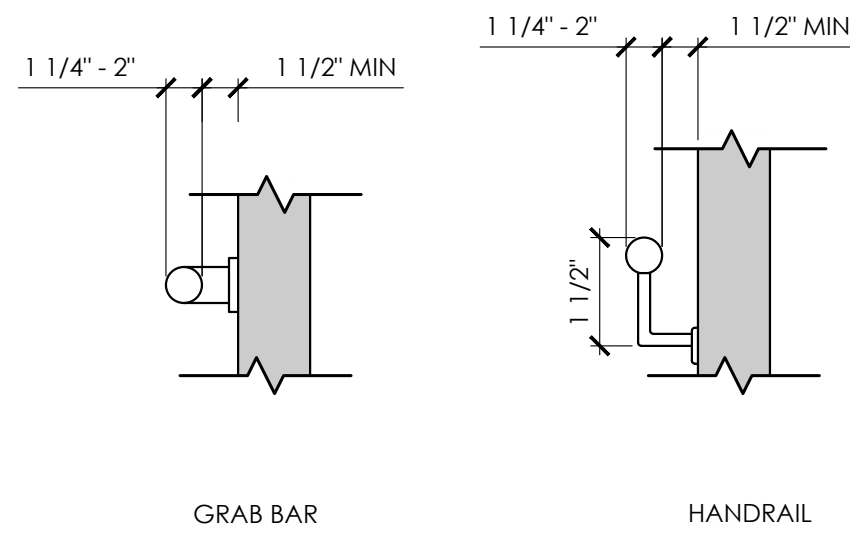


9 Handrail Clearance
SECTION 505.5

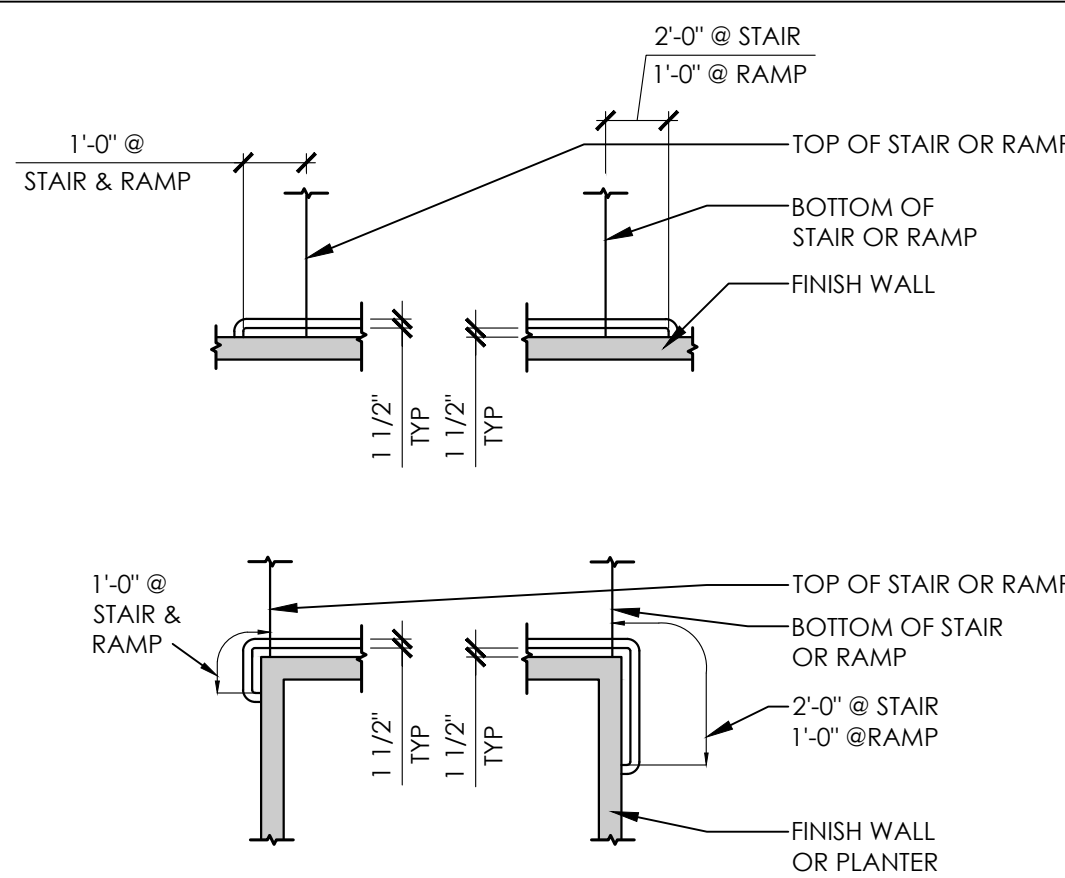


7 Handrails
SECTION 505

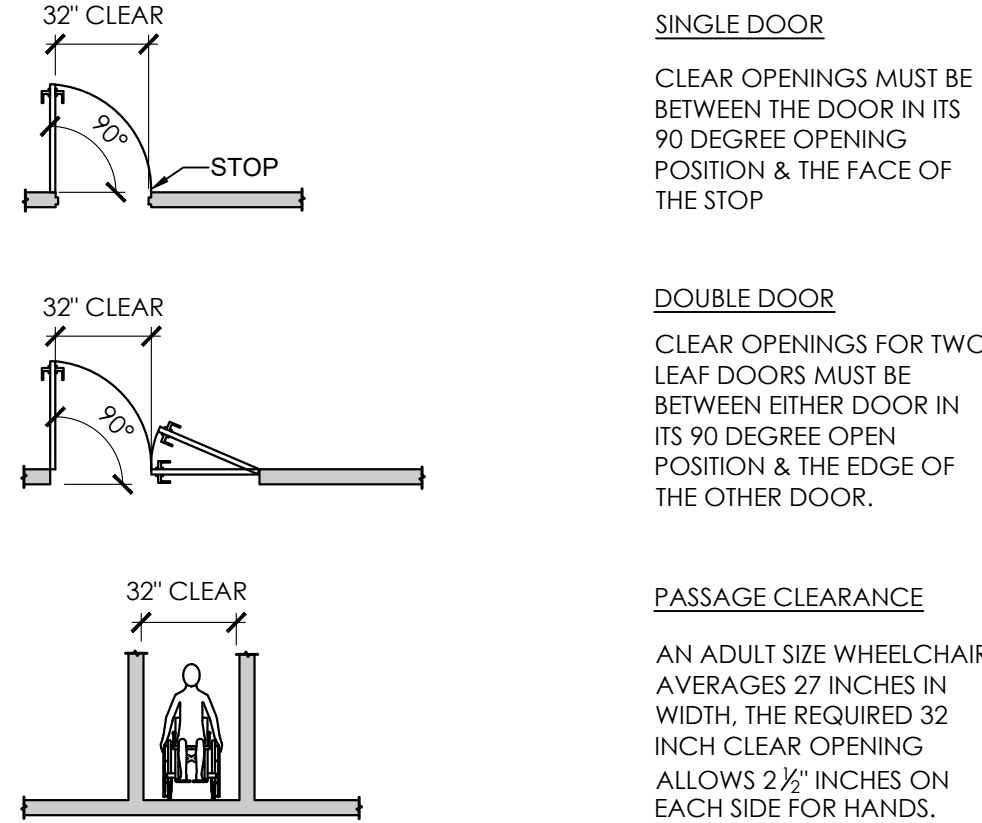


5 Door Widths
SECTIONS 403.5; 404.2.2 & 404.2.3

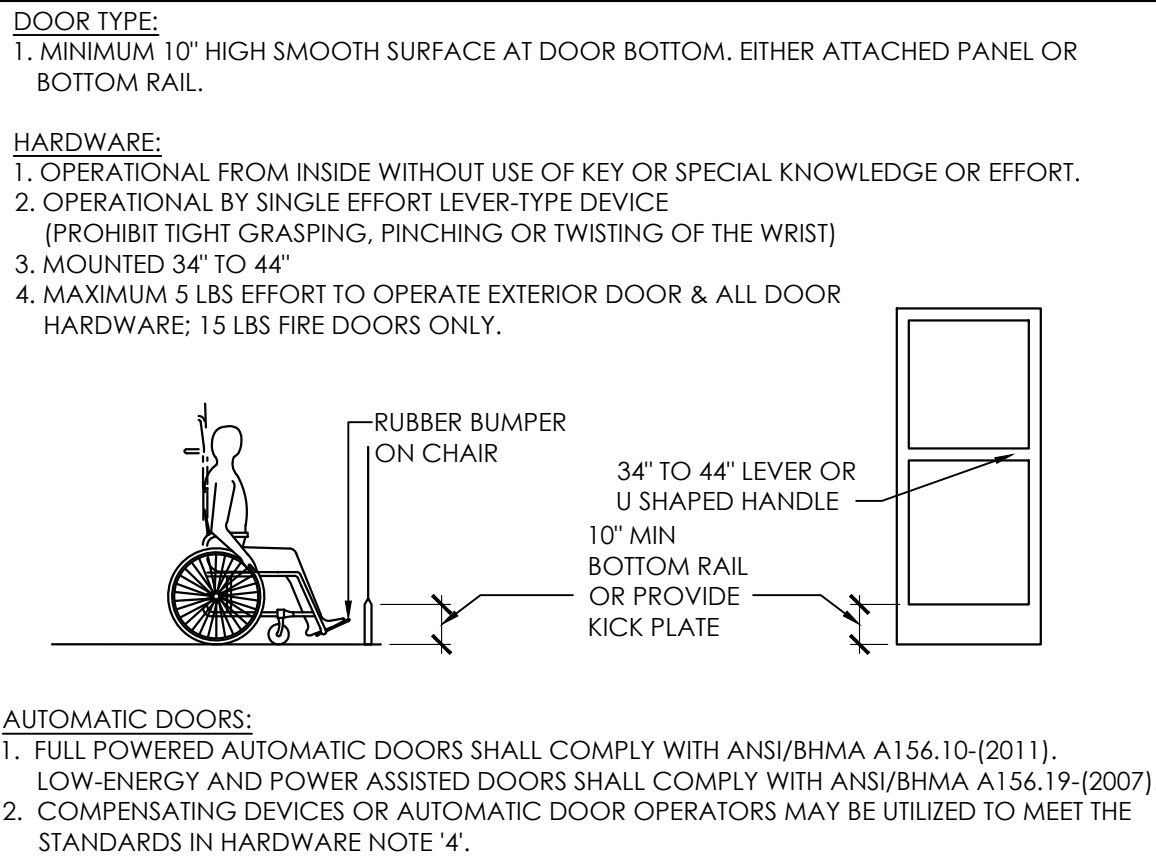

2 Door Requirements
SECTIONS 404.2.7; 404.2.10; 404.3

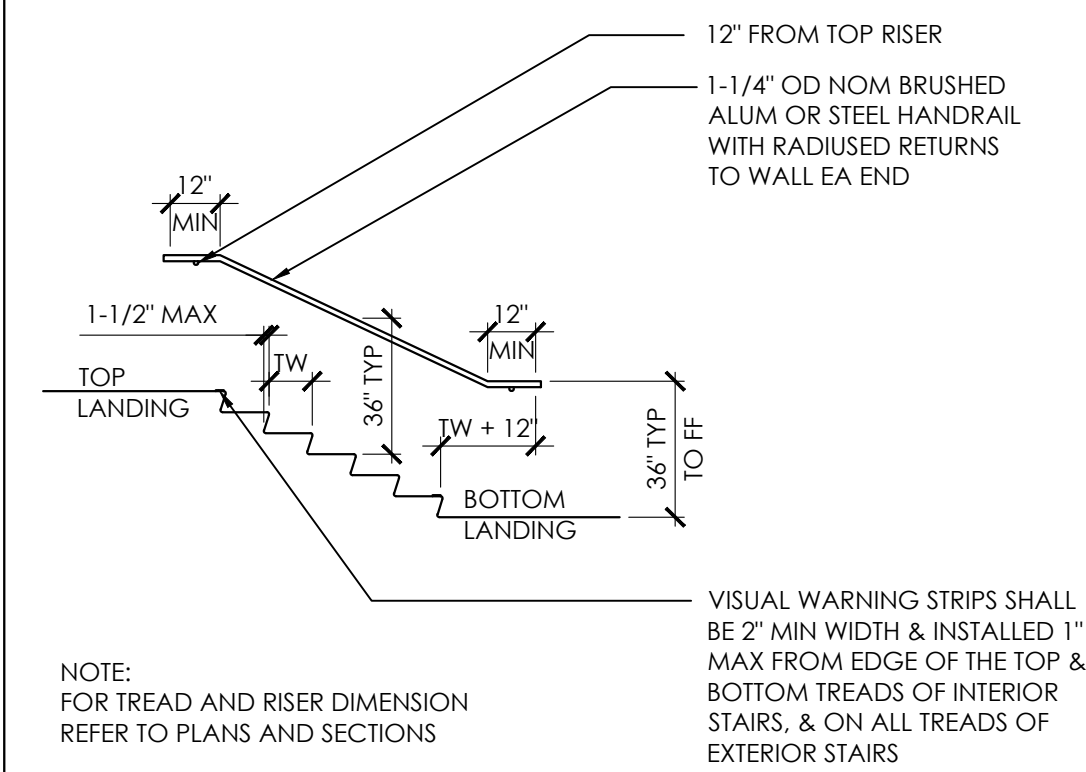

4 Stairways/Handrails
SECTIONS 504; 505

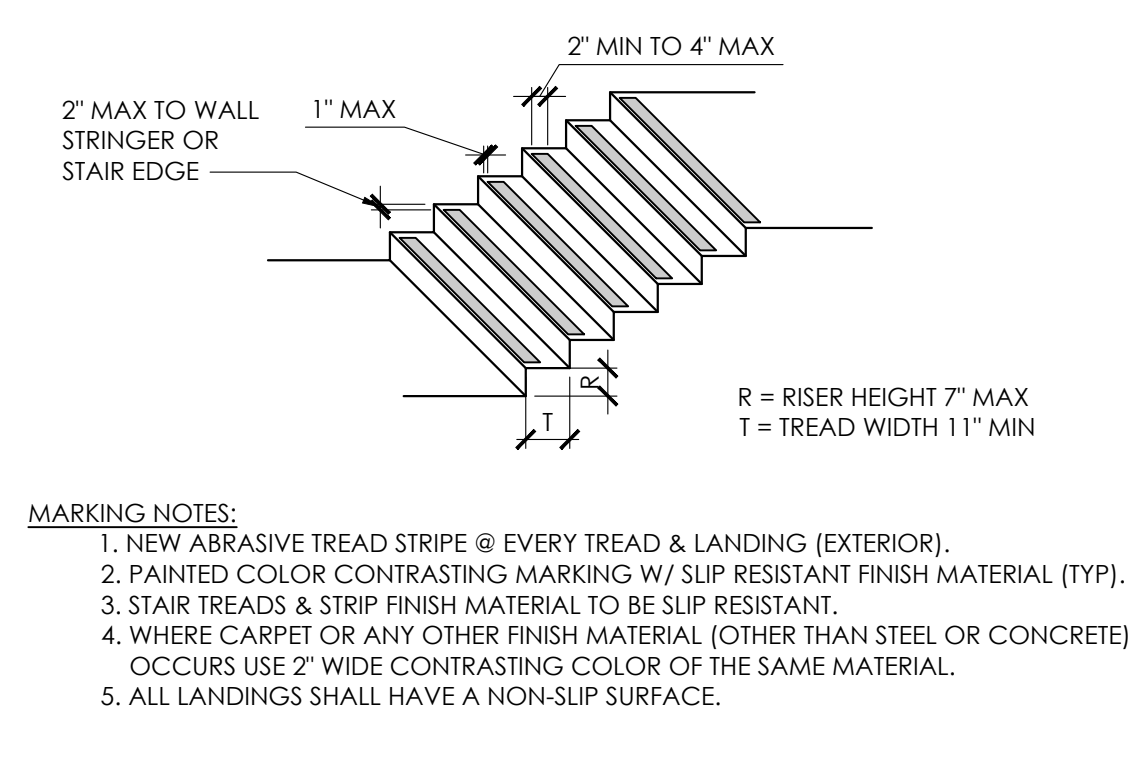

1 Stairways
SECTION 504

Copyright © 2024

APD Engineering & Architecture
03/17/2024

Drawing Alteration

It is a violation of law for any person, unless acting under the direction of licensed Architect, Professional Engineer, Landscape Architect, or Land Surveyor to alter any item on this document in any way. Any licensee who alters this document is required by law to affix his or her seal and to add the notation "Altered By" followed by his or her signature and the specific description of the alteration or revision.

DO NOT SCALE PLANS

Copying, Printing, Software and other processes required to produce these prints can stretch or shrink the actual paper or layout. Therefore, scaling of this drawing may be inaccurate. Contact APD E&A with any need for additional dimensions or clarifications.

Issued:	Date:
A Issued for Permit	07/08/24
B Issued for Bid	07/29/25
C	
D	
E	
Revisions:	Date:
1 Owner Changes	11/18/24
2 Owner Changes	07/29/25
3	
4	
5	
6	
7	
8	
9	
10	
11	
12	

PROJECT ARCHITECT/ENGINEER

Daniel Sargent

PROJECT LEAD

John Lynch

FOR NOT FOR
REFERENCE CONSTRUCTION

Seal Seal

ALDI Inc.
1171 North State Road 7
Royal Palm Beach, FL 33411
(561) 640-8000


ALDI Inc. Store #: 50
Coconut Crossing, FL 12850 Northlake Boulevard
Palm Beach Gardens, FL 33412
Palm Beach County
Project Name & Location:

Accessibility
Details


Drawing Name:

Prototype:	Project No.
V7.08 LHRD	22-0267A
Type:	
GROUND UP	
Drawn By:	
JWL	
Scale:	
As Noted	
Drawing No.	
G-003	

CODE REFERENCES ARE PER 2023 FBC - ACCESSIBILITY 8TH EDITION. REFER TO NOTED SECTIONS FOR MORE INFORMATION.

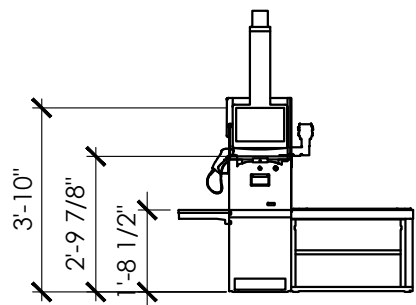

CHECK-OUT AISLES	
NUMBER OF CHECK-OUT AISLES OF EACH FUNCTION	MINIMUM NUMBER OF CHECK-OUT AISLES OF EACH FUNCTION REQUIRED TO COMPLY WITH ANSI A117.1(#904)
1 - 4	1
5 - 8	2
9 - 15	3
16+	3, PLUS 20% OF ADDITIONAL AISLES

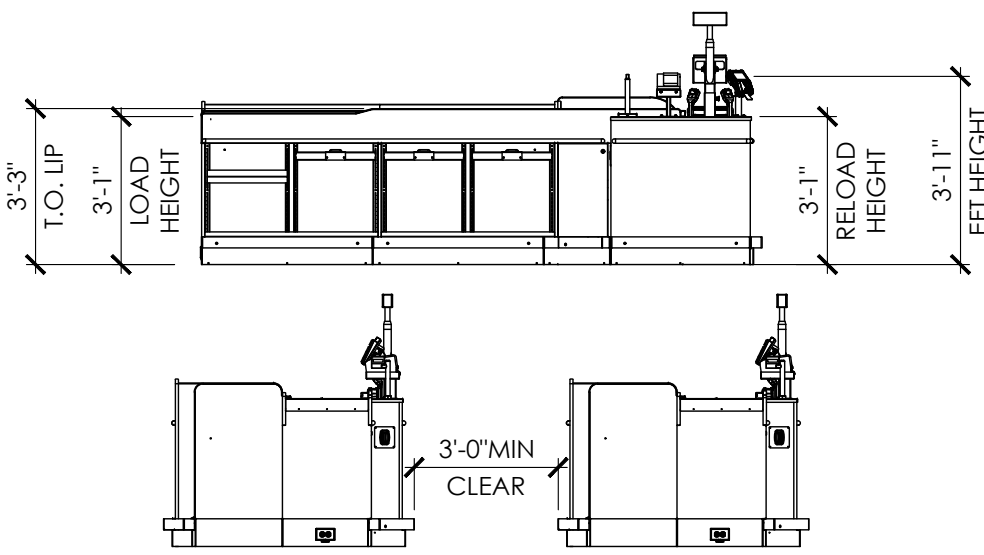


- NOTES:
- ALL PROVIDED CHECKLANES ARE ACCESSIBLE, AND THUS ARE NOT REQUIRED TO BE IDENTIFIED BY ANY ADDITIONAL SIGNAGE.
 - NO WRITING SURFACE IS REQUIRED AS STORES DO NOT ACCEPT PERSONAL CHECKS.

6 Checklane


SECTION 904

- NOTE:
- REFER TO 7/G-003 FOR DOOR APPROACH CLEARANCES
 - DW = DOOR WIDTH
 - 2" MIN WIDTH BECOMES 36" WHEN URINAL IS WITHIN AN ALCOVE WHERE THE DEPTH EXCEEDS 24".

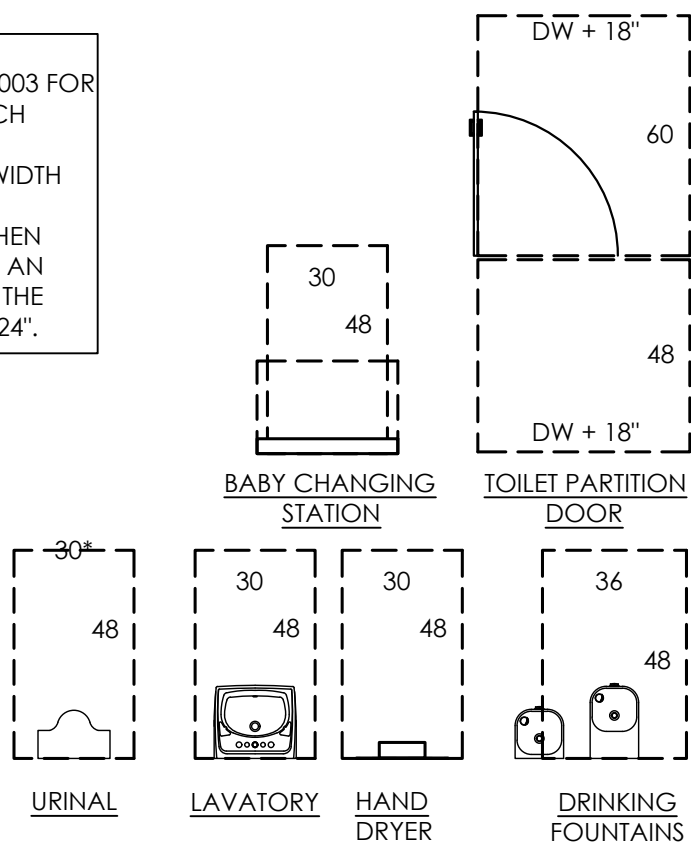

8 Fixture Clear Floor Area


SECTION 305

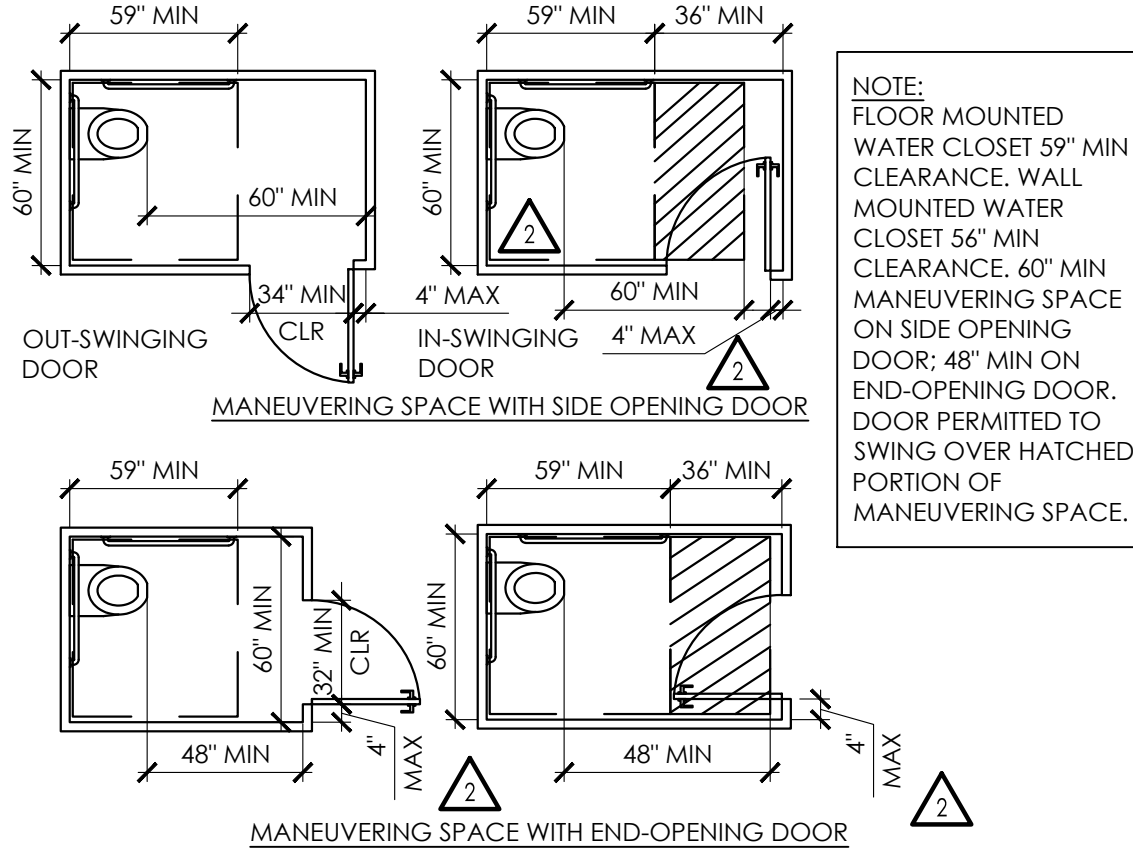

- NOTE:
- FLOOR MOUNTED WATER CLOSET 59" MIN CLEARANCE, WALL MOUNTED WATER CLOSET 56" MIN CLEARANCE, 60" MIN MANEUVERING SPACE ON SIDE OPENING DOOR; 48" MIN ON END-OPENING DOOR. DOOR PERMITTED TO SWING OVER HATCHED PORTION OF MANEUVERING SPACE.

7 Maneuvering Space

SECTION 604.8

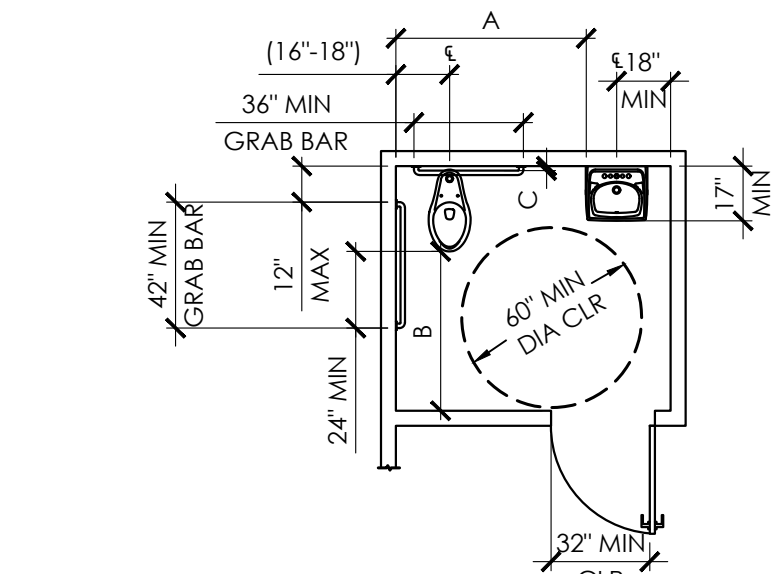

- DIMENSION NOTES:
- 60" CLR MIN FROM LAVATORY EDGE TO THE FAR WALL.
 - 48" MIN TO ENTRY DOOR.
 - THE SPACE BETWEEN THE WALL AND GRAB BAR SHALL BE 1 1/2".


- NOTE:
- PROVIDE PRIVACY DOOR LOCK WHEN IS A PRIVATE TOILET OF FOR UNISEX USE
 - GRAB BARS (REFER TO 9/ G-004)

5 Single Occupancy Toilet

SECTIONS 304; 305; 306; 603; 604; 606

BASIS OF DESIGN FOR INTERIOR SIGNAGE
MANUFACTURER: INPRO
COLLECTION: ASPEN
MATERIAL: PALLADIUM
FACE COLOR: 0134 CADET BLUE
TEXT COLOR: 0101 DESIGNER WHITE


CONTACT: CARRIE WOJCIK
NATIONAL ACCOUNT MANAGER SPACES
OFFICE 262-679-9010 X5594
CELL (262) 949 4932
FAX (888) 715-8407
EMAIL CWOJCIK@INPROCORP.COM

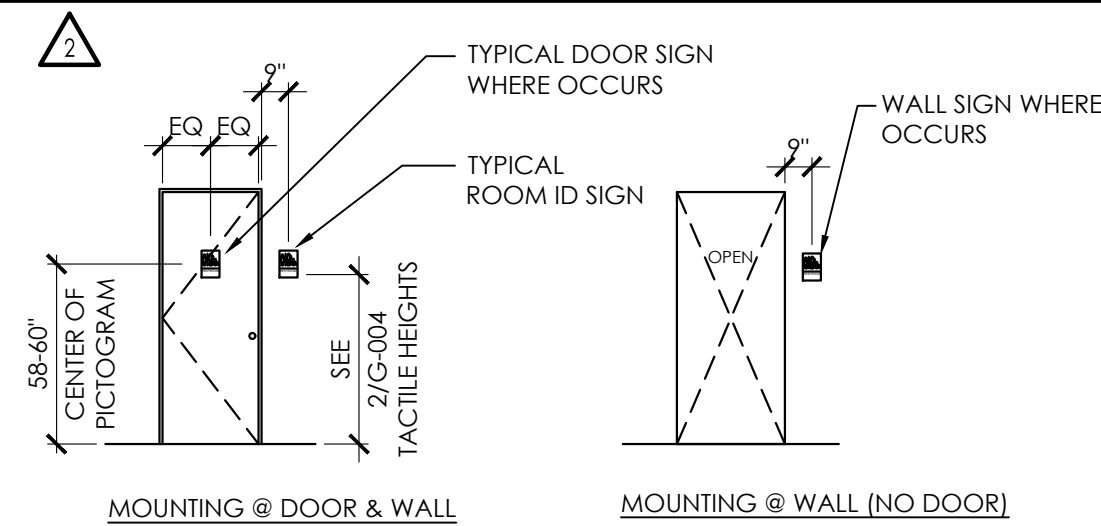

- NOTES:
- DOOR SIGN: SHALL BE CENTERED ON DOOR & MOUNTED 58-60" ABOVE THE FLOOR (W/ADHESIVE ONLY- CAULK EDGES W/CLEAR SILICONE) @ THE CENTER OF THE SIGN.
 - ROOM SIGN: RAISED & BRAILLED CHARACTERS & PICTORIAL SYMBOL SIGNS (PICTOGRAMS). LETTERS & NUMERALS SHALL BE RAISED 1/32", UPPERCASE, SANS SERIF OR SIMPLE SERIF TYPE, & SHALL BE ACCOMPANIED WITH GRADE 2 BRAILLE. RAISED CHARACTERS SHALL BE 5/8" HIGH MIN, 2" HIGH MAX.
 - FINISH CONTRAST: THE CHARACTERS & BACKGROUND OF SIGNS SHALL BE EGGSHELL, MATTE, OR OTHER NON-GLARE FINISH.
 - CHARACTERS & SIGNS: SHALL BE INSTALLED ON THE WALL ADJACENT TO THE LATCH SIDE OF THE DOOR.

2 Signage - Sanitary Facilities

SECTION 703

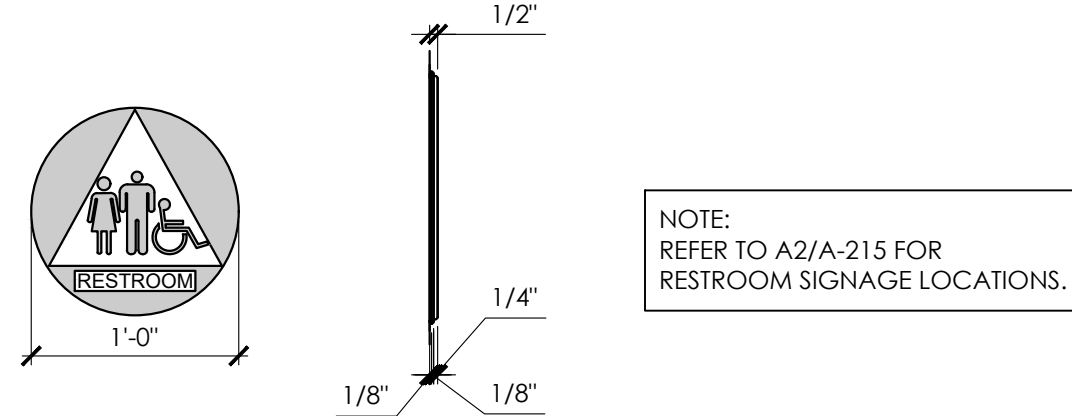


SYMBOL DESCRIPTION
ON DOORWAYS LEADING TO UNISEX ALL GENDER SANITARY FACILITIES THERE SHALL BE A 1/4" THICK & 12" DIAMETER CIRCLE WITH A 12" TRIANGLE SUPERIMPOSED UPON IT. THESE GEOMETRIC SYMBOLS SHALL BE CENTERED ON THE DOOR @ A HEIGHT OF 58-60" & THEIR COLOR & CONTRAST SHALL BE DISTINCTLY DIFFERENT FROM THE COLOR & CONTRAST OF THE DOOR.

- NOTE:
- REFER TO A2/A-215 FOR RESTROOM SIGNAGE LOCATIONS.

4 Signage - Sanitary Facilities


SECTION 703

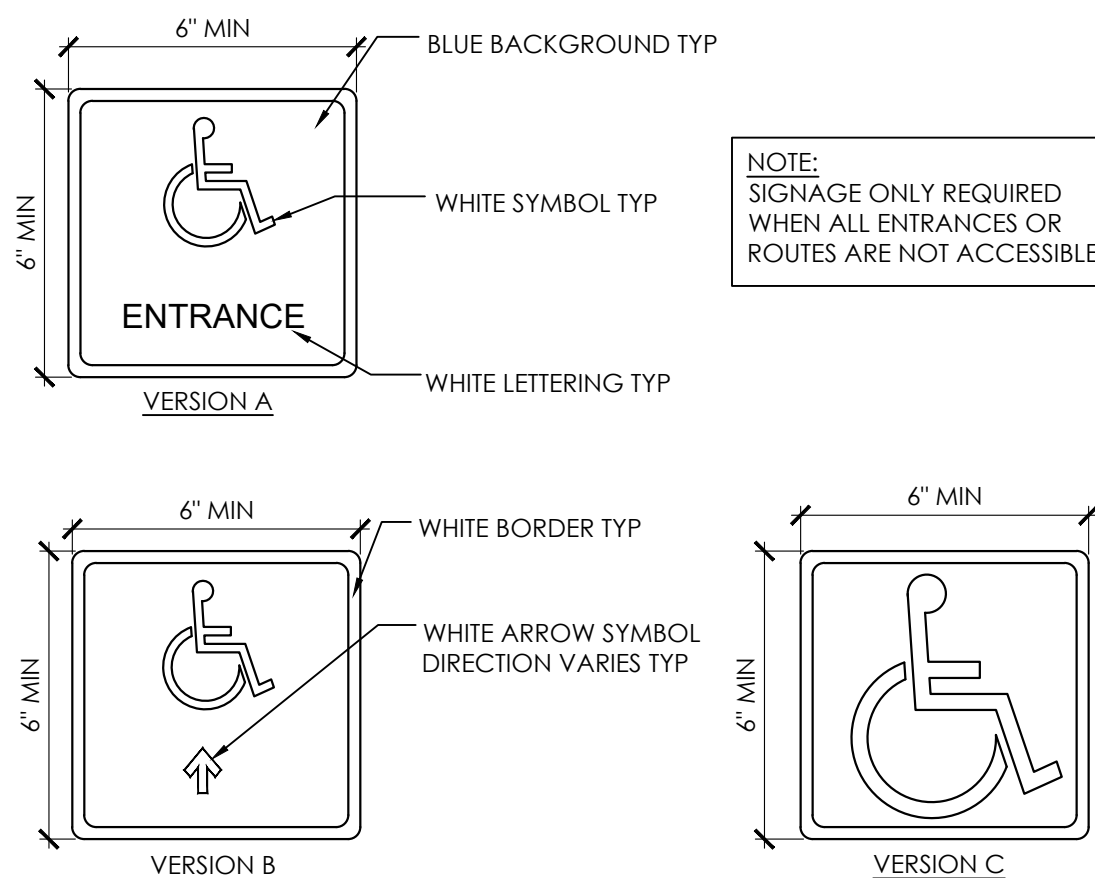

- NOTE:
- SIGNAGE ONLY REQUIRED WHEN ALL ENTRANCES OR ROUTES ARE NOT ACCESSIBLE.

3 Signage - Entrance/Exit


SECTION 703

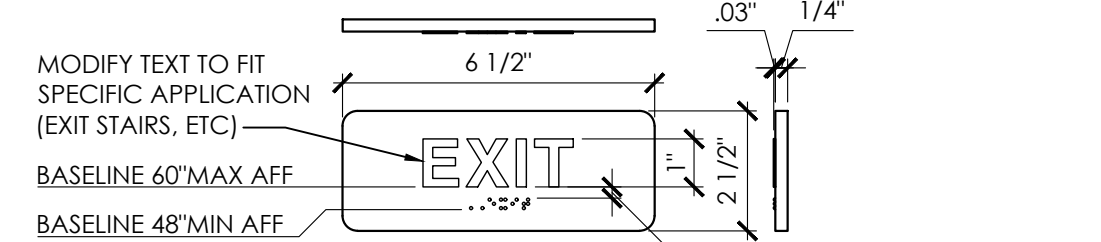

MODIFY TEXT TO FIT SPECIFIC APPLICATION (EXIT STAIRS, ETC)
BASELINE 60" MAX AFF
BASELINE 48" MIN AFF

1 Signage - Exit


SECTION 703

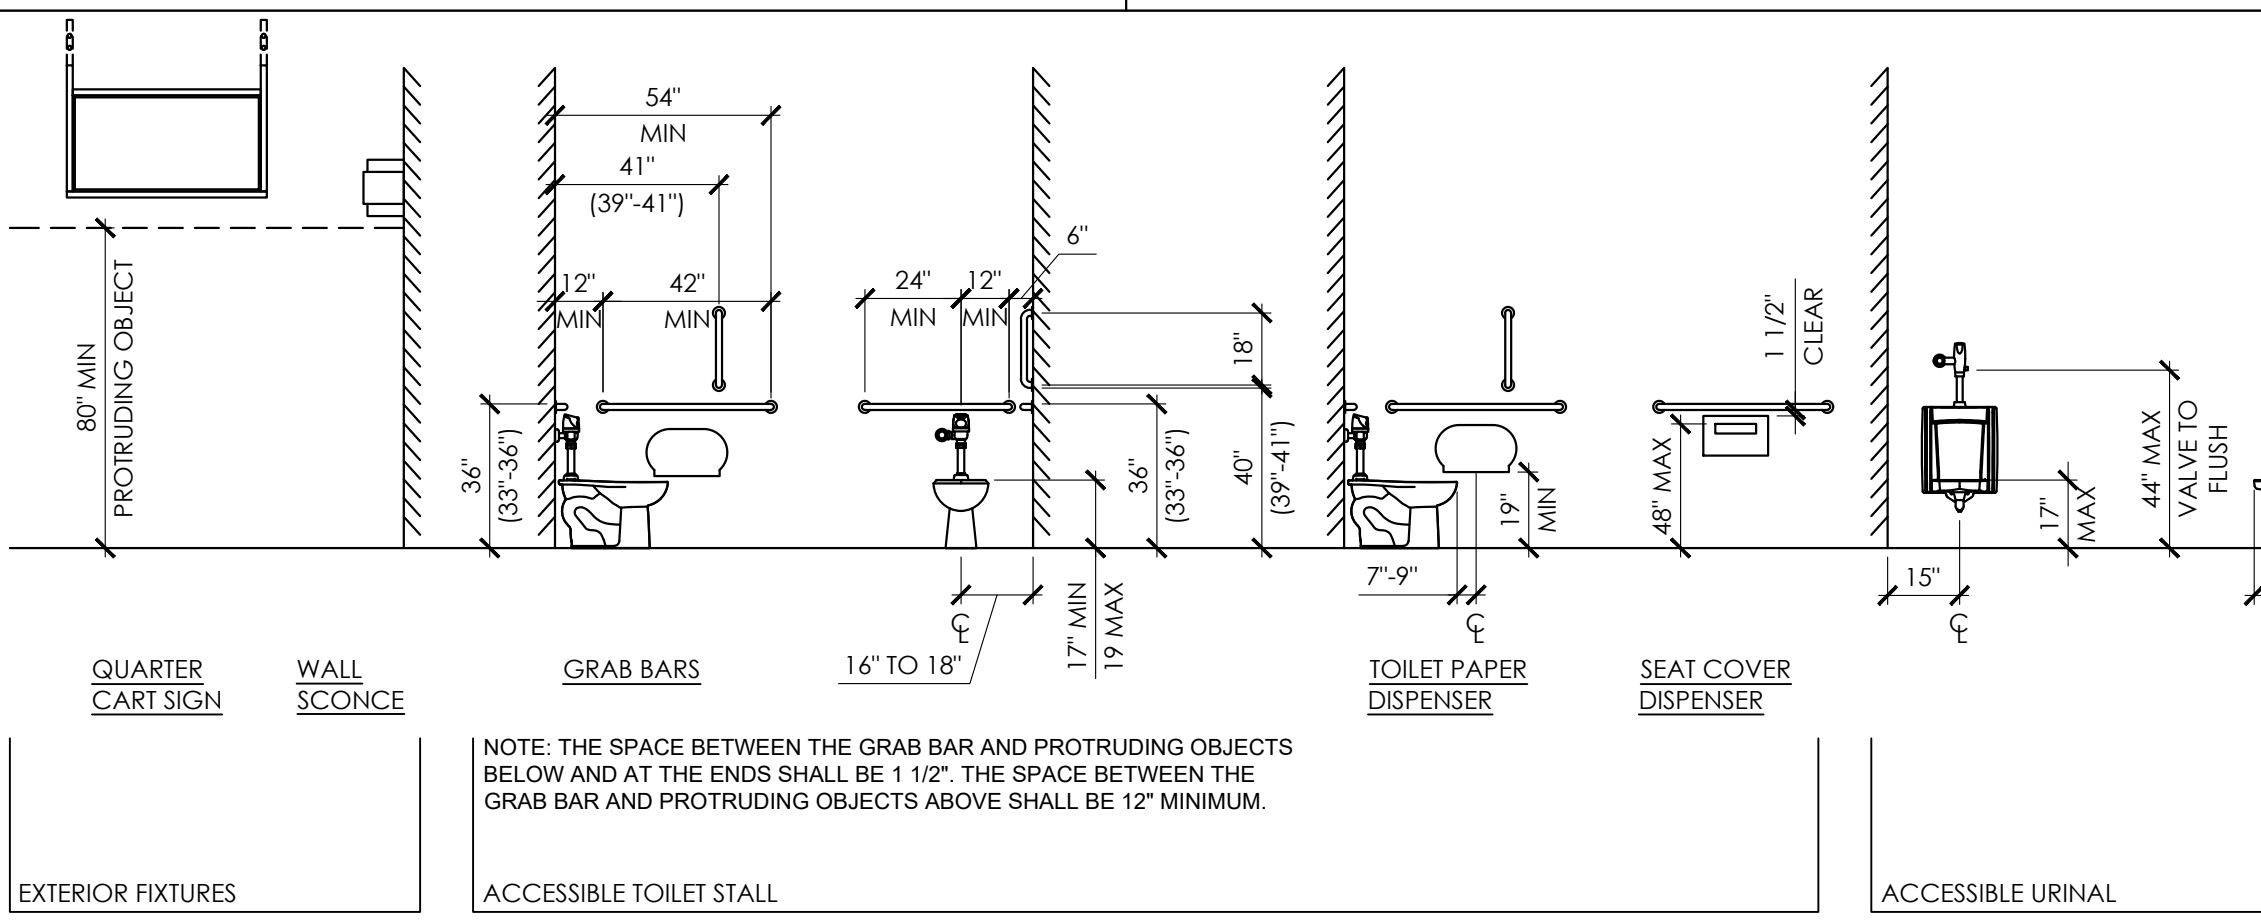

9 Mounting Heights / Fixture Clearances

SECTIONS 306; 307; 602; 603; 604; 605; 606; 609

GENERAL NOTE: ALL TOILET ROOM ACCESSORIES MUST CONFORM TO FBC 2020 - ACCESSIBILITY 7TH EDITION SECTION 309. OPERABLE PARTS SHALL BE OPERABLE WITH ONE HAND AND SHALL NOT REQUIRE TIGHT GRASPING, PINCHING, OR TWISTING OF THE WRIST. THE FORCE REQUIRED TO ACTIVATE OPERABLE PARTS SHALL NOT EXCEED 5LBS.

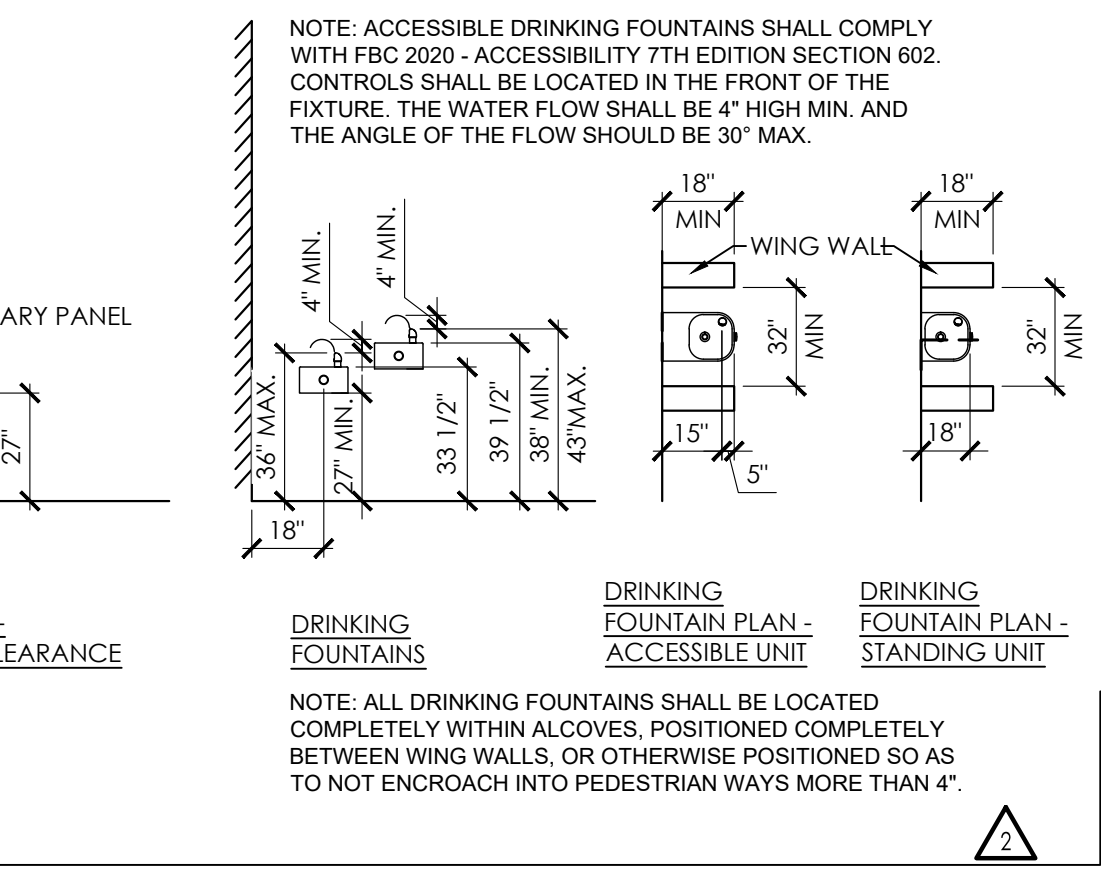

- NOTE: ACCESSIBLE DRINKING FOUNTAINS SHALL COMPLY WITH FBC 2020 - ACCESSIBILITY 7TH EDITION SECTION 602. CONTROLS SHALL BE LOCATED IN THE FRONT OF THE FIXTURE. THE WATER FLOW SHALL BE 4" HIGH MIN. AND THE ANGLE OF THE FLOW SHOULD BE 30" MAX.

DRINKING FOUNTAINS
DRINKING FOUNTAIN PLAN - ACCESSIBLE UNIT
DRINKING FOUNTAIN PLAN - STANDING UNIT

- NOTE: ALL DRINKING FOUNTAINS SHALL BE LOCATED COMPLETELY WITHIN ALCOVES, POSITIONED COMPLETELY BETWEEN WING WALLS, OR OTHERWISE POSITIONED SO AS TO NOT ENROACH INTO PEDESTRIAN WAYS MORE THAN 4".

APD
ENGINEERING
ARCHITECTURE
615 Fishers Run Victor, NY 14564
585.742.2222 - www.apd.com

Copyright © 2024
APD Engineering & Architecture
03/27/2024

Drawing Alteration

It is a violation of law for any person, unless acting under the direction of licensed Architect, Professional Engineer, Landscape Architect, or Land Surveyor to alter any item on this document in any way. Any licensee who alters this document is required by law to affix his or her seal and to add the notation "Altered By" followed by his or her signature and the specific description of the alteration or revision.

DO NOT SCALE PLANS

Copying, Printing, Software and other processes required to produce these prints can stretch or shrink the actual paper or layout. Therefore, scaling of this drawing may be inaccurate. Contact APD E&A with any need for additional dimensions or clarifications.

Issued:	Date:
A Issued for Permit	07/08/24
B Issued for Bid	07/29/25
C	
D	
E	

Revisions:	Date:
1 Owner Changes	11/18/24
2 Owner Changes	07/29/25
3	
4	
5	
6	
7	
8	
9	
10	
11	
12	

PROJECT ARCHITECT/ENGINEER

Daniel Sargent

PROJECT LEAD

John Lynch

FOR NOT FOR
REFERENCE CONSTRUCTION



ALDI Inc. Store #: 50
Coconut Crossing, FL
12850 Northlake Boulevard
Palm Beach Gardens, FL 33412
Palm Beach County
Project Name & Location:

Accessibility
Details
Drawing Name:

Prototype:	Project No.
V7.08 LHRD	22-0267A
Type:	
GROUND UP	
Drawn By:	
JWL	
Scale:	
As Noted	
Drawing No.	
G-004	

PLOTTED: 7/29/2025 9:49 AM

RESPONSIBILITY SCHEDULE															
SPEC SECTION	ELEMENT	NATIONAL ACCOUNT PRICING	EXISTING	ALDI			GENERAL CONTRACTOR			LAND LORD			REMARKS		
				FURNISHED	INSTALLED	COORDINATE	FURNISHED	INSTALLED	COORDINATE	FURNISHED	INSTALLED	COORDINATE			
DIVISION 01 - GENERAL REQUIREMENTS															
017700	CLOSEOUT PROCEDURES	--	--	--	--	--	X	--	--	--	--	--	GC TO COMPLETE TABLE OF CONTENTS DOCUMENT FOR CLOSEOUT BINDER		
017839	PROJECT RECORD DOCUMENTS	--	--	--	--	--	X	--	--	--	--	--	GC TO COMPLY WITH REQUIREMENTS OF THIS SECTION		
019100	COMMISSIONING REQUIREMENTS	X	--	X	--	--	--	--	X	--	--	--	COMMISSIONING AGENT FOR REFRIGERATION (EMERSON OR ENREPS) AND SIEMENS EMS (SIEMENS) CONTRACTED DIRECTLY BY ALDI. GC AND SUBCONTRACTORS TO BE ON SITE WHEN REQUIRED AND ASSIST WITH COMMISSIONING AND FINAL FUNCTIONAL TESTING.		
DIVISION 03 - CONCRETE															
033000	CAST-IN-PLACE CONCRETE	--	--	--	--	--	X	--	--	--	--	--			
033170	INTERIOR CONCRETE SLAB ON GRADE JOINT SEALANTS	--	--	--	--	--	X	--	--	--	--	--			
DIVISION 04 - MASONRY															
042000	UNIT MASONRY												SEE A202		
	CAST STONE WALL CAP		--	--	--	--	X	X	--	--	--	--	SEE A201 & A202 EXTERIOR FINISH SCHEDULE		
047300	MANUFACTURED STONE VENEER	--	--	--	--	--	X	X	--	--	--	--	CULTURED STONE: BORAL		
DIVISION 05 - METALS															
055000	METAL FABRICATIONS														
	ANODIZED ALUMINUM ENTRY DOOR PROTECTORS	--	--	--	--	--	X	X	--	--	--	--	TARPENING - LAFOLLETTE CO		
	BLRD-1: FLEXCORE	X	--	--	--	--	X	X	--	--	--	--	MCCUE CORPORATION		
	BLRD-4: CG-8106 BK CHROMIA HSE PE	X	--	--	--	--	X	X	--	--	--	--	MCCUE CORPORATION		
	BR: FLOOR MOUNTED STAINLESS STEEL RAIL	X	--	--	--	--	X	X	--	--	--	--	MCCUE CORPORATION		
	BR-C: FLOOR MOUNTED CORNER GUARD	X	--	--	--	--	X	X	--	--	--	--	MCCUE CORPORATION		
	ROOF ACCESS LADDER	--	--	--	--	--	X	X	--	--	--	--	STEEL LADDER: SEE PROJECT MANUAL FOR REQUIREMENTS PREFABRICATED ALUMINUM LADDER (OPTIONAL): UPNOVR CAGE IS REQUIRED FOR LADDERS OVER 20' HIGH PER OSHA REQUIREMENTS		
	SSBR: STAINLESS STEEL BUMPER RAIL	--	--	--	--	--	X	X	--	--	--	--	TARPENING - LAFOLLETTE CO		
057000	DECORATIVE METAL														
	COLUMN COVERS	--	--	--	--	--	X	X	--	--	--	--	TARPENING - LAFOLLETTE CO		
DIVISION 06 - WOOD, PLASTICS, AND COMPOSITES															
066400	PLASTIC PANELING	--	--	--	--	--	X	X	--	--	--	--	SEE PROJECT MANUAL FOR LIST OF APPROVED MANUFACTURERS		
DIVISION 07 - THERMAL AND MOISTURE PROTECTION															
072100	THERMAL INSULATION	--	--	--	--	--	X	X	--	--	--	--	FOAM-PLASTIC BOARD INSULATION: SEE PROJECT MANUAL FOR LIST OF APPROVED MANUFACTURERS GLASS-FIBER BLANKET INSULATION: SEE PROJECT MANUAL FOR LIST OF APPROVED MANUFACTURERS POLYURETHANE SPRAY FOAM INSULATION: ICYNENE INC. OR DEMILEC INC.		
074213	METAL SOFFIT PANELS	--	--	--	--	--	X	X	--	--	--	--	METAL SOFFIT PANELS: PETERSEN ALUMINUM CORPORATION (PAC) OR FIRESTONE BUILDING PRODUCTS THIS ITEM MAY BE PROVIDED BY OWNER - COORDINATE ROOFING SCOPE OF WORK WITH OWNER		
074243	COMPOSITE WALL PANELS	X	--	--	--	--	X	X	--	--	--	--	ALUMINUM COMPOSITE PANEL: LAMINATOR'S INC.		
074646	FIBER CEMENT WALL PANELS	X	--	--	--	--	X	X	--	--	--	--	FIBER CEMENT WALL PANELS: NICHIIA USA INC.		
076201	SHEET METAL FLASHING AND TRIM														
079999	ALDI GC ROOFING INSTRUCTIONS	--	--	--	--	--	X	X	X	--	--	--	REFER TO APPENDIX 'B' FOR ROOF SCOPE OF WORK. WHEN APPLICABLE, PHOTOVOLTAIC SYSTEM WILL BE PROVIDED BY ALDI VENDOR. GC IS TO COORDINATE WITH SOLAR CONTRACTOR AND ROOFING VENDOR.		
DRAWING	PIPE BOOT CURB	--	--	--	--	--	X	X	--	--	--	--	PATE COMPANY, THE OR ROOF PRODUCTS AND SYSTEMS (RPS)		
DRAWING	UNIT CURB	--	--	--	--	--	X	X	--	--	--	--	PATE COMPANY, THE OR ROOF PRODUCTS AND SYSTEMS (RPS)		
DIVISION 08 - OPENINGS															
083613	SECTIONAL OH DOORS						X	X							
083800	IMPACT TRAFFIC DOORS	X	--	--	--	--	X	X	--	--	--	--	CHASE DOORS (SENNECA HOLDINGS)		
088000	GLAZING	--	--	--	--	--	X	X	--	--	--	--	VERIFY GLAZING TYPE WITH CLIMATE ZONE SEE PROJECT MANUAL FOR LIST OF APPROVED MANUFACTURERS		
DIVISION 09 - FINISHES															
093000	TILING														
	GLAZED OR PORCELAIN	X	--	--	--	--	X	X	--	--	--	--	CERAMIC TILE: DALTILE / AMERICAN OLEAN		
095113	ACOUSTICAL PANEL CEILINGS														
	ACOUSTICAL PANEL CEILING SYSTEM	X	--	--	--	--	X	X	--	--	--	--	ARMSTRONG WORLD INDUSTRIES, INC.		
096513	RESILIENT BASE AND ACCESSORIES														
	VB-1: VINYL BASE	--	--	--	--	--	X	X	--	--	--	--	ROPPE CORPORATION		
099100	PAINTING	X	--	--	--	--	X	X	--	--	--	--	PAINT: SHERWIN-WILLIAMS		
DRAWING	WP-1: WOOD PANELS	X	--	--	--	--	X	X	--	--	--	--	ARCHSYSTEMS OR HARDWARE BARGAINS RE: INTERIOR ELEVATIONS		

NOTE: THE RESPONSIBILITY SCHEDULE IS MEANT TO PROVIDE AN OVERVIEW OF OWNER FURNISHED AND OWNER PROVIDED ITEMS. THIS IS NOT MEANT TO REPLACE THE GC OBLIGATIONS WITHIN THE DRAWINGS AND SPECIFICATIONS.

RESPONSIBILITY SCHEDULE															
SPEC SECTION	ELEMENT	NATIONAL ACCOUNT PRICING	EXISTING	ALDI			GENERAL CONTRACTOR			LAND LORD			REMARKS		
				FURNISHED	INSTALLED	COORDINATE	FURNISHED	INSTALLED	COORDINATE	FURNISHED	INSTALLED	COORDINATE			
DIVISION 10 - SPECIALTIES															
101400	SIGNAGE														
	HANDICAPPED PARKING	--	--	--	--	--	X	X	--	--	--	--	--		
	REST ROOM & ENTRY EXIT	--	--	--	--	--	X	X	--	--	--	--	--	INPRO - CONTACT: JOHN KAISER, JKAISER@INPROCORP.COM, 800-222-5556 X.5468 RE: G-004	
102600	WALL, DOOR AND EQUIPMENT PROTECTION														
	GUIDANCE RAILING	X	--	--	--	--	X	X	--	--	--	--	--	MCCUE CORPORATION	
	EQUIPMENT GUARDRAIL	X	--	--	--	--	X	X	--	--	--	--	--	MCCUE CORPORATION	
102800	TOILET, BATH AND LAUNDRY ACCESSORIES														
	AC-1: BABY CHANGING STATION	X	--	--	--	--	X	X	--	--	--	--	--	KOALA KARE PRODUCTS	
	AC-2: PAPER TOWEL DISPENSER	--	--	--	--	--	X	X	--	--	--	--	--	SIMPLEHUMAN	
	AC-3: GRAB BAR	--	--	--	--	--	X	X	--	--	--	--	--	BOBRICK WASHROOM EQUIPMENT, INC. <u>OR</u> BRADLEY CORPORATION	
	AC-4: MIRROR UNIT	--	--	--	--	--	X	X	--	--	--	--	--	BOBRICK WASHROOM EQUIPMENT, INC. <u>OR</u> BRADLEY CORPORATION	
	AC-5: HAND DRYER AND WALL GUARD	X	--	--	--	--	X	X	--	--	--	--	--	EXCEL DRYER INC.	
	AC-6: UNDERLAVATORY GUARD	--	--	--	--	--	X	X	--	--	--	--	--	PLUMBEREX SPECIALTY PRODUCTS, INC. <u>OR</u> IPS CORPORATION	
102813	MISCELLANEOUS ACCESSORIES														
	DISPLAY MOUNTING RAIL	--	--	--	--	--	X	X	--	--	--	--	--	ADVANTUS GRIP-A-STRIP. LOCATED IN BREAK ROOM. COORDINATE FINAL LOCATION WITH ALDI CONSTRUCTION REPRESENTATIVE	
104416	FIRE EXTINGUISHERS	--	--	--	--	--	X	X	X	--	--	--	--	SEE PROJECT MANUAL FOR LIST OF APPROVED MANUFACTURERS MOUNT IN COMPLIANCE WITH REQUIREMENTS OF AUTHORITY HAVING JURISDICTION	
DRAWING	KNOX BOX	--	--	--	--	--	X	X	X	--	--	--	--	MOUNT IN COMPLIANCE WITH REQUIREMENTS OF AUTHORITY HAVING JURISDICTION RE: A-201	
DIVISION 11 - EQUIPMENT															
111300	LOADING DOCK EQUIPMENT														
	DOCK LEVELER AND CONTROLS	--	--	--	--	--	X	X	--	--	--	--	--	SEE PROJECT MANUAL FOR LIST OF APPROVED MANUFACTURERS	
	DOCK SEAL	--	--	--	--	--	X	X	--	--	--	--	--	MARVEL EQUIPMENT COMPANY (MEC)	
	DOCK TRACK GUARD	--	--	--	--	--	X	X	--	--	--	--	--	DURAFLEX	
DIVISION 12 - FURNISHINGS															
124840	FLOOR MATS AND FRAMES	X	--	--	--	--	X	X	--	--	--	--	--	CONSTRUCTION SPECIALTIES	
DRAWING	TR-1: TRASH RECEPTACLE	--	--	--	--	--	X	X	--	--	--	--	--	DAWN ENTERPRISES RE: A-603	
DIVISION 21 - FIRE SUPPRESSION															
210500	COMMON WORK RESULTS FOR FIRE SUPPRESSION	--	--	--	--	--	X	X	--	--	--	--	--	A CRITERIA DRAWING IS PART OF DRAWING SET. ENGINEERED FIRE SUPPRESSION DRAWINGS TO BE PROVIDED BY GC AND SUBCONTRACTOR AND SUBMITTED TO AHJ FOR REVIEW AND APPROVAL.	
DIVISION 22 - PLUMBING															
220500	COMMON WORK RESULTS FOR PLUMBING	--	--	--	--	--	X	X	--	--	--	--	--		
DIVISION 23 - HEATING, VENTILATING, AND AIR CONDITIONING															
230500	COMMON WORK RESULTS FOR HVAC	--	--	--	--	--	X	X	--	--	--	--	--		
237414	PACKAGED, OUTDOOR, DEHUMIDIFICATION UNIT (RTU-1)														
	RTU-1 ROOF CURB	--	--	--	--	--	X	X	X	--	--	--	--	AES INDUSTRIES, INC. REFER TO G-006 FOR RTU-1 UNIT, TEMPERATURE AND HUMIDITY SENSOR SCOPE	
238126	SPLIT-SYSTEM AIR-CONDITIONERS														
	UNIT CONDENSATE DRAIN	--	--	--	--	--	X	X	--	--	--	--	--		
DRAWING	REFRIGERATION CONDENSER SUPPORT CURB	--	--	--	--	--	X	X	--	--	--	--	--	AES INDUSTRIES, INC.	
DIVISION 26 - ELECTRICAL															
260500	COMMON WORK RESULTS FOR ELECTRICAL	--	--	--	--	--	X	X	--	--	--	--	--	SEE PROJECT MANUAL FOR LIST OF APPROVED MANUFACTURERS	
265100	INTERIOR LIGHTING														
	FSG LIGHTING PACKAGE	X	--	--	--	--	X	X	--	--	--	--	--	FSG LIGHTING	
265400	EXTERIOR LIGHTING														
	FSG LIGHTING PACKAGE	X	--	--	--	--	X	X	--	--	--	--	--	FSG LIGHTING	
	IO (EATON) UP LIGHTING	X	--	--	--	--	X	X	--	--	--	--	--	IO (EATON) LIGHTING	
DRAWING	CHIME	--	--	--	--	--	X	X	--	--	--	--	--		
DRAWING	POWERPOLE - GONDOLA AND SPOT MERCHANDISER	--	--	--	--	--	X	X	--	--	--	--	--		
DIVISION 27 - COMMUNICATIONS															
DRAWING	ROOF MAST	--	--	--	--	--	X	X	X	--	--	--	--	GC TO PROVIDE ROOF MAST ASSEMBLY, BALLAST, AND CONDUIT THROUGH ROOF. REFER TO G-007 'DIVISION 27 - COMMUNICATIONS' ROOF MAST - ANTENNA' FOR ANTENNA SCOPE	

PLOTTED: 7/29/2025 9:49 AM

RESPONSIBILITY SCHEDULE																
SPEC SECTION	ELEMENT	NATIONAL ACCOUNT PRICING	EXISTING	ALDI			GENERAL CONTRACTOR			LAND LORD			REMARKS			
				FURNISHED	INSTALLED	COORDINATE	FURNISHED	INSTALLED	COORDINATE	FURNISHED	INSTALLED	COORDINATE				

APPENDIX A - OWNER FURNISHED AND CONTRACTOR INSTALLED														
SEE APPENDIX A IN THE VENDOR INFORMATION FOLDER ON SHARENOLGY														
DIVISION 05 - METALS														
DRAWING	SPOT MERCHANDISER BASE PROTECTION	--	--	X	--	--	--	X	--	--	--	--	KPI	
052100	ROOF JOIST	--	--	X	--	X	--	X	X	--	--	--	NEW MILLENNIUM - NATIONAL ACCOUNTS PROGRAM MANAGER JILL ENGERMAN JILL.ENGEMAN@NEWMILL.COM (260.969.3502)	
053100	ROOF DECK	--	--	X	--	X	--	X	X	--	--	--	NEW MILLENNIUM - NATIONAL ACCOUNTS PROGRAM MANAGER JILL ENGERMAN JILL.ENGEMAN@NEWMILL.COM (260.969.3502)	
DIVISION 06 - WOOD, PLASTICS, AND COMPOSITES														
064023	INTERIOR ARCHITECTURAL WOODWORK	X	--	X	--	--	--	X	--	--	--	--	RIDDLEY RETAIL FIXTURES, INC.	

DIVISION 08 - OPENINGS														
081113	DOOR AND FRAME	X	--	X	--	--	--	X	--	--	--	--	DH PACE: ALDIDOORS@DHFACE.COM SELECT DOOR FRAMES TO BE PREPARED TO RECEIVE ALARMED EXIT DEVICE EQUIPMENT - REFER TO A-601 FOR APPLICABLE DOOR FRAMES.	
087100	DOOR HARDWARE	X	--	X	--	--	--	X	--	--	--	--	DH PACE: ALDIDOORS@DHFACE.COM RE: A-601	

DIVISION 10 - SPECIALTIES

101436	INTERIOR SIGNAGE														
	HANGING 'NO PARKING'	X	--	X	--	--	--	X	--	--	--	--	SBPI GRAPHICS <u>OR</u> OFF THE WALL COMPANY, LLC		
	PRODUCE SCREEN WALL	X	--	X	--	--	--	X	--	--	--	--	OFF THE WALL COMPANY, LLC IF SHOWN ON PLANS		
	VALANCE MOUNTED	X	--	X	--	--	--	X	--	--	--	--	MULTIDECK UNITS HAVE AN INTEGRAL FASCIA FOR SIGNAGE ATTACHMENT LPB VALANCE LOCATED ABOVE COOLER / FREEZER DOORS (KPI <u>OR</u> RIDDLEY)		
	WALL MOUNTED	X	--	X	--	--	--	X	--	--	--	--	SBPI GRAPHICS <u>OR</u> OFF THE WALL COMPANY, LLC		
	GRAPHIC SCREEN WALL	X	--	X	--	--	--	X	--	--	--	--	OFF THE WALL COMPANY, LLC LOCATED AT E-COMMERCE		
	ECOMMERCE SCREEN WALL	X	--	X	--	--	--	X	--	--	--	--	OFF THE WALL COMPANY, LLC		
101400	EXTERIOR SIGNAGE														
	BANNERS - EXTERIOR	X	--	X	--	--	--	X	--	--	--	--	--		
10/11 0000	MISCELLANEOUS SPECIALTIES AND EQUIPMENT														
	BATTERY CHARGER	X	--	X	--	--	--	X	--	--	--	--	CROWN EQUIPMENT CORPORATION		
	PROJECTOR AND LENS (FOR BACKROOM FLOOR STRIPING IMAGE AT IMPACT DOORS)	X	--	X	--	--	--	X	--	--	--	--	FACILITY SOLUTIONS GROUP		
	SAFE	X	--	X	--	--	--	X	--	--	--	--	HAYMAN SAFE		
	SAFE BASE	X	--	X	--	--	--	X	--	--	--	--	HAYMAN SAFE		
	SPOT MERCHANDISER	X	--	X	--	--	--	X	--	--	--	--	AHT COOLING SYSTEMS USA INC.		
	ECOMMERCE AND CLEANING SHELVING, DONATION AND EPW/SS HOLD AREAS	X	--	X	--	--	--	X	--	--	--	--	REB		

DIVISION 11 - EQUIPMENT																
113100	RESIDENTIAL APPLIANCES															
	MW-1: MICROWAVE	X	--	X	--	--	--	X	--	--	--	--	MAS DISTRIBUTION - RE: A-603			
	DW-1: DISHWASHER	X	--	X	--	--	--	X	--	--	--	--	MAS DISTRIBUTION - RE: A-603			
	R-1: REFRIGERATOR	X	--	X	--	--	--	X	--	--	--	--	MAS DISTRIBUTION - RE: A-603			
114121	WALK-IN COOLERS AND FREEZERS															
	RACKING	X	--	X	--	--	--	X	--	--	--	--	B-O-F			
DRAWING	SHOPPING CARTS	X	--	X	--	--	--	X	--	--	--	--	R.W. ROGERS COMPANY OR TECHNIBILT			

NOTE:
THE RESPONSIBILITY SCHEDULE IS MEANT TO PROVIDE AN OVERVIEW OF OWNER FURNISHED AND OWNER PROVIDED ITEMS. THIS IS NOT MEANT TO REPLACE THE GC OBLIGATIONS WITHIN THE DRAWINGS AND SPECIFICATIONS.

RESPONSIBILITY SCHEDULE																
SPEC SECTION	ELEMENT	NATIONAL ACCOUNT PRICING	EXISTING	ALDI			GENERAL CONTRACTOR			LAND LORD			REMARKS			
				FURNISHED	INSTALLED	COORDINATE	FURNISHED	INSTALLED	COORDINATE	FURNISHED	INSTALLED	COORDINATE				

DIVISION 12 - FURNISHINGS																
123200	MANUFACTURED CASEWORK												RIDDLEY RETAIL FIXTURES, INC.			
	CABINETS	X	--	X	--	--	--	X	--	--	--	--	KPI <u>OR</u> RIDDLEY			
	CHECKLANES	X	--	X	--	--	--	X	--	--	--	--	KPI <u>OR</u> RIDDLEY			
	FILE CABINETS	X	--	X	--	--	--	X	--	--	--	--	KPI <u>OR</u> RIDDLEY			
	LOCKERS	X	--	X	--	--	--	X	--	--	--	--	KPI <u>OR</u> RIDDLEY			
	MANAGER'S ORGANIZATION DESK	X	--	X	--	--	--	X	--	--	--	--	KPI <u>OR</u> RIDDLEY			
	SACKING COUNTER AND MOUNTING BRACKET	X	--	X	--	--	--	X	--	--	--	--	KPI <u>OR</u> RIDDLEY			
	SALES FLOOR GONDOLAS	X	--	X	--	--	--	X	--	--	--	--	KPI <u>OR</u> RIDDLEY			
	SCO WALL	X	--	X	--	--	--	X	--	--	--	--	RIDDLEY			
DRAWING	BREAKROOM MIRROR	X	--	X	--	--	--	X	--	--	--	--				
DRAWING	CHECKLANE CHAIRS	X	--	X	--	--	--	X	--	--	--	--	DAUPHIN <u>OR</u> KDI DESIGN (VIA SEATING)			
DRAWING	QUARTER CART SIGN	X	--	X	--	--	X	X	X	--	--	--	OWNER FURNISHES GRAPHIC (SBPI GRAPHICS <u>OR</u> OFF THE WALL COMPANY, LLC) GC FURNISHES FRAME (WHEN APPLICABLE)			

DIVISION 22 - PLUMBING														
DRAWING	BREAKROOM SINK	--	--	X	--	--	--	X	--	--	--	--	SINK FURNISHED BY OWNER WITH MILLWORK PACKAGE SINK IS PREINSTALLED UNDER COUNTER	

DIVISION 23 - HEATING, VENTILATING, AND AIR CONDITIONING														
237413	PACKAGED, OUTDOOR, CENTRAL-STATION ROOFTOP UNITS (RTU-2 & RTU-3)													
	RTU-2	X	--	X	--	--	--	X	X	--	--	--	TRANE	
	RTU-3	X	--	X	--	--	--	X	X	--	--	--	TRANE	
237414	PACKAGED, OUTDOOR, DEHUMIDIFICATION UNIT (RTU-1)													
	RTU-1	X	--	X	--	--	--	X	X	--	--	--	TRANE	
	TEMPERATURE AND HUMIDITY SENSORS	--	--	X	--	--	--	X	X	--	--	--	REFER TO G-005 FOR RTU-1 ROOF CURB SCOPE	
238126	SPLIT-SYSTEM AIR-CONDITIONERS													
	DUCTLESS SPLIT-FAN COIL UNIT (FCU-1)	X	--	X	--	--	--	X	X	--	--	--	LG ELECTRONICS U.S.A., INC. RE: MECH DWGS - THIS PIECE OF EQUIPMENT IS ORDERED BY GC, AND ALDI IS DIRECT BILLED FOR COST OF EQUIPMENT. INSTALLATION OF EQUIPMENT UNDER GC CONTRACT.	
	HEAT PUMP (HP-1)	X	--	X	--	--	--	X	X	--	--	--	LG ELECTRONICS U.S.A., INC. RE: MECH DWGS - THIS PIECE OF EQUIPMENT IS ORDERED BY GC, AND ALDI IS DIRECT BILLED FOR COST OF EQUIPMENT. INSTALLATION OF EQUIPMENT UNDER GC CONTRACT.	

DIVISION 26 - ELECTRICAL													
265100	NORDEON INTERIOR LIGHTING - TRUNK SYSTEM	X	--	X	--	--	--	X	X	--	--	--	NORDEON USA
DRAWING	POWERPOLE - CHECKLANE	X	--	X	--	--	--	X	--	--	--	--	KPI OR RIDDLEY
DRAWING	INTEGRATED POWER SUPPLY (FORMERLY POWERWALL)	X	--	X	--	--	--	X	X	--	--	--	CUSTOM DESIGN CONTROLS



Copyright © 2024
APD Engineering & Architecture
03/17/2018
Drawing Alteration
It is a violation of law for any person, unless acting under the direction of licensed Architect, Professional Engineer, Landscape Architect, or Land Surveyor to alter any item on this document in any way. Any licensee who alters this document is required by law to offit his or her seal and to add the notation "Altered By" followed by his or her signature and the specific description of the alteration or revision.

DO NOT SCALE PLANS
Copying, Printing, Software and other processes required to produce these prints can stretch or shrink the actual paper or layout. Therefore, scaling of this drawing may be inaccurate. Contact APD E&A with any need for additional dimensions or clarifications.

Issued:	Date:
A Issued for Permit	07/08/24
B Issued for Bid	07/29/25
C	
D	
E	

Revisions:	Date:
1 Owner Changes	11/18/24
2 Owner Changes	07/29/25
3	
4	
5	
6	
7	
8	
9	
10	
11	
12	

PROJECT ARCHITECT/ENGINEER
Daniel Sargent
PROJECT LEAD
John Lynch

NOT FOR CONSTRUCTION

SealSeal

ALDI Inc.
1171 North State Road 7
Royal Palm Beach, FL 33411
(561) 640-8000

ALDI Inc. Store #: 50
Coconut Crossing, FL
12850 Northlake Boulevard
Palm Beach Gardens, FL 33412
Palm Beach County
Project Name & Location:

Responsibility Schedule - Appendix A	
Drawing Name:	
Prototype: V7.08 LHRD	Project No. 22-0267A
Type: GROUND UP	G-006
Drawn By: JWL	

PLOTTED: 7/29/2025 9:49 AM

RESPONSIBILITY SCHEDULE																
SPEC SECTION	ELEMENT	NATIONAL ACCOUNT PRICING	EXISTING	ALDI			GENERAL CONTRACTOR			LAND LORD			REMARKS			
				FURNISHED	INSTALLED	COORDINATE	FURNISHED	INSTALLED	COORDINATE	FURNISHED	INSTALLED	COORDINATE				

APPENDIX B - OWNER PROVIDED (FURNISHED AND INSTALLED)																
SEE APPENDIX B IN THE VENDOR INFORMATION FOLDER ON SHARENOLGY																
DIVISION 03 - CONCRETE																
033544	DIAMOND POLISHED CONCRETE FINISHING	X	--	X	X	--	--	--	X	--	--	--	COORDINATE WITH ALDI CONSTRUCTION REPRESENTATIVE			

DIVISION 07 - THERMAL AND MOISTURE PROTECTION													
075416	KEE ROOFING	--	--	X	X	--	--	--	X	--	--	--	FIBERTITE: KEE ROOFING
	ROOF INSULATION	--	--	X	X	--	--	--	X	--	--	--	SEE THERMAL INSULATION SCHEDULE ON A-603 FOR DESIRED R-VALUE
075419	PVC ROOFING	--	--	X	X	--	--	--	X	--	--	--	--
	ROOF INSULATION	--	--	X	X	--	--	--	X	--	--	--	SEE THERMAL INSULATION SCHEDULE ON A-603 FOR DESIRED R-VALUE
076200	SHEET METAL FLASHING AND TRIM	--	--	X	X	--	--	--	X	--	--	--	DRIP EDGE AND FASCIA CAP: SEE ROOFER'S SCOPE OF WORK
	SCUPPER	--	--	X	X	--	--	--	X	--	--	--	SEE ROOFER'S SCOPE OF WORK
077200	ROOF ACCESSORIES												
	ROOF HATCH WALKWAY PADS	--	--	X	X	--	--	--	X	--	--	--	--
	ROOF HATCH	--	--	X	X	--	--	--	X	--	--	--	BABCOCK-DAVIS
	ROOF HATCH SAFETY RAILING SYSTEM	--	--	X	X	--	--	--	X	--	--	--	SAFEPRO SAFETY

DIVISION 08 - OPENINGS														
084229	AUTOMATIC ENTRANCES													
	AUTODOOR SYSTEM AND TRANSOM FRAMING	X	--	X	X	--	--	--	X	--	--	--	AUTOMATIC ENTRANCE DOOR SYSTEM: STANLEY ACCESS TECHNOLOGIES. AUTO DOOR SYSTEM IS FURNISHED & INSTALLED BY ALDI. TRANSOM FRAMING IS FURNISHED AND INSTALLED BY GC.GC TO CONFIRM WITH OWNER THAT DOOR SUPPLIER VERIFIES R.O. SIZE BEFORE FABRICATION OF DOORS. GLAZING FOR BI-PARTING ENTRANCE DOOR IS FURNISHED & INSTALLED WITH THE DOOR BY ALDI. ALL OTHER GLAZING FURNISHED AND INSTALLED BY GC	
	GLAZING IN AUTODOOR AND TRANSOM	--	--	--	--	--	X	X	X	--	--	--		
	ECOMMERCE DOOR OPERATOR	X	--	X	X	--	--	--	X	--	--	--		

DIVISION 09 - FINISHES													

DIVISION 10 - SPECIALTIES														
101400	EXTERIOR SIGNAGE													
	LOGO	X	--	X	X	--	--	--	X	--	--	--	PERSONA SIGN	
	MONUMENT / PYLON	X	--	X	X	--	--	--	X	--	--	--	PERSONA SIGN	
102800	TOILET, BATH AND LAUNDRY ACCESSORIES													
	TOILET PAPER DISPENSER	--	--	X	X	--	--	--	X	--	--	--	--	
	SOAP DISPENSER	--	--	X	X	--	--	--	X	--	--	--	--	
10/11 0000	MISCELLANEOUS SPECIALTIES AND EQUIPMENT													
	SMART SAFE	X	--	X	--	--	--	X	--	--	--	--	LOOMIS	

NOTE:
THE RESPONSIBILITY SCHEDULE IS MEANT TO PROVIDE AN OVERVIEW OF OWNER FURNISHED AND OWNER PROVIDED ITEMS. THIS IS NOT MEANT TO REPLACE THE GC OBLIGATIONS WITHIN THE DRAWINGS AND SPECIFICATIONS.

RESPONSIBILITY SCHEDULE																
SPEC SECTION	ELEMENT	NATIONAL ACCOUNT PRICING	EXISTING	ALDI			GENERAL CONTRACTOR			LAND LORD			REMARKS			
				FURNISHED	INSTALLED	COORDINATE	FURNISHED	INSTALLED	COORDINATE	FURNISHED	INSTALLED	COORDINATE				

DIVISION 11 - EQUIPMENT

114000	FOODSERVICE EQUIPMENT													
	COMPRESSOR/CONDENSER	X	--		X	X	--	--	--	X	--	--	--	GC TO PROVIDE STRUCTURAL SUPPORT FOR EQUIPMENT MOUNTING SEE REFRIGERATION DRAWINGS FOR ADDITIONAL REQUIREMENTS
	COOLER/FREEZER - DOOR - CUSTOMER	X	--	X	X	--	--	--	X	--	--	--	--	THERMOSEAL
	COOLER/FREEZER - DOOR - SERVICE	X	--	X	X	--	--	--	X	--	--	--	--	--
	COOLER/FREEZER - EVAPORATORS	X	--	X	X	--	--	--	--	--	--	--	--	--
	COOLER/FREEZER - LIGHTING	X	--	--	X	--	X	--	--	--	--	--	--	COOLER AND FREEZER LIGHTING FURNISHED BY GC AND INSTALLED BY REFRIGERATION CONTRACTOR
	COOLER/FREEZER - OCCUPANCY SENSORS	--	--	X	X	--	--	--	--	--	--	--	--	--
	COOLER/FREEZER - WALK-IN BOX	X	--	X	X	--	--	--	X	--	--	--	--	--
	FLOOR SCRUBBER	X	--	X	X	--	--	--	--	--	--	--	--	TENNANT
	MULTI-DECK UNIT	X	--	X	X	--	--	--	--	--	--	--	--	SEE REFRIGERATION DRAWINGS FOR VENDOR
	MULTI-DECK UNIT - FILLER PANEL	--	--	X	X	--	--	--	--	--	--	--	--	--
	PALLET JACKS / STACKERS	X	--	X	X	--	--	--	--	--	--	--	--	CROWN, RAYMOND, <u>OR</u> GLOBAL INDUSTRIAL ETC.
	REFRIGERATION EQUIPMENT DISCONNECT	--	--	--	--	--	X	X	--	--	--	--	--	--
REFRIGERATION REMOTE PANEL	--	--	X	X	--	--	--	--	X	--	--	--	SEE REFRIGERATION DRAWINGS IF APPLICABLE	
DRAWING	SCO (SELF CHECKOUT) UNIT	--	--	X	X	--	--	--	X	--	--	--	DIEBOLD NIXDORF CONTRACTOR RESPONSIBLE FOR PROVIDING POWER AND DATA CONNECTION POINTS TO UNIT VIA POWERPOLES AND/OR WALL CHASE	
DRAWING	WASTE COMPACTOR AND DESTRUCTORS													
	BALER	X	--	X	X	--	--	--	X	--	--	--	BACE	
	BALER DISCONNECT SWITCH	--	--	--	--	--	X	X	--	--	--	--	COORDINATE FINAL DISCONNECT LOCATION TO BE ON POWER SUPPLY SIDE OF BALER	

DIVISION 23 - HVAC																
	IAQ IONIZATION UNIT	X	--	X	X	--	--	--	X	--	--	--	UNIT TO BE SHIPPED W/ SIEMENS INDUSTRY, INC ORDER AND INSTALLED BY REFRIGERATION CONTRACTOR			

DIVISION 25 - INTEGRATED AUTOMATION														
DRAWING	ENERGY MANAGEMENT SYSTEM													
	HVAC	X	--	X	X	--	--	--	X	--	--	--	SIEMENS INDUSTRY, INC.	
	LIGHTING	X	--	X	X	--	--	--	X	--	--	--	SIEMENS INDUSTRY, INC.	
	REFRIGERATION	X	--	X	X	--	--	--	X	--	--	--	DANFOSS	

DIVISION 27 - COMMUNICATIONS														
DRAWING	I.T. RACK	--	--	X	X	--	--	--	X	--	--	--	MIDDLE ATLANTIC PRODUCTS	
DRAWING	ROOF MAST - ANTENNA	--	--	X	X	--	--	--	X	--	--	--	ALDI TO PROVIDE ANTENNA REFER TO G-005 'DIVISION 27 - COMMUNICATIONS, ROOF MAST' FOR ROOF MAST ASSEMBLY, BALLAST, AND CONDUIT SCOPE.	
DRAWING	SECURITY MONITOR - ECOMMERCE	--	--	X	X	--	--	--	X	--	--	--		
DRAWING	SECURITY / CCTV / FIRE ALARM SYSTEMS	--	--	X	X	--	--	X	X	--	--	--	EVERON (FORMERLY PROTECTION 1)	
DRAWING	TIME CLOCK	--	--	X	X	--	--	--	X	--	--	--	--	



Copyright © 2024
APD Engineering & Architecture
03/27/2018

Drawing Alteration

It is a violation of law for any person, unless acting under the direction of licensed Architect, Professional Engineer, Landscape Architect, or Land Surveyor to alter any item on this document in any way. Any licensee who alters this document is required by law to affix his or her seal and to add the notation "Altered By" followed by his or her signature and the specific description of the alteration or revision.

DO NOT SCALE PLANS

Copying, Printing, Software and other processes required to produce these prints can stretch or shrink the actual paper or layout. Therefore, scaling of this drawing may be inaccurate. Contact APD E&A with any need for additional dimensions or clarifications.

Issued:	Date:
A Issued for Permit	07/08/24
B Issued for Bid	07/29/25
C	
D	
E	

Revisions:	Date:
1 Owner Changes	11/18/24
2 Owner Changes	07/29/25
3	
4	
5	
6	
7	
8	
9	
10	
11	
12	

PROJECT ARCHITECT/ENGINEER
Daniel Sargent

PROJECT LEAD
John Lynch

NOT FOR
CONSTRUCTION



ALDI Inc. Store #: 50
Coconut Crossing, FL
12850 Northlake Boulevard
Palm Beach Gardens, FL 33412
Palm Beach County
Project Name & Location:

Responsibility Schedule -

Appendix B

Drawing Name:

Prototype:	Project No.
V7.08 LHRD	22-0267A
Type:	
GROUND UP	G-007
Drawn By:	
JWL	
Scale:	Drawing No.
As Noted	

PLOTTED: 7/29/2025 9:43 AM

FLOOR FINISH SCHEDULE	
01	CONCRETE SLAB - SMOOTH FINISH
02	CONCRETE SLAB (FREEZER) - HEAVY BROOM FINISH
03	CONCRETE SLAB (COOLER) - SMOOTH FINISH
04	CONCRETE SLAB - SHADED AREA INDICATES EXTENTS OF GROUND AND POLISHED CONCRETE SLAB - SEE SPECS - CONFIRM DESIRED FINISH WITH ALDI CONSTRUCTION REPRESENTATIVE
05	CONCRETE SLAB (VESTIBULE) - SMOOTH FINISH


- NOTES:
- REFER TO DRAWING A-603 FOR COLOR/ FINISH/ MATERIAL SCHEDULES.
 - ALL PARTITION DIMENSIONS ARE TO FACE OF STUD UNLESS NOTED OTHERWISE (IE. CLEAR)
 - PROVIDE BLOCKING AS NEEDED FOR ALL WALL MOUNTED ITEMS
 - REFER TO DRAWING A-102 FOR FLOOR MOUNTED EQUIPMENT
 - REFER TO DRAWING A-603 FOR INTERIOR METAL STUD INFORMATION
- (X) INDICATES COLUMN DESIGNATION

- SLAB NOTES:
- FINISHED FLOOR = 0'-0" (22.50) UNLESS NOTED OTHERWISE, REFER TO SHEET S-102 FOR TOP OF FINISH FLOOR ELEVATIONS.
 - SOIL POISONING FOR TERMITE CONTROL: REFER TO SPECIFICATION SECTION 31311.6 - TERMITE CONTROL, TERMITE PROTECTION STATEMENT.
 - A SIGNED CONTRACT ASSURING THE INSTALLATION, MAINTENANCE, AND MONITORING OF THE BAITING SYSTEM FOR A MINIMUM OF 5 YEARS FROM THE ISSUE OF CERTIFICATE OF OCCUPANCY SHALL BE PROVIDED TO THE BUILDING OFFICIAL PRIOR TO THE POURING OF THE SLAB AND THE SYSTEM MUST BE INSTALLED PRIOR TO THE FINAL BUILDING APPROVAL. IF THE BAITING SYSTEM DIRECTIONS FOR USE REQUIRE A MONITORING PHASE COMPONENT SHALL BE DEEMED TO CONSTITUTE INSTALLATION OF THE SYSTEM.
 - TROWEL AND FINE-BROOM FINISH: APPLY A FIRST TROWEL FINISH TO SURFACES WHERE CERAMIC OR PORCELAIN TILE IS TO BE INSTALLED BY EITHER THICKSET OR THIN-SET METHOD. WHILE CONCRETE IS STILL PLASTIC, SLIGHTLY SCARIFY SURFACE WITH A FINE BROOM, REFER TO SPEC SECTION 033000 FOR ADDITIONAL CONCRETE FINISHING INFORMATION.

- FIRE DEPARTMENT NOTES:
- PROVIDE FIRE KEY (KNOX) BOX COORD. EXACT LOCATION W/ LOCAL FIRE MARSHALL.
 - PROVIDE BUILDING ADDRESS NUMBERS THAT SHALL BE BETWEEN 8'-12" HIGH AND CONTRASTING WITH THEIR BACKGROUND.

1 Floor Plan

SCALE: 1/8" = 1'-0"

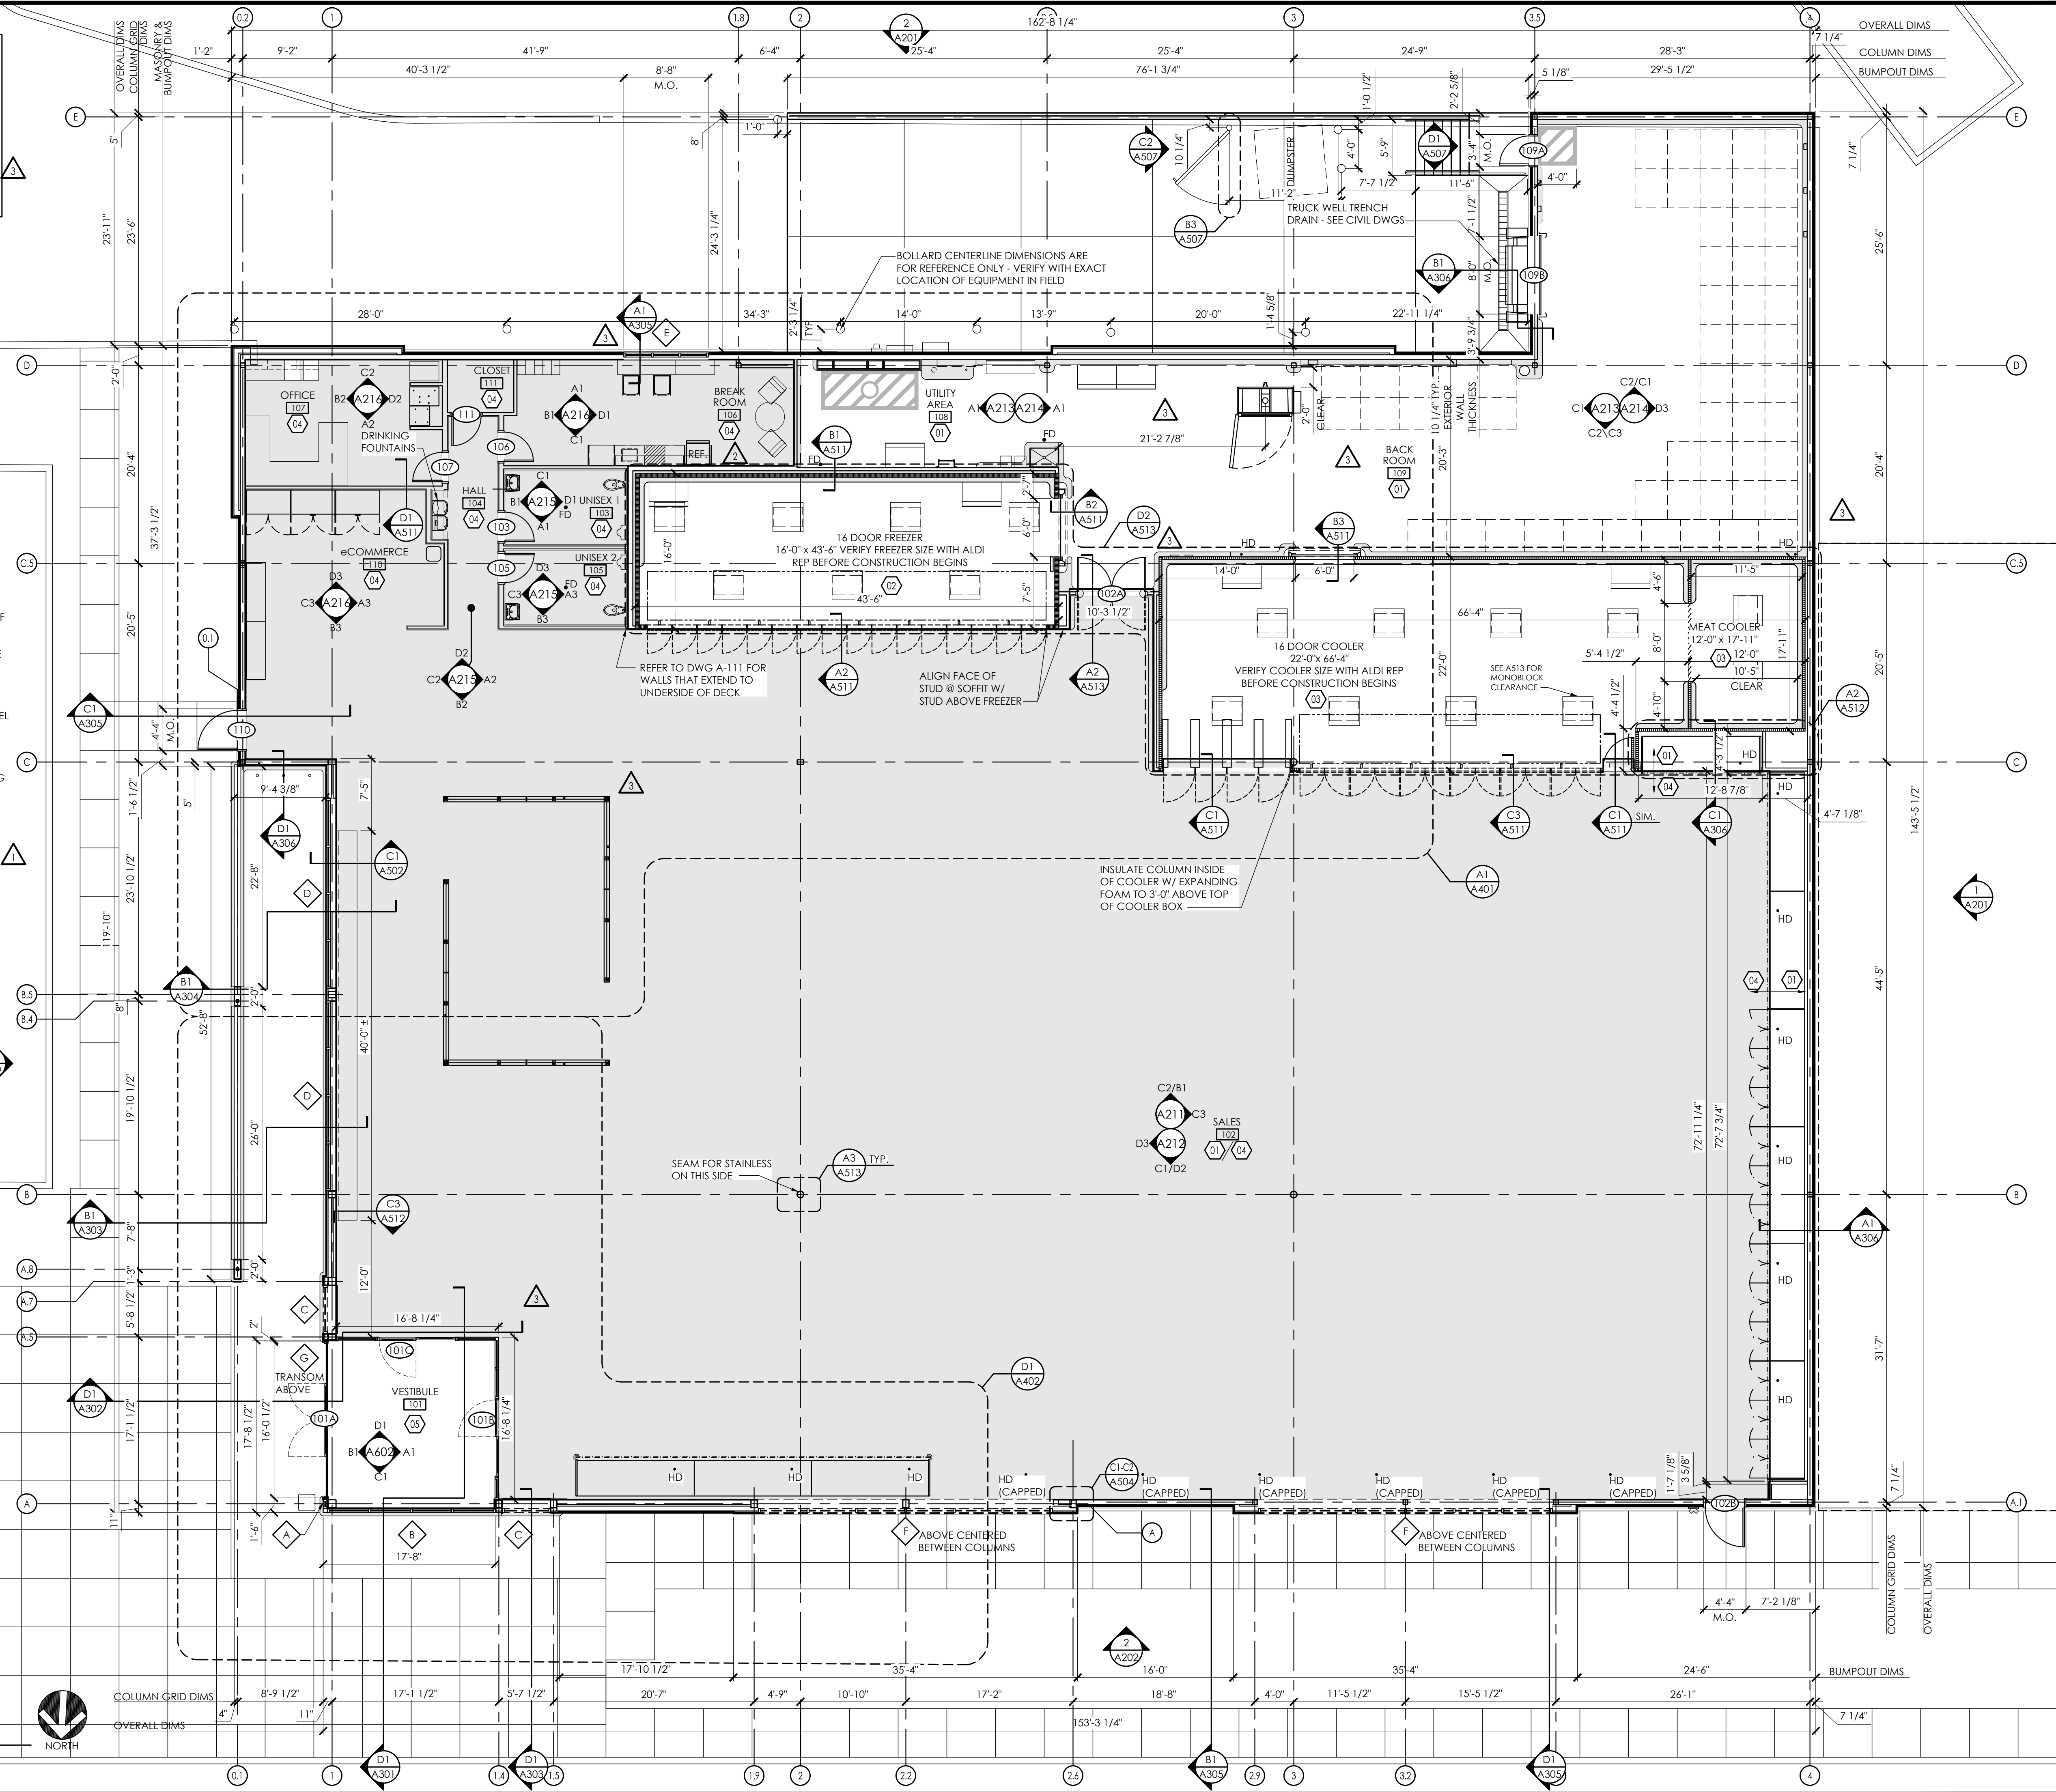

Copyright © 2024

APD Engineering & Architecture
03/27/19/1224

Drawing Alteration

It is a violation of law for any person, unless acting under the direction of licensed Architect, Professional Engineer, Landscape Architect, or Land Surveyor to alter any item on this document in any way. Any licensee who alters this document is required by law to affix his or her seal and to add the notation "Altered By" followed by his or her signature and the specific description of the alteration or revision.

DO NOT SCALE PLANS

Copying, Printing, Software and other processes required to produce these prints can stretch or shrink the actual paper or layout. Therefore, scaling of this drawing may be inaccurate. Contact APD E&A with any need for additional dimensions or clarifications.

Issued: Date:

A Issued for Permit 07/08/24

B Issued for Bid 07/29/25

C

D

E

Revisions: Date:

1 AHJ Responses 10/02/24

2 Owner Changes 11/18/24

3 Owner Changes 07/29/25

4

5

6

7

8

9

10

11

12

PROJECT ARCHITECT/ENGINEER


Daniel Sargent

PROJECT LEAD

John Lynch

**NOT FOR
CONSTRUCTION**

Seal Seal

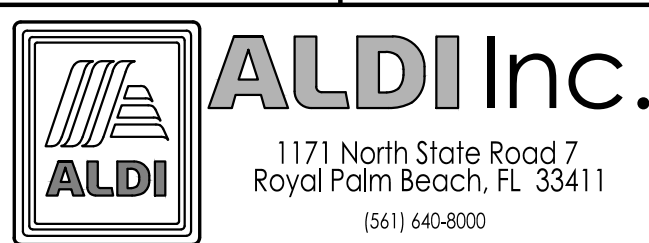

ALDI Inc. Store #: 50
Coconut Crossing, FL
12850 Northlake Boulevard
Palm Beach Gardens, FL 33412
Palm Beach County
Project Name & Location:

Floor Plan

Drawing Name:

Prototype:

V7.08 LHRD

Type:

GROUND UP

Drawn By:

JWL

Scale:

As Noted

Project No.

22-0267A

A-101

Drawing No.

PLOTTED: 7/29/2025 9:43 AM

KEYED NOTES:

100 SERIES
CONTRACTOR PROVIDED (FURNISHED & INSTALLED)

- 101 CPB 6" PALLET BUMPER REFER TO DWG. A1/A304 - CONTRACTOR SHALL FULLY WELD ALL SEAMS AND GRIND SMOOTH PRIOR TO PAINT
- 102 CRTB 4" d x 6" h CONC. CART BUMPER - PROVIDE SAWN OR TOOLED JOINTS AT ALL CORNERS
- 103 ROOF ACCESS LADDER
- 104 CG-ST PROVIDE AT ALL INSIDE AND OUTSIDE CORNERS OF UTILITY ROOM AND BACK ROOM
- 105 BLRD-2 10" Ø PIPE BOLLARD - SEE STRUCT DWGS
- 106 NOT USED
- 107 5/16" x 3 1/2" x 6" REVERSE ANGLE PALLET BUMPER - HOLD TIGHT TO WALL
- 108 STAINLESS STEEL BUMPER GUARD - REFER TO INTERIOR ELEVATIONS FOR LOCATIONS. INSTALL PER MFR RECOMMENDATIONS; SEE SPEC
- 109 HOT WATER HEATER - SEE INT ELEV C3/A213
- 110 WALK OFF MAT - LAYOUT BY NATIONAL VENDOR; SEE SPEC
- 111 6" THICK EQUIPMENT PAD - VERIFY SIZE W/ ELECT AND PLUMB CONTRACTORS PRIOR TO INSTALLATION
- 112 BLRD-3 3" GALVANIZED STEEL POSTS - SEE A603
- 113 MOP BASIN - INSTALL BOTTOM OF BASIN @ FINISHED FLOOR ELEVATION
- 114 SSSR SEE DETAILS A2,C3/A511
- 115 ANODIZED ALUMINUM DOOR PROTECTORS (QUANTITY OF 4) COORD LOCATIONS WITH ALDI CONSTRUCTION REPRESENTATIVE. SEE SPECIFICATION SECTION 055000
- 116 PIPE GUARDRAIL & HANDRAIL
- 117 STAINLESS STEEL COLUMN COVERS - SEE DETAIL A3/A513
- 118 BLRD-4 SEE SECTION B1/A304
- 119 TR-1 TRASH RECEPTACLE - VERIFY LOCATION W/ OWNER'S REPRESENTATIVE
- 120 FIRE EXTINGUISHER - SEE SPEC. MOUNT IN COMPLIANCE WITH REQUIREMENTS OF AUTHORITIES HAVING JURISDICTION
- 121 FIRE & WATER SERVICE - SEE PLUMB DWGS
- 122 SALES FLOOR STL ANGLE (3x4x1/4 w/PUNCHED 1/4" DIAM HOLES @ 24" O.C. MAX & DRILL 6" FROM ENDS AS REQUIRED FOR MERCHANDISE GONDOLAS. COORD LOCATIONS W/ ALDI CONSTRUCTION REP. PT-3 / CL-5
- 123 (4) HEAVY DUTY COAT HOOKS - SEE INT ELEV C3/A213
- 124 ROOF LEADER CLEAN-OUT ON EXTERIOR - SEE PLUMB
- 125 HOSE BIB - SEE PLUMB DWGS
- 126 STRIPE PAINT AREA IN FRONT OF EGRESS DOOR PT-10/CL-4
- 127 STRIPE PAINT AREA IN FRONT ELECTRICAL PANELS PT-10/CL-4 - PROVIDE AN ELECTRICAL CLEARANCE WARNING LABEL - SEE ELEC DWGS
- 128 TRACK GUARDS - SEE SPEC; INSTALL PER MFR'S WRITTEN INSTRUCTIONS
- 129 IMPACT DOORS & HARDWARE - SEE SPEC; INSTALL PER MFR'S WRITTEN INSTRUCTIONS
- 130 BR FLOOR MOUNTED STAINLESS STEEL RAIL - PRE-DRILL MOUNTING HOLES PRIOR TO INSTALLATION OF MULTIDECK UNITS. HOLD AS CLOSE AS POSSIBLE TO MULTIDECK UNITS - SEE SPEC; INSTALL PER MFR'S WRITTEN INSTRUCTIONS
- 131 DOCK LEVELER AND SEAL - SEE SPEC; INSTALL PER MFR'S WRITTEN INSTRUCTIONS
- 132 GUIDANCE RAILING - SEE SPEC; INSTALL PER MFR'S WRITTEN INSTRUCTIONS
- 133 1/2" Ø X 6" GRAY PVC TO HOLD BALER WIRE SEE INT ELEV C1/A214
- 134 BR-C FLOOR MOUNTED CORNER GUARD - SEE SPEC; INSTALL PER MFR'S WRITTEN INSTRUCTIONS
- 135 WP-1 WOOD PANELS; INSTALL PER MFR'S WRITTEN INSTRUCTIONS (ABOVE MDUS)
- 136 MULTI-DECK UNIT CLOSURE PANEL - INSTALL 22 GAUGE STAINLESS STEEL OR ALUMINUM (BRUSHED FINISH) AT END OF UNIT FROM FINISHED FLOOR TO TOP OF CASE. WIDTH TO ALLOW FOR SHORT ZIP SCREW (SILVER) ATTACHMENT TO END PANEL AND 1/2" BEND AT WALL INTERSECTION. USE CLEAR SILICONE AT WALL TO ALLOW FOR MOVEMENT.
- 137 4'-0" X 8" GRAY PVC TO HOLD AS-BUILT DWGS - SEE INT ELEV C1/A214
- 138 (20 GA) GALVANIZED METAL CLOSURE W/ 1/2" RETURN - PROVIDE SEALANT @ EDGES OF CLOSURE
- 139 AC-1 BABY CHANGING STATION
- 140 AC-3 GRAB BAR
- 141 AC-4 MIRROR UNIT
- 142 AC-5 HAND DRYER AND WALL GUARD

200 SERIES
OWNER FURNISHED & CONTRACTOR INSTALLED - REFER TO APPENDIX 'A' OF THE PROJECT CONTRACT MANUAL


- 201 HANGING "NO PARKING" SIGN
- 202 CHECKOUT COUNTER
- 203 R-1 REFRIGERATOR
- 204 LMW-1 MICROWAVE OVEN
- 205 eCOMMERCE SHELVING - SEE A131 FOR SIZE
- 206 SHELVING AND HOLD AREAS - INSTALL REVERSE ANGLE PALLET BUMPER AT BASE OF SHELVING TO FLOOR WITH (4) ANCHORS
- 207 INTERIOR GRAPHICS & MILLWORK - TO BE INSTALLED PRIOR TO STORE TURNOVER TO OPERATIONS
- 208 COOLER/FREEZER RACKING SYSTEM
- 209 SAFE & SAFE CABINET, SEE DETAILS B1.B2/A513
- 210 LOCKERS - PROVIDE MINIMUM 5% ACCESSIBLE LOCKERS
- 211 MANAGER ORGANIZATION DESK
- 212 BREAKROOM CASEWORK
- 213 OFFICE DESK - PROVIDE 2" GROMMETS IN COUNTERTOP - CONFIRM LOCATIONS WITH ALDI REP PRIOR TO DRILLING
- 214 OFFICE CASEWORK
- 215 NOT USED
- 216 TABLE & CHAIRS
- 217 WALL MOUNTED SACKING COUNTER
- 218 CG-A INSTALL AT ALL INSIDE & OUTSIDE CORNERS AT SALES, HALL, & VESTIBULE
- 219 POWER WALL - REFER TO ELEC DWGS
- 220 SPOT MERCHANDISER
- 221 SS BASE PROTECTION ATTACHED TO SPOT MERCHANDISER FRAME
- 222 MERCHANDISING FIXTURES
- 223 BATTERY CHARGERS
- 224 ALDI MIRROR
- 225 PROJECTED IMAGE FROM PROJECTOR ABOVE - SEE A111 FOR PROJECTOR LOCATION
- 226 QUARTER CART SIGN 4'-6" AFF TO BOTTOM OF SIGN
- 227 QUARTER CART SIGN CENTERED AT 7'-6" AFF TO CENTER OF SIGN
- 228 GRAPHIC SCREEN WALL; INSTALL PER MFR'S INSTRUCTIONS. CORE DRILL FLOOR FOR POSTS
- 229 SCO SCREEN WALL; INSTALL PER MFR'S INSTRUCTIONS. CORE DRILL FLOOR FOR POSTS
- 230 R-2 REFRIGERATOR (eCOMMERCE)
- 231 F-1 FREEZER (eCOMMERCE)
- 232 FILING CABINET
- 233 BREAK ROOM HIGH TOP COUNTER AND CHAIRS - SEE D2/A512
- 234 DW-1 DISHWASHER

300 SERIES
OWNER PROVIDED (FURNISHED & INSTALLED) - REFER TO APPENDIX 'B' OF THE PROJECT CONTRACT MANUAL

- 301 WALK-IN COOLER
- 302 WALK-IN FREEZER
- 303 PALLET JACKS/STACKERS
- 304 FUTURE CHECKOUT
- 305 MULTI-DECK UNIT
- 306 AUTOMATIC SLIDING DOORS W/ BREAKAWAY HINGED EMERGENCY EXIT
- 307 TIME CLOCK MOUNTING BRACKET
- 308 DUMPSTER
- 309 I.T. RACK - COORDINATE WITH ALDI CONSTRUCTION REPRESENTATIVE
- 310 WALK-IN MEAT COOLER
- 311 SHOPPING CARTS - VERIFY SIZE OF CARTS ORDERED WITH ALDI CONSTRUCTION REPRESENTATIVE PRIOR TO REPLACEMENT OF RAILS & STARTER POSTS
- 312 BALER
- 313 SMART SAFE
- 314 FLOOR SCRUBBER
- 315 SELF CHECKOUT (SCO) COUNTERS
- 316 FUTURE SELF CHECKOUT (SCO) COUNTERS
- 317 BEVERAGE COOLER
- 318 NOT USED
- 319 SOAP DISPENSER
- 320 TOILET PAPER DISPENSER
- 321 EVAPORATOR/MONOBLOCK - VERIFY LOCATION W/ REFRIGERATION PACKAGE
- 322 NOT USED
- 323 NOT USED

NOTES:

- A. VERIFY INSTALLATION OF ALL OWNER FURNISHED ITEMS WITH OWNER'S REPRESENTATIVE.
- B. REFER TO DRAWING A-603 FOR COLOR/ FINISH/ MATERIAL SCHEDULES.

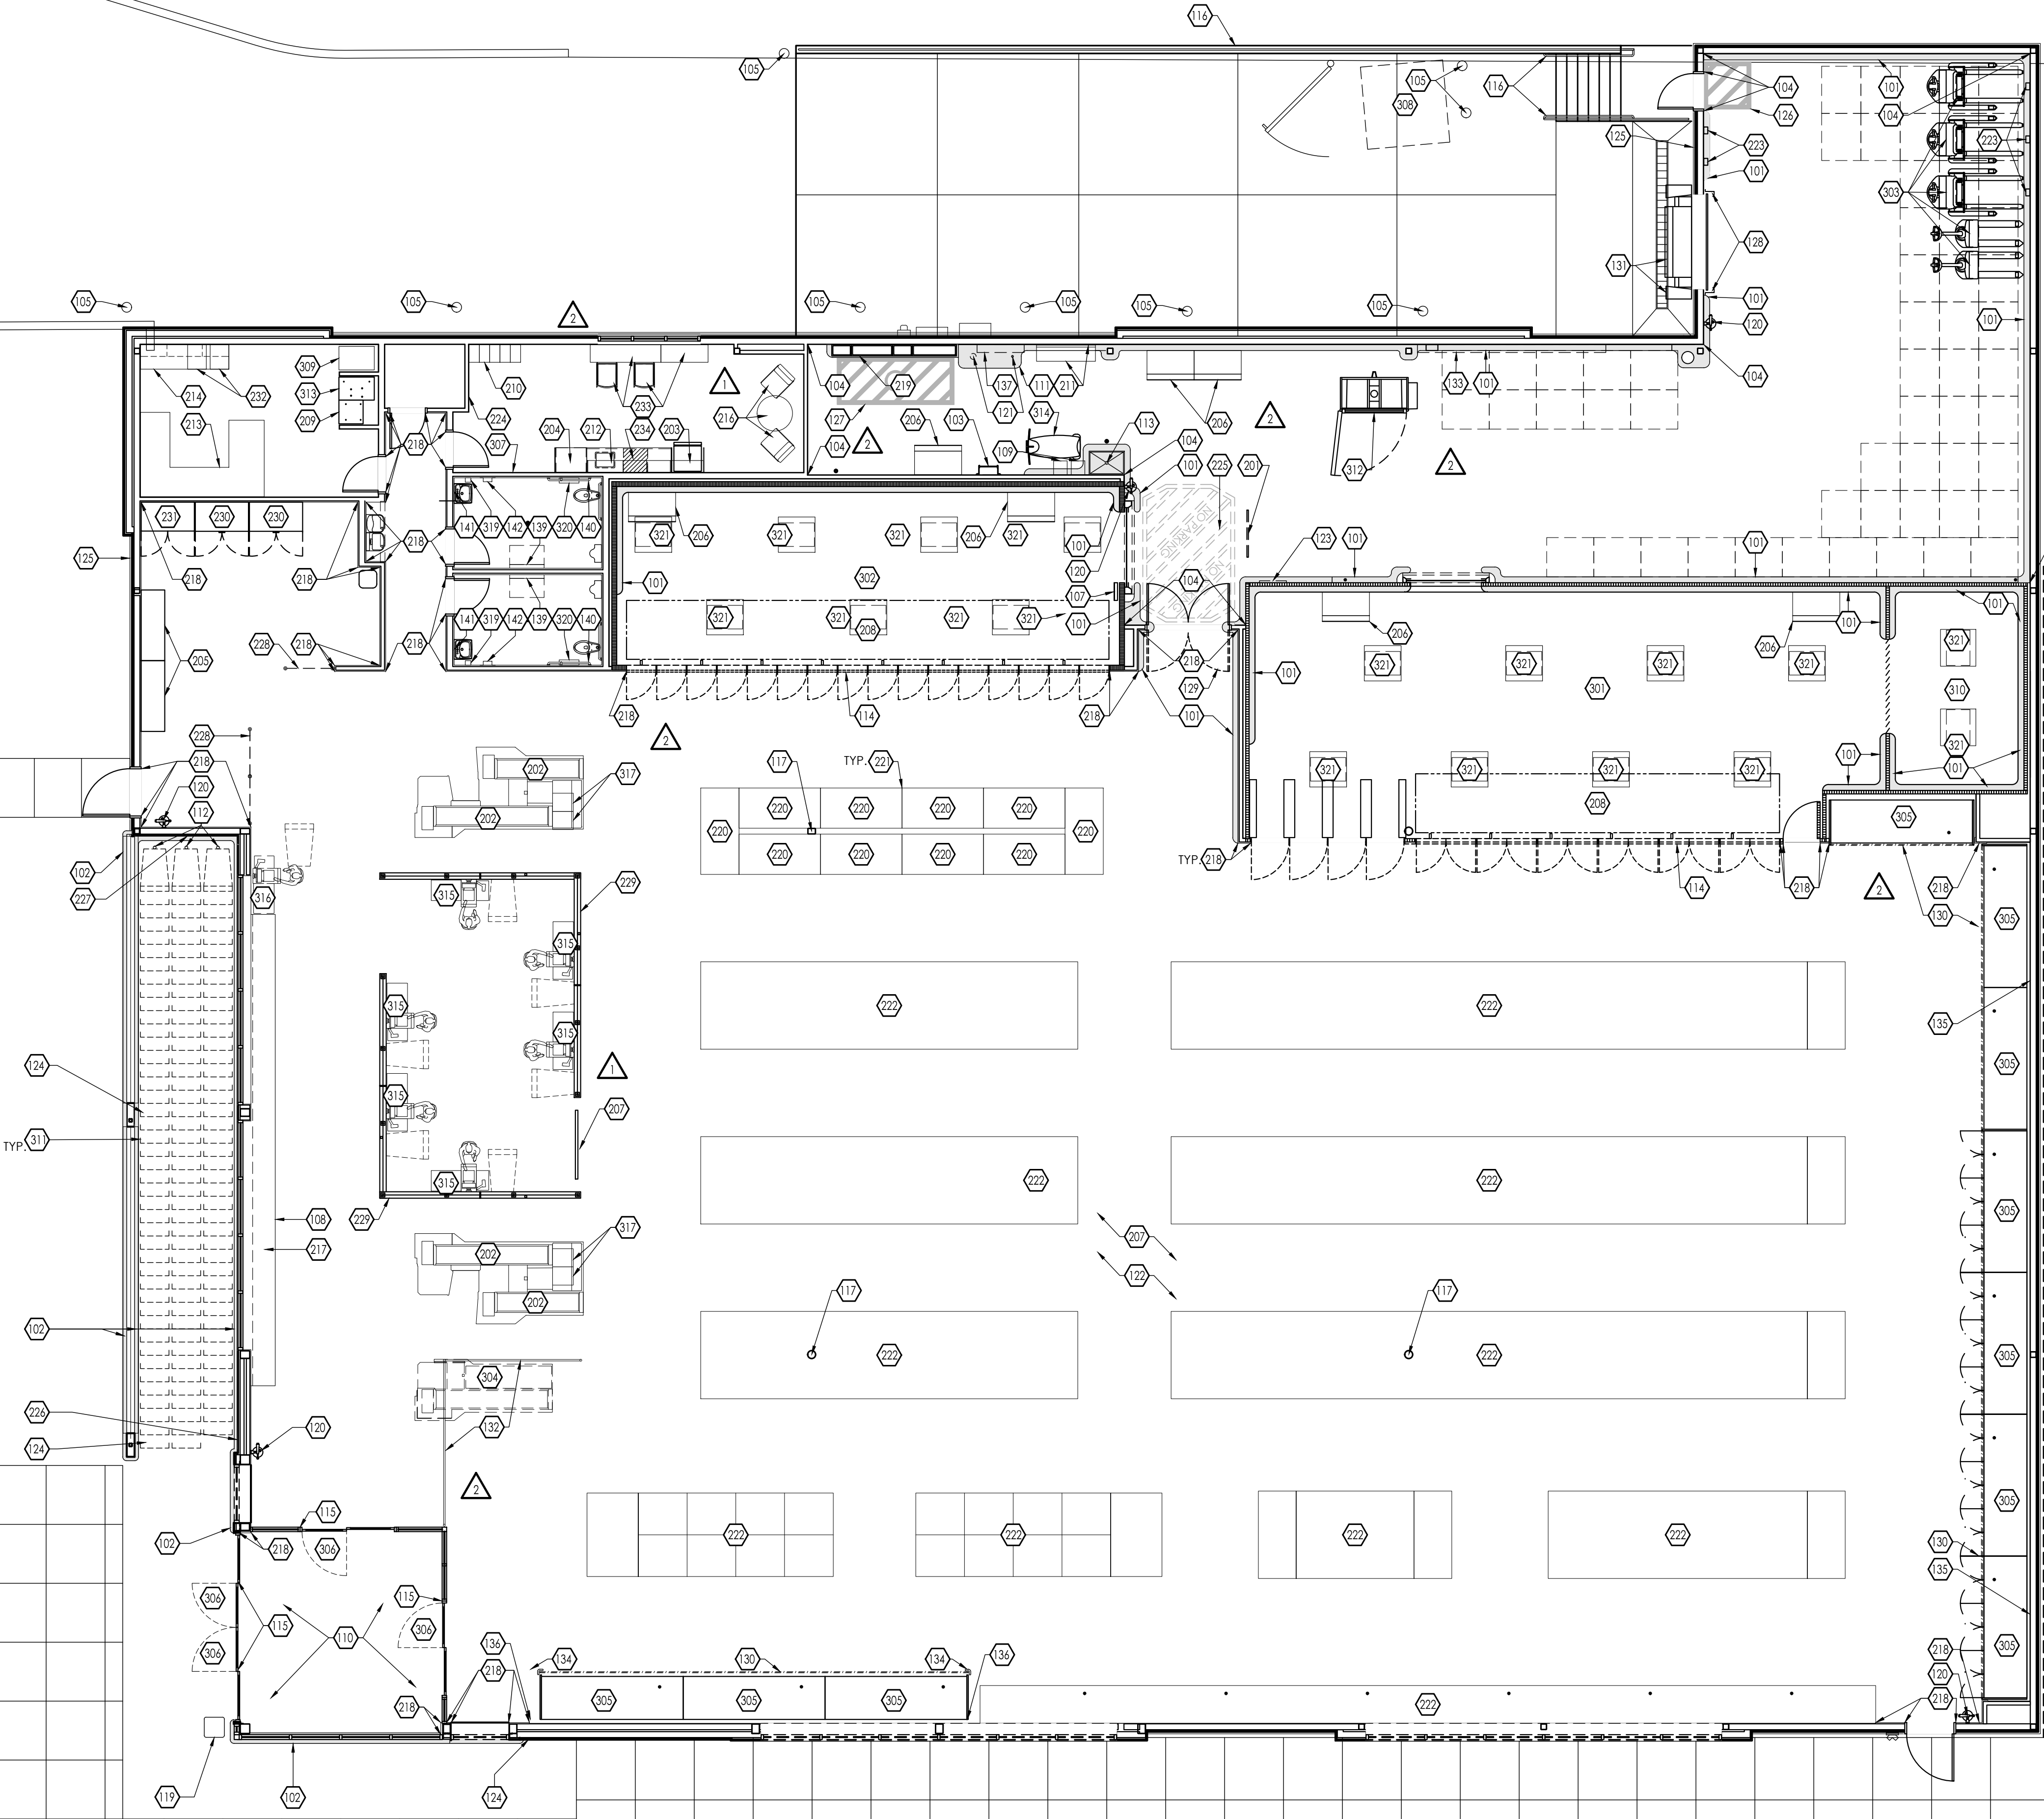

1 Keyed Notes Plan
SCALE: 1/8" = 1'-0"



Copyright © 2024
APD Engineering & Architecture
03/21/2024

Drawing Alteration

It is a violation of law for any person, unless acting under the direction of licensed Architect, Professional Engineer, Landscape Architect, or Land Surveyor to alter any item on this document in any way. Any licensee who alters this document is required by law to affix his or her seal and to add the notation "Altered By" followed by his or her signature and the specific description of the alteration or revision.

DO NOT SCALE PLANS

Copying, Printing, Software and other processes required to produce these prints can stretch or shrink the actual paper or layout. Therefore, scaling of this drawing may be inaccurate. Contact APD E&A with any need for additional dimensions or clarifications.

Issued:		Date:
A	Issued for Permit	07/08/24
B	Issued for Bid	07/29/25
C		
D		
E		
Revisions:		Date:
1	Owner Changes	11/18/24
2	Owner Changes	07/29/25
3		
4		
5		
6		
7		
8		
9		
10		
11		
12		

PROJECT ARCHITECT/ENGINEER

Daniel Sargent

PROJECT LEAD

John Lynch

**NOT FOR
CONSTRUCTION**

SealSeal


**ALDI Inc.**
1171 North State Road 7
Royal Palm Beach, FL 33411
(561) 640-8000

ALDI Inc. Store #: 50
Coconut Crossing, FL
12850 Northlake Boulevard
Palm Beach Gardens, FL 33412
Palm Beach County
Project Name & Location:

Keyed
Notes Plan

Drawing Name:


Prototype:	Project No.
V7.08 LHRD	22-0267A
Type:	
GROUND UP	
Drawn By:	
JWL	
Scale:	
As Noted	
	A-102
	Drawing No.

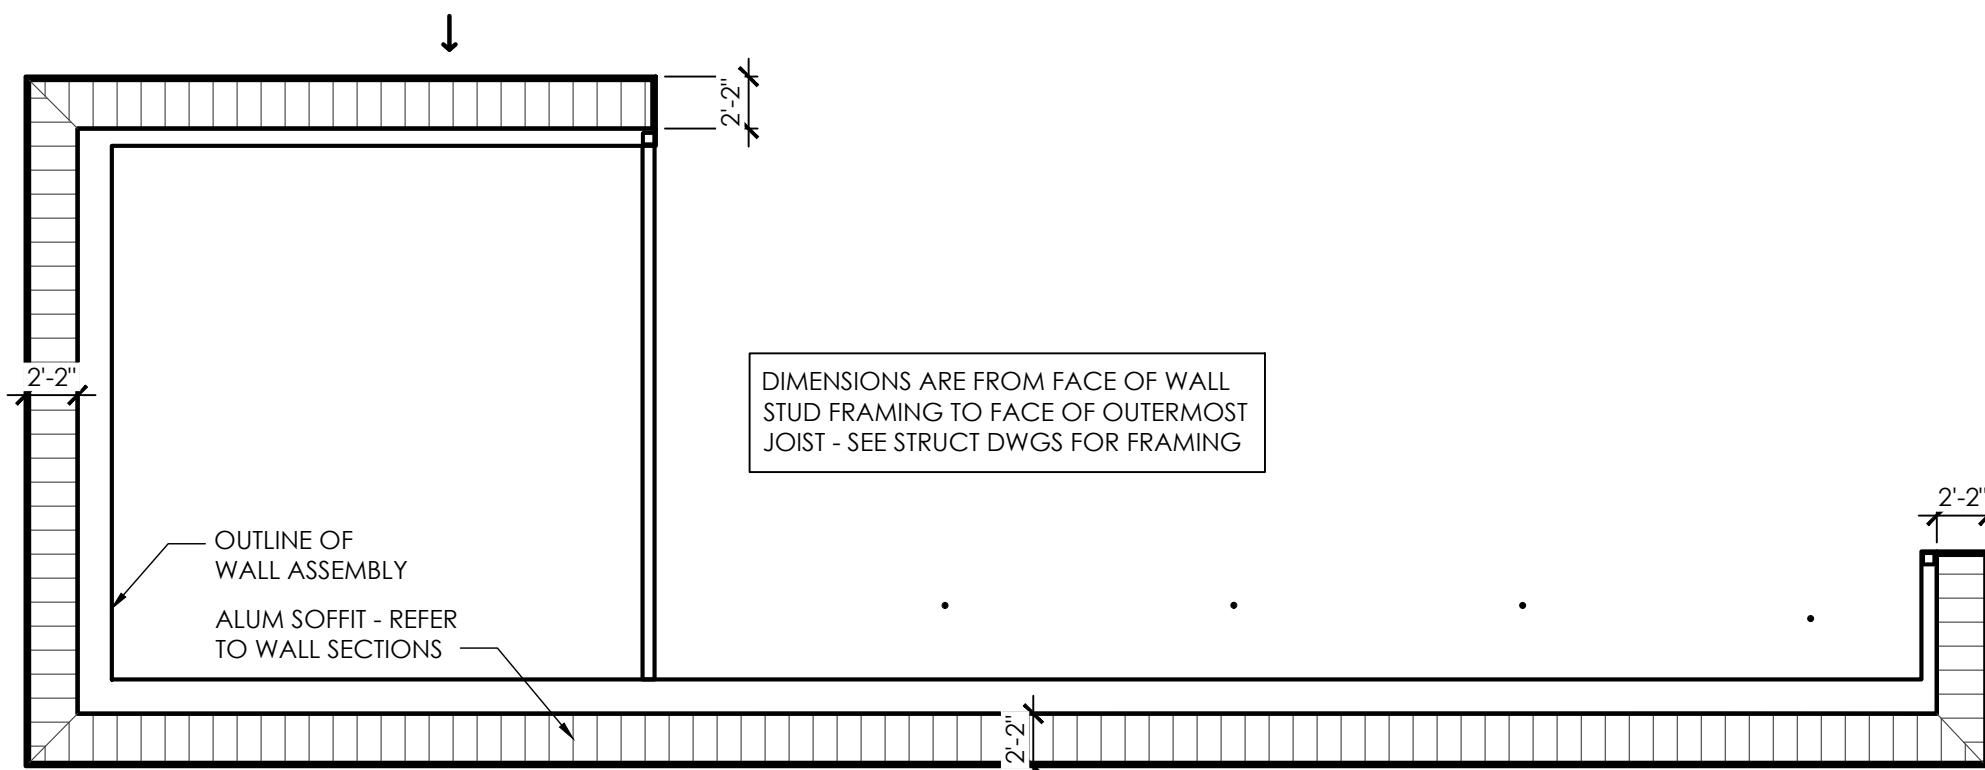

High Roof Reflected Ceiling Plan

2

SCALE: 1/8" = 1'-0"

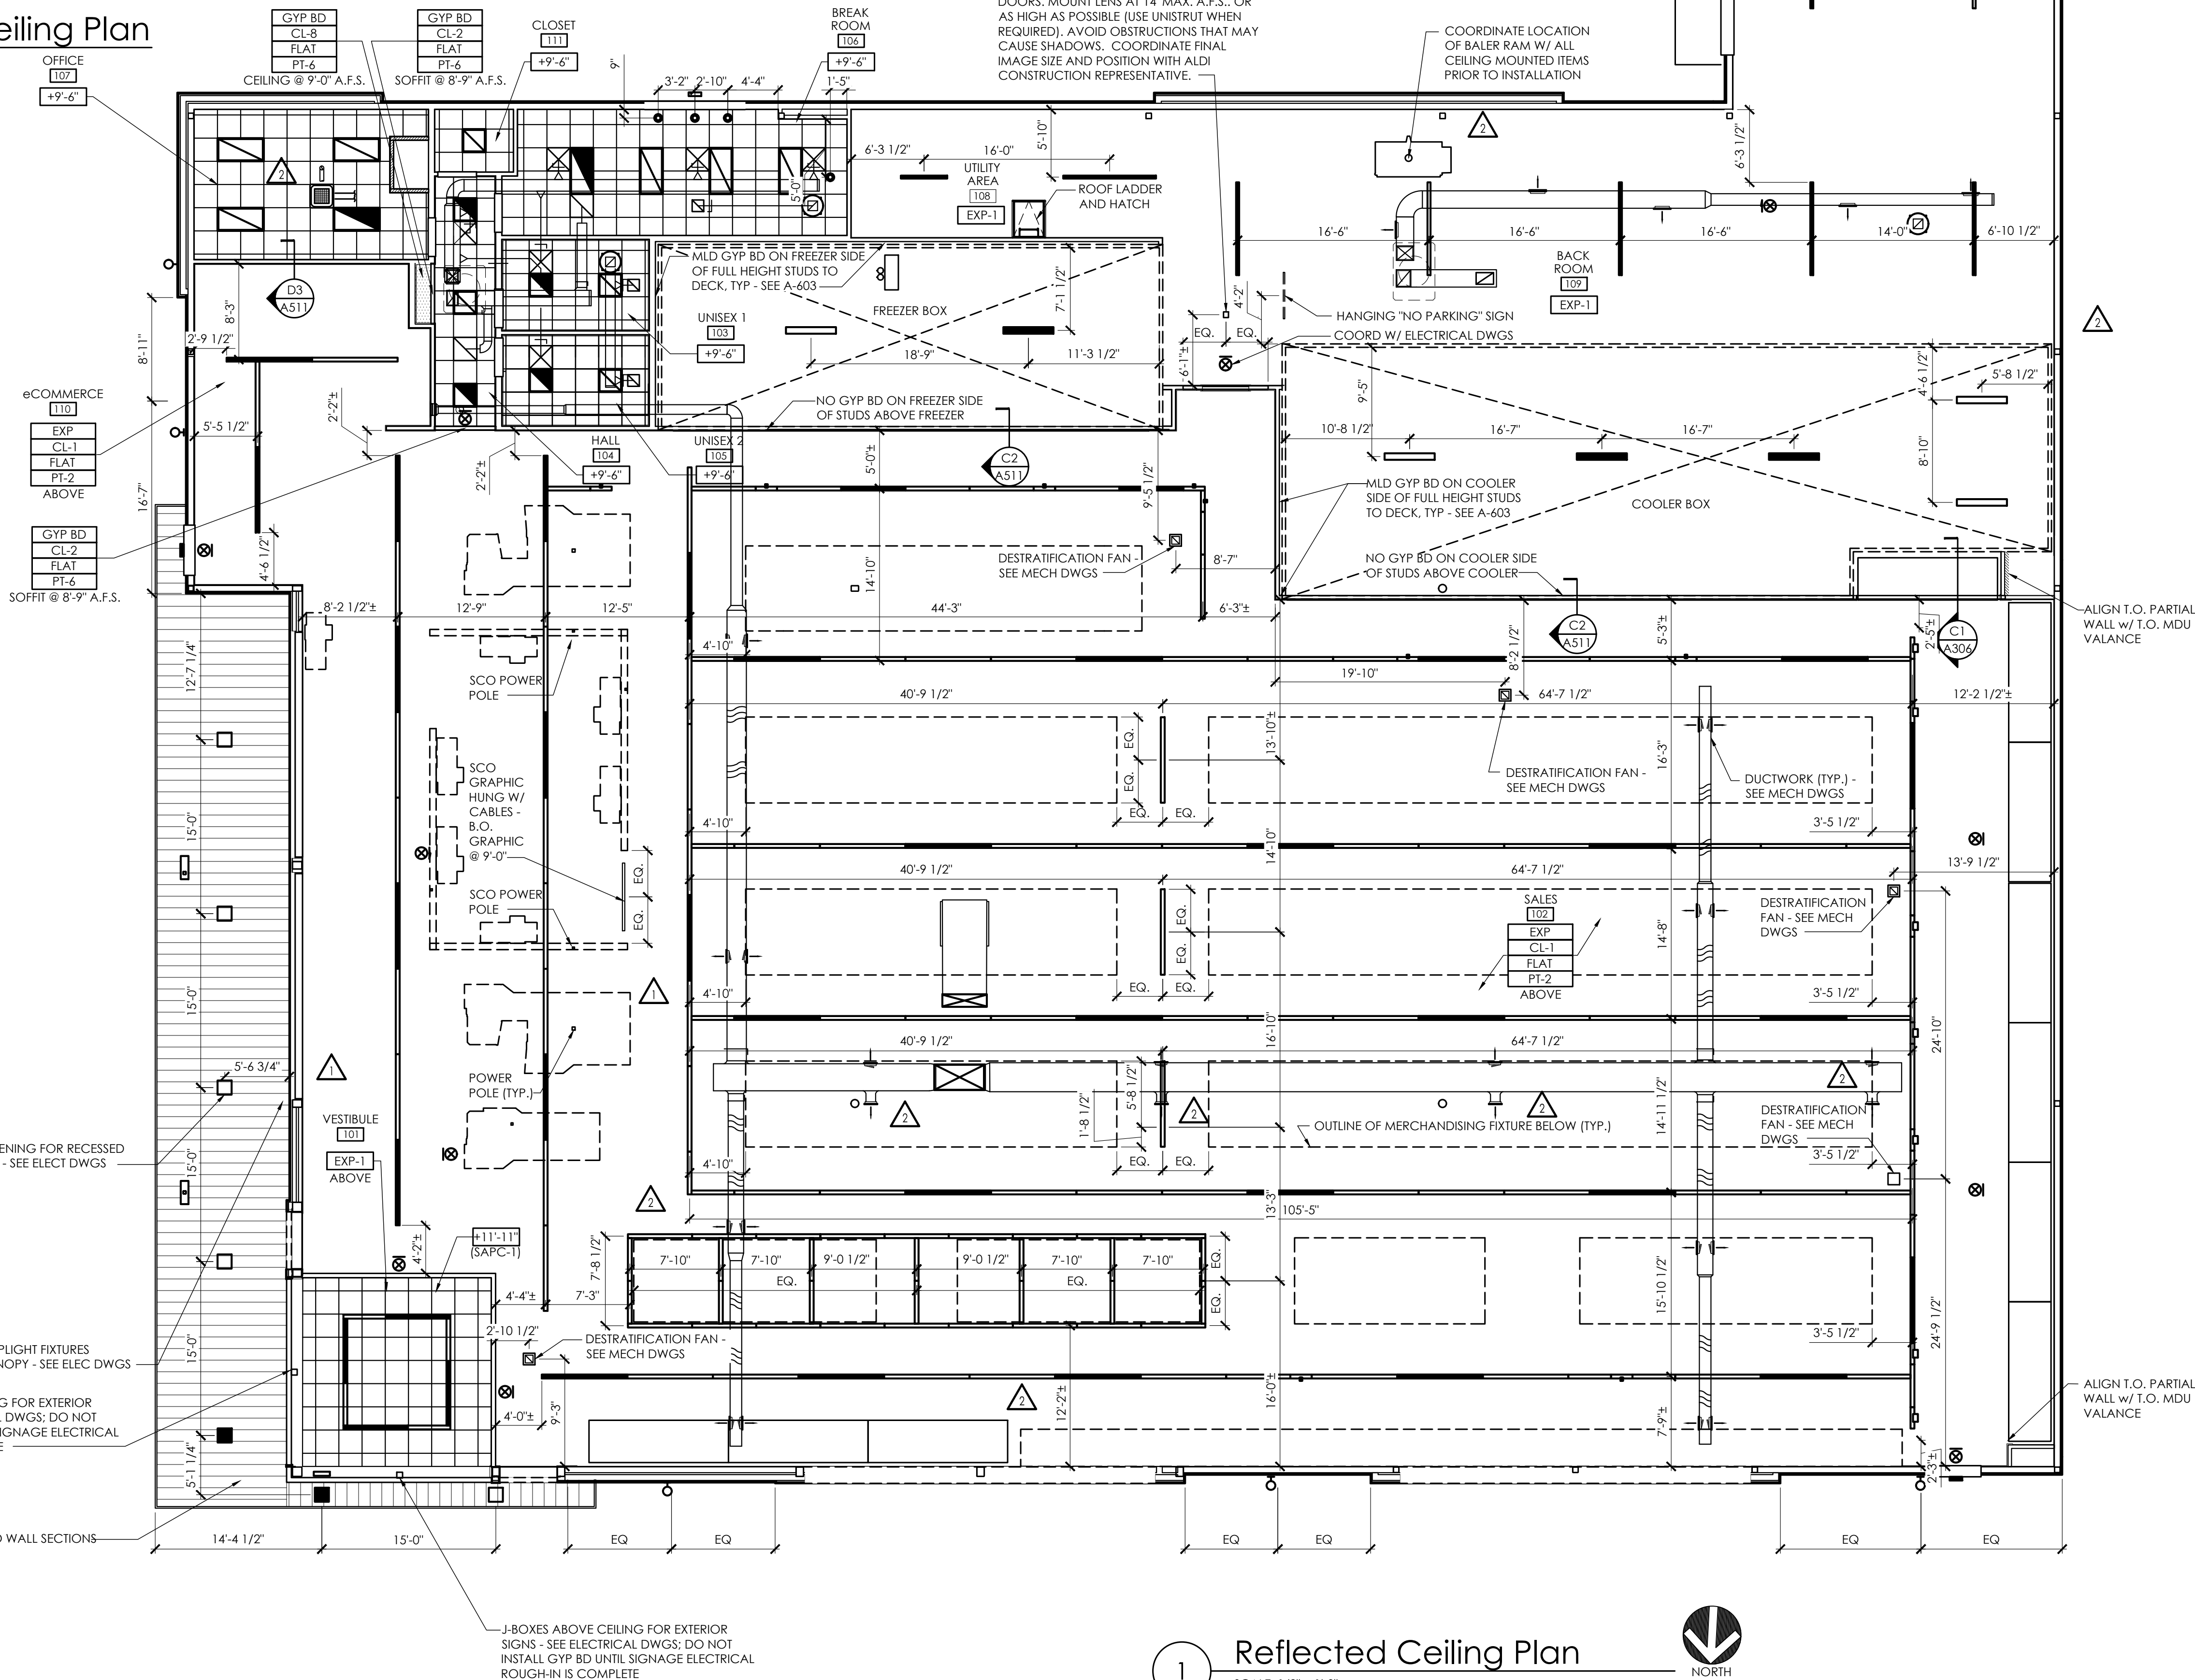

1

Reflected Ceiling Plan

SCALE: 1/8" = 1'-0"



NOTE:

- COORDINATE WITH STRUCTURAL, PLUMBING, MECHANICAL AND ELECTRICAL FOR ALL ITEMS PROVIDED BY THOSE DISCIPLINES. CONTRACTOR SHALL BE RESPONSIBLE FOR LAYING OUT ALL CEILING MOUNTED ELEMENTS WITH ALL OTHER CEILING MOUNTED EQUIPMENT AND STRUCTURE AND CORRECTING ANY INTERFERENCE PRIOR TO INSTALLATION.
- PREPARE AND PAINT ALL CEILING MOUNTED ITEMS ON SALES FLOOR, INCLUDING BUT NOT LIMITED TO HVAC DIFFUSERS AND RETURNS, THREADED ROD, CONDUIT AND SPRINKLER PIPING. DO NOT PAINT EVAC CONDENSATE REMOVAL SYSTEM PINCH VALVES, OR ANY WIRELESS ACCESS POINT APPLIANCES PROVIDED BY ALDI.
- ALL DIMENSIONS ARE TO FACE OF WALL FINISH UNLESS OTHERWISE NOTED.
- ALL DIMENSIONS TO LIGHT LOCATIONS ARE TO CENTERLINE OF FIXTURE.
- CAULK ALL SUSPENDED CEILING TO WALL INTERSECTIONS - SEE SPEC SECTION 079200.
- ALL INTERIOR WALLS EXCEPT SHADED PORTIONS EXTEND TO UNDERSIDE OF DECK.
- ATTACH POWERPOLE TO ROOF STRUCTURE WITH UNISTRUT (TYP. AT CHECKLANES AND SPOT MERCHANDISERS) - PAINT UNISTRUT TO MATCH CEILING.
- GC TO ENSURE ALL JOIST AND JOIST GIRDER TAGS ARE PROPERLY SECURED TO JOIST WEBBING AND CONCEALED FROM VIEW PRIOR TO PAINTING.
- NORDEON LIGHTING SYSTEM SHALL BE OWNER FURNISHED AND CONTRACTOR INSTALLED. CONTRACTOR SHALL HAVE FIVE (5) DAYS FROM DATE OF DELIVERY ACCEPTANCE TO VERIFY SHIPMENT FOR ANY DAMAGES. CORRECT QUANTITY OF FIXTURES AND PLACE A CLAIM. AFTER FIVE (5) DAYS THE CONTRACTOR SHALL BE RESPONSIBLE FOR ANY DAMAGES AND ADDITIONAL FIXTURES REQUIRED.
- THE LIGHT FIXTURE LOCATION DIMENSIONS ARE BASED ON THE DESIGNED SALES FLOOR & GONDOLA LAYOUT. THE CONTRACTOR SHALL COORDINATE THE FINAL LIGHT FIXTURE MOUNTING LOCATIONS WITH THE ACTUAL AS BUILT CONDITIONS.

LEGEND:

EXIT SIGN	
2' X 2' RECESSED LIGHT FIXTURE	
2' X 4' RECESSED LIGHT FIXTURE	
4' STRIP LIGHT FIXTURE	
6' STRIP LIGHT FIXTURE	
8' STRIP LIGHT FIXTURE	
VAPORTITE LIGHT FIXTURE	
SINGLE LAMP PENDANT	
DOCK LIGHT	
CANOPY / SOFFIT SQUARE	
EXTERIOR ACCENT CYLINDER	
WALL PACK	
48" LINEAR WALL GRAZE UPLIGHT LIGHT FIXTURE	
EMERGENCY EGRESS LIGHT FIXTURE	
RETURN AIR GRILLE	
SUPPLY DIFFUSER	
LINEAR DIFFUSER	
DESTRATIFICATION FAN	
DUCTLESS SPLIT FAN COIL UNIT	
SHADED FIXTURES ARE NIGHT LIGHTS - SEE LIGHTING PLAN	

Copyright © 2024

APD Engineering & Architecture
03/27/2024

Drawing Alteration

It is a violation of law for any person, unless acting under the direction of licensed Architect, Professional Engineer, Landscape Architect, or Land Surveyor to alter any item on this document in any way. Any licensee who alters this document is required by law to affix his or her seal and to add the notation "Altered By" followed by his or her signature and the specific description of the alteration or revision.

DO NOT SCALE PLANS

Copying, Printing, Software and other processes required to produce these prints can stretch or shrink the actual paper or layout. Therefore, scaling of this drawing may be inaccurate. Contact APD E&A with any need for additional dimensions or clarifications.

Issued: Date:

A	Issued for Permit	07/08/24
B	Issued for Bid	07/29/25
C		
D		
E		

Revisions: Date:

1	Owner Changes	11/18/24
2	Owner Changes	07/29/25
3		
4		
5		
6		
7		
8		
9		
10		
11		
12		

PROJECT ARCHITECT/ENGINEER


Daniel Sargent

PROJECT LEAD

John Lynch

NOT FOR CONSTRUCTION

Seal Seal

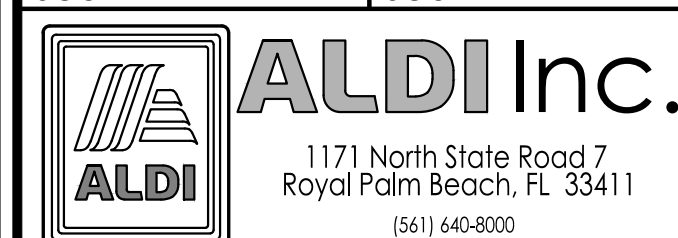

ALDI Inc. Store #: 50
Coconut Crossing, FL
12850 Northlake Boulevard
Palm Beach Gardens, FL 33412
Palm Beach County
Project Name & Location:

Reflected Ceiling Plan
Drawing Name:

Prototype:	Project No.
V7.08 LHRD	22-0267A
Type:	
GROUND UP	
Drawn By:	
JWL	
Scale:	
As Noted	
Drawing No.	
A-111	




Revisions:		Date:
1	Owner Changes	11/18/24
2	Owner Changes	07/29/25
3		
4		
5		
6		
7		
8		
9		
10		
11		
12		

NOT FOR
CONSTRUCTION

ALDI Inc. Store #: 50
Coconut Crossing, FL 
12850 Northlake Boulevard
Palm Beach Gardens, FL 33412
Palm Beach County
Project Name & Location:

Drawing Name:		Project No. 22-0267A A-121 Drawing No.
Prototype:	V7.08 LHRD	
Type:	GROUND UP	
Drawn By:	JWL	
Scale:	As Noted	

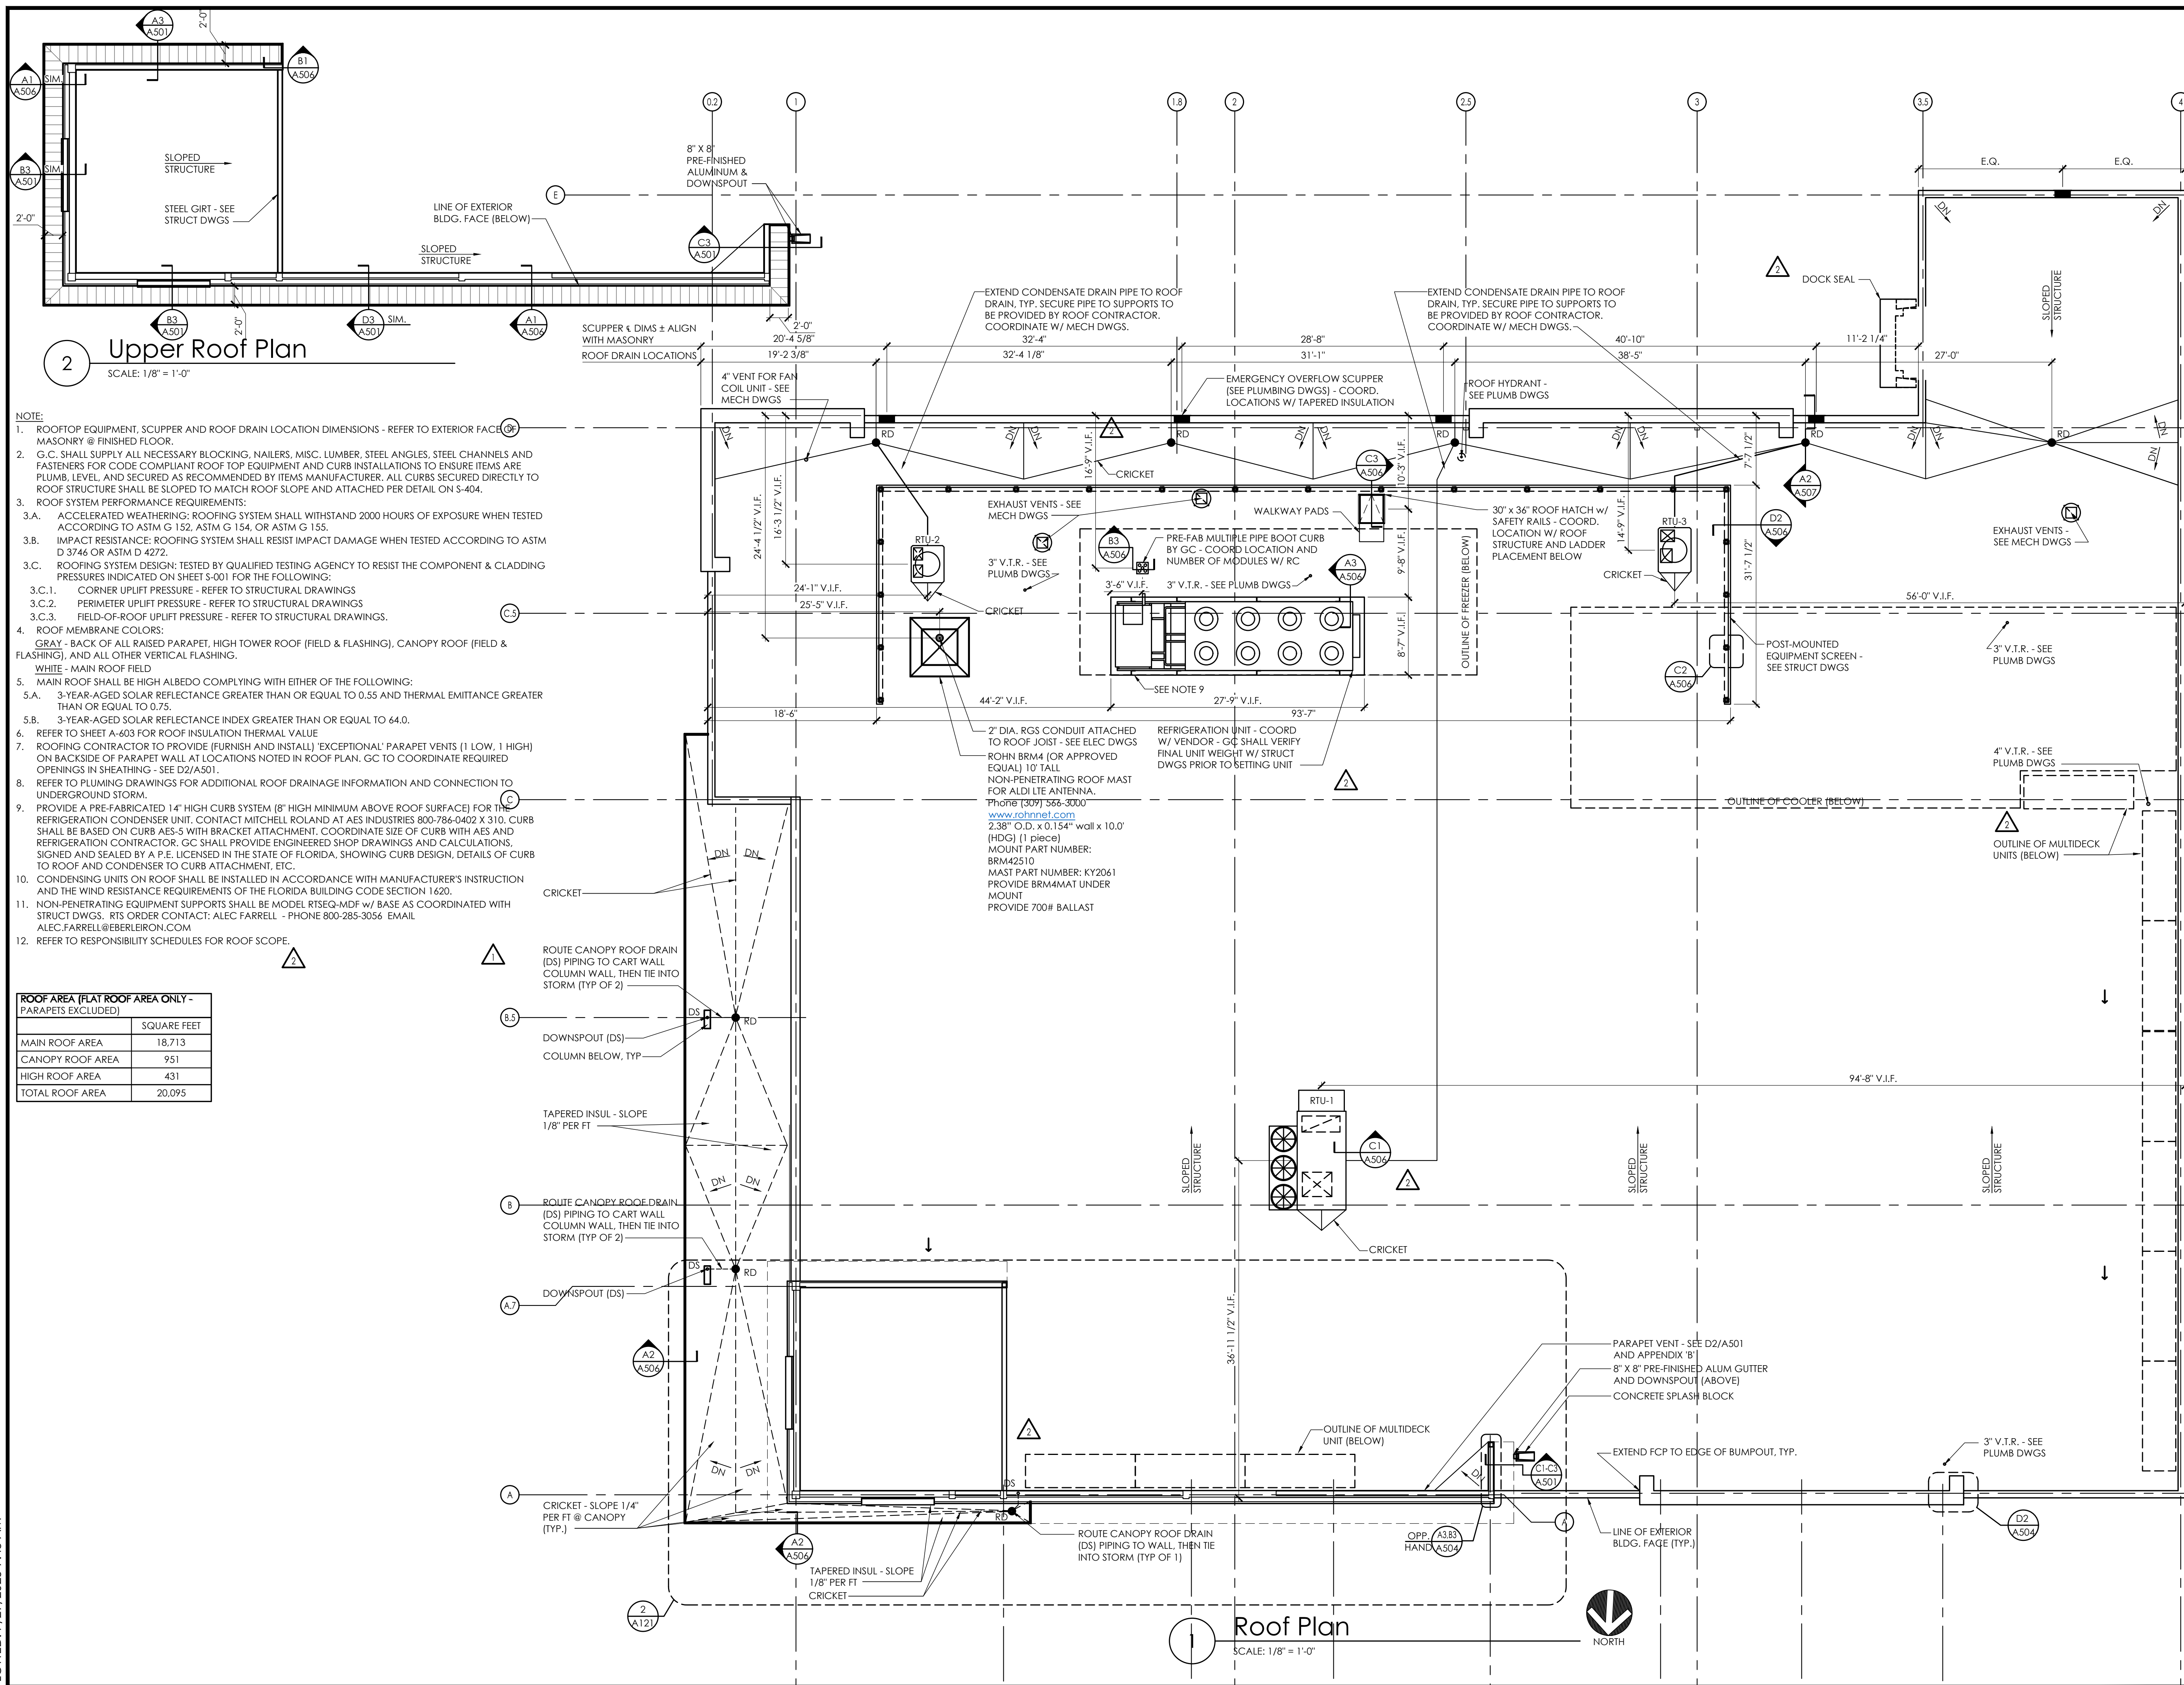


PLOTTED: 7/29/2025 9:43 AM

PLOTTED: 7/29/2025 9:43 AM

COCONUT CROSSING, FL AREA SUMMARY		
OCCUPANCY USE	ROOM NAME	SQUARE FOOTAGE
MERCANTILE (M)	SALES / VESTIBULE	12,423
	UNISEX 2	96
	UNISEX 1	96
	HALL	120
SUBTOTAL (MERCANTILE)		12,935
BUSINESS (B)	OFFICE	258
	BREAK ROOM	309
	eCOMMERCE	401
	CLOSET	36
SUBTOTAL (BUSINESS)		1004
STORAGE / STOCK (S-2)	BACKROOM	2,568
	COOLER	1,338
	FREEZER	647
SUBTOTAL (STORAGE / STOCK)		4,553
SUBTOTAL (OCCUPANCIES)		18,492
EXTERIOR / INTERIOR WALLS / UNOCCUPIED SPACE		908
BUILDING SQUARE FOOTAGE		19,400
EXTERIOR CANOPY		987
TOTAL SQUARE FOOTAGE (INCLUDING CANOPY)		20,387

REAR DOCK OPERATIONS DATA	
ITEM	COCONUT CROSSING, FL
LINEAR FOOTAGE OF BASE (PRODUCE INCLUDED)	803'-2"
ASSUMED PALLET STORAGE	57
BUILDING DIMENSIONS	119'-4" x 162'-8"
SALES FLOOR DIMENSIONS	74'-10" x 151'-1"
LENGTH OF MULTIDECK	120'
COOLER MILK DOORS	4
COOLER GENERAL DOORS	12
FREEZER GENERAL DOORS	16
SPOT MERCHANDISERS	10
CART STORAGE	128

- NOTES:
- THIS DRAWING IS FOR GENERAL FIXTURING LAYOUT AND REFERENCE TO EQUIPMENT ONLY. ALL INFORMATION IS FOR ALDI OPERATIONAL USE ONLY AND SHALL NOT BE USED FOR CONSTRUCTION OR BIDDING PURPOSES.
 - ALL DIMENSIONS TO WALLS ARE TO FACE OF STUD UNLESS NOTED OTHERWISE.
 - THIS FACILITY DOES NOT CONTAIN A BAKERY, A BUTCHER, A DELI OR FISH COUNTER.
 - ALL FOOD IS PREPACKAGED. THERE IS NO ON SITE FOOD PREPARATION.
 - GONDOLA LOCATIONS ARE MEASURED FROM THE FACE OF THE STAINLESS STEEL PRICE TAG MOLDING (SSPTM).

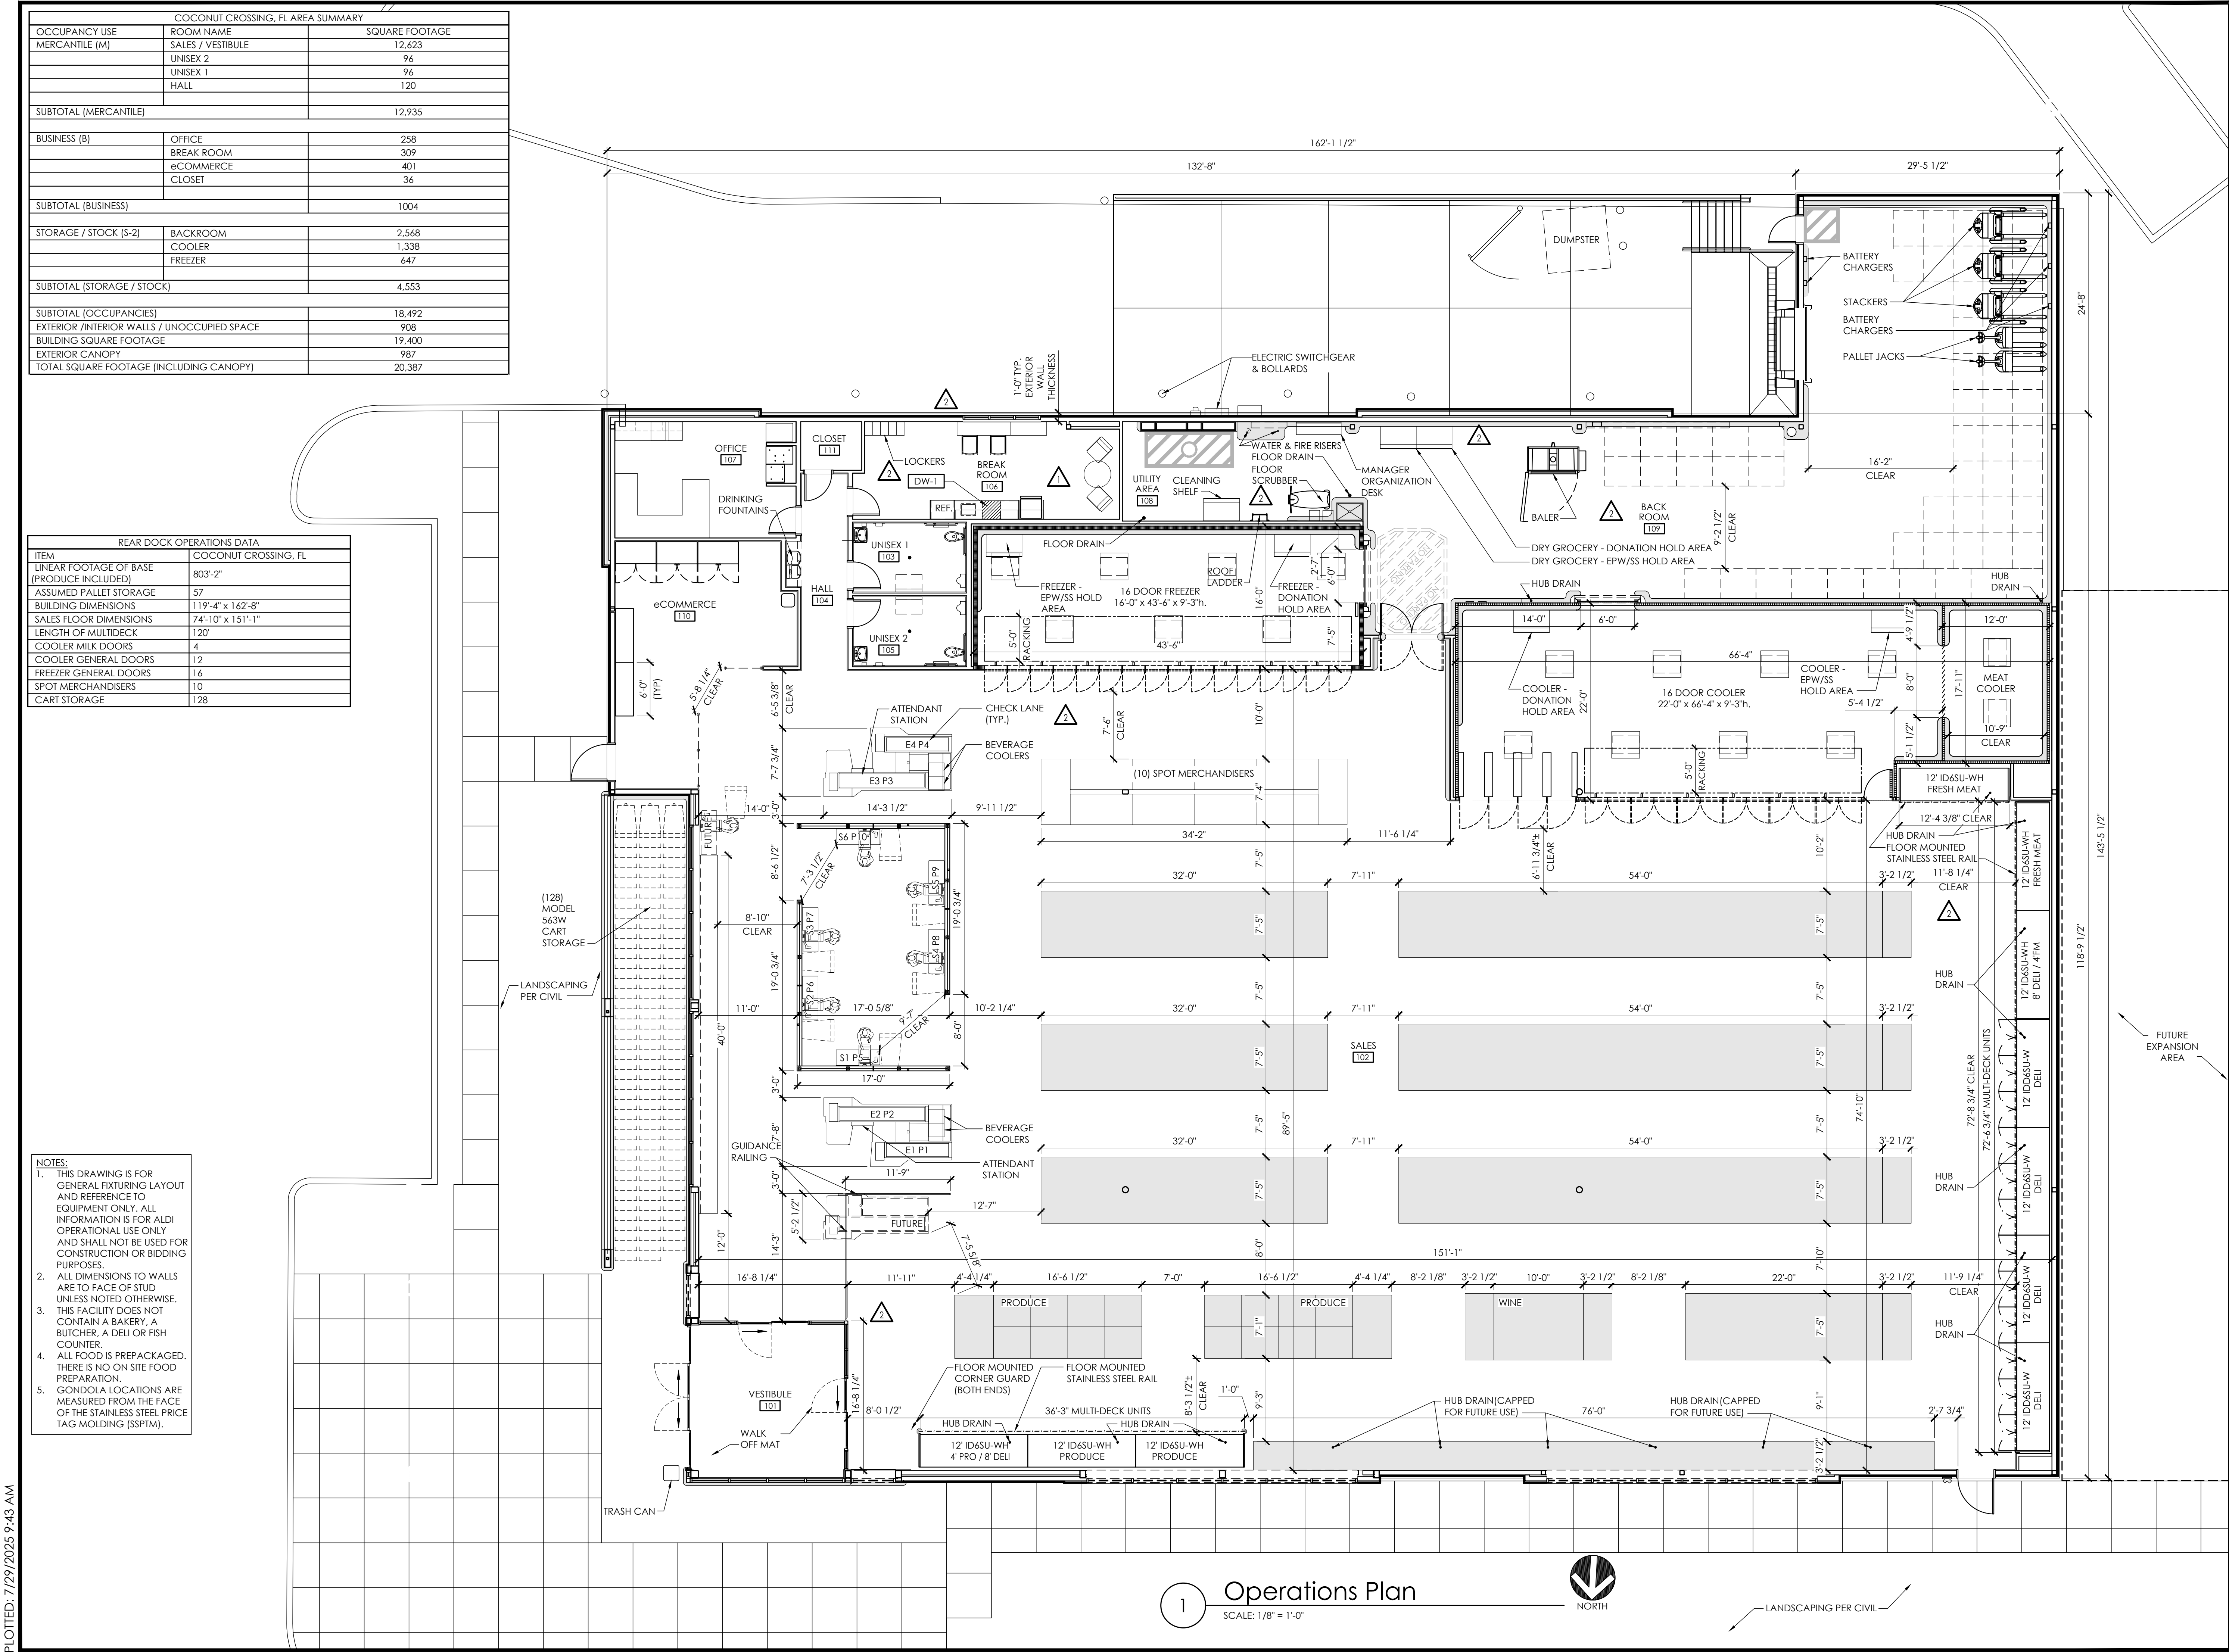

Copyright © 2024

AFD Engineering & Architecture
03/27/2018

Drawing Alteration

It is a violation of law for any person, unless acting under the direction of licensed Architect, Professional Engineer, Landscape Architect, or Land Surveyor to alter any item on this document in any way. Any licensee who alters this document is required by law to affix his or her seal and to add the notation "Altered By" followed by his or her signature and the specific description of the alteration or revision.

DO NOT SCALE PLANS

Copying, Printing, Software and other processes required to produce these prints can stretch or shrink the actual paper or layout. Therefore, scaling of this drawing may be inaccurate. Contact AFD E&A with any need for additional dimensions or clarifications.

Issued:	Date:
A Issued for Permit	07/08/24
B Issued for Bid	07/29/25
C	
D	
E	

Revisions:	Date:
1 Owner Changes	11/18/24
2 Owner Changes	07/29/25
3	
4	
5	
6	
7	
8	
9	
10	
11	
12	

PROJECT ARCHITECT/ENGINEER

Daniel Sargent

PROJECT LEAD

John Lynch

**NOT FOR
CONSTRUCTION**

Seal Seal

ALDI Inc.
1171 North State Road 7
Royal Palm Beach, FL 33411
(561) 640-8000


ALDI Inc. Store #: 50
Coconut Crossing, FL
12850 Northlake Boulevard
Palm Beach Gardens, FL 33412
Palm Beach County
Project Name & Location:

Operations Plan


Drawing Name:	Project No.
Prototype: V7.08 LHRD	22-0267A
Type: GROUND UP	
Drawn By: JWL	A-131
Scale: As Noted	Drawing No.

EXTERIOR FINISH SCHEDULE			
KEY	MATERIAL / MFG.	COLOR / NO.	NOTES
A1	PREFINISHED METAL ROOF EDGE TERMINATION	A1 - SILVER - AT HIGH ROOF & CANOPY A1b - AGED BRONZE - AT NICHIIHA A1c - GRANITE - AT EIFS	SEE SPECIFICATIONS APPENDIX 'B'
A2	MASONRY STONE VENEER (MSV) / BORAL CULTURED STONE	PROFIT LEDGESTONE - SOUTHWEST BLEND	
A3	PREFINISHED ALUM. SILL FLASHING	A3 - BRIGHT SILVER A3a - PETERSEN ALUMINUM - 'AGED BRONZE'	SEE SPEC FOR ADDITIONAL INFO; NOTE AGED BRONZE IS CUSTOM COLOR PAINT ON POST FORMED ALUMINUM.
A4	ALUMINUM STOREFRONT SYSTEM	ANODIZED ALUM.	RE: DWG. A602
A5	MEMBRANE ROOFING	GRAY	TOP OF SLOPED ROOF, CANOPY ROOF, AND BACK OF RAISED ROOF PROJECTIONS - SEE SPECIFICATIONS APPENDIX 'B'
A6	METAL SOFFIT PANELS	SOLID PANELS - SILVER METALLIC	RE: DWG. A301-A304
A7	EXTERIOR PAINT		RE: DWG. A603
A8	POST MOUNTED GREEN SCREEN	FACTORY FINISH	GREEN SCREEN WELDED WIRE TRELLIS SYSTEM - SEE SPEC.
A9	ALUMINUM COMPOSITE PANEL	BRIGHT SILVER	PROVIDE PANEL JOINTS AS SHOWN - PROVIDE ONE PIECE TIGHT FIT EXTRUDED MOLDING INSTALLATION SYSTEM WITH CENTER REVEAL TRIM BETWEEN PANELS AND J TRIM AT PANEL EDGES.
A10	NICHIIHA FIBER CEMENT EXTERIOR CLADDING	VINTAGEWOOD 'BARK'	CONTACT NICHIIHA AT 770-805-9466 FOR ORDERING. SEE SPEC FOR TRIM REQUIREMENTS AND ADDITIONAL INFO. ALL INCLUDED TRIM ('H', 'J', 'L', CORNER, ETC) TO MATCH FCP
A11	BLRD-2	PT-19 / CL-4	RE: DWG. A603
A12	BLRD-4		RE: DWG. A603
A13	GUARD RAIL TYPE "A"	GALVANIZED STEEL	RE: DETAIL B2/A507
A14	GUARD RAIL TYPE "B"	GALVANIZED STEEL	RE: DETAIL B2/A507
A15	BLRD-3	GALVANIZED	RE: DWG. A603
A16	DOCK LEVELER / SEAL AND BUMPERS	LEVELER - FACTORY FINISH / SEAL AND BUMPERS - FACTORY FINISH - BLACK	RE: DETAIL 9/A601 FOR CONDITION BEHIND SEAL
A17	MASONRY CONTROL JOINT		MAX 20' OC
A18	16" OVERFLOW SCUPPER	PT-19 / CL-9	RE: DWG. A2/A507
A19	WATER TABLE-SILL / CULTURED STONE	16"X20"X2"-2 3/4" (AT PEAK) FLAGSTONE / CHAMPAGNE	SEE SPEC FOR ADDITIONAL INFORMATION; RE: DWG B3b/A503
A20	ALDI TOWER SIGN	BY SIGN VENDOR	VERIFY SIGN SIZE PRIOR TO FRAMING OPENING SEE DETAIL B2/A505
A21	CRTB	NATURAL	RE: DWG A603 - SEE STRUCTURAL DWGS
A22	KNOX BOX	FACTORY FINISH	CONFIRM TYPE AND LOCATION WITH LOCAL FIRE MARSHAL
A23	AUTO DOOR SYSTEM & TRANSOM	ANODIZED ALUMINUM	RE: DWG. A601 & A602

EXTERIOR FINISH SCHEDULE			
KEY	MATERIAL / MFG.	COLOR / NO.	NOTES
A24	SLOPED WALL CAP / CULTURED STONE	16"X20"X2"-2 3/4" (AT PEAK) FLAGSTONE / CHAMPAGNE	SEE SPEC FOR ADDITIONAL INFORMATION
A25	8" X 8" PRE-FINISHED ALUM. GUTTER	MATCH PREFINISHED METAL COPING	RE: DETAIL C3/A501
A26	8" X 8" PRE-FINISHED ALUM. DOWNSPOUT	MATCH PREFINISHED METAL COPING	RE: DETAIL C3/A501 TERMINATE AT CONC. SPLASH BLOCK
A27	ACP H/J TRIM / JOINT COVER		TYPICAL AT EDGES AND BUTT JOINTS OF ACP
A28	FIBER CEMENT PANEL BASE FLASHING	PETERSEN ALUMINUM - 'AGED BRONZE'	
A29	DRYVIT SYSTEMS, INC EXTERIOR INSULATION FINISH SYSTEM	A29a - MATCH DRYVIT COLOR #104 - 'DOVER SKY' A29b - MATCH DRYVIT COLOR #449 - 'BUCKSKIN'	SEE SPEC FOR ADDITIONAL INFO
A30	DUMPSTER GATE	CLAM SHELL	RE: DWG. A507
A31	NICHIIHA CONTROL JOINT WITH "H" CLIP		
A32	3/4" ESTHETIC EIFS "V" GROVE		
A33	EIFS EXPANSION JOINT		MAX 75' OC
A34	MECHANICAL SCREEN	PT-19 / PAINT COLOR TO MATCH DRYVIT COLOR #104 DOVER SKY	SEE STRUCT DWGS
A35	SMOOTH FACE CMU		PROVIDE SMOOTH FACE CMU FROM FINISHED FLOOR TO FOOTING INSIDE FULL INSIDE PERIMETER OF TRUCK WELL
A36	ALUMINUM BRAKE METAL CLOSURE	ANODIZED ALUM.	RE: DWG. A505
E1	NOT USED		
E2	WALL SCENCE	FACTORY FINISH	MOUNT @ 14'-8" A.F.S.; RE: DWG. A111 FOR DIMENSIONS
E3	JUNCTION BOX WITH COVER FOR FUTURE CARD READER		MOUNT CENTERED @ 46" A.F.S.; SEE ELEC DWGS
E4	UTILITY METERING & C.T.	FACTORY FINISH	SEE ELECTRICAL DWGS
E5	EXTERIOR WALL PACK	FACTORY FINISH	MAN DOORS - MOUNT @ 8'-0" A.F.S.; BREAK ROOM WINDOW @ 10'-0" A.F.S. TRUCK WELL - MOUNT @ 12'-0" A.F.S. (SIDE DOCK ONLY)
E6	EXTERIOR DUPLEX RECEPTACLE	FACTORY FINISH	MOUNT @ 1'-6" A.F.S. IN 4" SQUARE J-BOX
E7	GENERATOR QUICK CONNNECT	FACTORY FINISH	SEE ELEC DWGS
F1	MOTOR GONG	FACTORY FINISH	SEE FIRE PROTECTION DWGS
P1	HOSE BIB	FACTORY FINISH	SEE PLUMBING DWGS
XX	GLAZING KEY		RE: DWG. A602
XX	ALIGN KEY		A: ALIGN NICHIIHA PANEL JOINTS AND WINDOW MULLIONS B: ALIGN ALUMINUM COMPOSITE PANEL JOINTS AND NICHIIHA PANEL JOINTS C: ALIGN NICHIIHA PANEL JOINTS, ALUMINUM COMPOSITE PANEL JOINTS, AND WINDOW MULLIONS

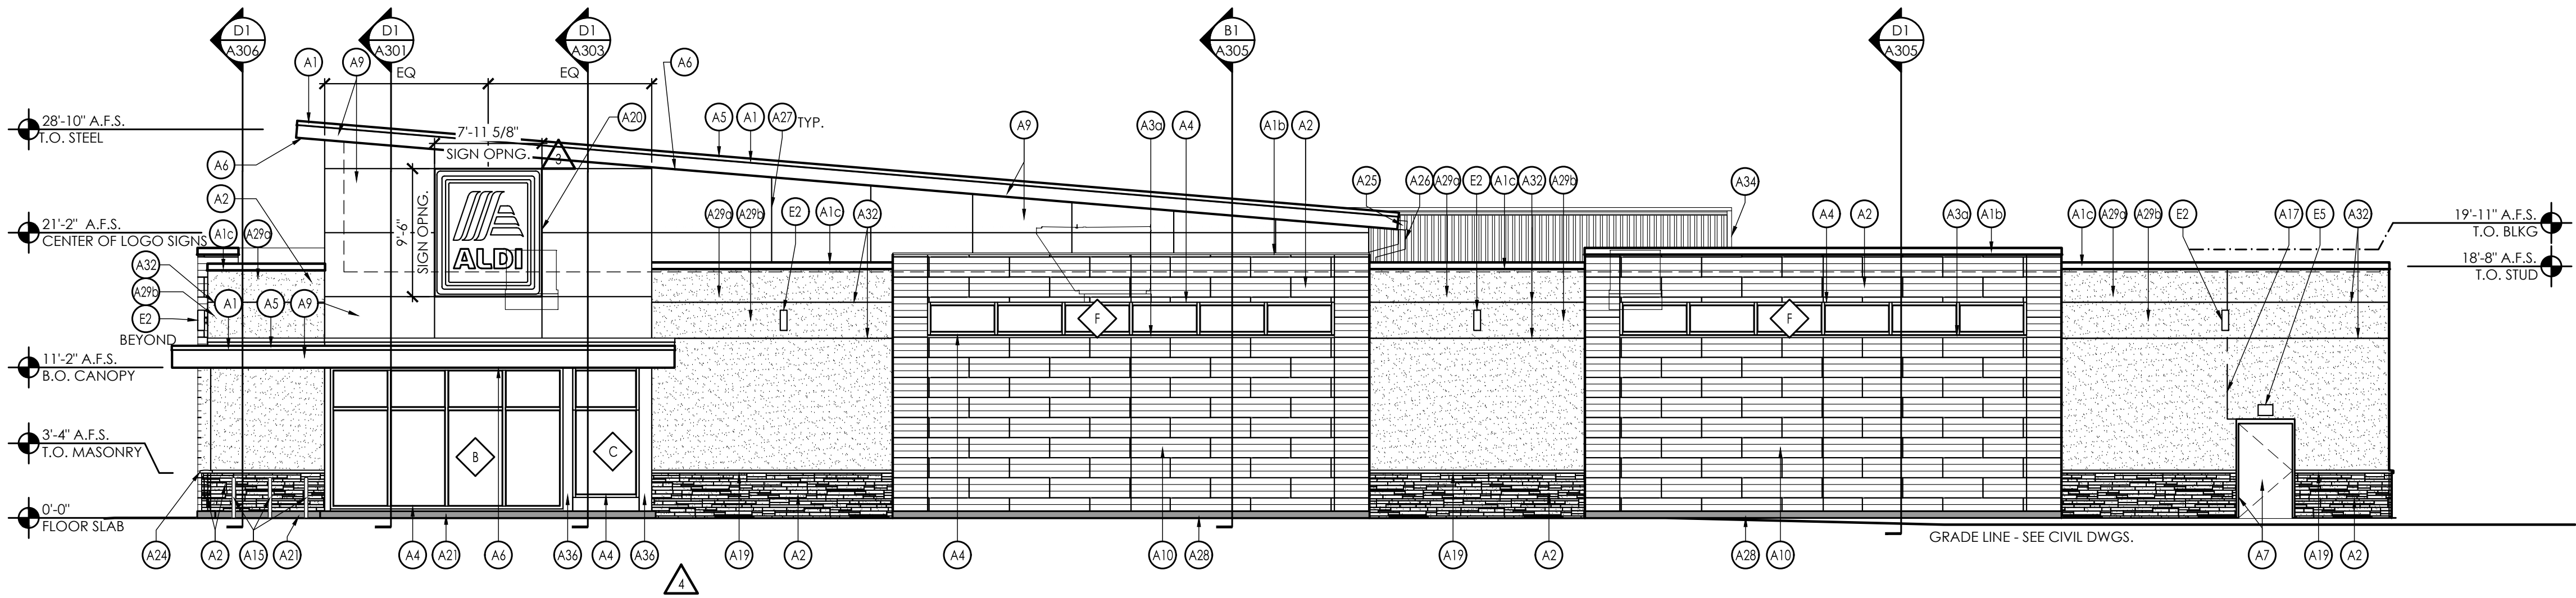

2 North Elevation
SCALE: 1/8" = 1'-0"

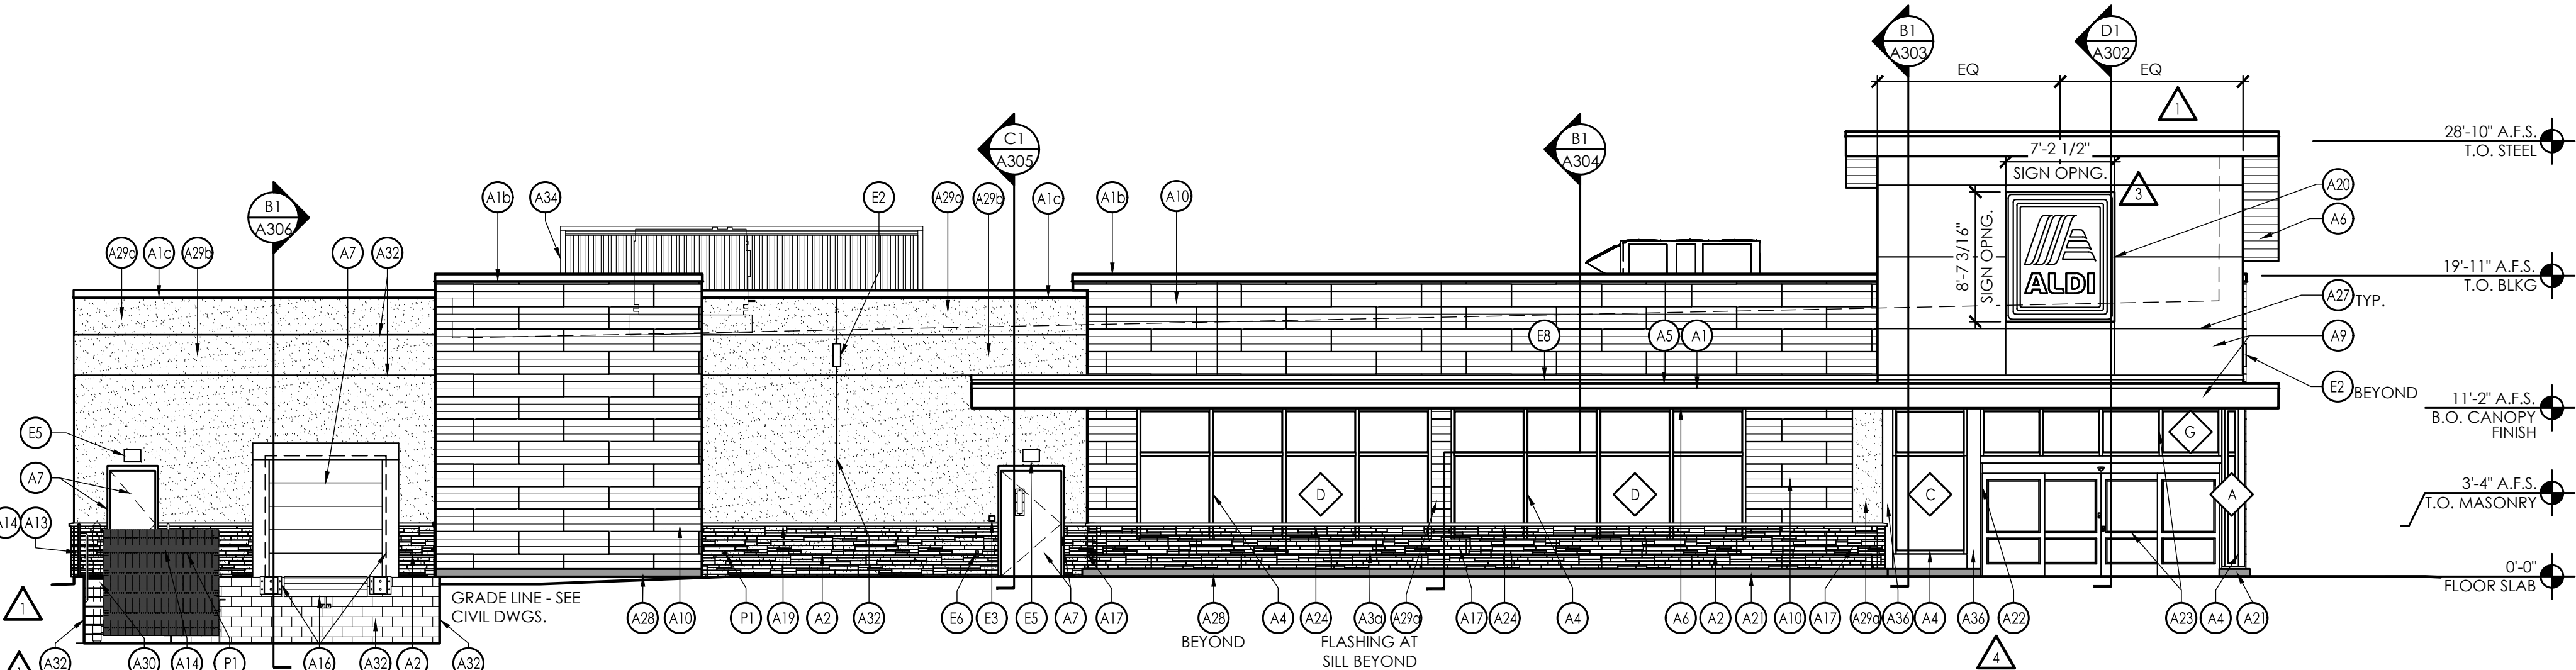

1 East Elevation
SCALE: 1/8" = 1'-0"

SIGNAGE			
DESCRIPTION	QUANTITY	SQ. FT. PER SIGN	TOTALS
NORTH TOWER SIGN	1	74.9	74.9
EAST TOWER SIGN	1	61.98	62.0
TOTAL SIGNAGE			136.9
SIGNAGE IS SHOWN FOR REFERENCE ONLY AND SHALL BE UNDER SEPARATE PERMIT SUBMITTAL			

Issued:	Date:
A Issued for Permit	07/08/24
B Issued for Bid	07/29/25
C	
D	
E	

Revisions:	Date:
1 AHJ Responses	10/08/24
2 Owner Changes	11/18/24
3 AHJ Responses	12/20/24
4 Owner Changes	07/29/25
5	
6	
7	
8	
9	
10	
11	
12	

PROJECT ARCHITECT/ENGINEER

Daniel Sargent

PROJECT LEAD

John Lynch

**NOT FOR
CONSTRUCTION**

Seal Seal



ALDI Inc.
1171 North State Road 7
Royal Palm Beach, FL 33411
(561) 640-8000

ALDI Inc. Store #: 50
Coconut Crossing, FL
12850 Northlake Boulevard
Palm Beach Gardens, FL 33412
Palm Beach County
Project Name & Location:

Exterior

Elevations

Drawing Name:

Prototype:

V7.08 LHRD

Type:

GROUND UP

Drawn By:

JWL

Scale:

As Noted

Project No.


22-0267A

A-201


Drawing No.

EXTERIOR FINISH SCHEDULE			
KEY	MATERIAL / MFG.	COLOR / NO.	NOTES
A1	PREFINISHED METAL ROOF EDGE TERMINATION	A1 - SILVER - AT HIGH ROOF & CANOPY A1b - AGED BRONZE - AT NICHIIHA A1c - GRANITE - AT EIFS	SEE SPECIFICATIONS APPENDIX 'B'
A2	MASONRY STONE VENEER (MSV) / BORAL CULTURED STONE	PROFIT LEDGESTONE - SOUTHWEST BLEND	
A3	PREFINISHED ALUM. SILL FLASHING	A3 - BRIGHT SILVER A3a - PETERSEN ALUMINUM - 'AGED BRONZE'	SEE SPEC FOR ADDITIONAL INFO; NOTE AGED BRONZE IS CUSTOM COLOR PAINT ON POST FORMED ALUMINUM.
A4	ALUMINUM STOREFRONT SYSTEM	ANODIZED ALUM.	RE: DWG. A602
A5	MEMBRANE ROOFING	GRAY	TOP OF SLOPED ROOF, CANOPY ROOF, AND BACK OF RAISED ROOF PROJECTIONS - SEE SPECIFICATIONS APPENDIX 'B'
A6	METAL SOFFIT PANELS	SOLID PANELS - SILVER METALLIC	RE: DWG. A301-A304
A7	EXTERIOR PAINT		RE: DWG. A603
A8	POST MOUNTED GREEN SCREEN	FACTORY FINISH	GREEN SCREEN WELDED WIRE TRELLIS SYSTEM - SEE SPEC.
A9	ALUMINUM COMPOSITE PANEL	BRIGHT SILVER	PROVIDE PANEL JOINTS AS SHOWN - PROVIDE ONE PIECE TIGHT FIT EXTRUDED MOLDING INSTALLATION SYSTEM WITH CENTER REVEAL TRIM BETWEEN PANELS AND J TRIM AT PANEL EDGES.
A10	NICHIIHA FIBER CEMENT EXTERIOR CLADDING	VINTAGEWOOD 'BARK'	CONTACT NICHIIHA AT 770-805-9466 FOR ORDERING. SEE SPEC FOR TRIM REQUIREMENTS AND ADDITIONAL INFO. ALL INCLUDED TRIM ('H', 'J', 'L', CORNER, ETC) TO MATCH FCP
A11	BLRD-2	PT-19 / CL-4	RE: DWG. A603
A12	BLRD-4		RE: DWG. A603
A13	GUARD RAIL TYPE "A"	GALVANIZED STEEL	RE: DETAIL B2/A507
A14	GUARD RAIL TYPE "B"	GALVANIZED STEEL	RE: DETAIL B2/A507
A15	BLRD-3	GALVANIZED	RE: DWG. A603
A16	DOCK LEVELER / SEAL AND BUMPERS	LEVELER - FACTORY FINISH / SEAL AND BUMPERS - FACTORY FINISH - BLACK	RE: DETAIL 9/A601 FOR CONDITION BEHIND SEAL
A17	MASONRY CONTROL JOINT		MAX 20' OC
A18	16" OVERFLOW SCUPPER	PT-19 / CL-9	RE: DWG. A2/A507
A19	WATER TABLE-SILL / CULTURED STONE	16"X20"X2"-2 3/4" (AT PEAK) FLAGSTONE / CHAMPAGNE	SEE SPEC FOR ADDITIONAL INFORMATION; RE: DWG B3b/A503
A20	ALDI TOWER SIGN	BY SIGN VENDOR	VERIFY SIGN SIZE PRIOR TO FRAMING OPENING SEE DETAIL B2/A505
A21	CRTB	NATURAL	RE: DWG. A603 - SEE STRUCTURAL DWGS
A22	KNOX BOX	FACTORY FINISH	CONFIRM TYPE AND LOCATION WITH LOCAL FIRE MARSHAL
A23	AUTO DOOR SYSTEM & TRANSOM	ANODIZED ALUMINUM	RE: DWG. A601 & A602

EXTERIOR FINISH SCHEDULE			
KEY	MATERIAL / MFG.	COLOR / NO.	NOTES
A24	SLOPED WALL CAP / CULTURED STONE	16"X20"X2"-2 3/4" (AT PEAK) FLAGSTONE / CHAMPAGNE	SEE SPEC FOR ADDITIONAL INFORMATION
A25	8" X 8" PRE-FINISHED ALUM. GUTTER	MATCH PREFINISHED METAL COPING	RE: DETAIL C3/A501
A26	8" X 8" PRE-FINISHED ALUM. DOWNSPOUT	MATCH PREFINISHED METAL COPING	RE: DETAIL C3/A501 TERMINATE AT CONC. SPLASH BLOCK
A27	ACP H/J TRIM / JOINT COVER		TYPICAL AT EDGES AND BUTT JOINTS OF ACP
A28	FIBER CEMENT PANEL BASE FLASHING	PETERSEN ALUMINUM - 'AGED BRONZE'	
A29	DRYVIT SYSTEMS, INC EXTERIOR INSULATION FINISH SYSTEM	A29a - MATCH DRYVIT COLOR #104 - 'DOVER SKY' A29b - MATCH DRYVIT COLOR #449 - 'BUCKSKIN'	SEE SPEC FOR ADDITIONAL INFO
A30	DUMPSTER GATE	CLAM SHELL	RE: DWG. A507
A31	NICHIIHA CONTROL JOINT WITH "H" CLIP		
A32	3/4" ESTHETIC EIFS "V" GROVE		
A33	EIFS EXPANSION JOINT		MAX 75' OC
A34	MECHANICAL SCREEN	PT-19 / PAINT COLOR TO MATCH DRYVIT COLOR #104 DOVER SKY	SEE STRUCT DWGS
A35	SMOOTH FACE CMU		PROVIDE SMOOTH FACE CMU FROM FINISHED FLOOR TO FOOTING INSIDE FULL INSIDE PERIMETER OF TRUCK WELL
A36	ALUMINUM BRAKE METAL CLOSURE	ANODIZED ALUM.	RE: DWG. A505
E1	NOT USED		
E2	WALL SCONCE	FACTORY FINISH	MOUNT @ 14'-8" A.F.S.; RE: DWG. A111 FOR DIMENSIONS
E3	JUNCTION BOX WITH COVER FOR FUTURE CARD READER		MOUNT CENTERED @ 46" A.F.S., SEE ELEC DWGS
E4	UTILITY METERING & C.T.	FACTORY FINISH	SEE ELECTRICAL DWGS
E5	EXTERIOR WALL PACK	FACTORY FINISH	MAN DOORS - MOUNT @ 8'-0" A.F.S., BREAK ROOM WINDOW @ 10'-0" A.F.S. TRUCK WELL - MOUNT @ 12'-0" A.F.S. (SIDE DOCK ONLY)
E6	EXTERIOR DUPLEX RECEPTACLE	FACTORY FINISH	MOUNT @ 1'-6" A.F.S. IN 4" SQUARE J-BOX
E7	GENERATOR QUICK CONNNECT	FACTORY FINISH	SEE ELEC DWGS
F1	MOTOR GONG	FACTORY FINISH	SEE FIRE PROTECTION DWGS
P1	HOSE BIB	FACTORY FINISH	SEE PLUMBING DWGS
XX	GLAZING KEY		RE: DWG. A602
XX	ALIGN KEY		A: ALIGN NICHIIHA PANEL JOINTS AND WINDOW MULLIONS B: ALIGN ALUMINUM COMPOSITE PANEL JOINTS AND NICHIIHA PANEL JOINTS C: ALIGN NICHIIHA PANEL JOINTS, ALUMINUM COMPOSITE PANEL JOINTS, AND WINDOW MULLIONS

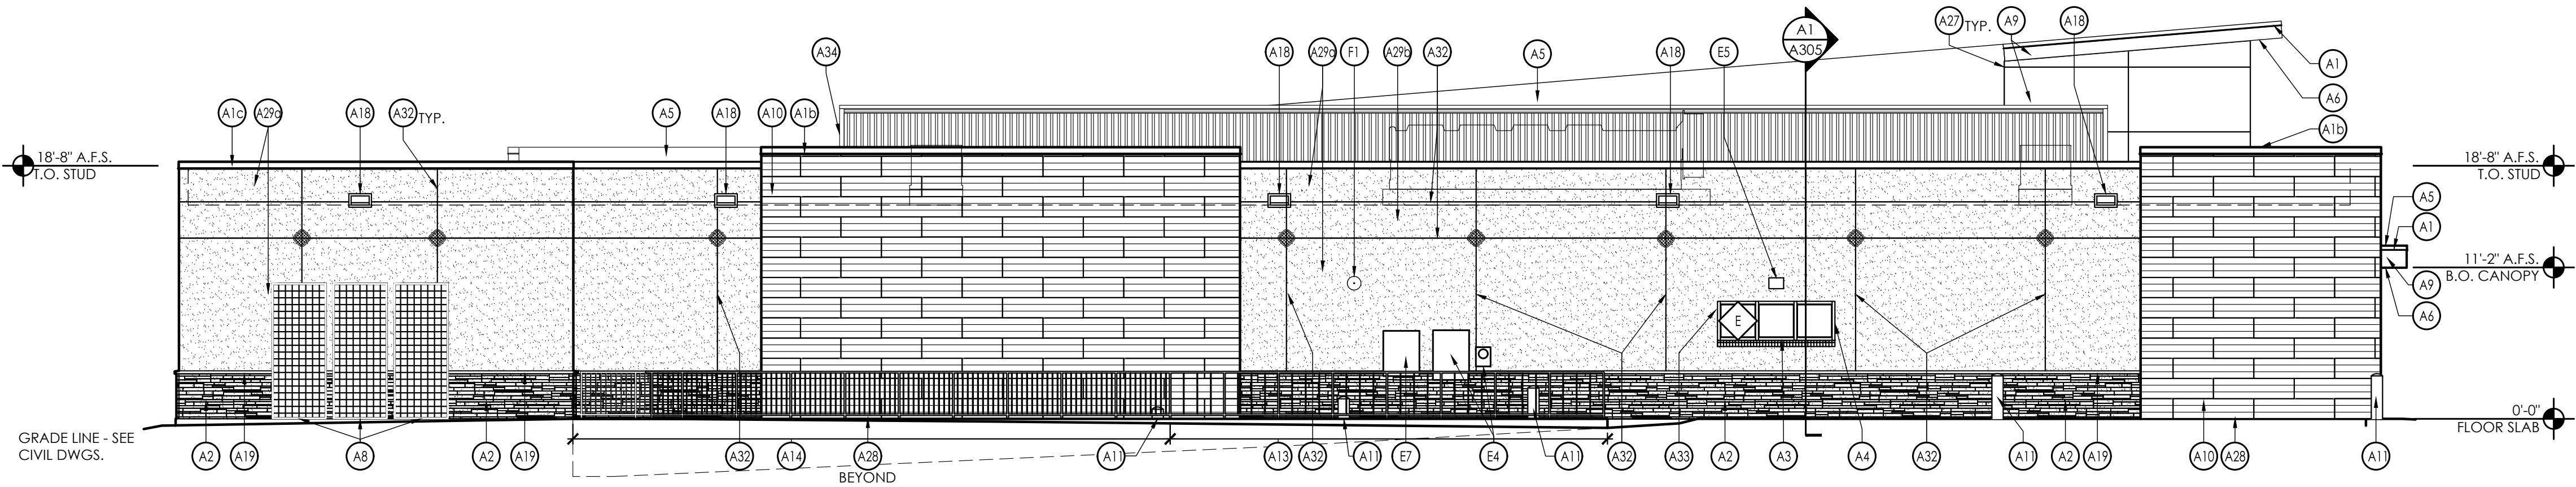

2 South Elevation
SCALE: 1/8" = 1'-0"

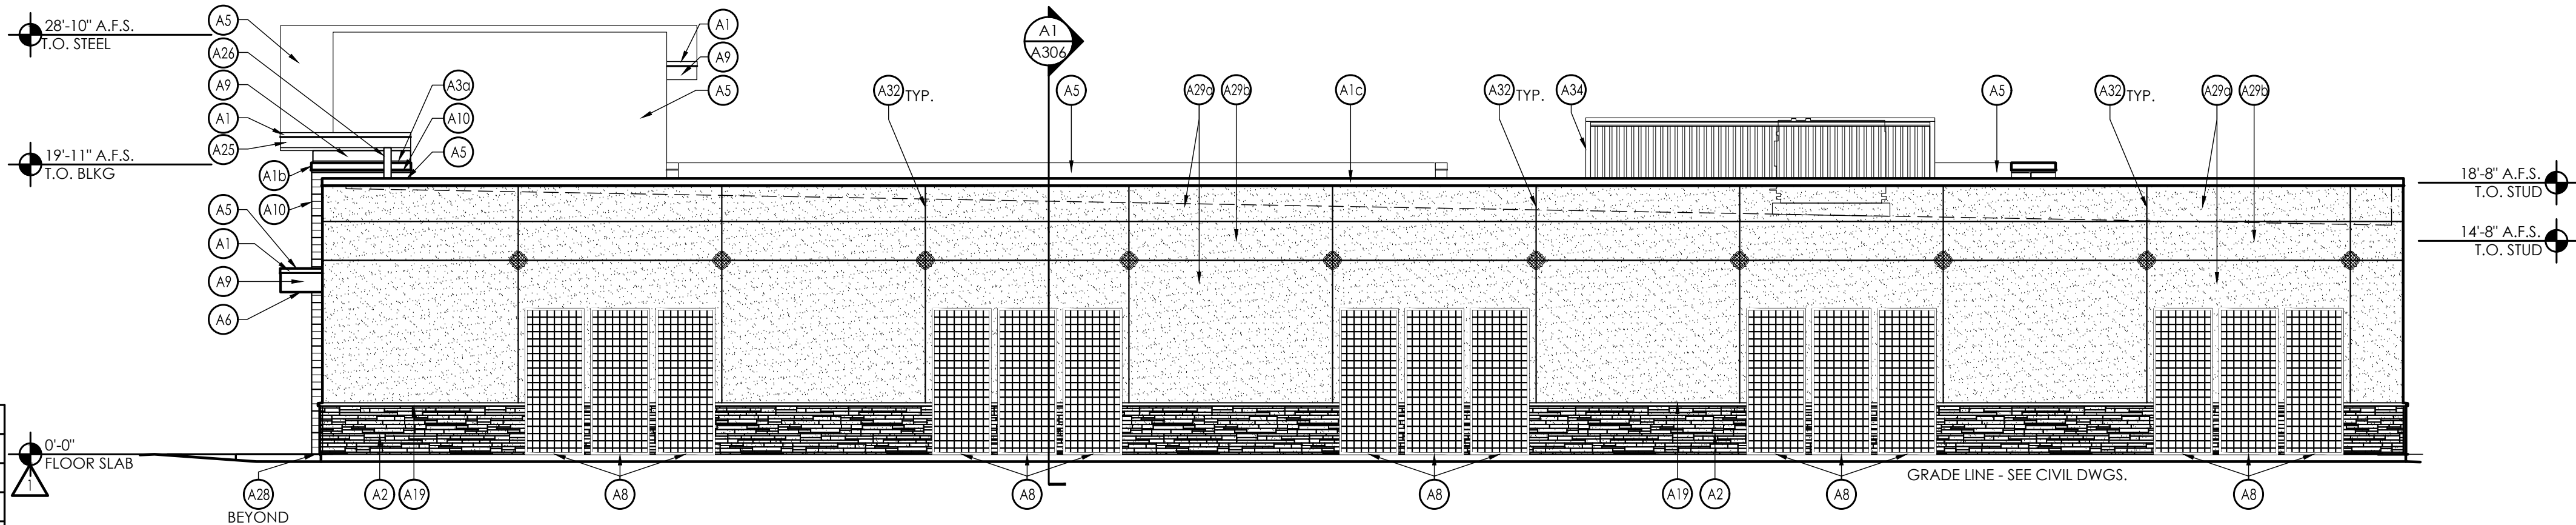

1 West Elevation
SCALE: 1/8" = 1'-0"

SIGNAGE			
DESCRIPTION	QUANTITY	SQ. FT. PER SIGN	TOTALS
NORTH TOWER SIGN	1	74.9	74.9
EAST TOWER SIGN	1	61.98	62.0
TOTAL SIGNAGE			136.9
SIGNAGE IS SHOWN FOR REFERENCE ONLY AND SHALL BE UNDER SEPARATE PERMIT SUBMITTAL			

Issued:	Date:
A Issued for Permit	07/08/24
B Issued for Bid	07/29/25
C	
D	
E	

Revisions:	Date:
1 AHJ Responses	10/08/24
2 Owner Changes	11/18/24
3 AHJ Responses	12/20/24
4 Owner Changes	07/29/25
5	
6	
7	
8	
9	
10	
11	
12	

PROJECT ARCHITECT/ENGINEER

Daniel Sargent

PROJECT LEAD

John Lynch

NOT FOR
CONSTRUCTION

Seal Seal



ALDI Inc. Store #: 50
Coconut Crossing, FL
12850 Northlake Boulevard
Palm Beach Gardens, FL 33412
Palm Beach County
Project Name & Location:

Exterior

Elevations

Drawing Name:

Prototype:

V7.08 LHRD

Type:

GROUND UP

Drawn By:

JWL

Scale:

As Noted


Project No.

22-0267A


A-202

Drawing No.

PLOTTED: 7/29/2025 9:44 AM

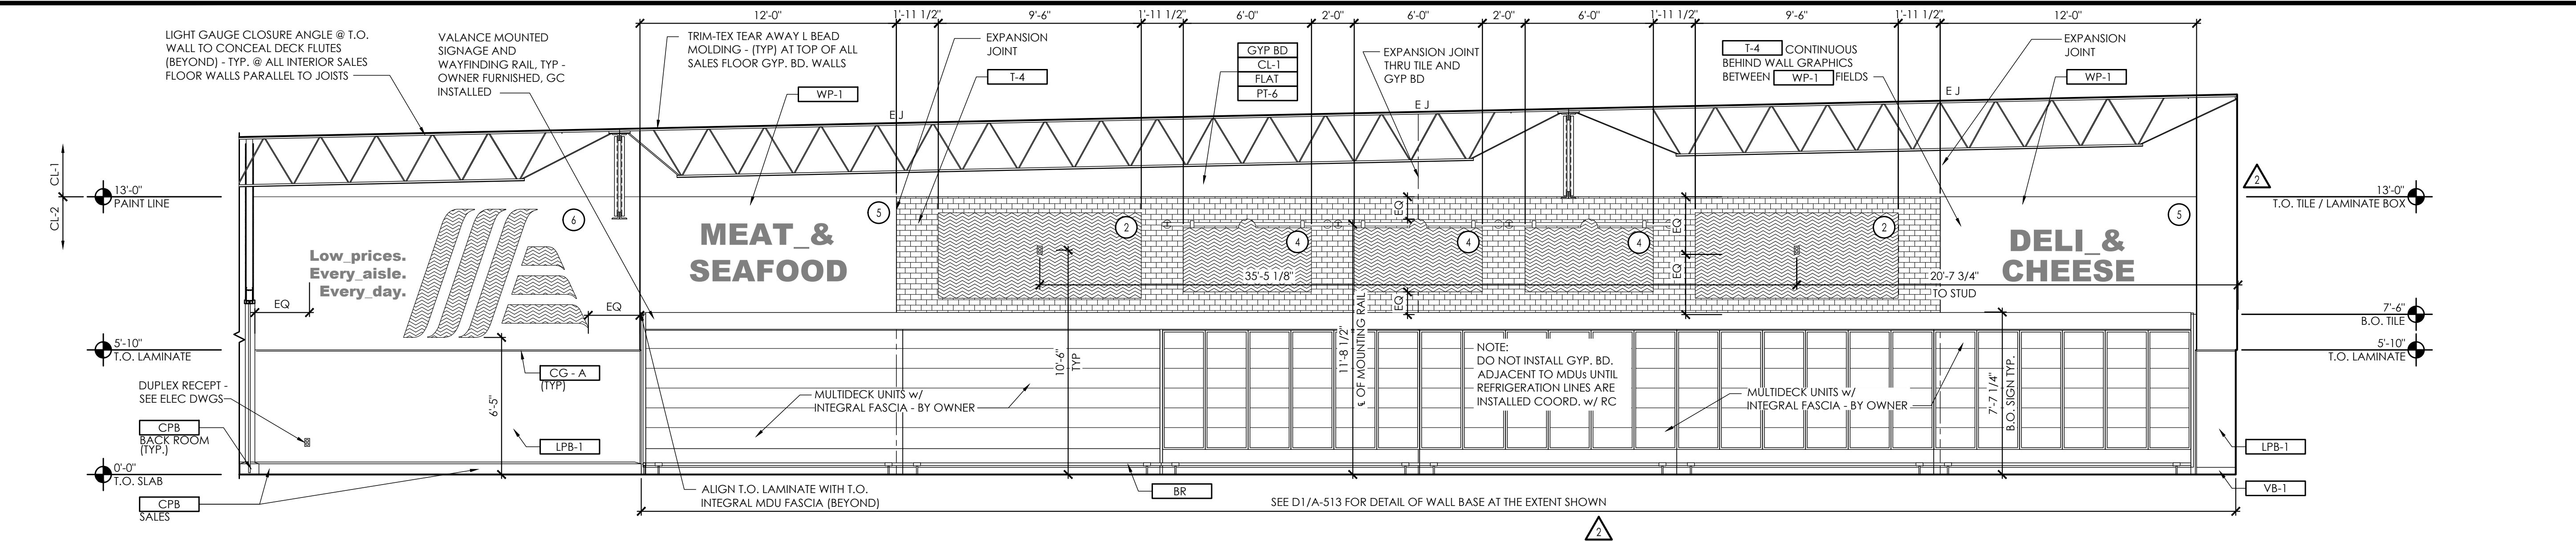

C3 Sales #102
SCALE: 1/4" = 1'-0"

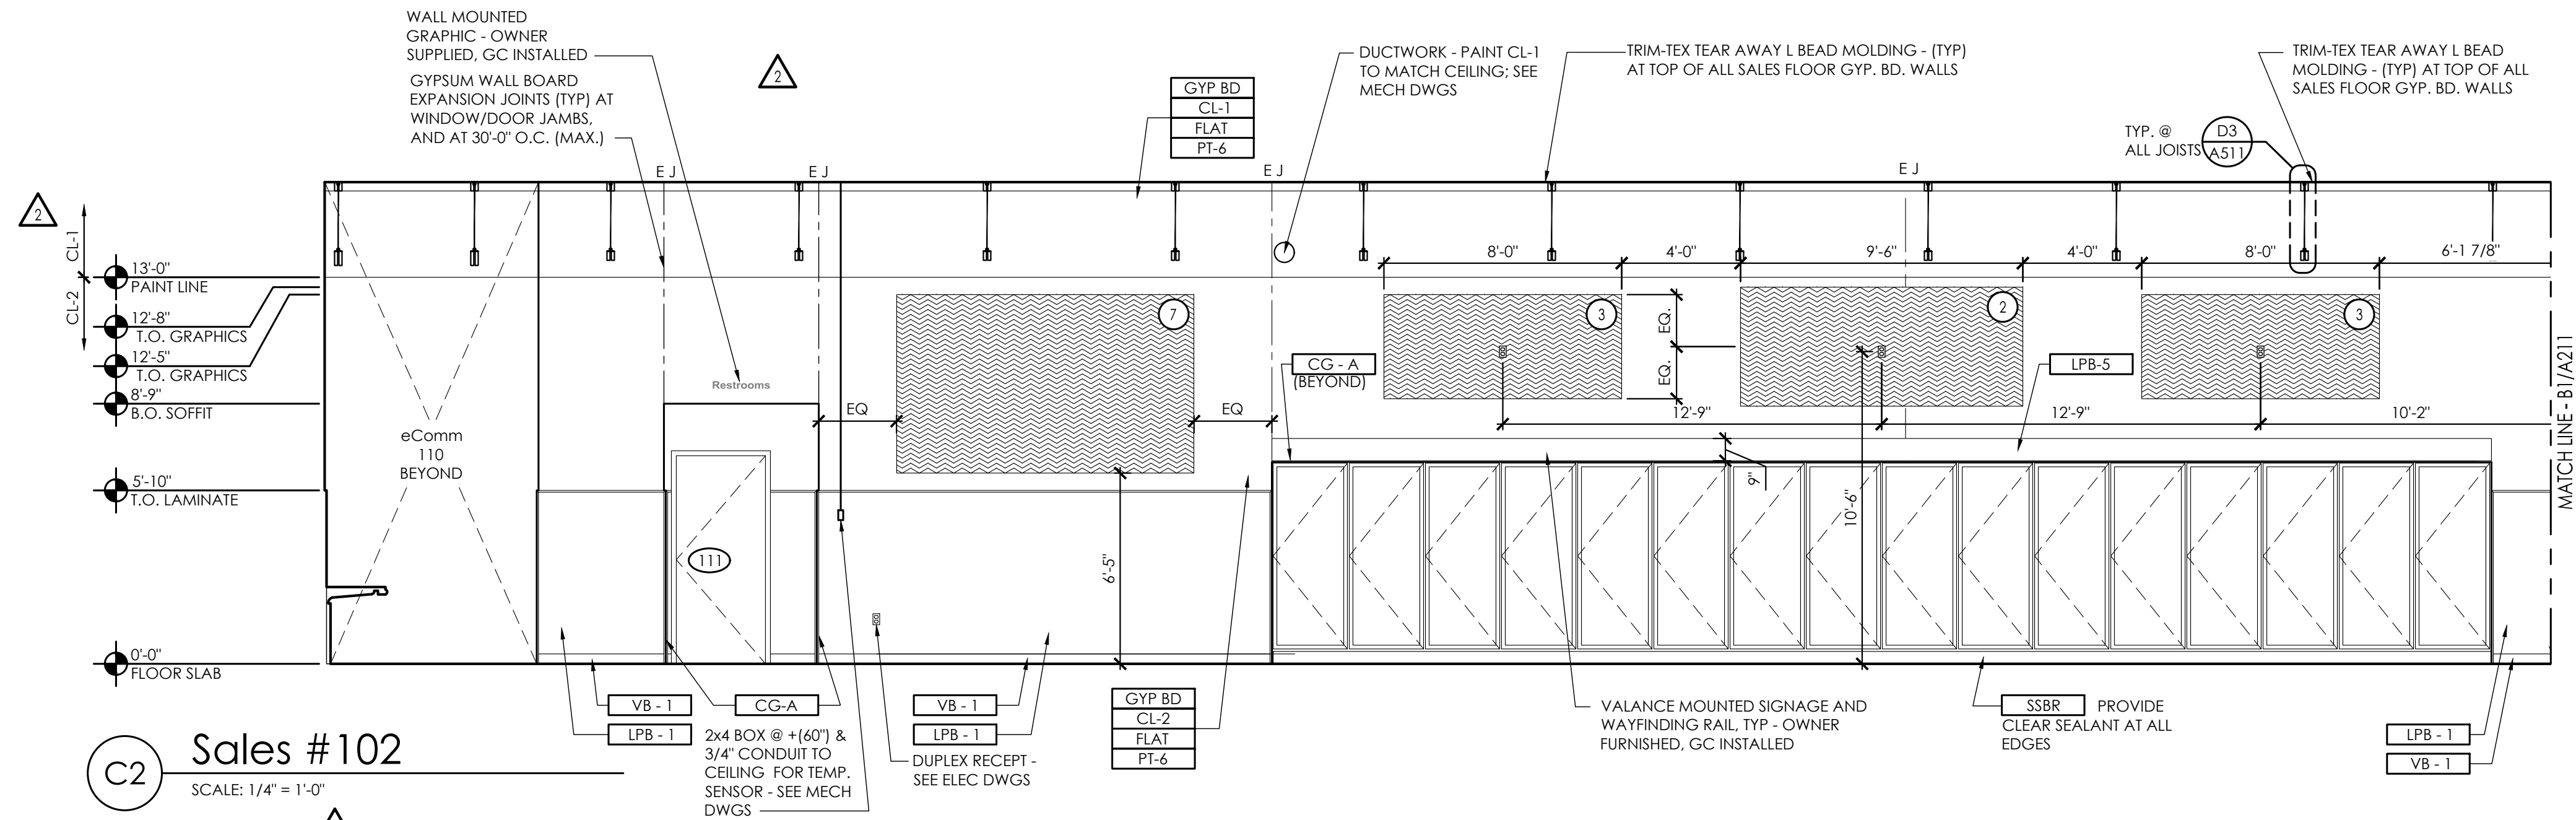


C2 Sales #102
SCALE: 1/4" = 1'-0"

SALES FLOOR GRAPHICS SCHEDULE			
KEY	KEY DESCRIPTION	MANUFACTURER	NOTES
1	ILLUMINATED WALL MTD. GRAPHIC - PRODUCE	OWNER FURNISHED CONTRACTOR INSTALLED	21'6"W x 48"H - FIRST AISLE
2	ILLUMINATED WALL MTD. GRAPHIC - PHOTOGRAPHY	OWNER FURNISHED CONTRACTOR INSTALLED	11'4"W x 48"H - FIRST AISLE, ABOVE MDUS, COOLER AND FREEZER WALLS
3	WALL MTD. GRAPHIC - WAYFINDING	OWNER FURNISHED CONTRACTOR INSTALLED	9'6"W x 42"H - FIRST AISLE, COOLER AND FREEZER WALLS
4	WALL MTD. GRAPHIC w/ MOUNTING RAIL - MDU WALL WAYFINDING	OWNER FURNISHED CONTRACTOR INSTALLED	7'2"W x 40'7/8"H - BACK WALL ABOVE MDUS PROVIDE CONTINUOUS 2X6 WD BLKG IN WALL FOR FOR MOUNTING RAIL BRACKET ATTACHMENT FOR ENTIRE LENGTH OF RAIL
5	WALL MTD. CHANNEL LETTERS - MDU WALL WAYFINDING	OWNER FURNISHED CONTRACTOR INSTALLED	VIF x 17"H - LETTERS REFER TO A-603 FOR WP-1 INFO
6	WALL MTD GRAPHIC - LOGO AND TAGLINES	OWNER FURNISHED CONTRACTOR INSTALLED	VIF x 7"H - LETTERS COORDINATE INSTALLATION WITH CLIENT
7	WALL MTD GRAPHIC - CR MURAL	OWNER FURNISHED CONTRACTOR INSTALLED	12'0"W x 7'2"H - ADJACENT TO FREEZER
8	WALL MTD GRAPHIC - SACKING COUNTER	OWNER FURNISHED CONTRACTOR INSTALLED	4'7'1/2" x 3'6'3/8"
9	ILLUMINATED GRAPHIC - VERTICAL MESSAGE	OWNER FURNISHED CONTRACTOR INSTALLED	VIF OPENING TO ALLOW FOR FRAME TO BE INSTALLED WITHIN WALL ASSEMBLY

GENERAL NOTES:

- ALL WALLS TO BE CLEANED AFTER PAINTING OF CEILING TO REMOVE DRYFALL PAINT RESIDUE. COMPLETE CLEANING PRIOR TO INSTALLATION OF OWNER FURNISHED GRAPHICS PACKAGE.
- REFER TO DRAWING A-603 FOR ALL FINISH CALL-OUTS.
- GC TO INSTALL OWNER FURNISHED INTERIOR GRAPHICS AND MILLWORK PACKAGE. REFER TO INSTALLATION INSTRUCTIONS AND CUT SHEETS POSTED TO WWW.SHARENOLGY.COM
INTERIOR GRAPHICS:
VENDOR INFO > SBPI INTERIOR GRAPHICS
MILLWORK:
VENDOR INFO > RIDDELY CABINET CO INC
VENDOR INFO > KPI CONCEPTS INC
- COORDINATE LOCATIONS OF ALL EXPANSION JOINTS WITH THE GRAPHICS PACKAGE TO MINIMIZE INTERFERENCE WITH THE GRAPHICS.
- ALL SALES AREA WALLS TO BE FREE OF ABANDONED DEVICE BOXES AND NO BLANK COVER PLATES ARE TO BE EXPOSED.
- COORDINATE LAYOUT OF REFRIGERATION LINES WITH REFRIGERATION CONTRACTOR BEFORE ENCLOSING WALL CAVITY.

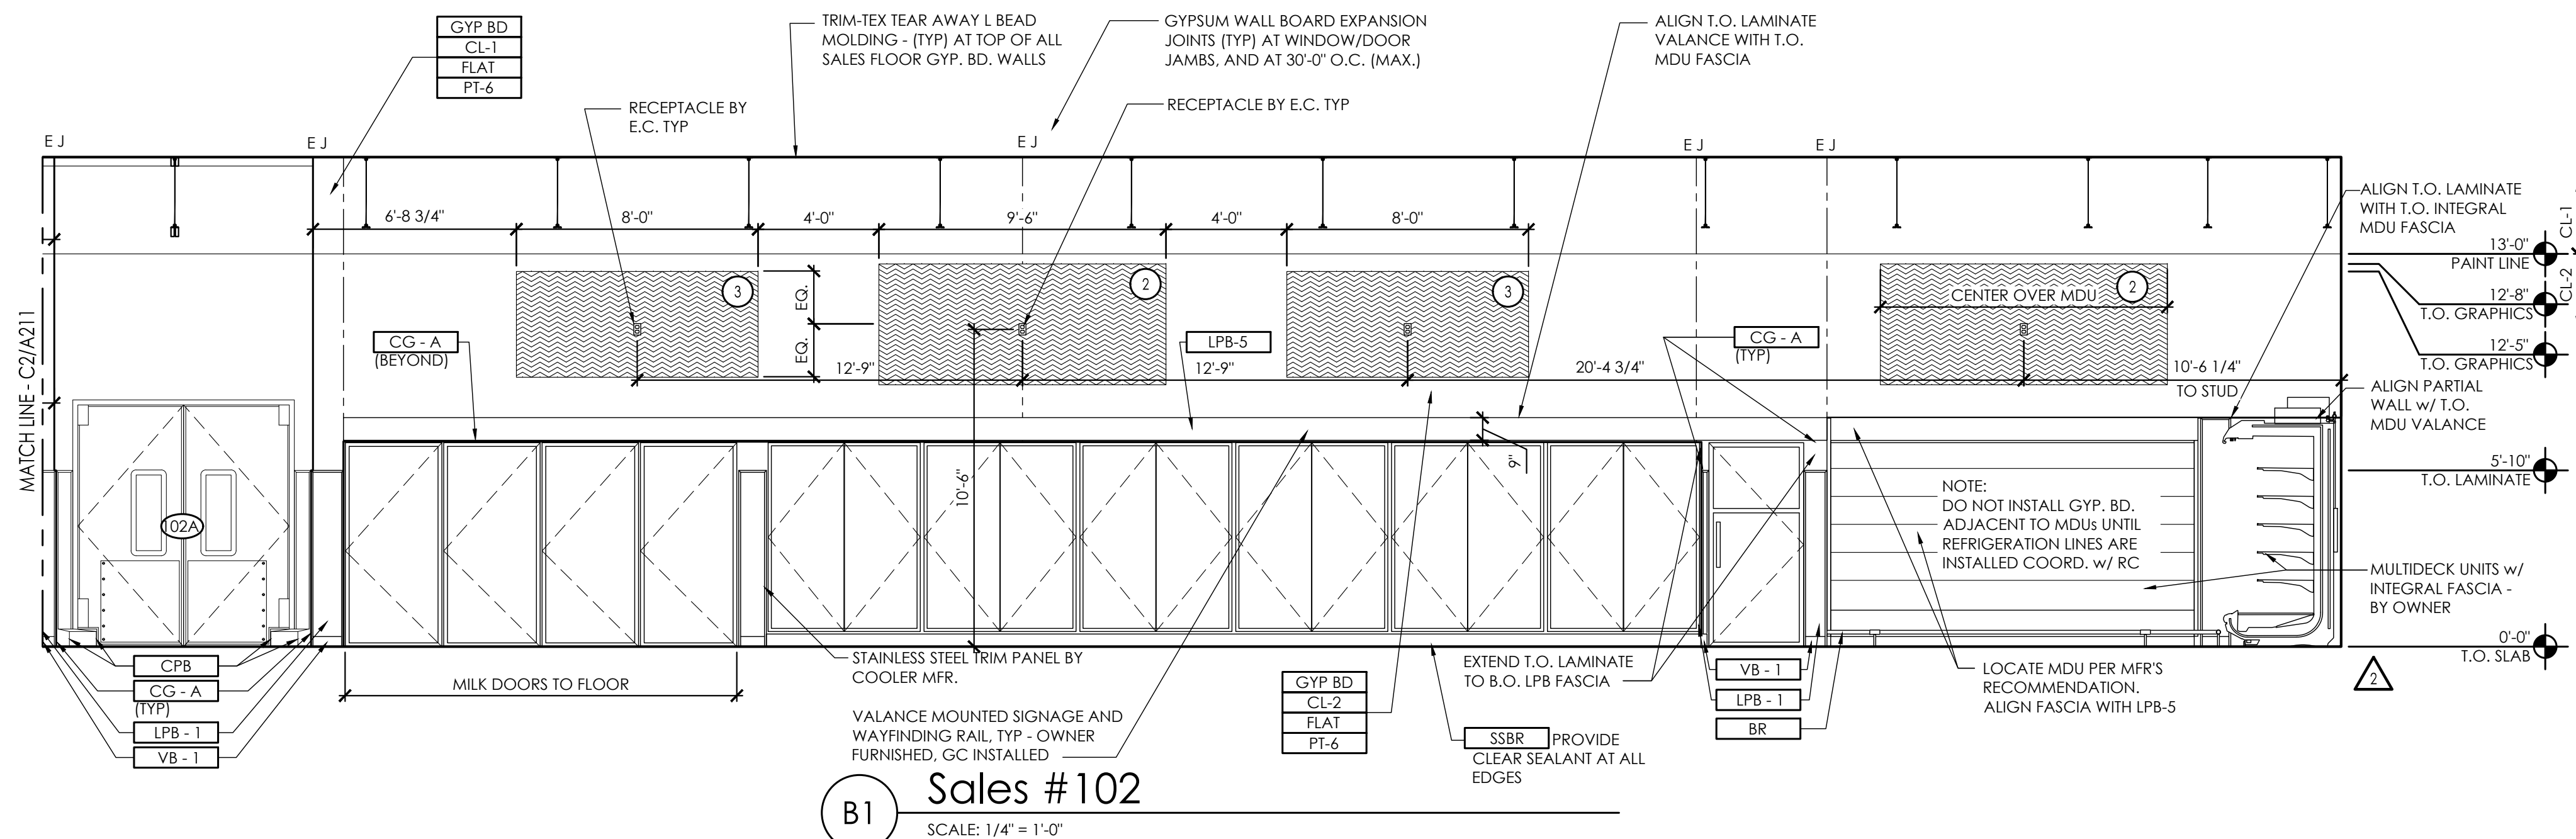

B1 Sales #102
SCALE: 1/4" = 1'-0"

Copyright © 2024

APD Engineering & Architecture
03/21/2024

Drawing Alteration

It is a violation of law for any person, unless acting under the direction of licensed Architect, Professional Engineer, Landscape Architect, or Land Surveyor to alter any item on this document in any way. Any licensee who alters this document is required by law to affix his or her seal and to add the notation "Altered By" followed by his or her signature and the specific description of the alteration or revision.

DO NOT SCALE PLANS

Copying, Printing, Software and other processes required to produce these prints can stretch or shrink the actual paper or layout. Therefore, scaling of this drawing may be inaccurate. Contact APD E&A with any need for additional dimensions or clarifications.

Issued:	Date:
A Issued for Permit	07/08/24
B Issued for Bid	07/29/25
C	
D	
E	

Revisions:	Date:
1 Owner Changes	11/18/24
2 Owner Changes	07/29/25
3	
4	
5	
6	
7	
8	
9	
10	
11	
12	

PROJECT ARCHITECT/ENGINEER

Daniel Sargent

PROJECT LEAD

John Lynch

NOT FOR CONSTRUCTION

Seal Seal

ALDI Inc.
1171 North State Road 7
Royal Palm Beach, FL 33411
(561) 640-8000


ALDI Inc. Store #: 50
Coconut Crossing, FL
12850 Northlake Boulevard
Palm Beach Gardens, FL 33412
Palm Beach County
Project Name & Location:

Interior Elevations Drawing Name:	
Prototype:	Project No.
V7.08 LHRD	22-0267A
Type:	
GROUND UP	
Drawn By:	
JWL	
Scale:	
As Noted	
A-211	
Drawing No.	

A	Issued for Permit	07/08/24
B	Issued for Bid	07/29/25
C		
D		
E		


1	Owner Changes	11/18/24
2	Owner Changes	07/29/25
3		
4		
5		
6		
7		
8		
9		
10		
11		
12		

Prototype:	Project No.
V7.08 LHRD	22-0267A
Type:	
GROUND UP	
Drawn By:	
JWL	
Scale:	A-212
As Noted	Drawing No.

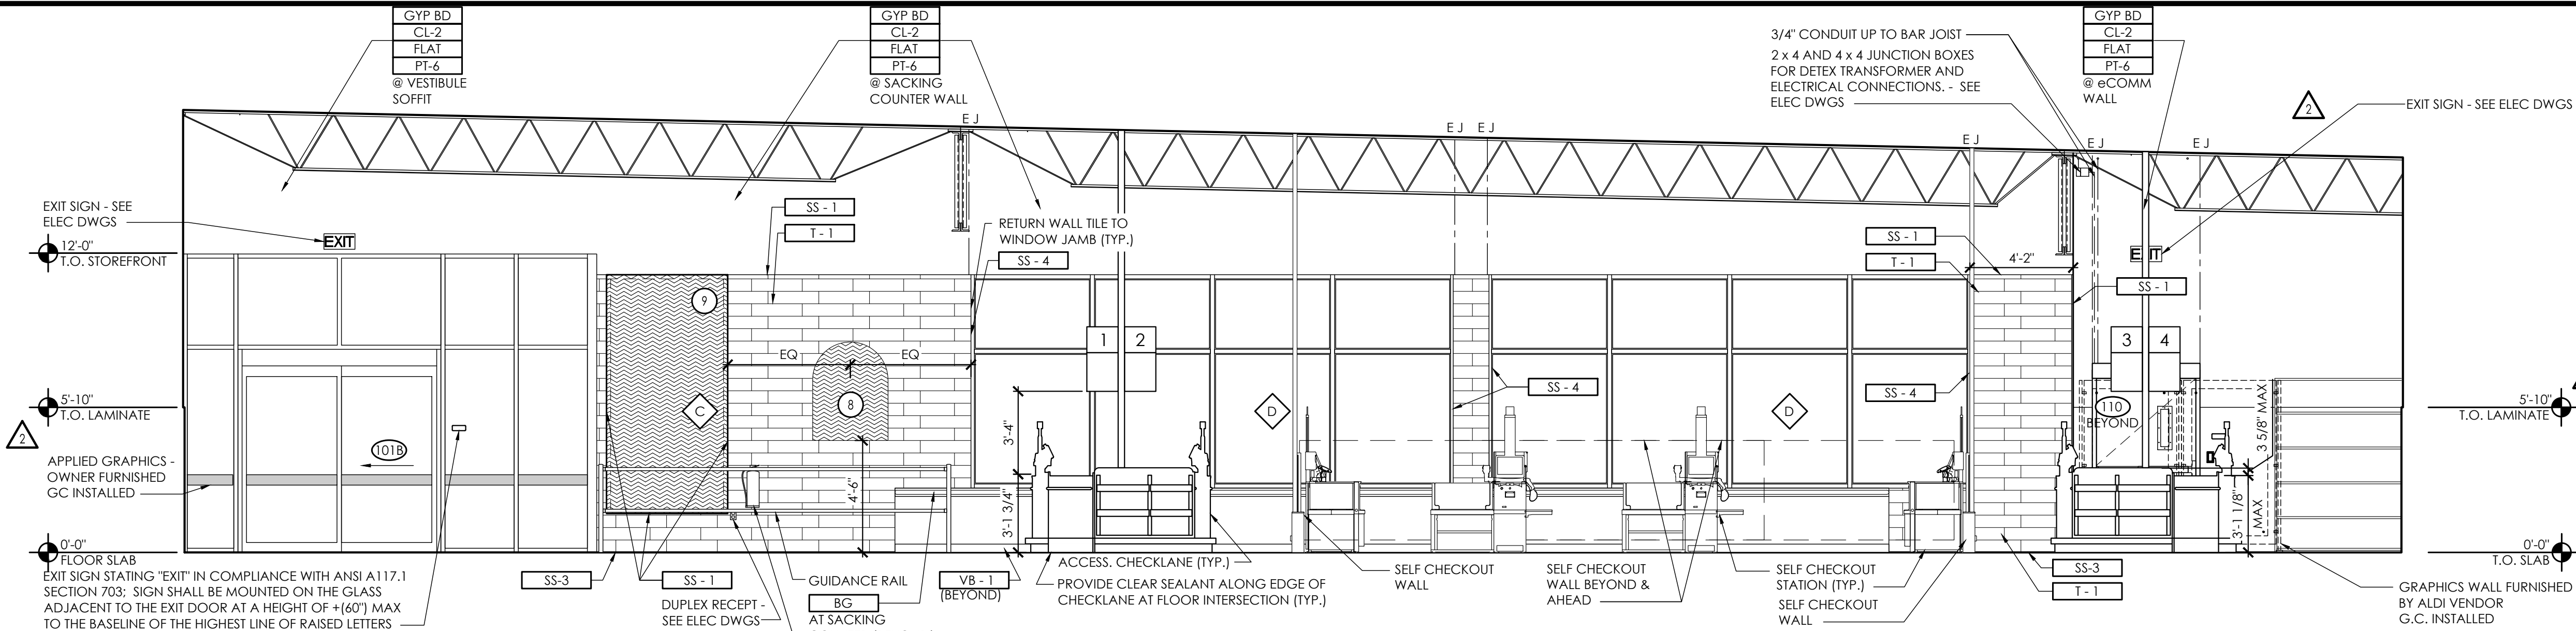

Sales #102

SCALE: 1/4" = 1'-0"

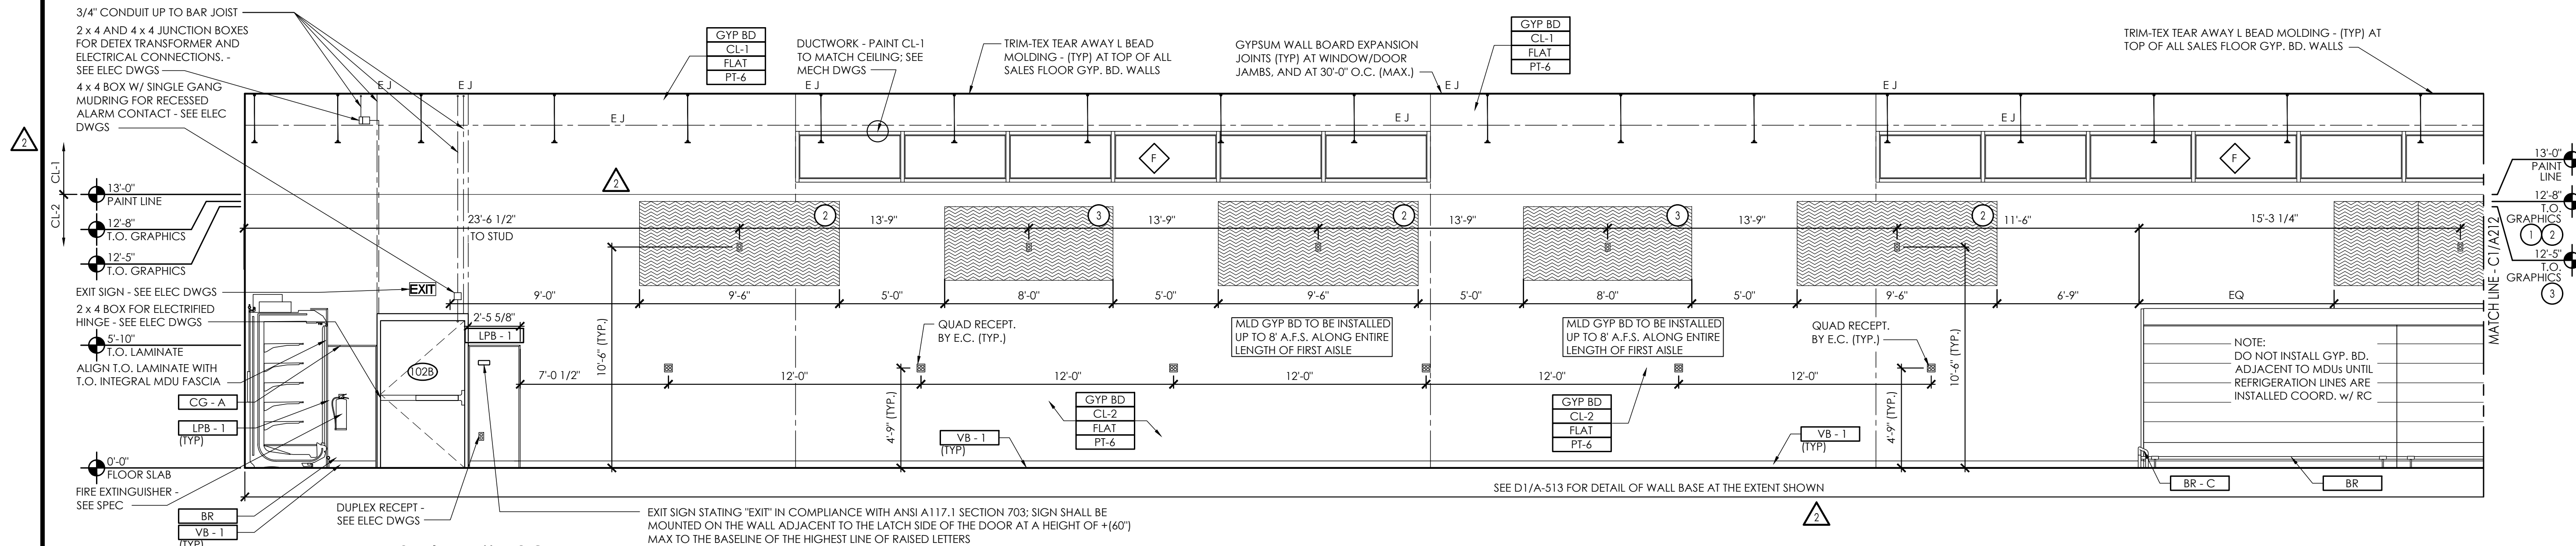


Sales #102

SCALE: 1/4" = 1'-0"

KEY	KEY DESCRIPTION	SALES FLOOR GRAPHICS SCHEDULE	MANUFACTURER	NOTES
1	ILLUMINATED WALL MTD. GRAPHIC - PRODUCE	OWNER FURNISHED CONTRACTOR INSTALLED	216"W x 48"H - FIRST AISLE	
2	ILLUMINATED WALL MTD. GRAPHIC - PHOTOGRAPHY	OWNER FURNISHED CONTRACTOR INSTALLED	114"W x 48"H - FIRST AISLE, ABOVE MDUS, COOLER AND FREEZER WALLS	
3	WALL MTD. GRAPHIC - WAYFINDING	OWNER FURNISHED CONTRACTOR INSTALLED	96"W x 42"H - FIRST AISLE, COOLER AND FREEZER WALLS	
4	WALL MTD. GRAPHIC w/ MOUNTING RAIL - MDU WALL WAYFINDING	OWNER FURNISHED CONTRACTOR INSTALLED	72"W x 40 7/8"H - BACK WALL ABOVE MDUS PROVIDE CONTINUOUS 2X6 WD BLKG IN WALL FOR FOR MOUNTING RAIL BRACKET ATTACHMENT FOR ENTIRE LENGTH OF RAIL	
5	WALL MTD. CHANNEL LETTERS - MDU WALL WAYFINDING	OWNER FURNISHED CONTRACTOR INSTALLED	VIF x 17"H - LETTERS REFER TO A-603 FOR WP-1 INFO	
6	WALL MTD GRAPHIC - LOGO AND TAGLINES	OWNER FURNISHED CONTRACTOR INSTALLED	102.875"W x 72"H - LOGO VIF x 7"H - LETTERS COORDINATE INSTALLATION WITH CLIENT	
7	WALL MTD GRAPHIC - CR MURAL	OWNER FURNISHED CONTRACTOR INSTALLED	120"W x 72"H - ADJACENT TO FREEZER	
8	WALL MTD GRAPHIC - SACKING COUNTER	OWNER FURNISHED CONTRACTOR INSTALLED	47 1/2" x 36 3/8"	
9	ILLUMINATED GRAPHIC - VERTICAL MESSAGE	OWNER FURNISHED CONTRACTOR INSTALLED	VIF OPENING TO ALLOW FOR FRAME TO BE INSTALLED WITHIN WALL ASSEMBLY	





GENERAL NOTES:

- ALL WALLS TO BE CLEANED AFTER PAINTING OF CEILING TO REMOVE DRYFALL PAINT RESIDUE. COMPLETE CLEANING PRIOR TO INSTALLATION OF OWNER FURNISHED GRAPHICS PACKAGE.
- REFER TO DRAWING A-603 FOR ALL FINISH CALL-OUTS.
- GC TO INSTALL OWNER FURNISHED INTERIOR GRAPHICS AND MILLWORK PACKAGE. REFER TO INSTALLATION INSTRUCTIONS AND CUT SHEETS POSTED TO WWW.SHARENOLOGY.COM
INTERIOR GRAPHICS:
VENDOR INFO > SBPI INTERIOR GRAPHICS
MILLWORK:
VENDOR INFO > RIDDLEY CABINET CO INC
VENDOR INFO > KPI CONCEPTS INC
- COORDINATE LOCATIONS OF ALL EXPANSION JOINTS WITH THE GRAPHICS PACKAGE TO MINIMIZE INTERFERENCE WITH THE GRAPHICS.
- ALL SALES AREA WALLS TO BE FREE OF ABANDONED DEVICE BOXES AND NO BLANK COVER PLATES ARE TO BE EXPOSED.
- COORDINATE LAYOUT OF REFRIGERATION LINES WITH REFRIGERATION CONTRACTOR BEFORE ENCLOSING WALL CAVITY.

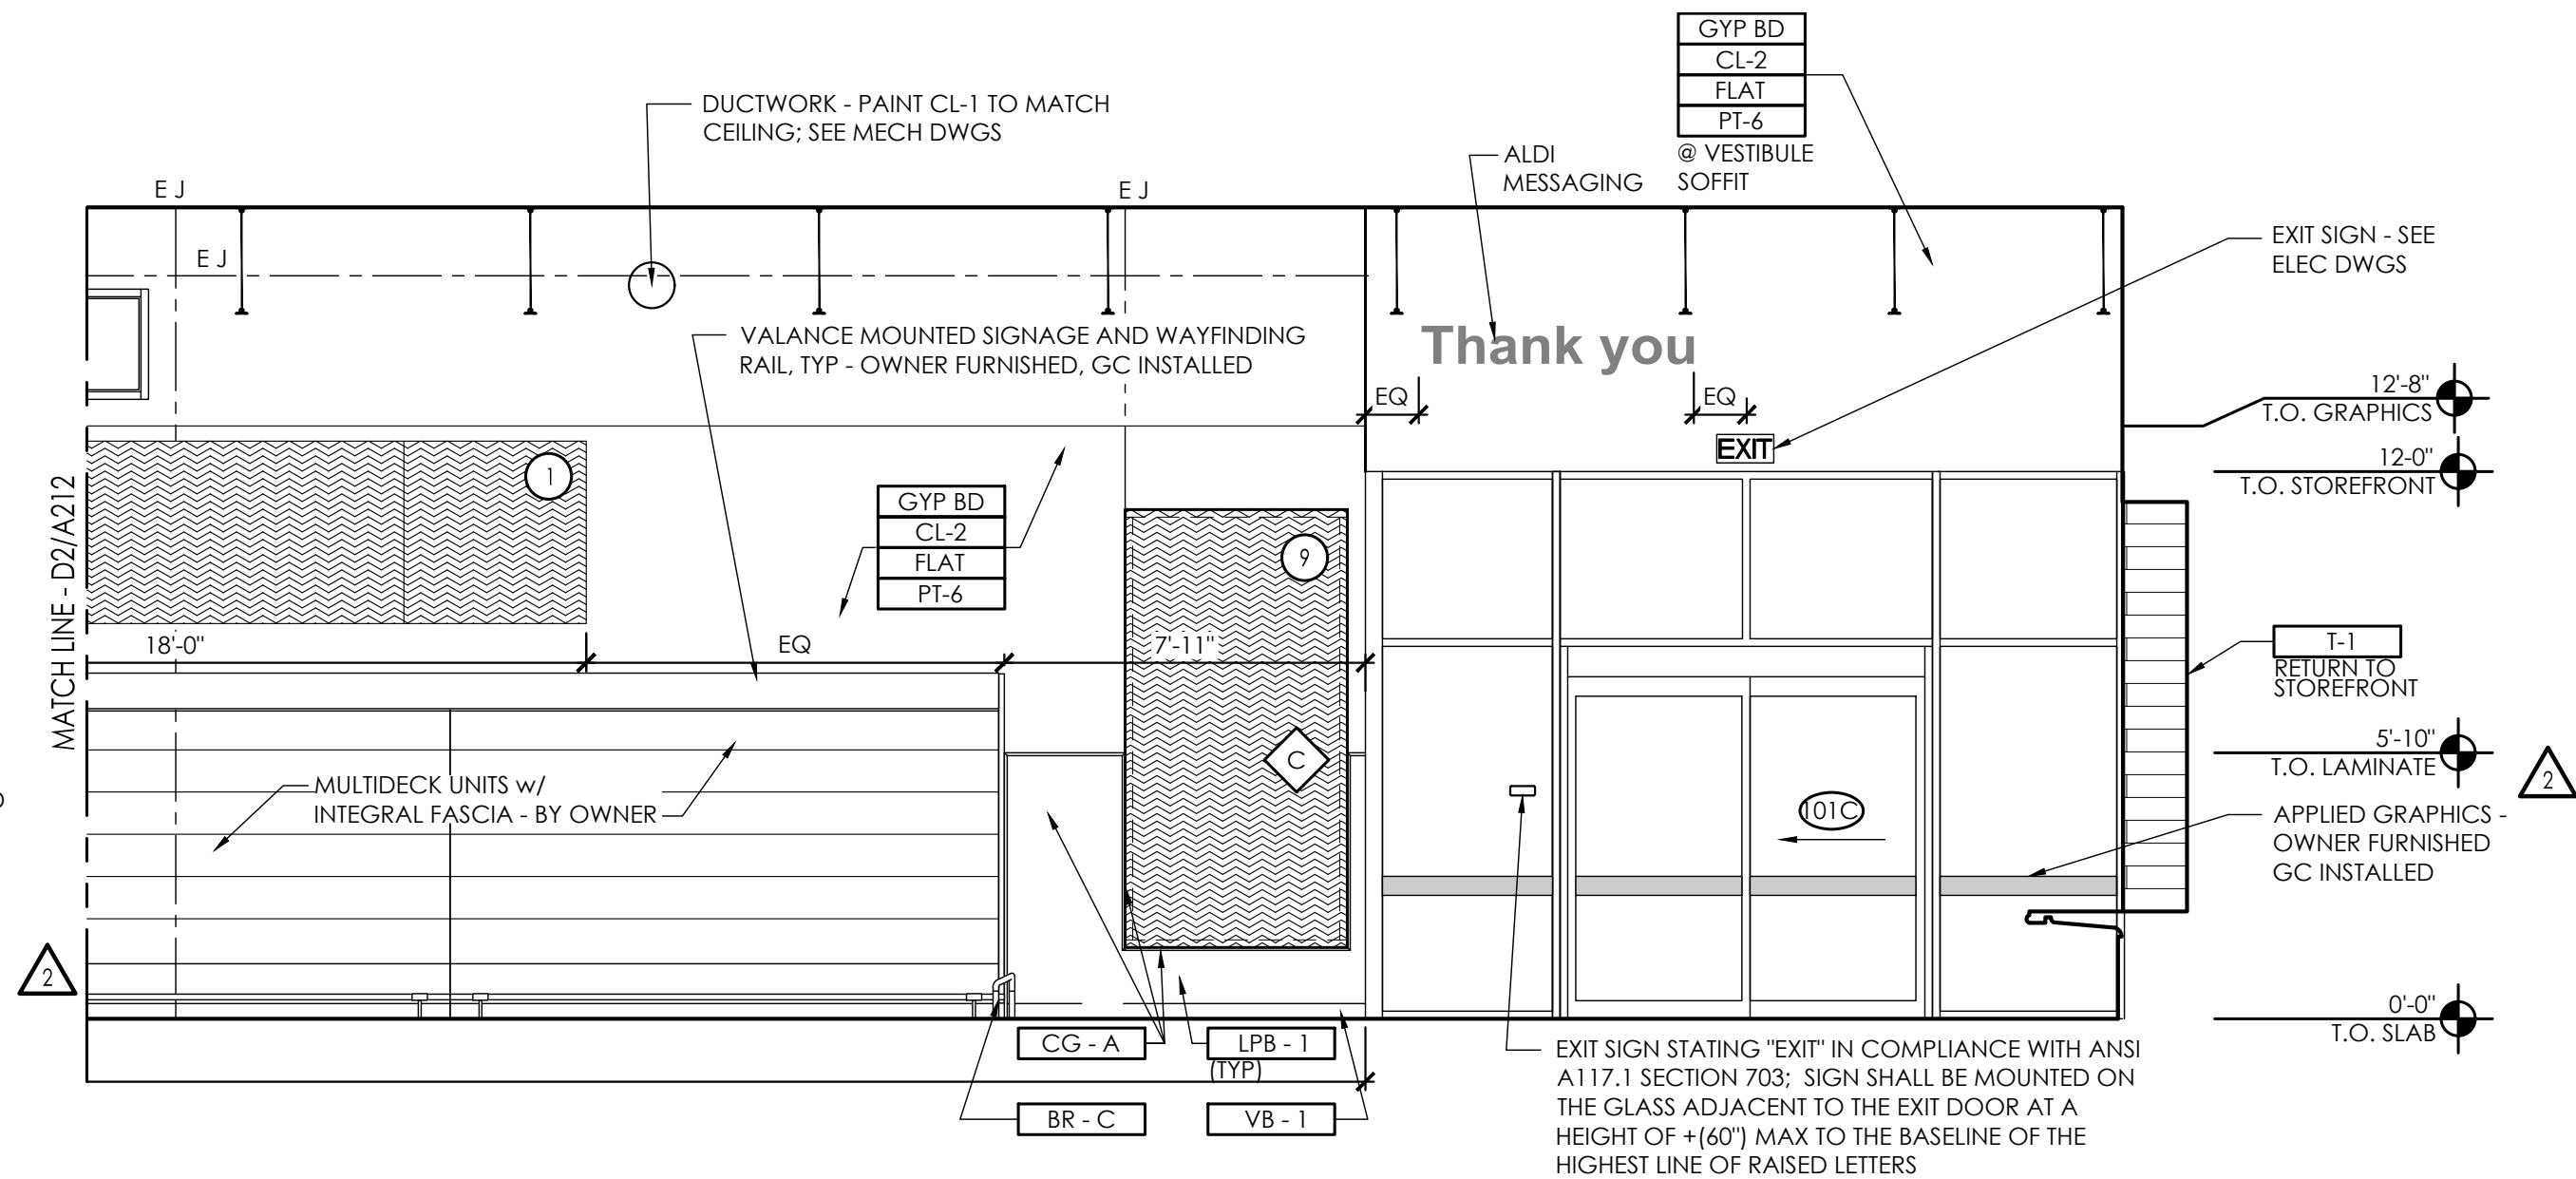

Sales #102

SCALE: 1/4" = 1'-0"

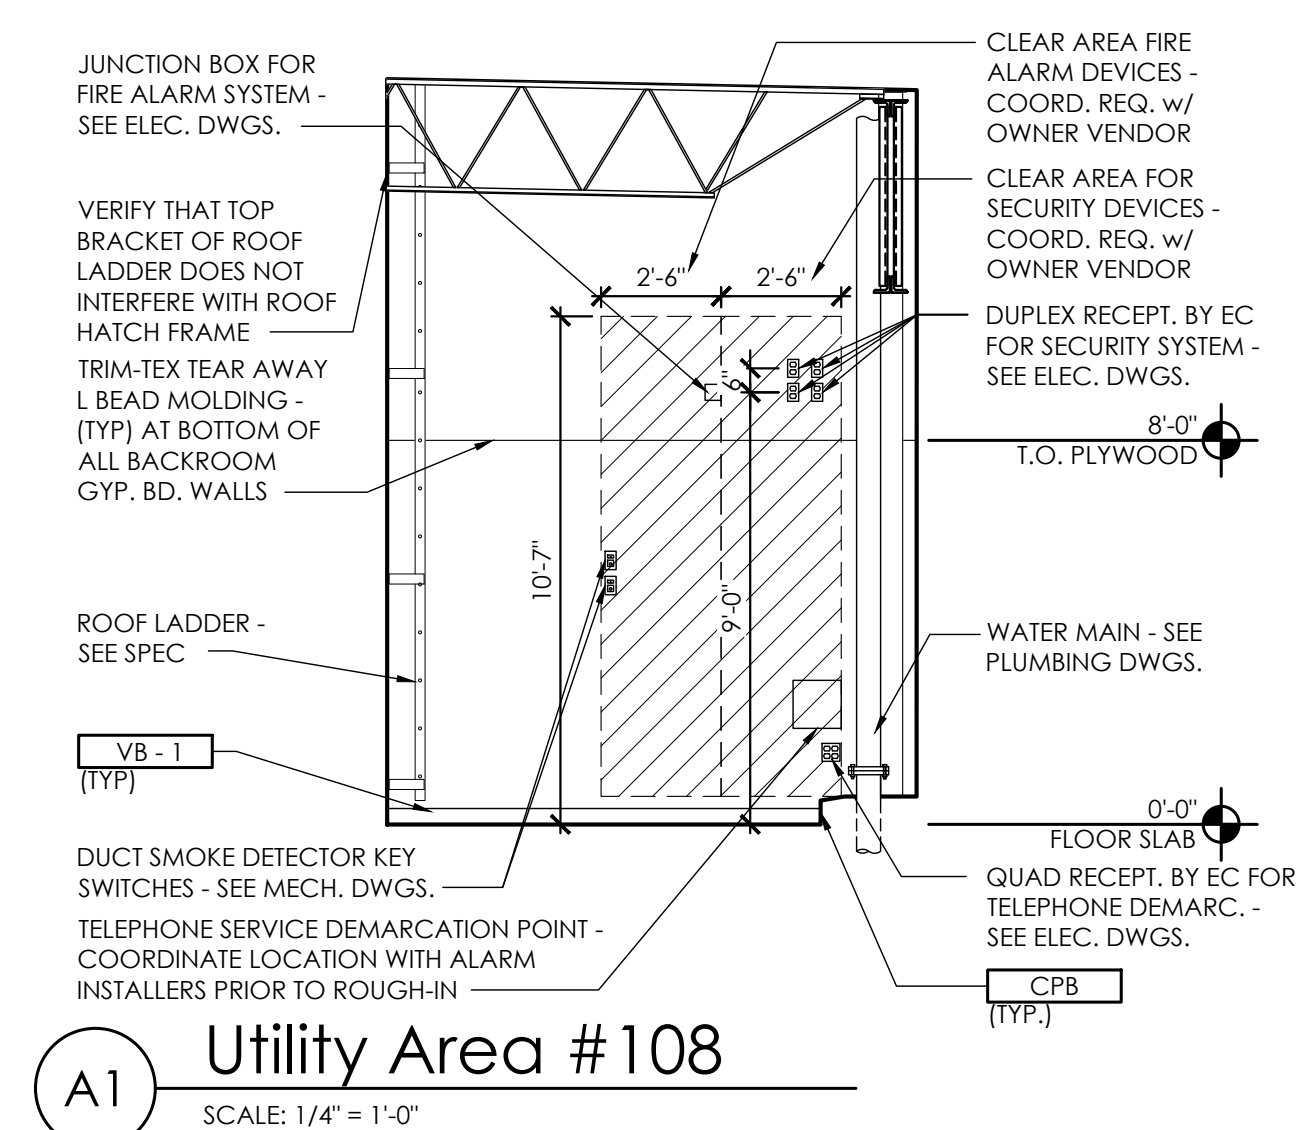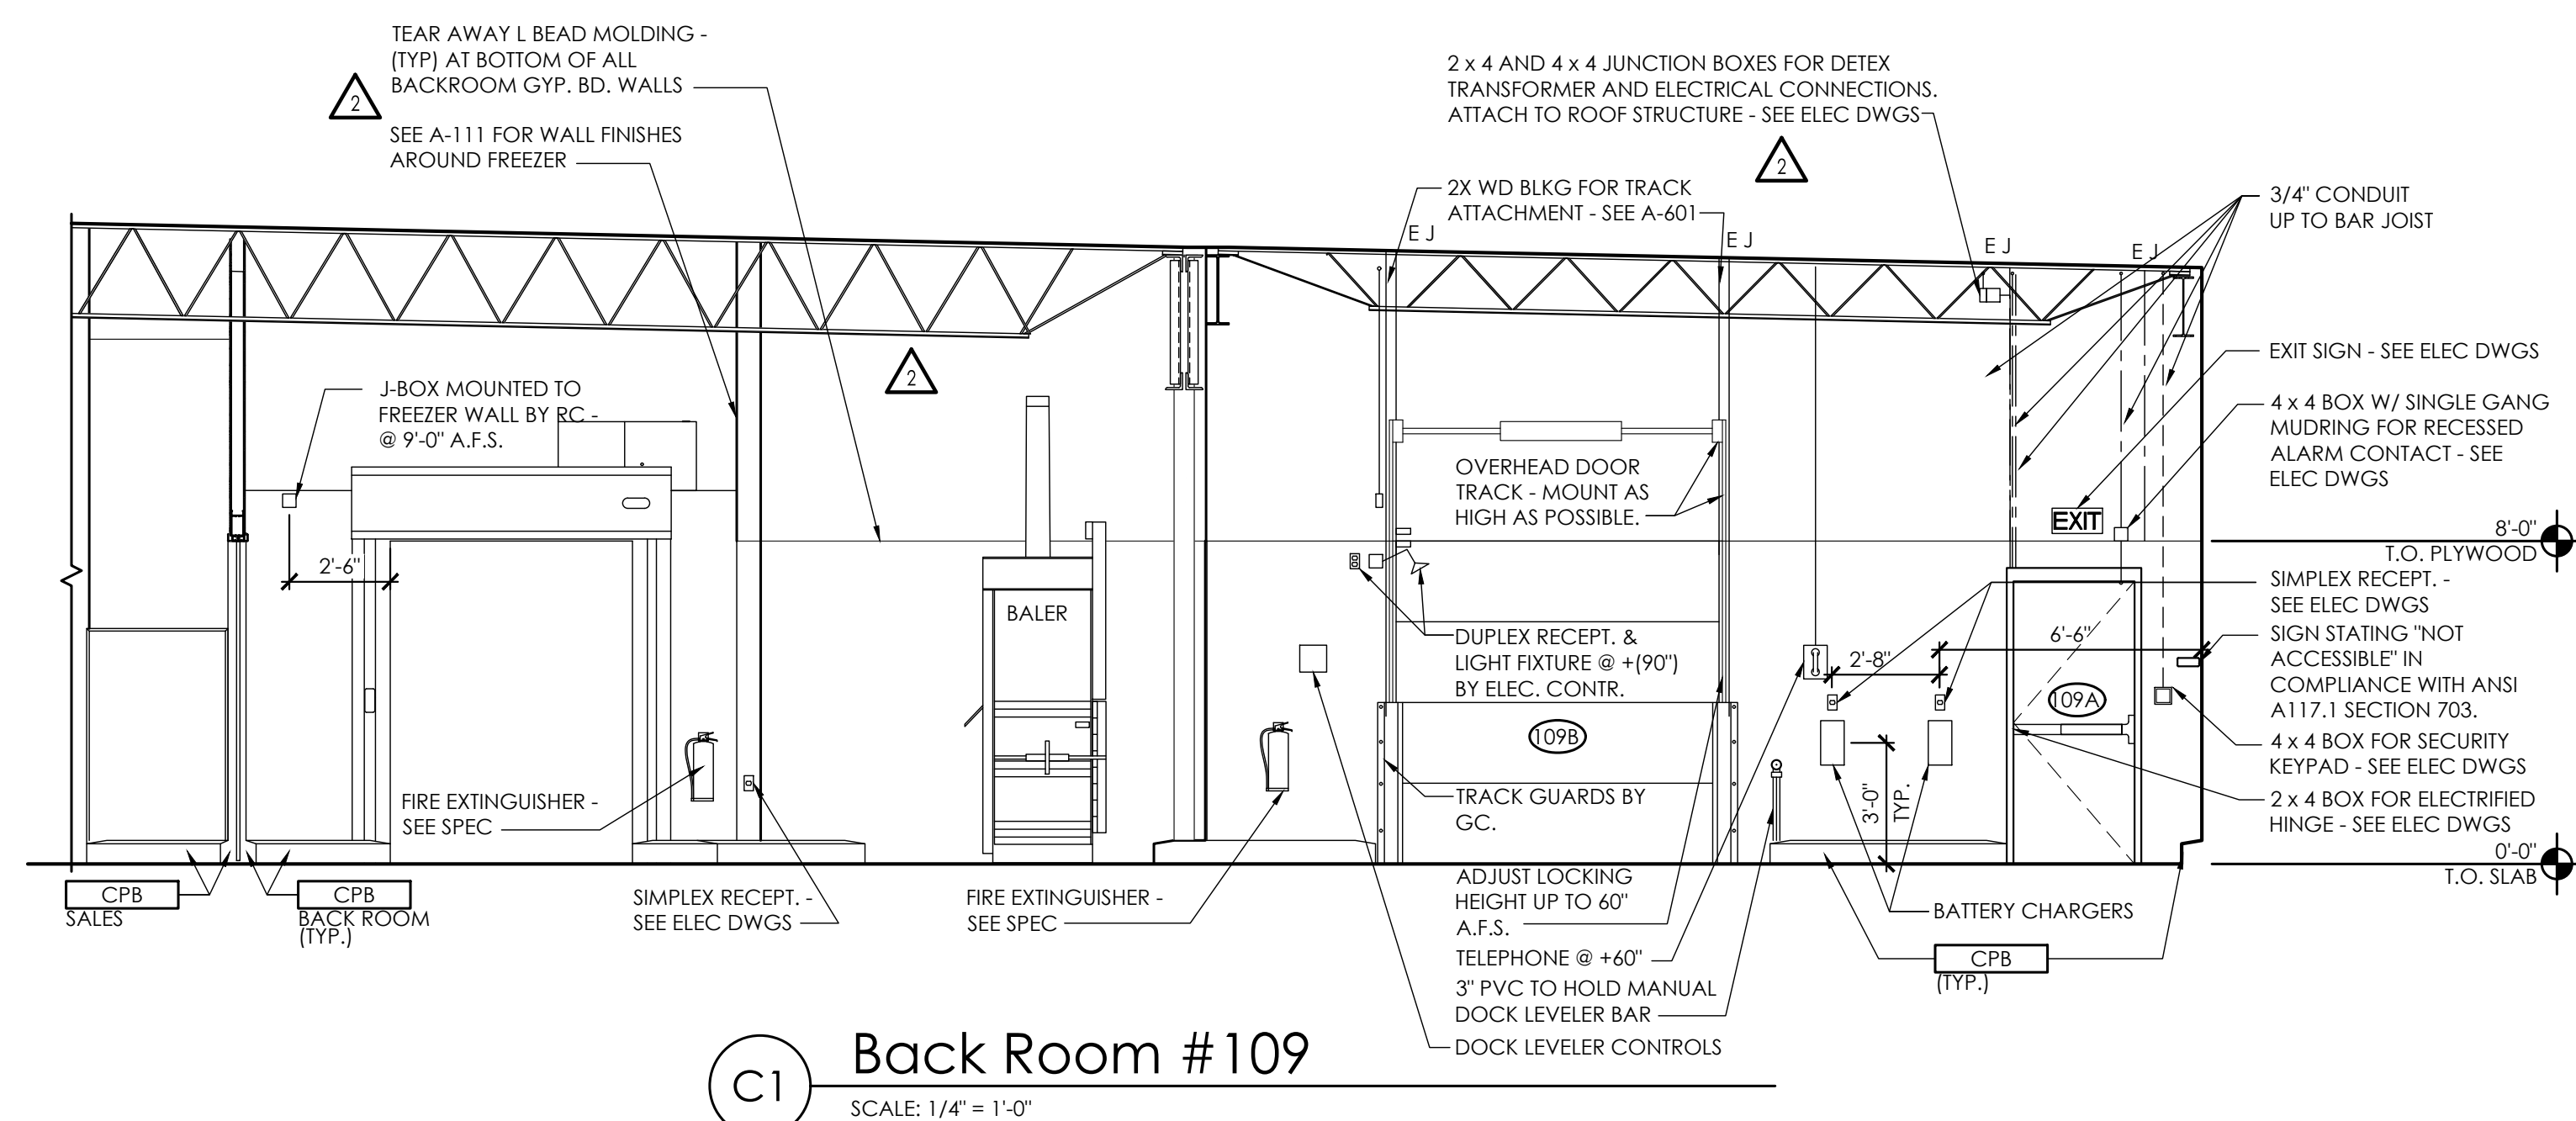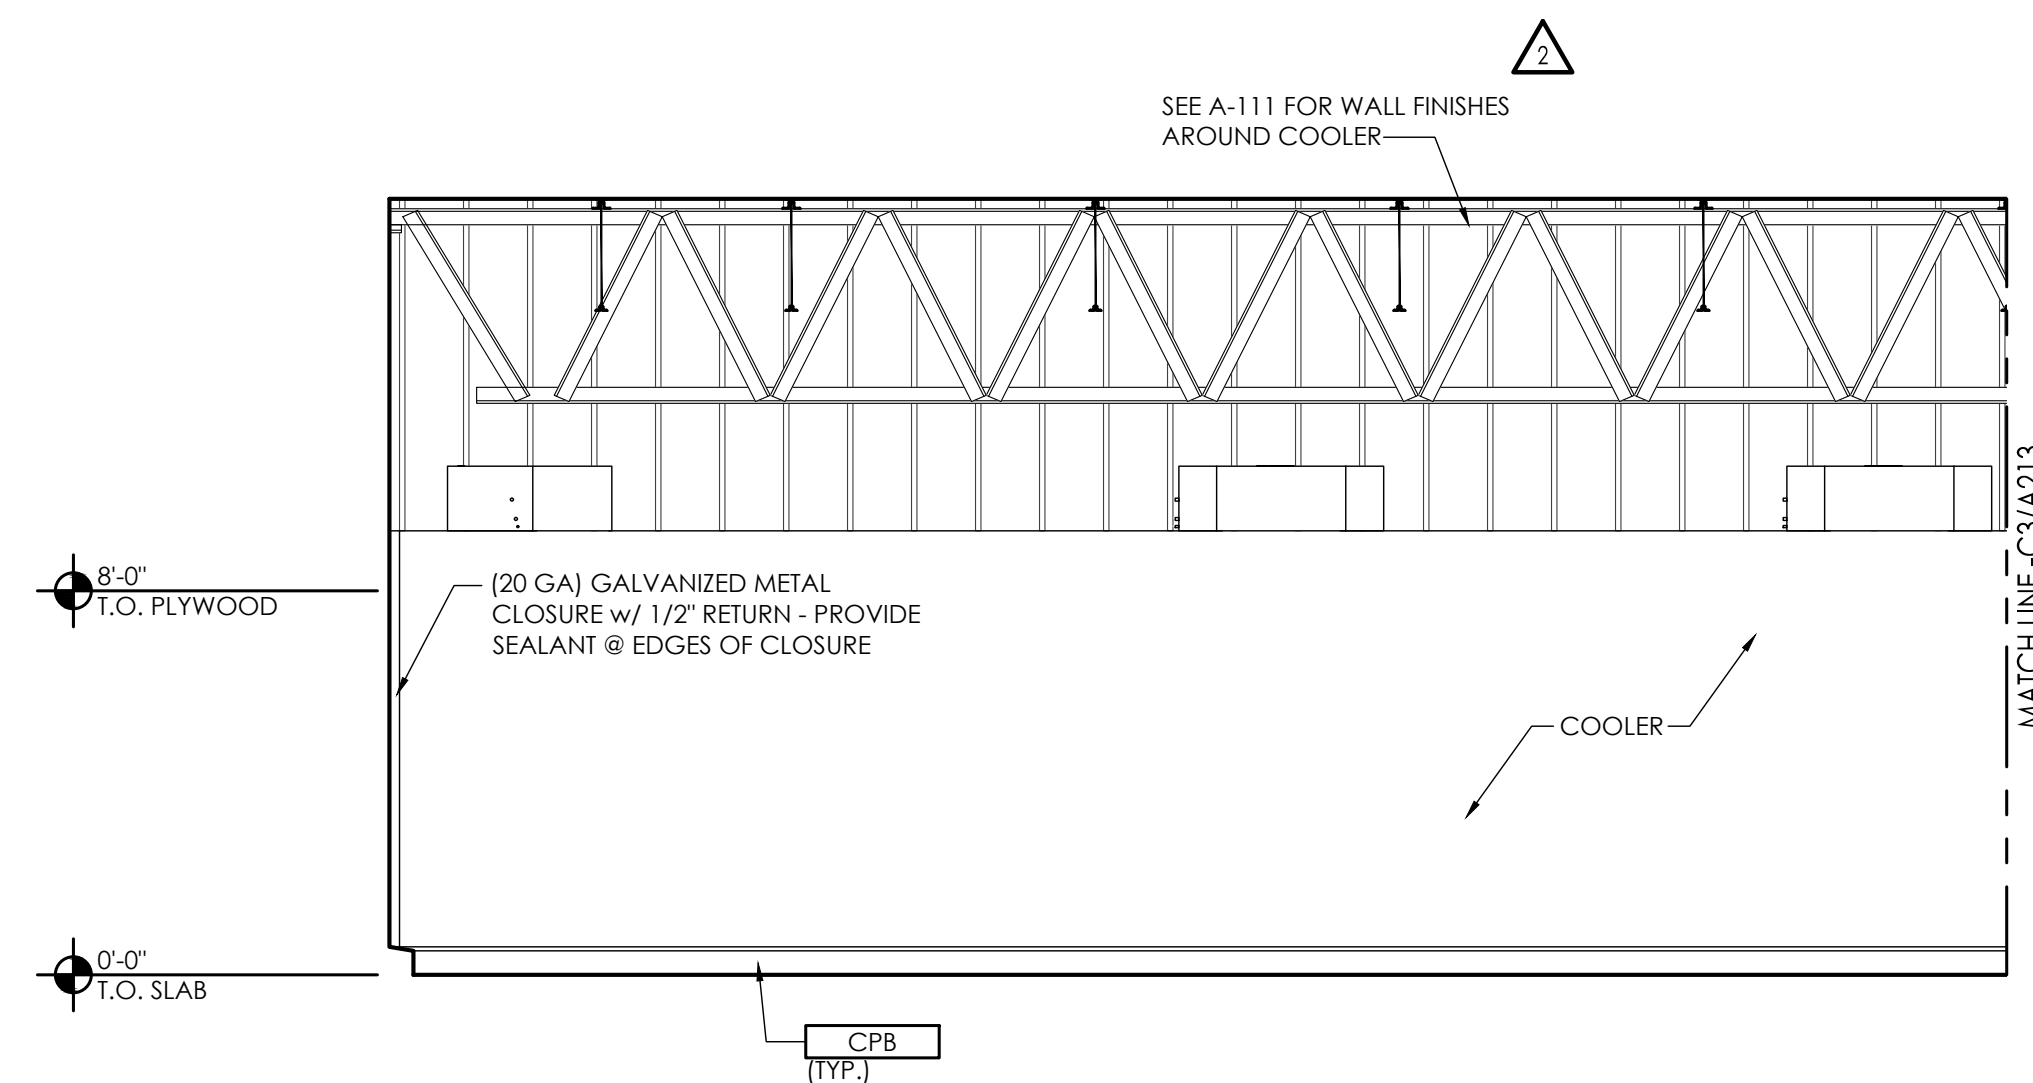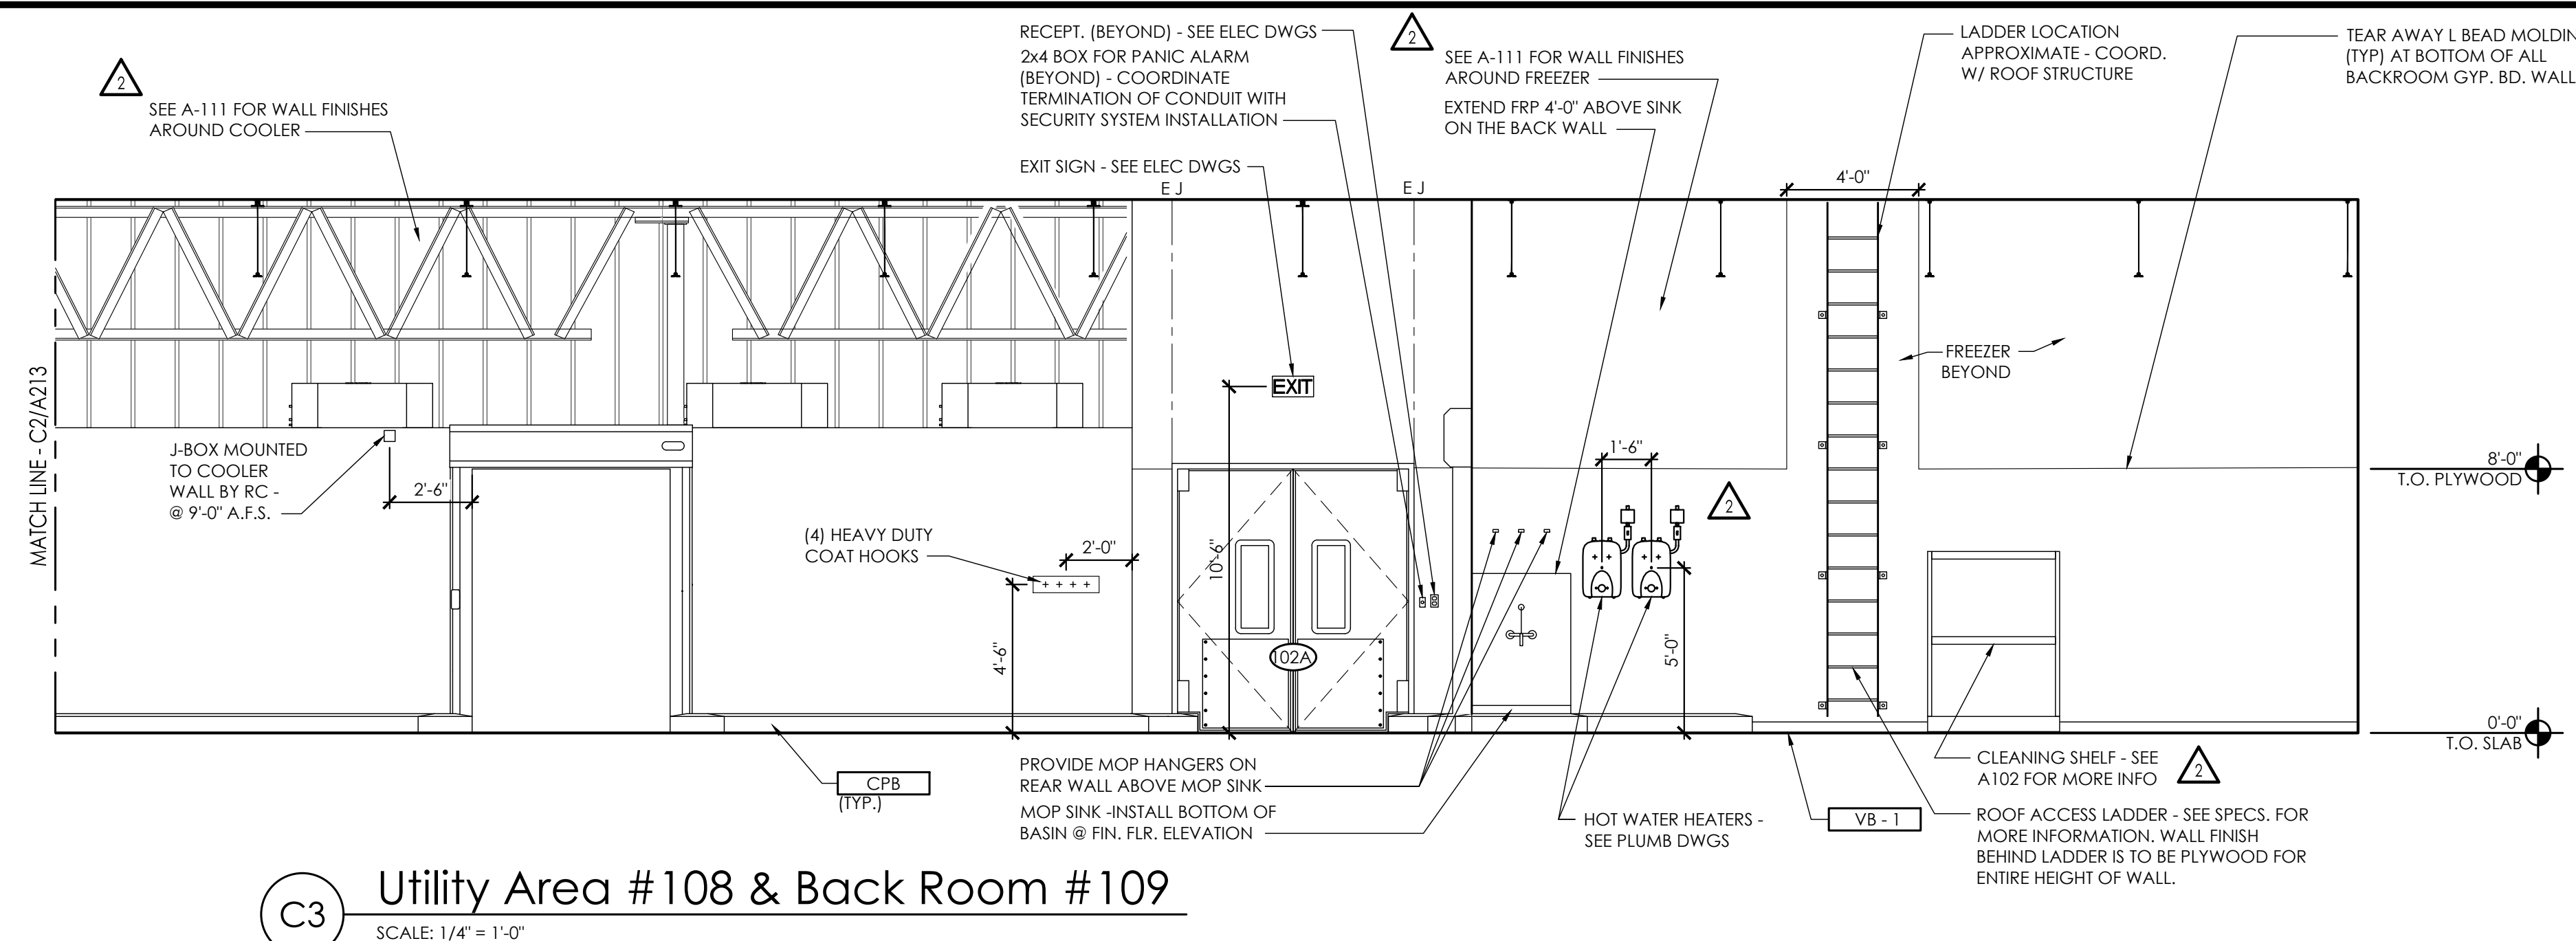

NOTES:

1. REFER TO DRAWING A-603 FOR ALL FINISH CALL-OUTS
2. VERIFY THE LOCATION OF ELECTRICAL OUTLETS WITH ELECTRICAL PLANS BEFORE INSTALLATION. IF THERE IS A CONFLICT, NOTIFY OWNER PRIOR TO ANY WORK.

Issued:		Date:
A	Issued for Permit	07/08/24
B	Issued for Bid	07/29/25
C		
D		
E		

Revisions:		Date:
1	Owner Changes	11/18/24
2	Owner Changes	07/29/25
3		
4		
5		
6		
7		
8		
9		
10		
11		
12		

PROJECT ARCHITECT/ENGINEER


Daniel Sargent

PROJECT LEAD

John Lynch

NOT FOR
CONSTRUCTION

Seal	Seal
------	------

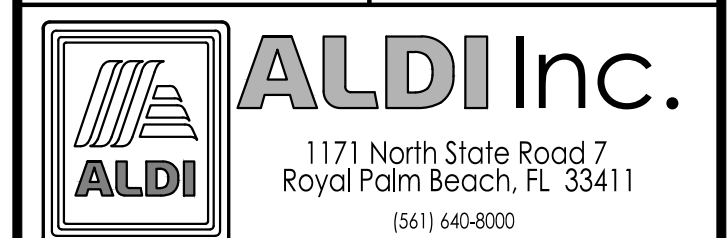

ALDI Inc. Store #: 50
Coconut Crossing, FL 
12850 Northlake Boulevard
Palm Beach Gardens, FL 33412
Palm Beach County
Project Name & Location:

Interior Elevations

Drawing Name:

Prototype: V7.08 LHRD	Project No.
Type: GROUND UP	22-0267A
Drawn By: JWL	A-213
Scale: As Noted	Drawing No.

- NOTES:
1. REFER TO DRAWING A-603 FOR ALL FINISH CALL-OUTS
 2. VERIFY THE LOCATION OF ELECTRICAL OUTLETS WITH ELECTRICAL PLANS BEFORE INSTALLATION. IF THERE IS A CONFLICT, NOTIFY OWNER PRIOR TO ANY WORK.

Copyright © 2024
APD Engineering & Architecture
03/27/2024

Drawing Alteration

It is a violation of law for any person, unless acting under the direction of licensed Architect, Professional Engineer, Landscape Architect, or Land Surveyor to alter any item on this document in any way. Any licensee who alters this document is required by law to affix his or her seal and to add the notation "Altered By" followed by his or her signature and the specific description of the alteration or revision.

DO NOT SCALE PLANS

Copying, Printing, Software and other processes required to produce these prints can stretch or shrink the actual paper or layout. Therefore, scaling of this drawing may be inaccurate. Contact APD E&A with any need for additional dimensions or clarifications.

3

Issued:	Date:
A Issued for Permit	07/08/24
B Issued for Bid	07/29/25
C	
D	
E	

Revisions:	Date:
1 Owner Changes	11/18/24
2 Owner Changes	07/29/25
3	
4	
5	
6	
7	
8	
9	
10	
11	
12	

2

PROJECT ARCHITECT/ENGINEER


Daniel Sargent

PROJECT LEAD

John Lynch

**NOT FOR
CONSTRUCTION**


Seal Seal

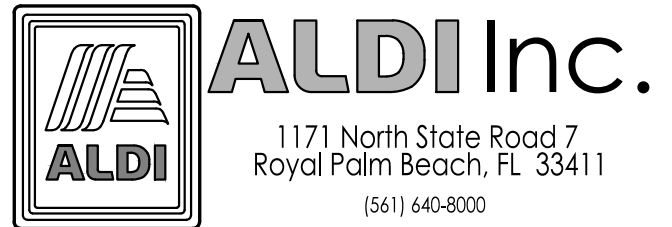


ALDI Inc. Store #: 50
Coconut Crossing, FL
12850 Northlake Boulevard
Palm Beach Gardens, FL 33412
Palm Beach County
Project Name & Location:

Interior
Elevations
Drawing Name:


Prototype:	Project No.
V7.08 LHRD	22-0267A
Type:	
GROUND UP	
Drawn By:	
JWL	
Scale:	A-214
As Noted	Drawing No.

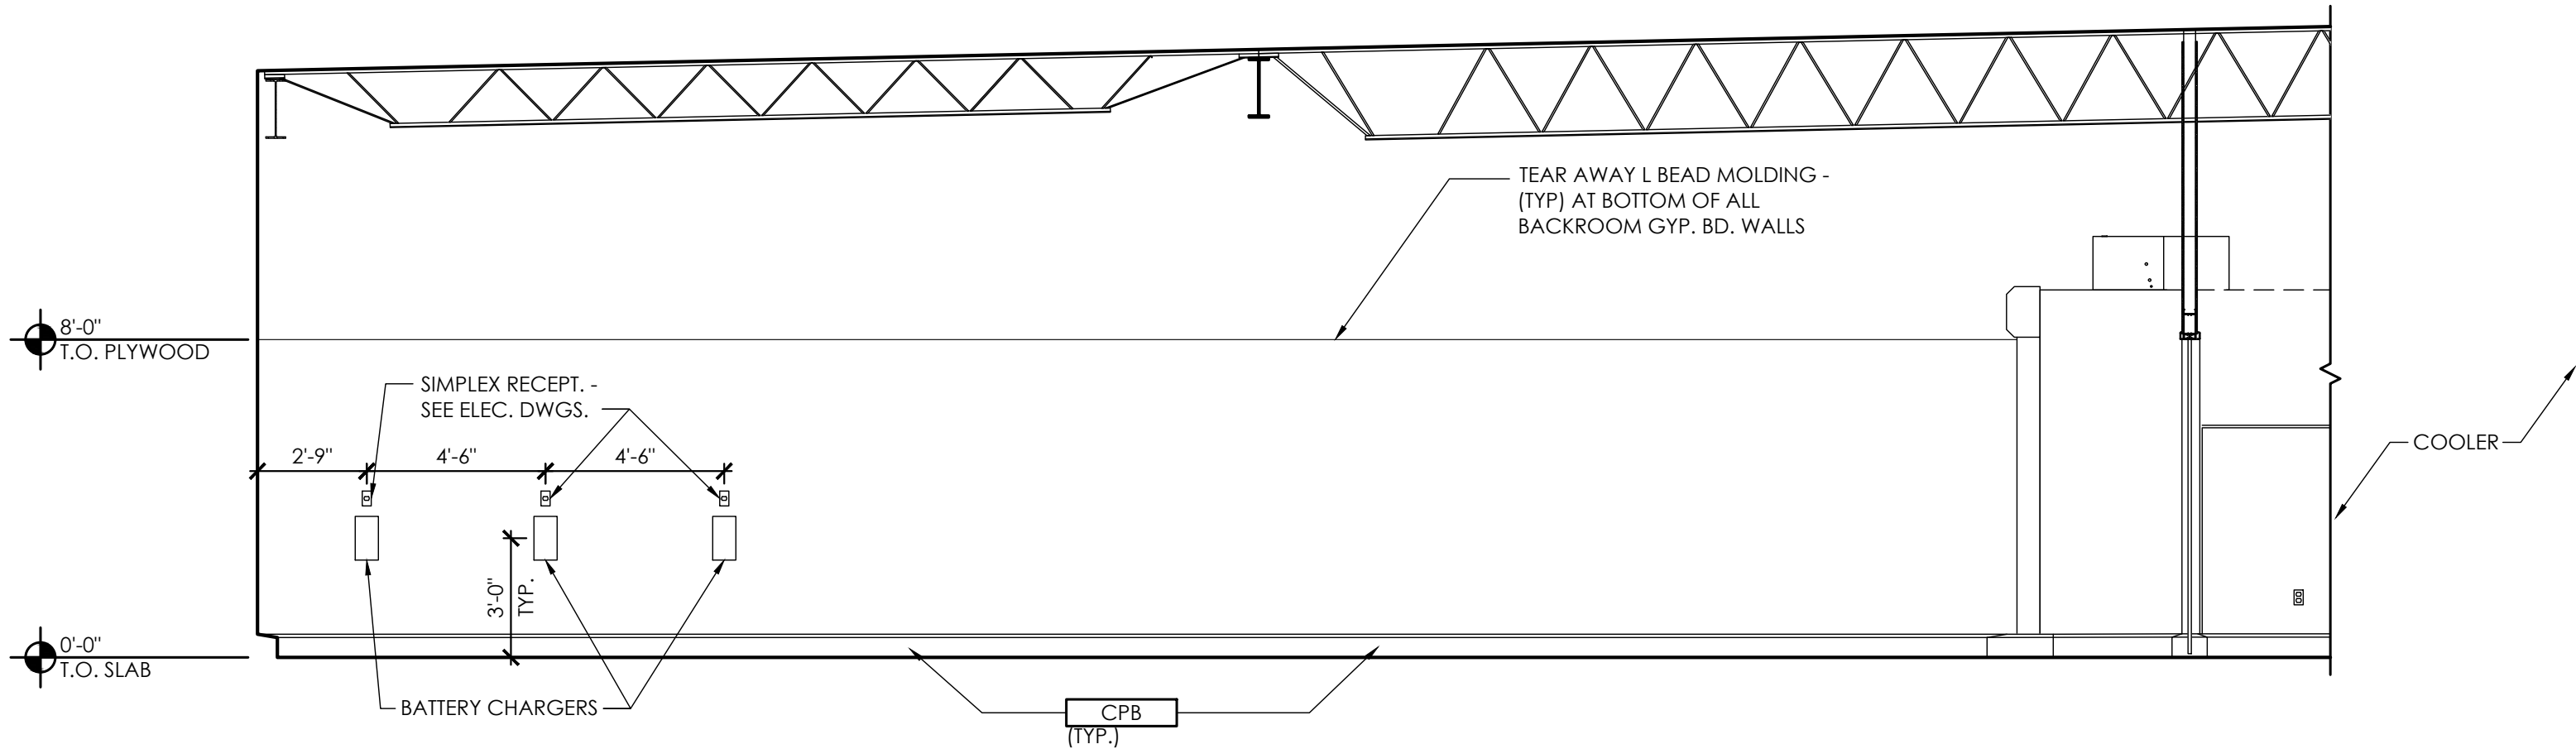


D3 Back Room #109
SCALE: 1/4" = 1'-0"

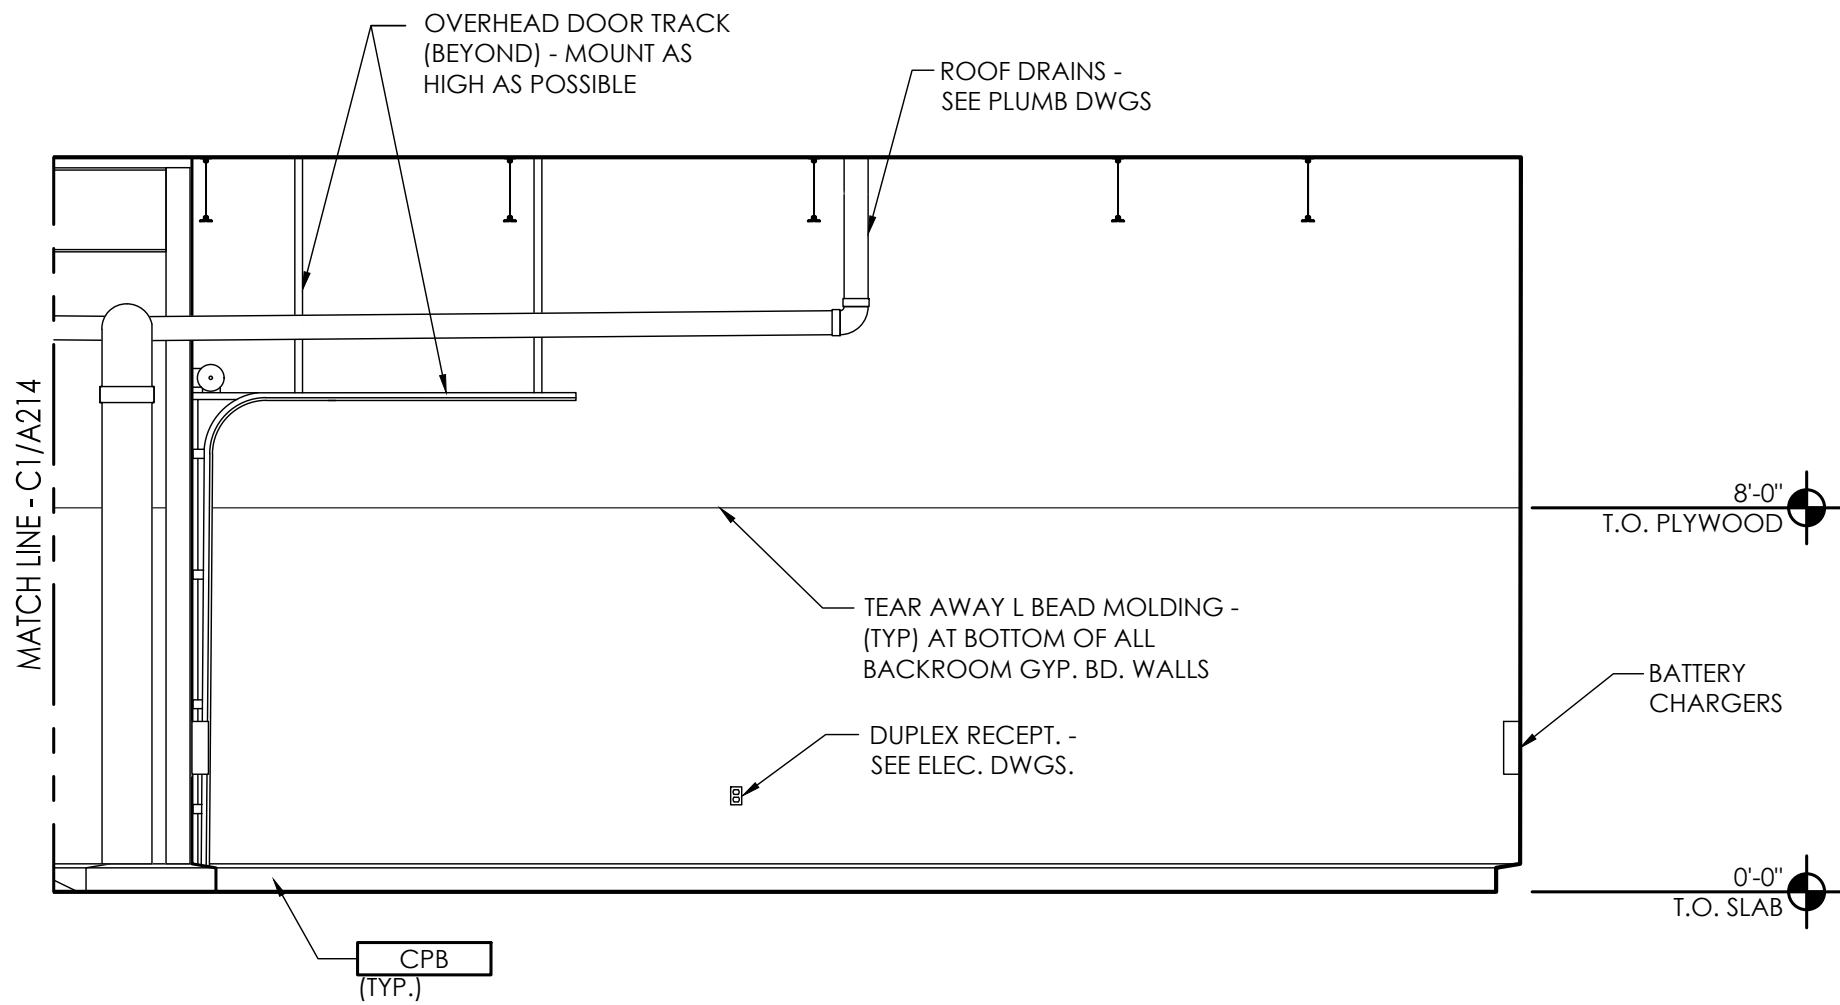

C2 Back Room #109
SCALE: 1/4" = 1'-0"

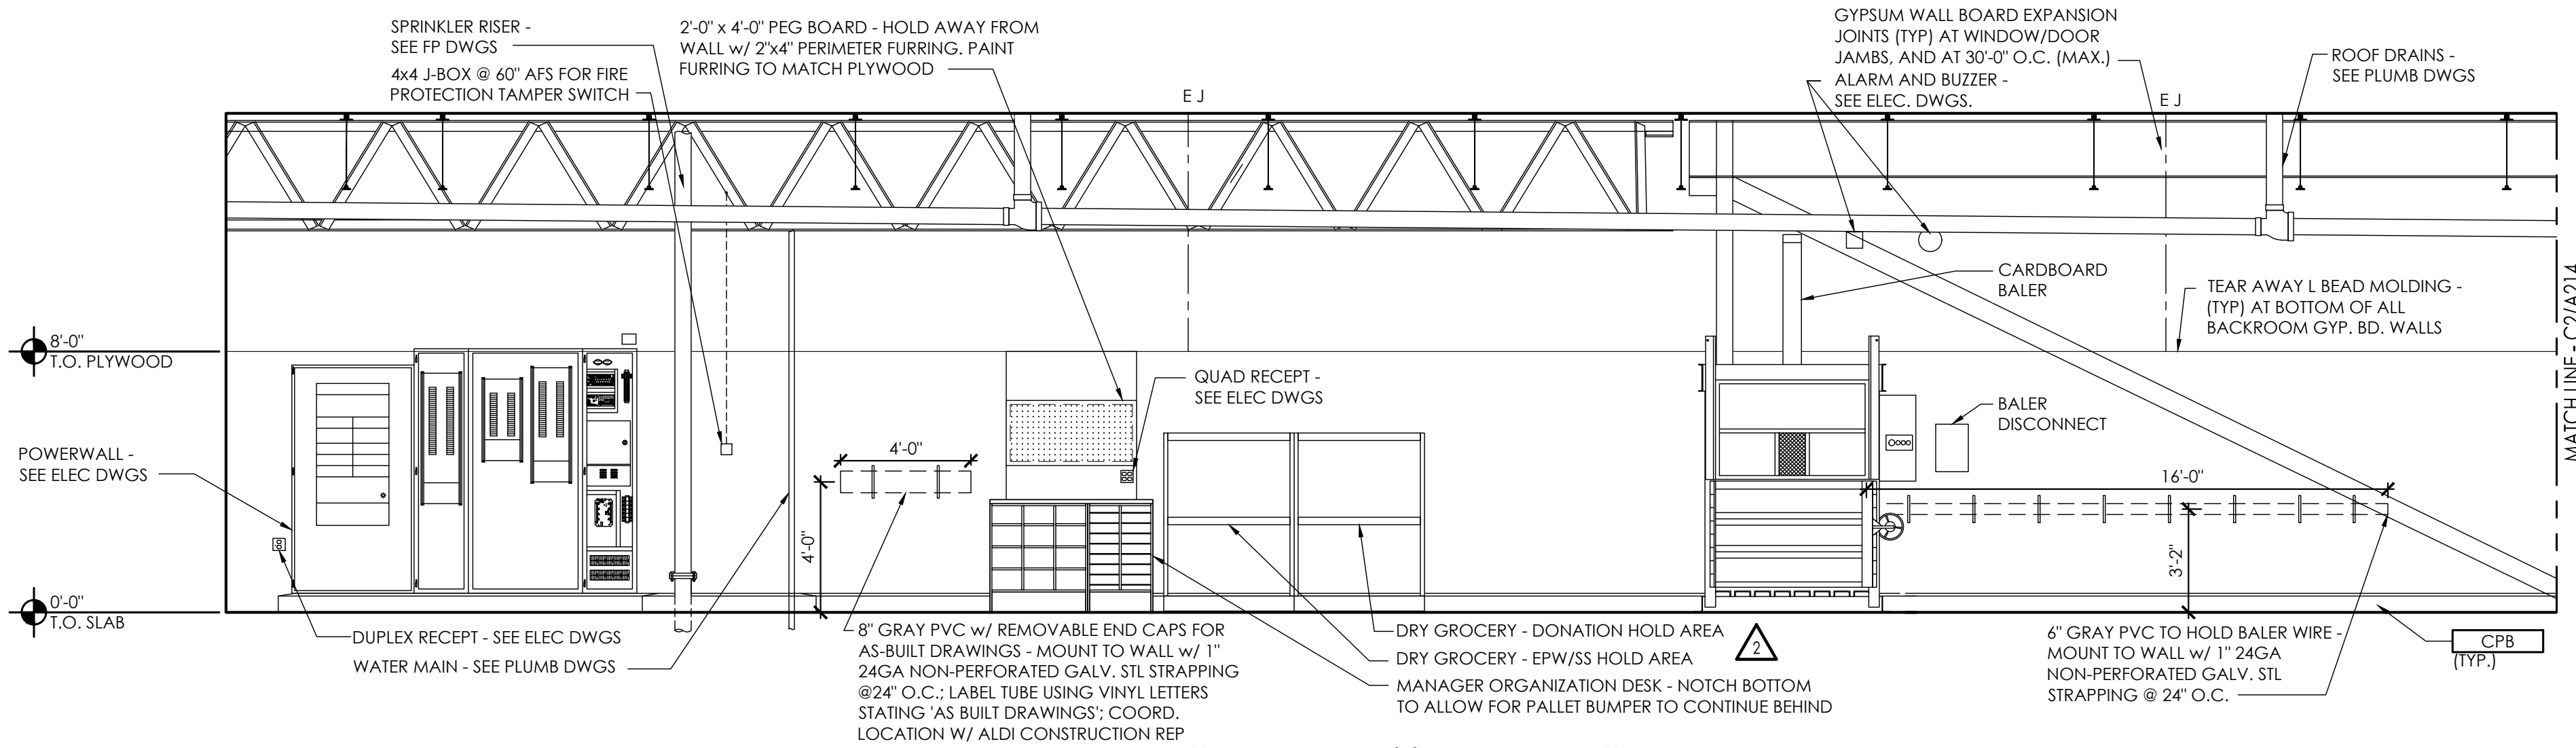


C1 Back Room #109 & Utility Area #108
SCALE: 1/4" = 1'-0"

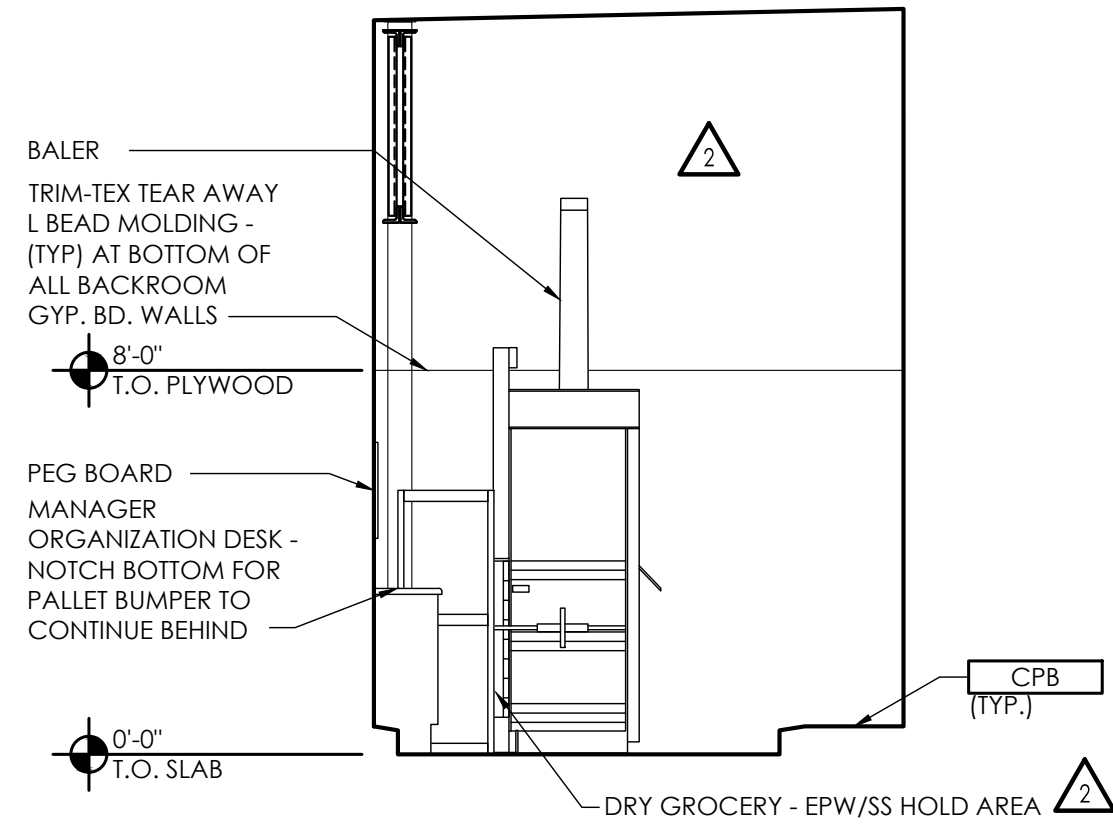


A1 Utility Area #108 & Back Room #109
SCALE: 1/4" = 1'-0"


PLOTTED: 7/29/2025 9:44 AM

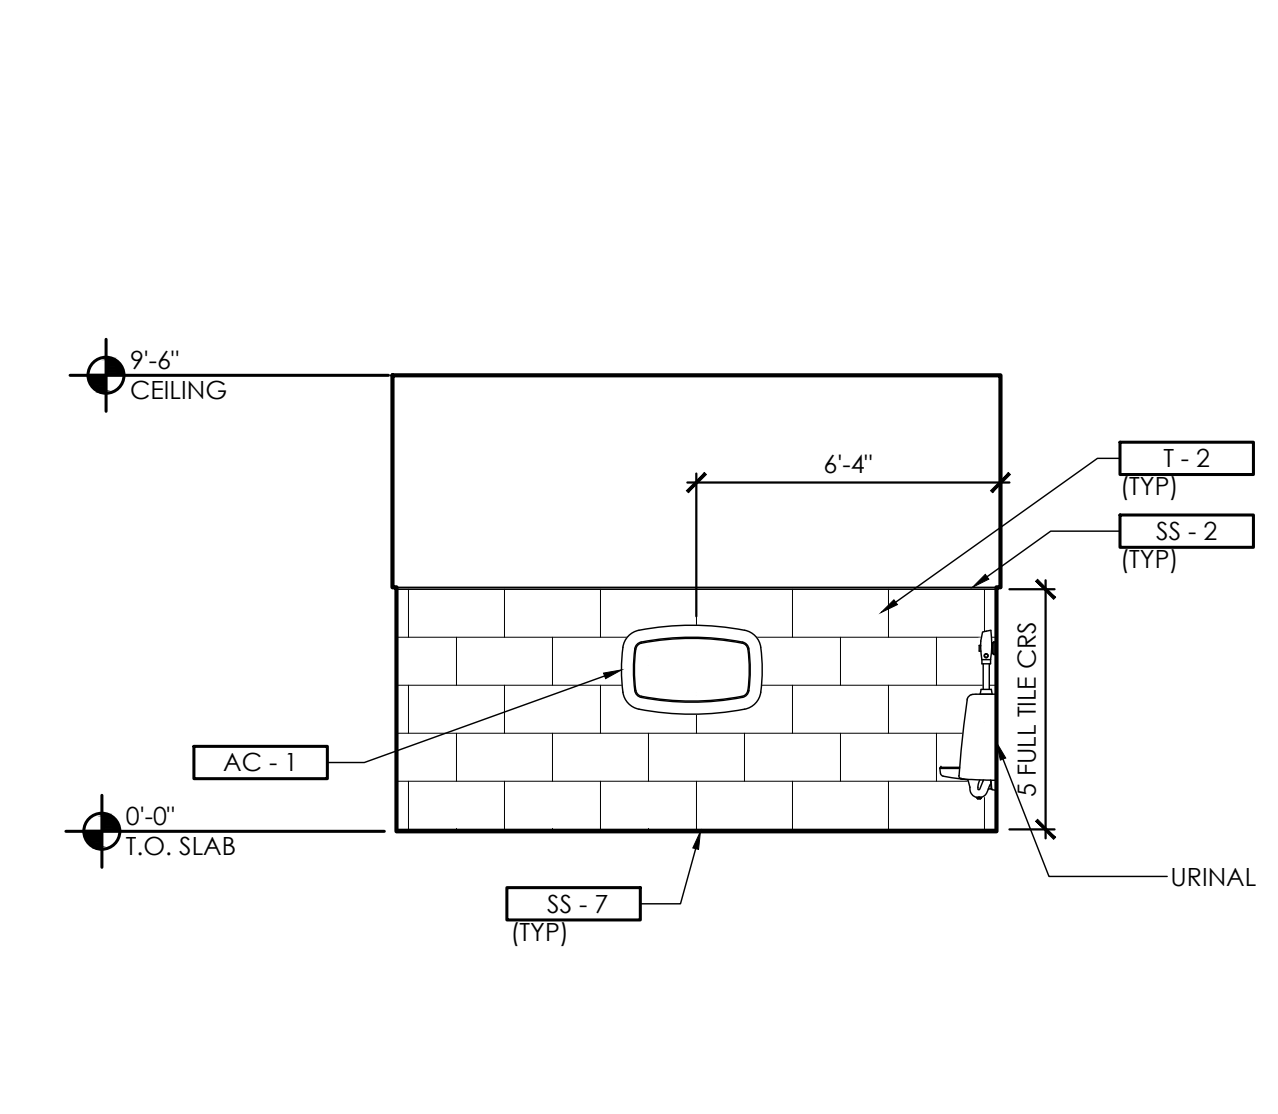


D3 Unisex 2 #105
SCALE: 1/4" = 1'-0"

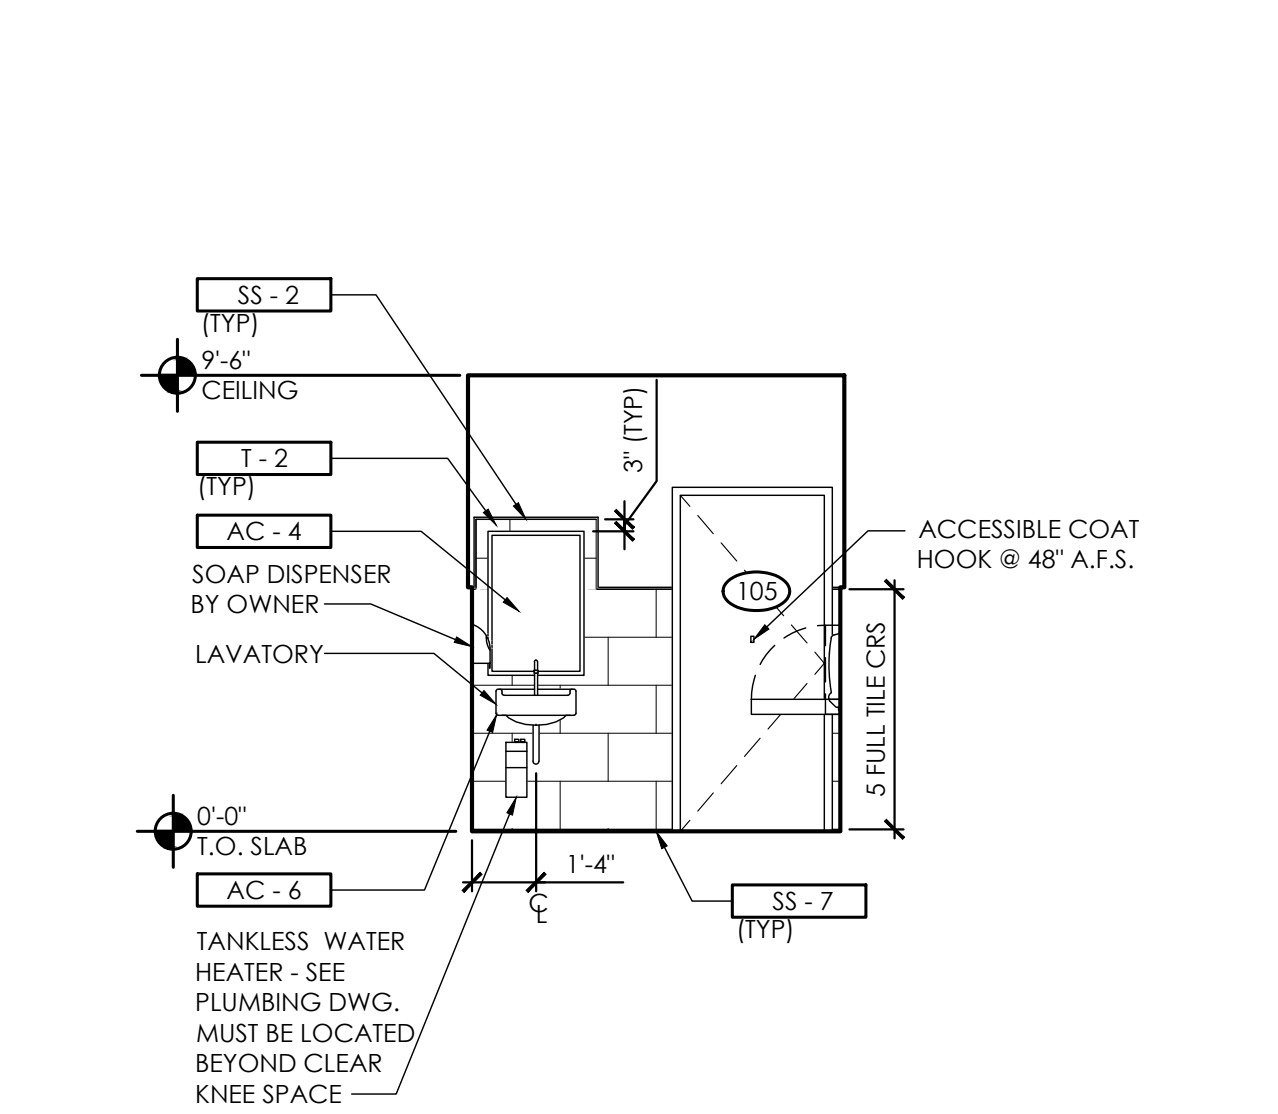


C3 Unisex 2 #105
SCALE: 1/4" = 1'-0"

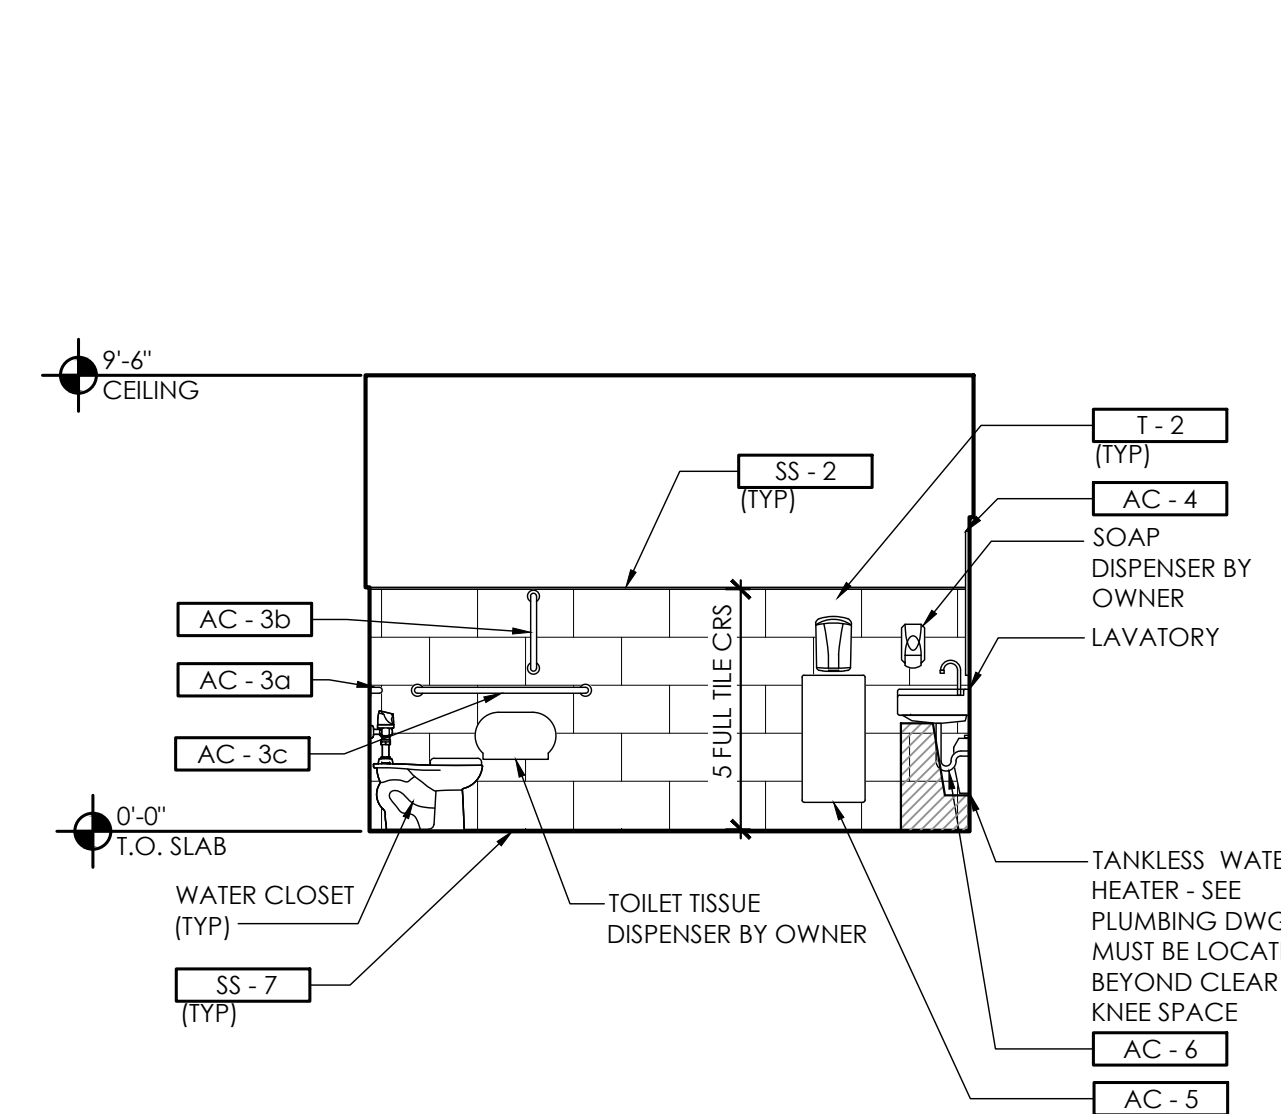


B3 Unisex 2 #105
SCALE: 1/4" = 1'-0"

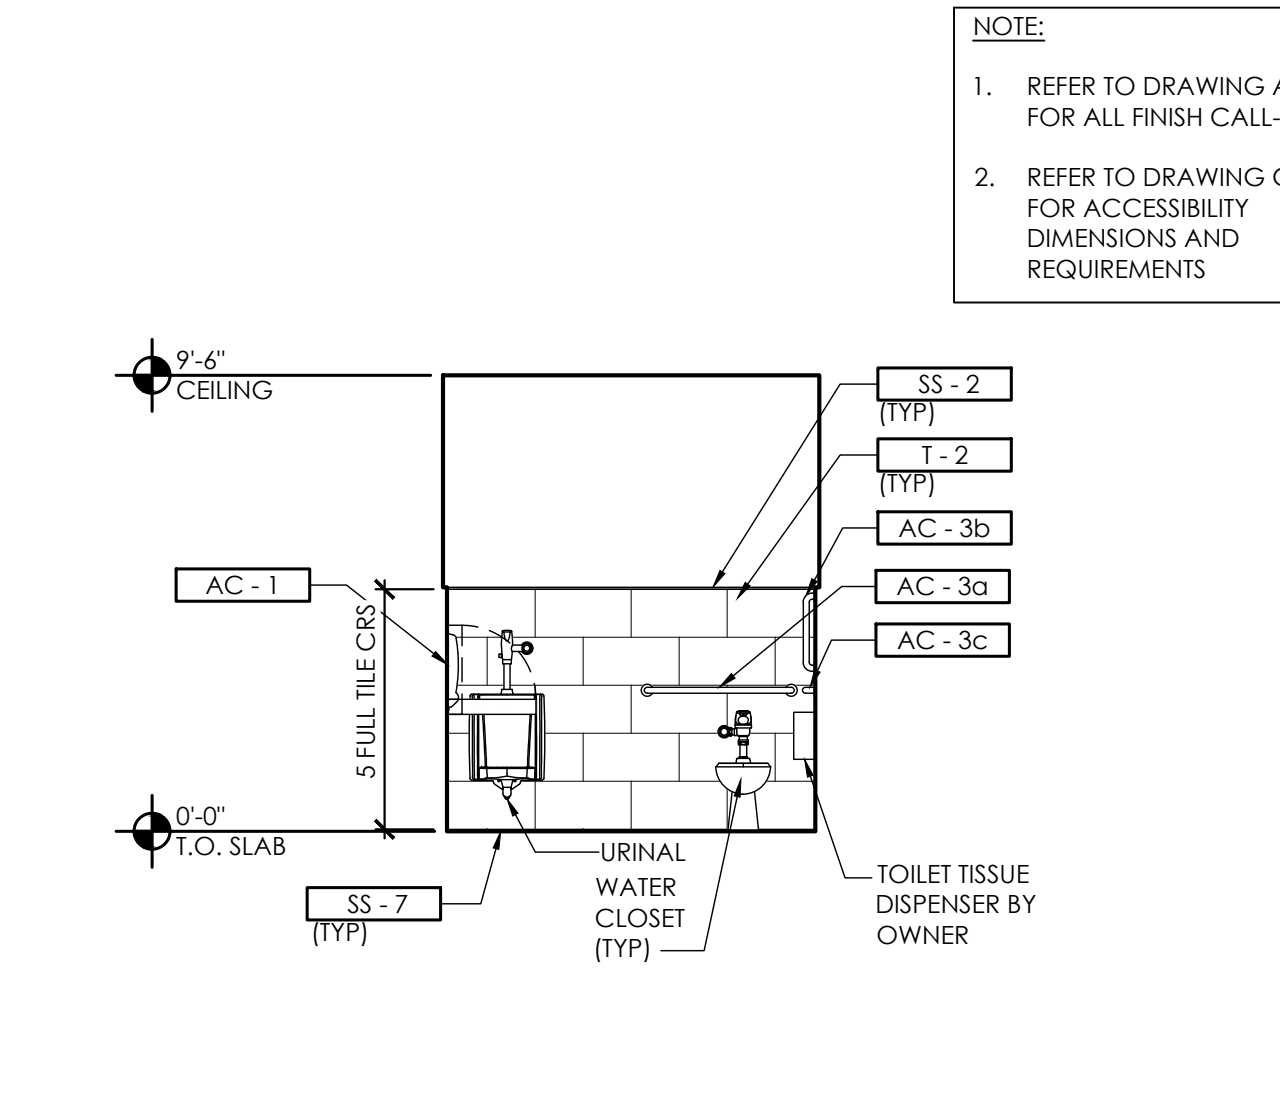


A3 Unisex 2 #105
SCALE: 1/4" = 1'-0"

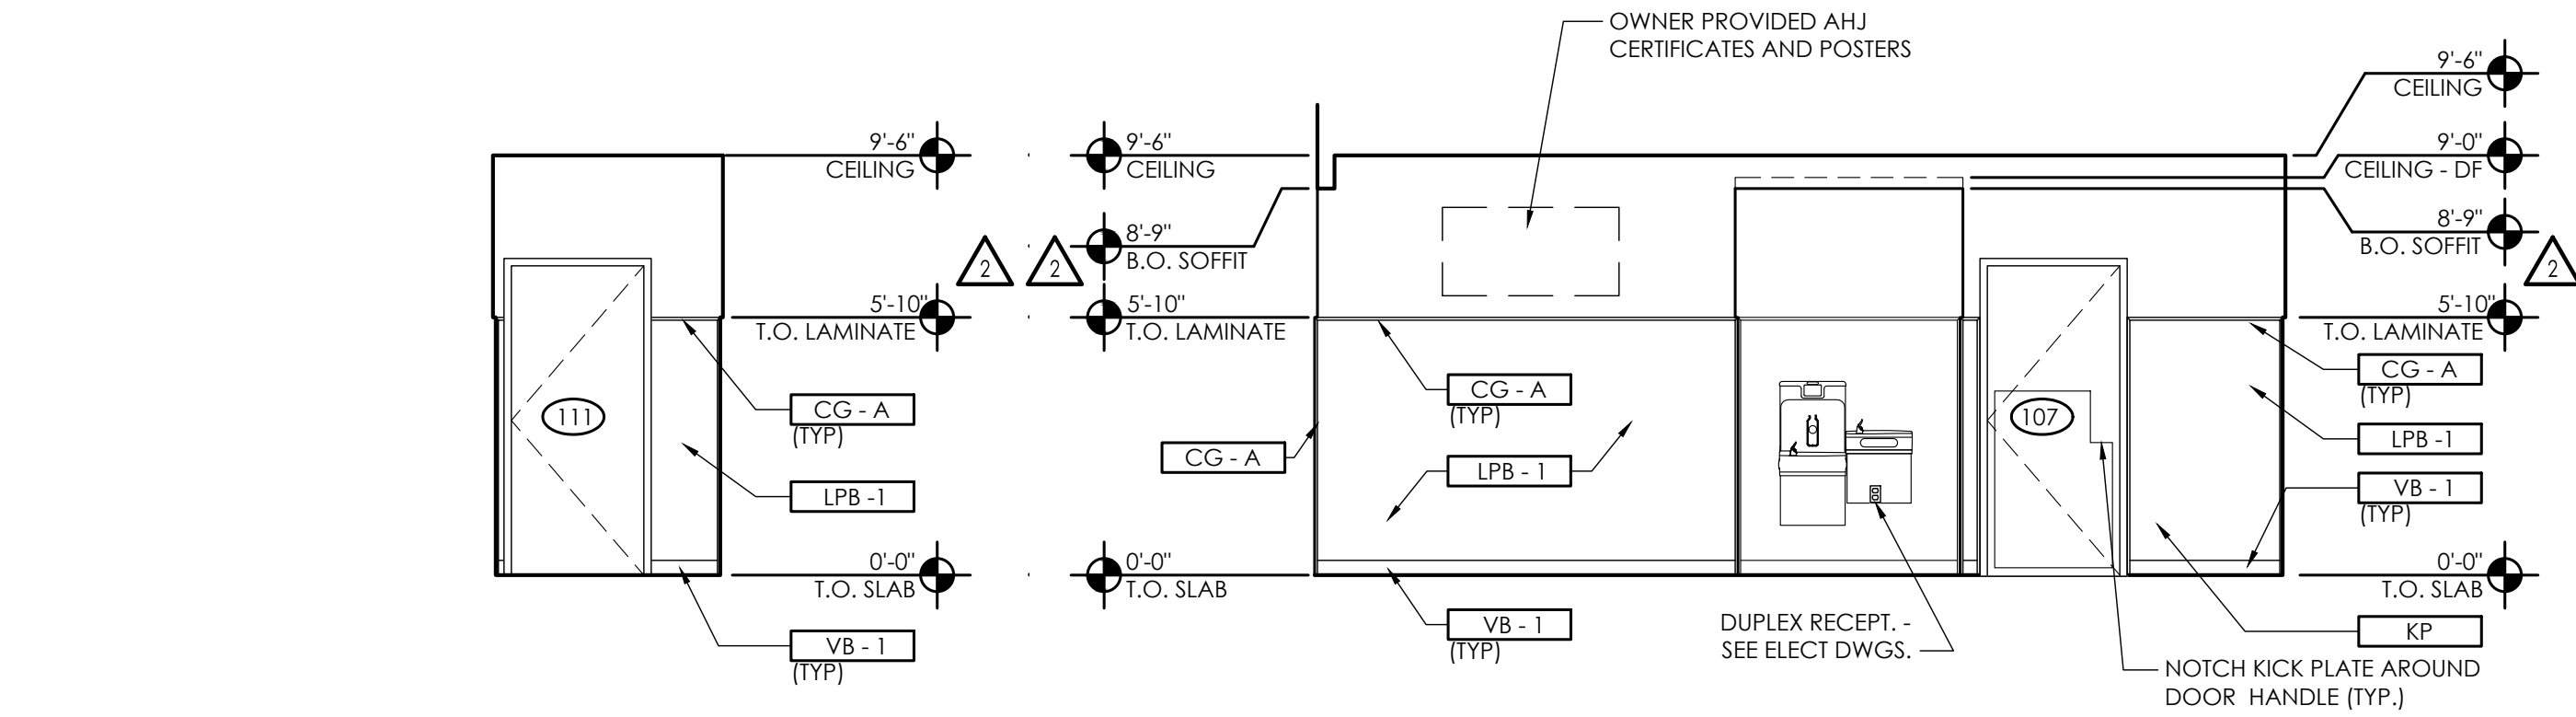


D2 Hall #104
SCALE: 1/4" = 1'-0"

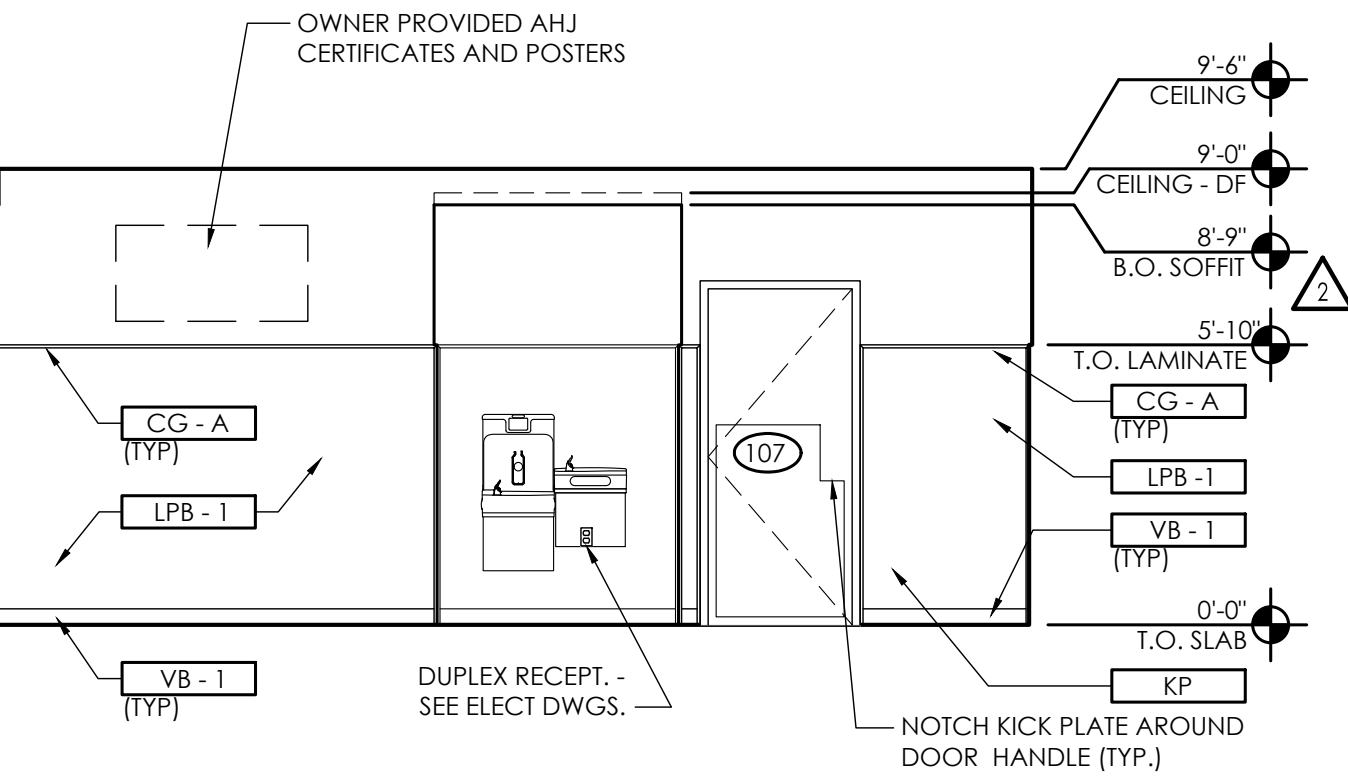


C2 Hall #104
SCALE: 1/4" = 1'-0"

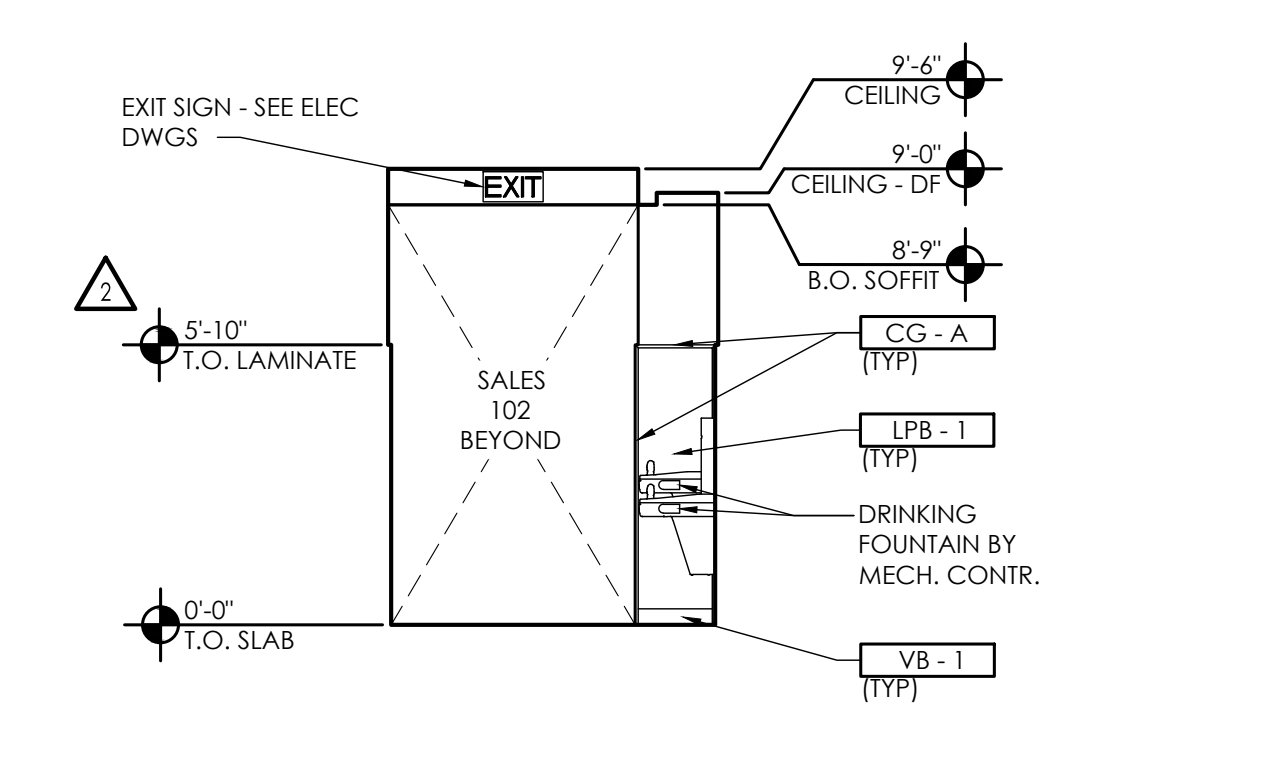


B2 Hall #104
SCALE: 1/4" = 1'-0"

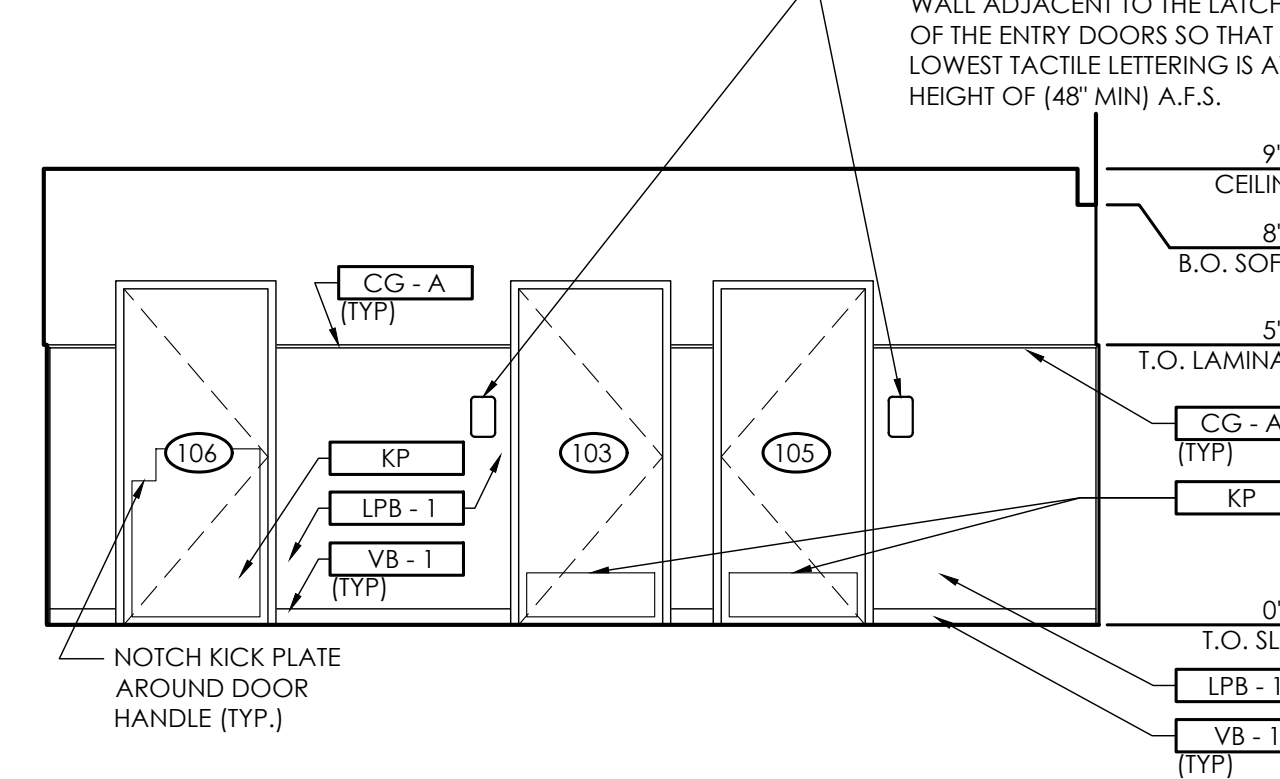


A2 Hall #104
SCALE: 1/4" = 1'-0"

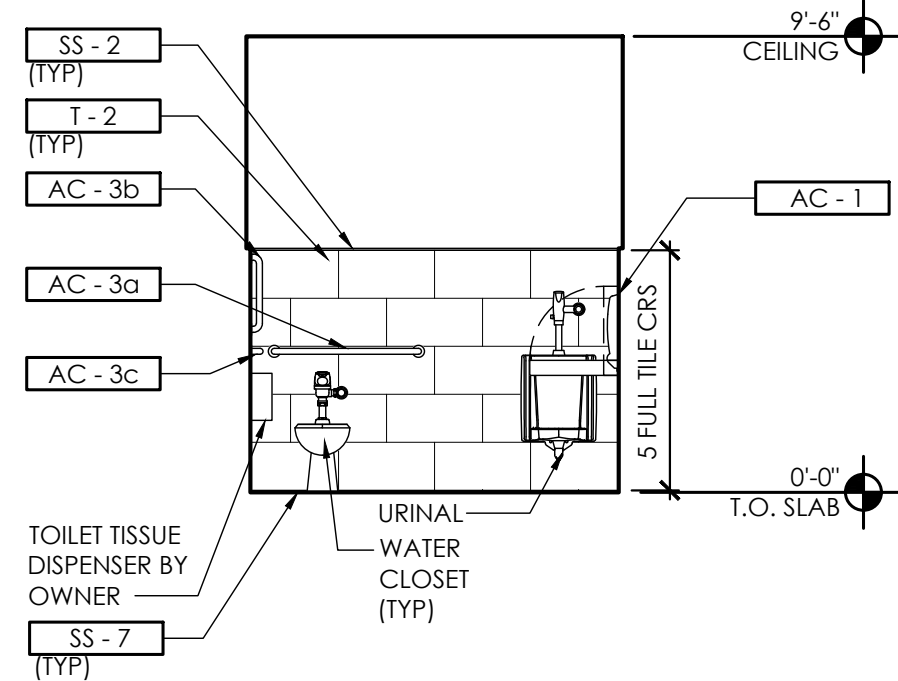


D1 Unisex 1 #103
SCALE: 1/4" = 1'-0"

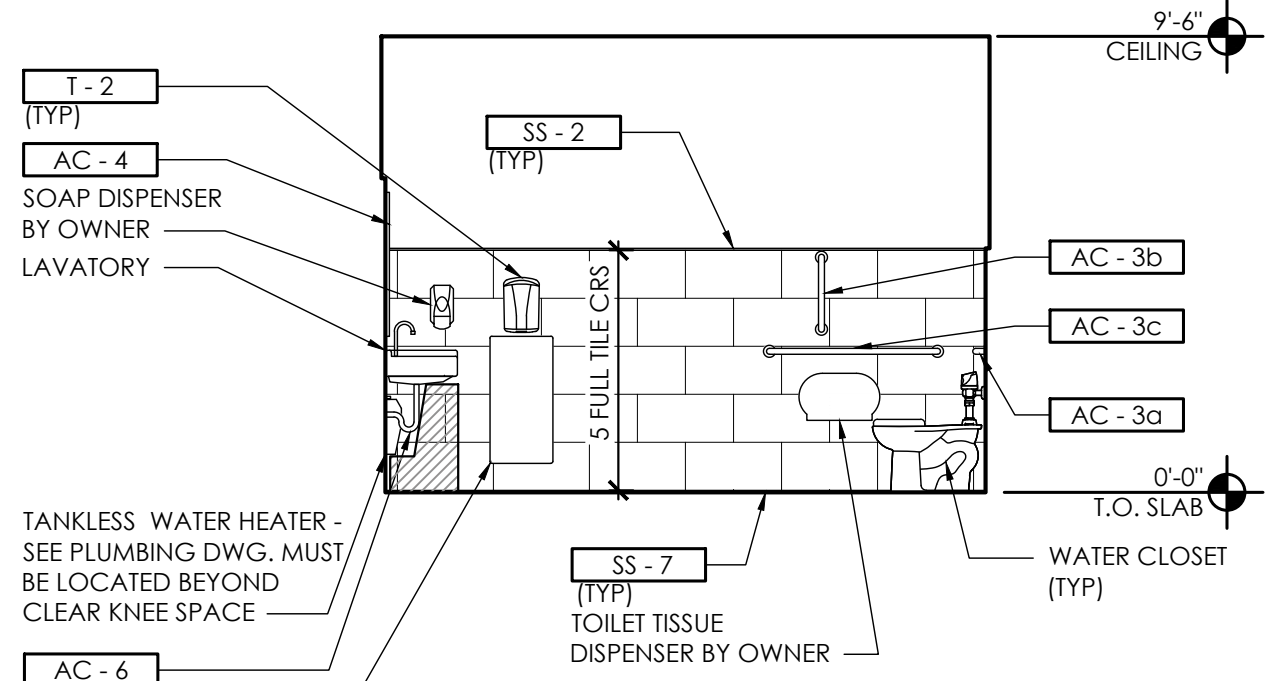

C1 Unisex 1 #103
SCALE: 1/4" = 1'-0"

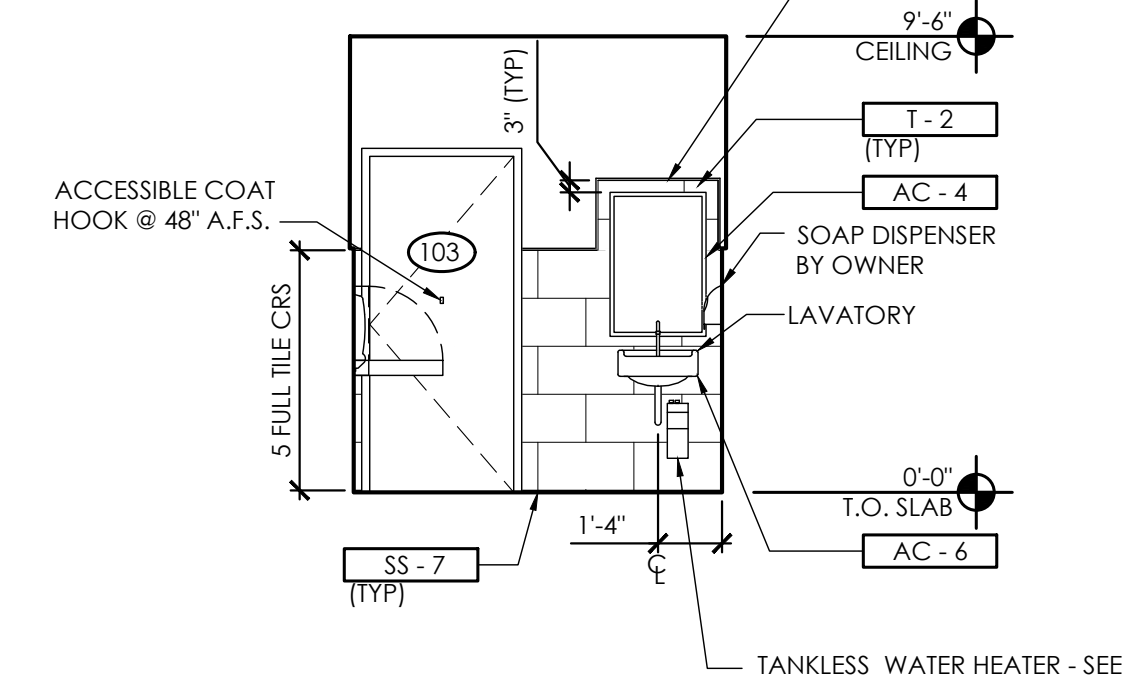

B1 Unisex 1 #103
SCALE: 1/4" = 1'-0"

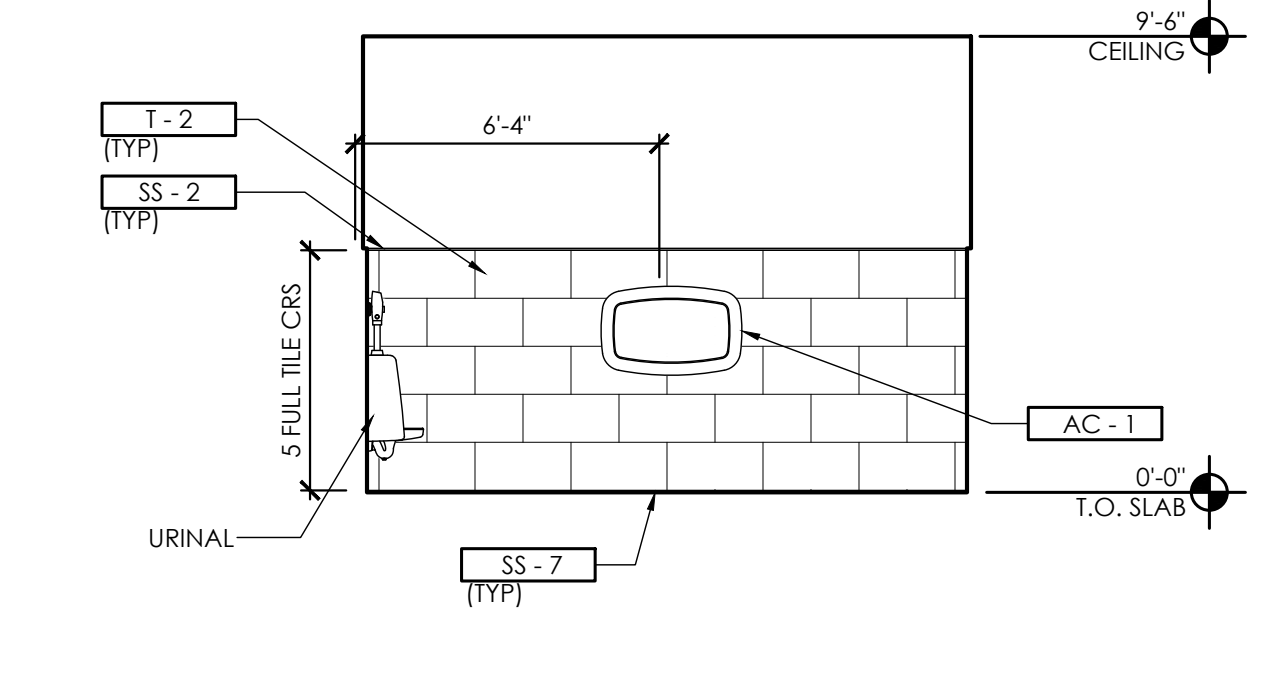

A1 Unisex 1 #103
SCALE: 1/4" = 1'-0"

NOTE:
1. REFER TO DRAWING A-603
FOR ALL FINISH CALL-OUTS
2. REFER TO DRAWING G-004
FOR ACCESSIBILITY
DIMENSIONS AND
REQUIREMENTS



Copyright © 2024
APD Engineering & Architecture
03/27/2024
Drawing Alteration
It is a violation of law for any person, unless acting under the
direction of licensed Architect, Professional Engineer, Landscape
Architect, or Land Surveyor to alter any item on this document in any
way. Any licensee who alters this document is required by law to affix
his or her seal and to add the notation "Altered By" followed by his or
her signature and the specific description of the alteration or revision.
DO NOT SCALE PLANS
Copying, Printing, Software and other processes required to produce
these prints can stretch or shrink the actual paper or layout.
Therefore, scaling of this drawing may be inaccurate. Contact APD
E&A with any need for additional dimensions or clarifications.

Issued:	Date:
A Issued for Permit	07/08/24
B Issued for Bid	07/29/25
C	
D	
E	
Revisions:	Date:
1 Owner Changes	11/18/24
2 Owner Changes	07/29/25
3	
4	
5	
6	
7	
8	
9	
10	
11	
12	
PROJECT ARCHITECT/ENGINEER	
Daniel Sargent	
PROJECT LEAD	
John Lynch	


NOT FOR
CONSTRUCTION



ALDI Inc. Store #: 50
Coconut Crossing, FL
12850 Northlake Boulevard
Palm Beach Gardens, FL 33412
Palm Beach County
Project Name & Location:

Interior Elevations	
Drawing Name:	
Prototype:	Project No.
V7.08 LHRD	22-0267A
Type:	
GROUND UP	
Drawn By:	
JWL	
Scale:	
As Noted	
A-215	
Drawing No.	

PLOTTED: 7/29/2025 9:44 AM

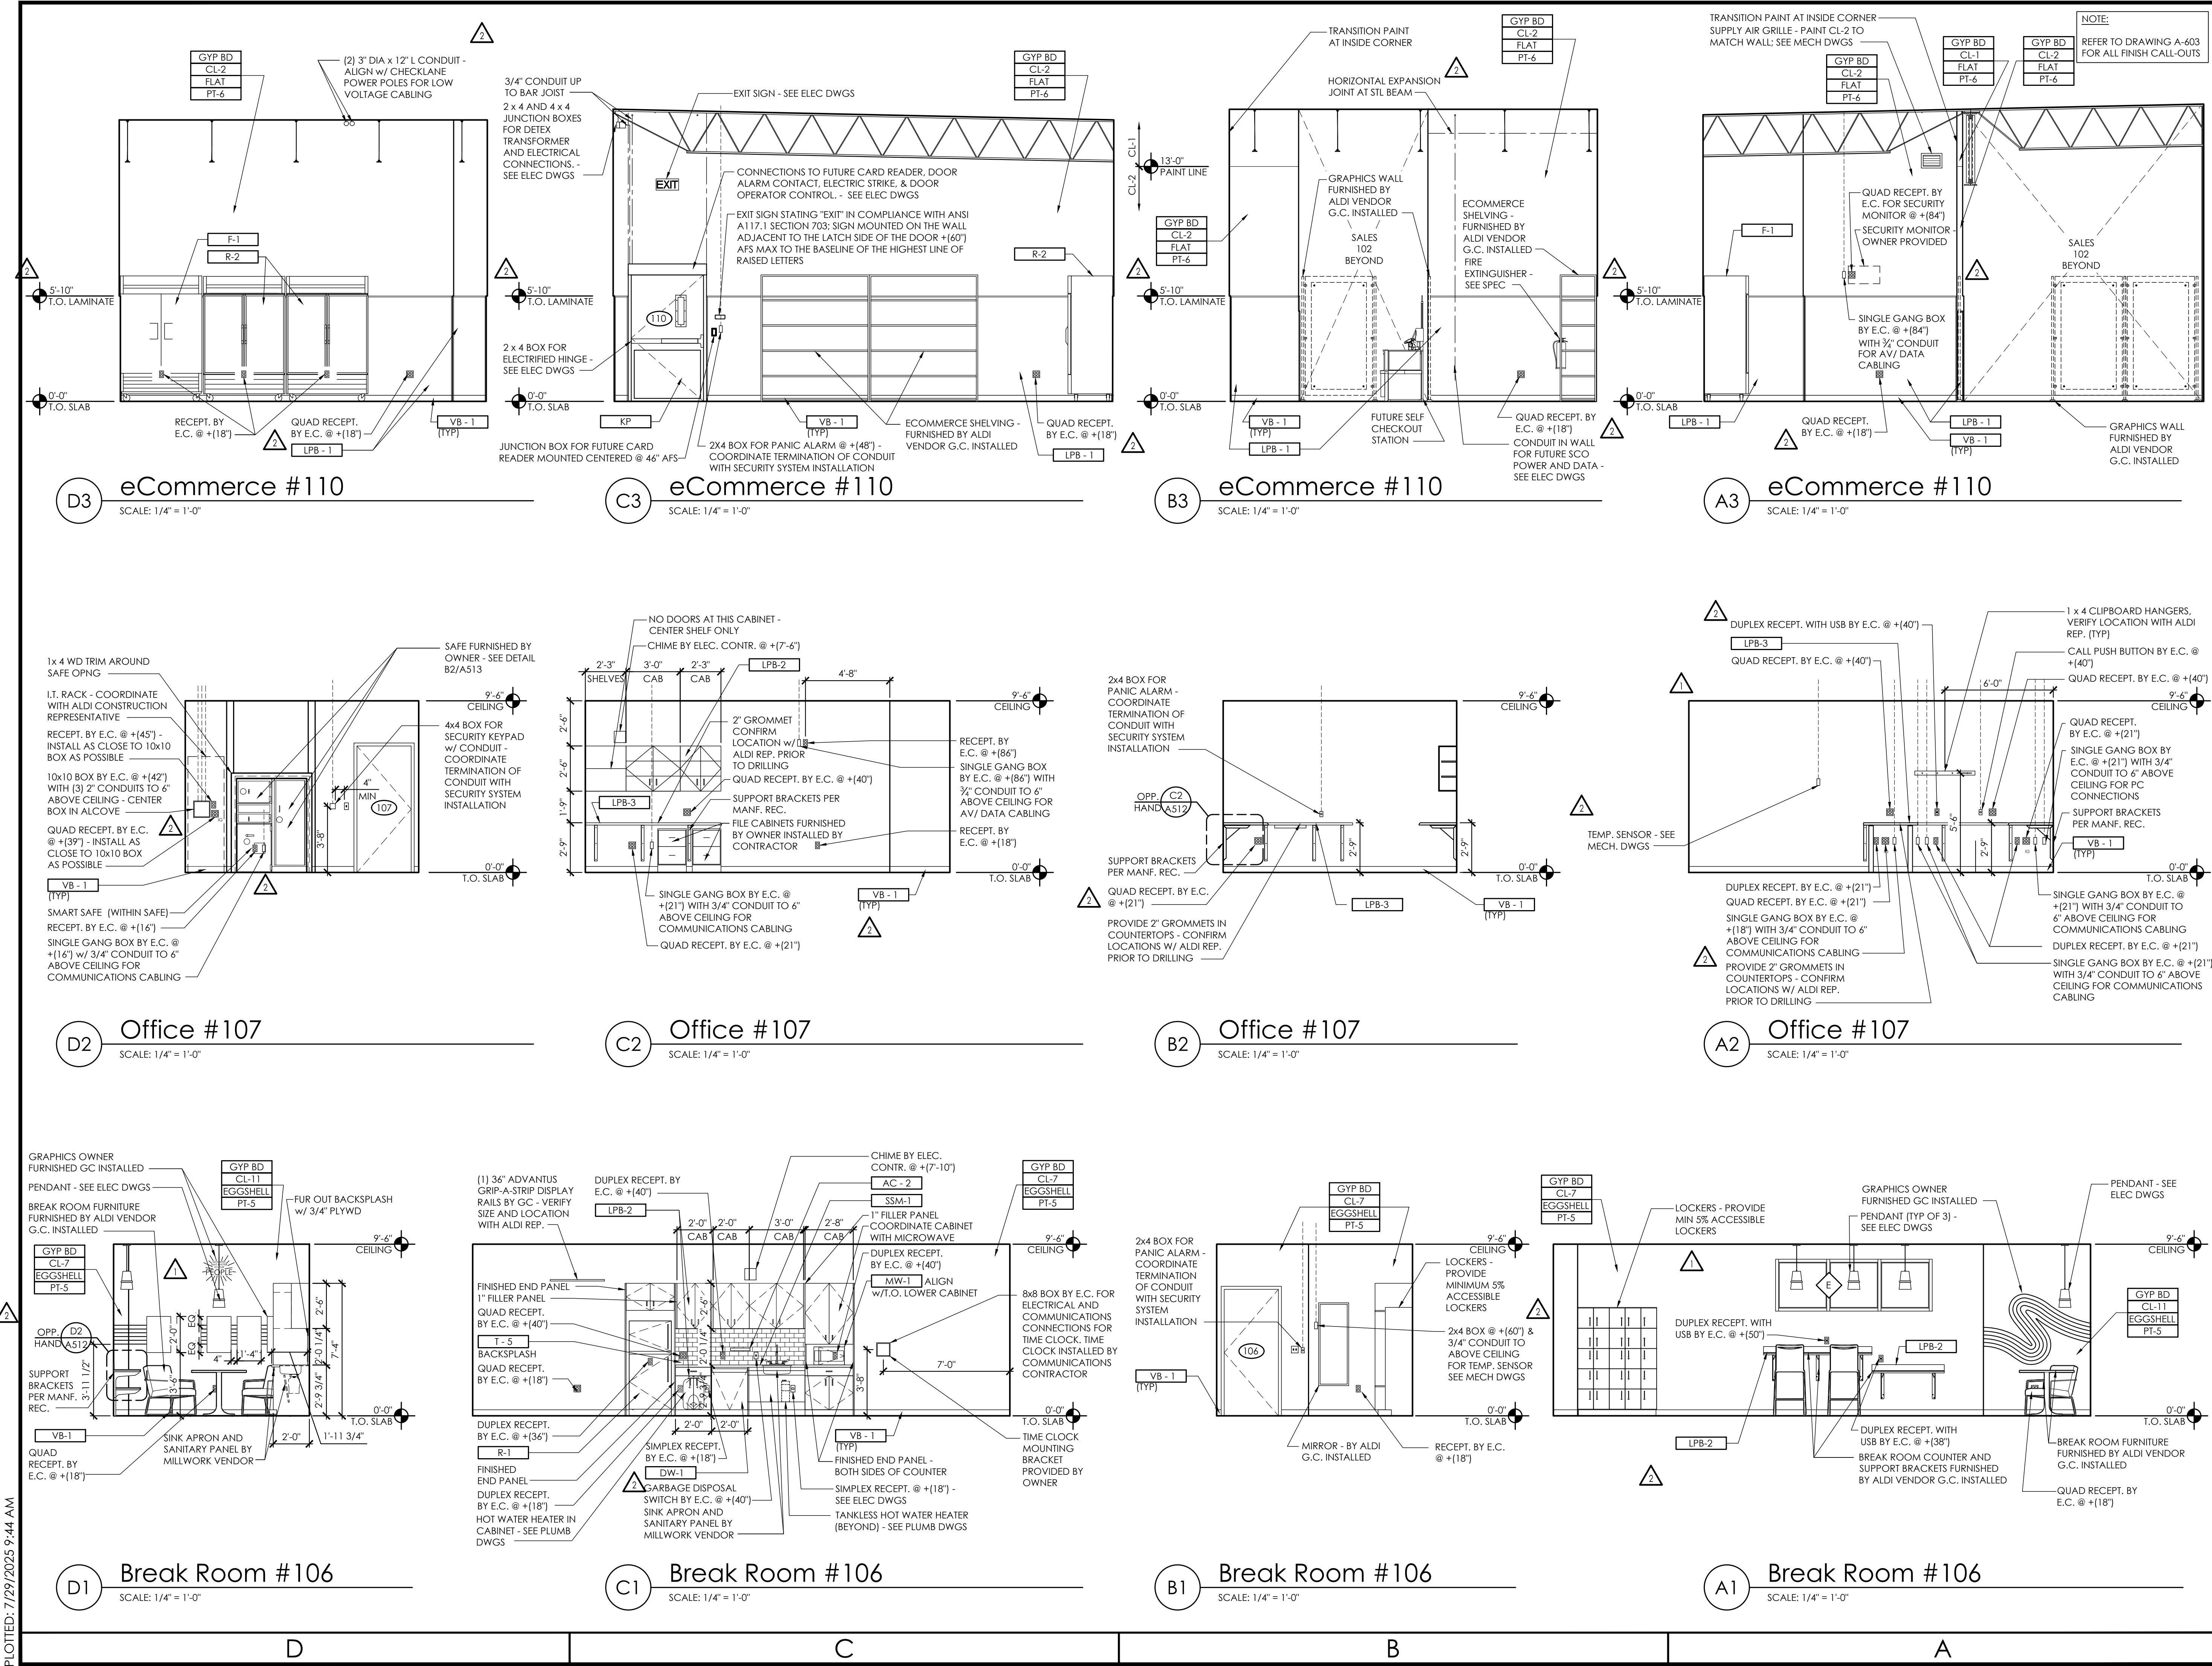

3

2

Issued: Date:

A	Issued for Permit	07/08/24
B	Issued for Bid	07/29/25
C		
D		
E		

Revisions: Date:

1	Owner Changes	11/18/24
2	Owner Changes	07/29/25
3		
4		
5		
6		
7		
8		
9		
10		
11		
12		

PROJECT ARCHITECT/ENGINEER

Daniel Sargent

PROJECT LEAD

John Lynch

**NOT FOR
CONSTRUCTION**

Seal Seal




ALDI Inc.
1171 North State Road 7
Royal Palm Beach, FL 33411
(561) 640-8000

ALDI Inc. Store #: 50
Coconut Crossing, FL
12850 Northlake Boulevard
Palm Beach Gardens, FL 33412
Palm Beach County
Project Name & Location:

**Wall
Sections**
Drawing Name:

Prototype:	Project No.
V7.08 LHRD	22-0267A
Type:	
GROUND UP	
Drawn By:	
JAH	
Scale:	
As Noted	
Drawing No.	
A-301	

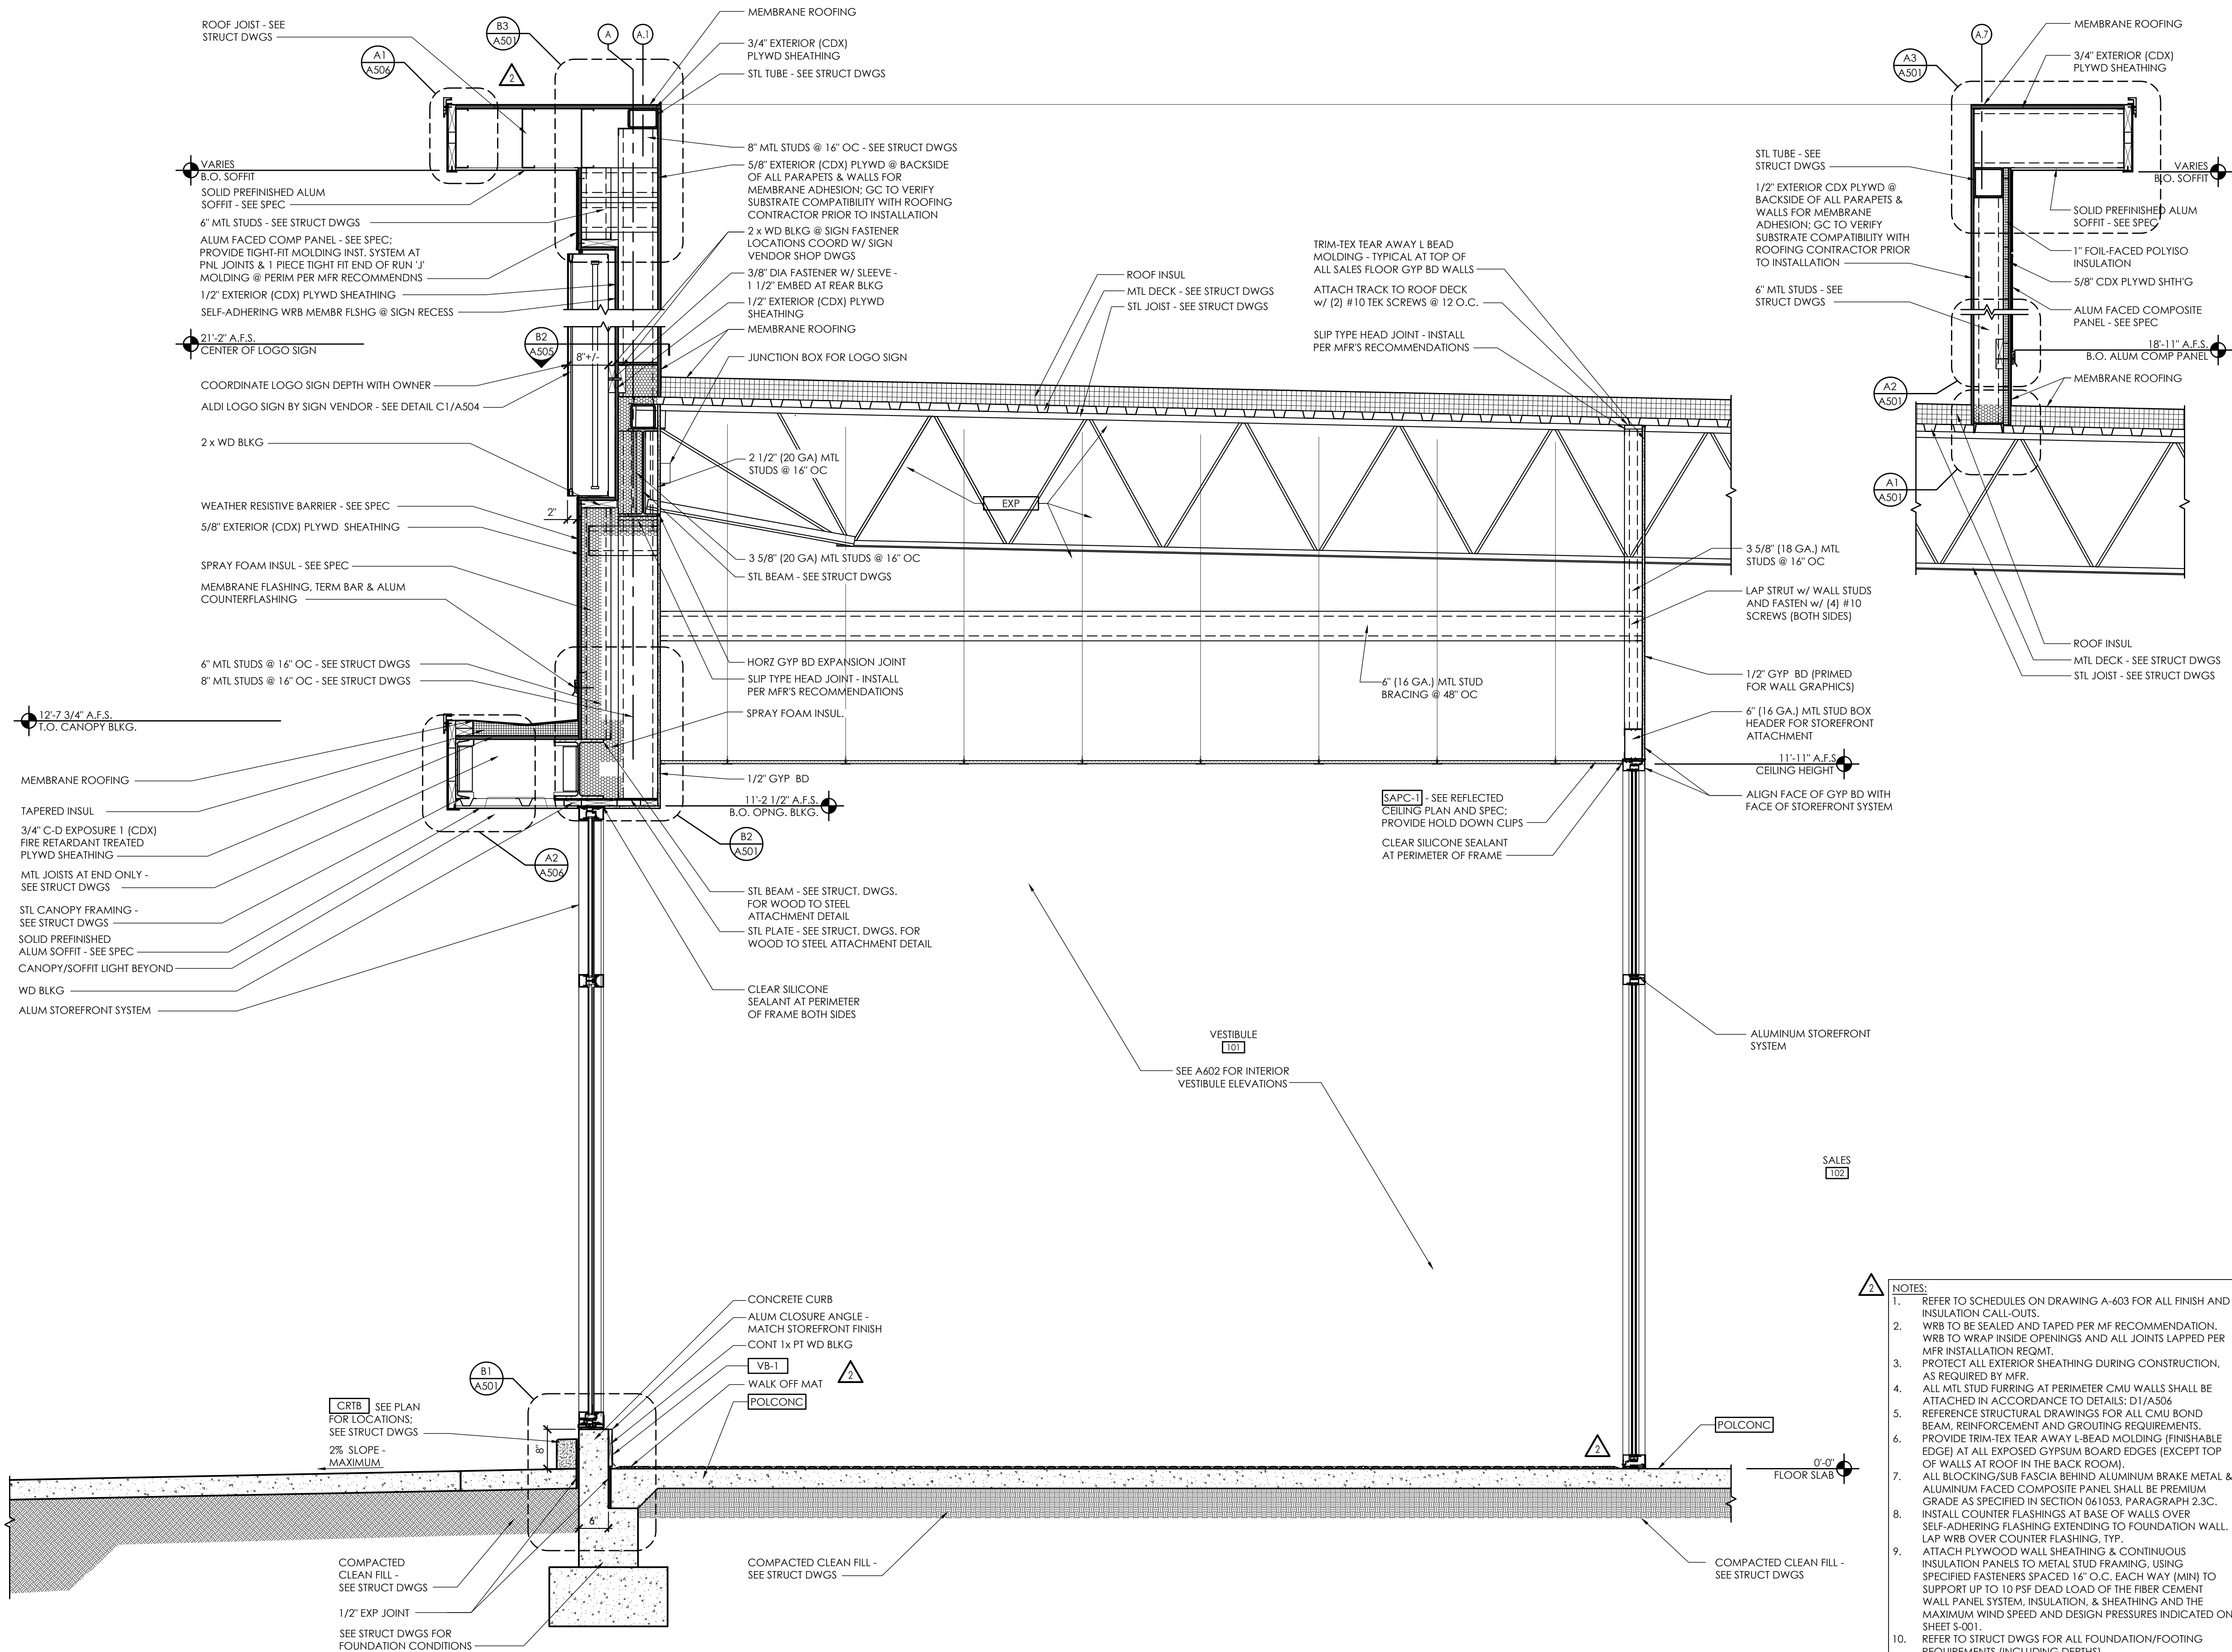


Wall Section -
Vestibule & Logo Sign (Long Wall)

SCALE: 3/4" = 1'-0"

D1

PLOTTED: 7/29/2025 9:45 AM

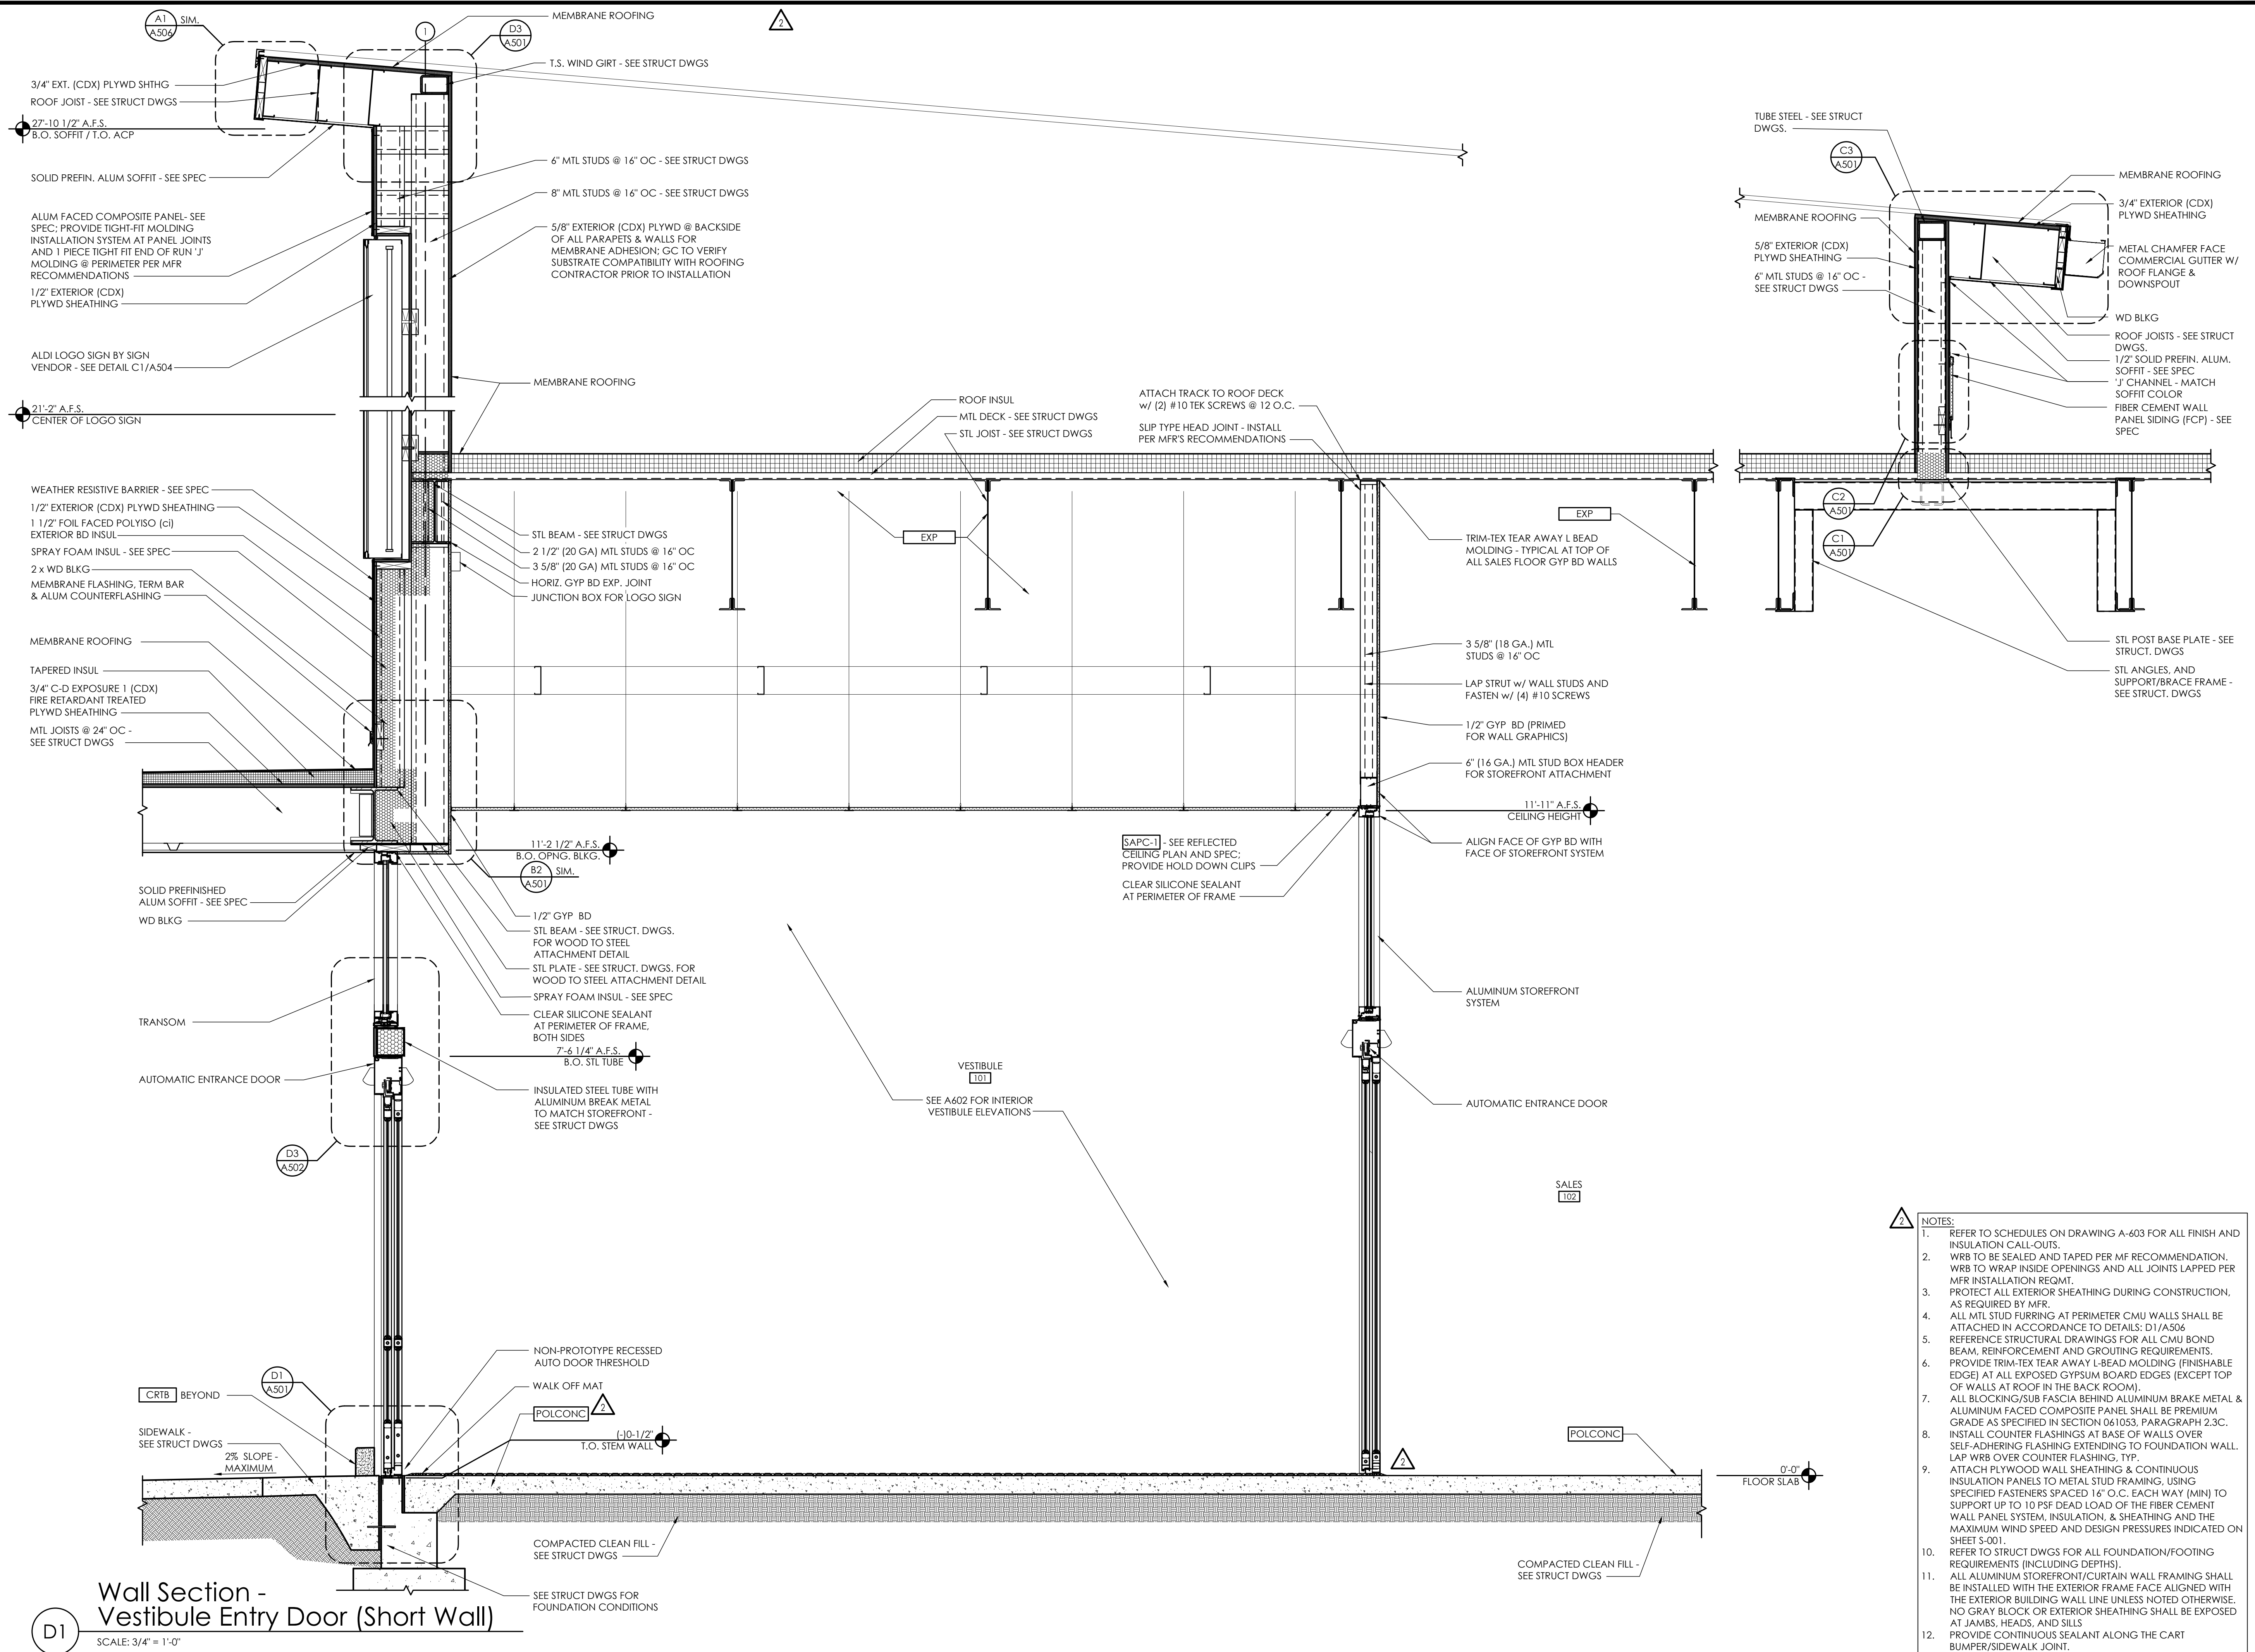

Wall Section - Vestibule Entry Door (Short Wall)

SCALE: 3/4" = 1'-0"

Copyright © 2024
APD Engineering & Architecture
03/27/2012

Drawing Alteration

It is a violation of law for any person, unless acting under the direction of licensed Architect, Professional Engineer, Landscape Architect, or Land Surveyor to alter any item on this document in any way. Any licensee who alters this document is required by law to affix his or her seal and to add the notation "Altered By" followed by his or her signature and the specific description of the alteration or revision.

DO NOT SCALE PLANS

Copying, Printing, Software and other processes required to produce these prints can stretch or shrink the actual paper or layout. Therefore, scaling of this drawing may be inaccurate. Contact APD E&A with any need for additional dimensions or clarifications.

Issued:	Date:
A Issued for Permit	07/08/24
B Issued for Bid	07/29/25
C	
D	
E	

Revisions:	Date:
1 Owner Changes	11/18/24
2 Owner Changes	07/29/25
3	
4	
5	
6	
7	
8	
9	
10	
11	
12	

PROJECT ARCHITECT/ENGINEER

Daniel Sargent

PROJECT LEAD

John Lynch

**NOT FOR
CONSTRUCTION**


Seal Seal



ALDI Inc. Store #: 50
Coconut Crossing, FL
12850 Northlake Boulevard
Palm Beach Gardens, FL 33412
Palm Beach County
Project Name & Location:

Wall Sections	Drawing Name:
Prototype:	Project No.
V7.08 LHRD	22-0267A
Type:	
GROUND UP	
Drawn By:	
JAH	
Scale:	
As Noted	

- NOTES:
- REFER TO SCHEDULES ON DRAWING A-603 FOR ALL FINISH AND INSULATION CALL-OUTS.
 - WRB TO BE SEALED AND TAPED PER MFR RECOMMENDATION. WRB TO WRAP INSIDE OPENINGS AND ALL JOINTS LAPPED PER MFR INSTALLATION REQMT.
 - PROTECT ALL EXTERIOR SHEATHING DURING CONSTRUCTION, AS REQUIRED BY MFR.
 - ALL MTL STUD FURRING AT PERIMETER CMU WALLS SHALL BE ATTACHED IN ACCORDANCE TO DETAILS: D1/A506
 - REFERENCE STRUCTURAL DRAWINGS FOR ALL CMU BOND BEAM, REINFORCEMENT AND GROUTING REQUIREMENTS. PROVIDE TRIM-TEX TEAR AWAY L-BEAD MOLDING (FINISHABLE EDGE) AT ALL EXPOSED GYPSUM BOARD EDGES (EXCEPT TOP OF WALLS AT ROOF IN THE BACK ROOM).
 - ALL BLOCKING/SUB FASCIA BEHIND ALUMINUM BRAKE METAL & ALUMINUM FACED COMPOSITE PANEL SHALL BE PREMIUM GRADE AS SPECIFIED IN SECTION 061053, PARAGRAPH 2.3C.
 - INSTALL COUNTER FLASHINGS AT BASE OF WALLS OVER SELF-ADHERING FLASHING EXTENDING TO FOUNDATION WALL. LAP WRB OVER COUNTER FLASHING, TYP.
 - ATTACH PLYWOOD WALL SHEATHING & CONTINUOUS INSULATION PANELS TO METAL STUD FRAMING, USING SPECIFIED FASTENERS SPACED 16" O.C. EACH WAY (MIN) TO SUPPORT UP TO 10 PSF DEAD LOAD OF THE FIBER CEMENT WALL PANEL SYSTEM, INSULATION, & SHEATHING AND THE MAXIMUM WIND SPEED AND DESIGN PRESSURES INDICATED ON SHEET S-001.
 - REFER TO STRUCT DWGS FOR ALL FOUNDATION/FOOTING REQUIREMENTS (INCLUDING DEPTHS).
 - ALL ALUMINUM STOREFRONT/CURTAIN WALL FRAMING SHALL BE INSTALLED WITH THE EXTERIOR FRAME FACE ALIGNED WITH THE EXTERIOR BUILDING WALL LINE UNLESS NOTED OTHERWISE. NO GRAY BLOCK OR EXTERIOR SHEATHING SHALL BE EXPOSED AT JAMBS, HEADS, AND SILLS.
 - PROVIDE CONTINUOUS SEALANT ALONG THE CART BUMPER/SIDEWALK JOINT.
 - PROVIDE BOND BREAKER BETWEEN DISSIMILAR METALS.
 - REFER TO RESPONSIBILITY SCHEDULES FOR ROOF SCOPE.

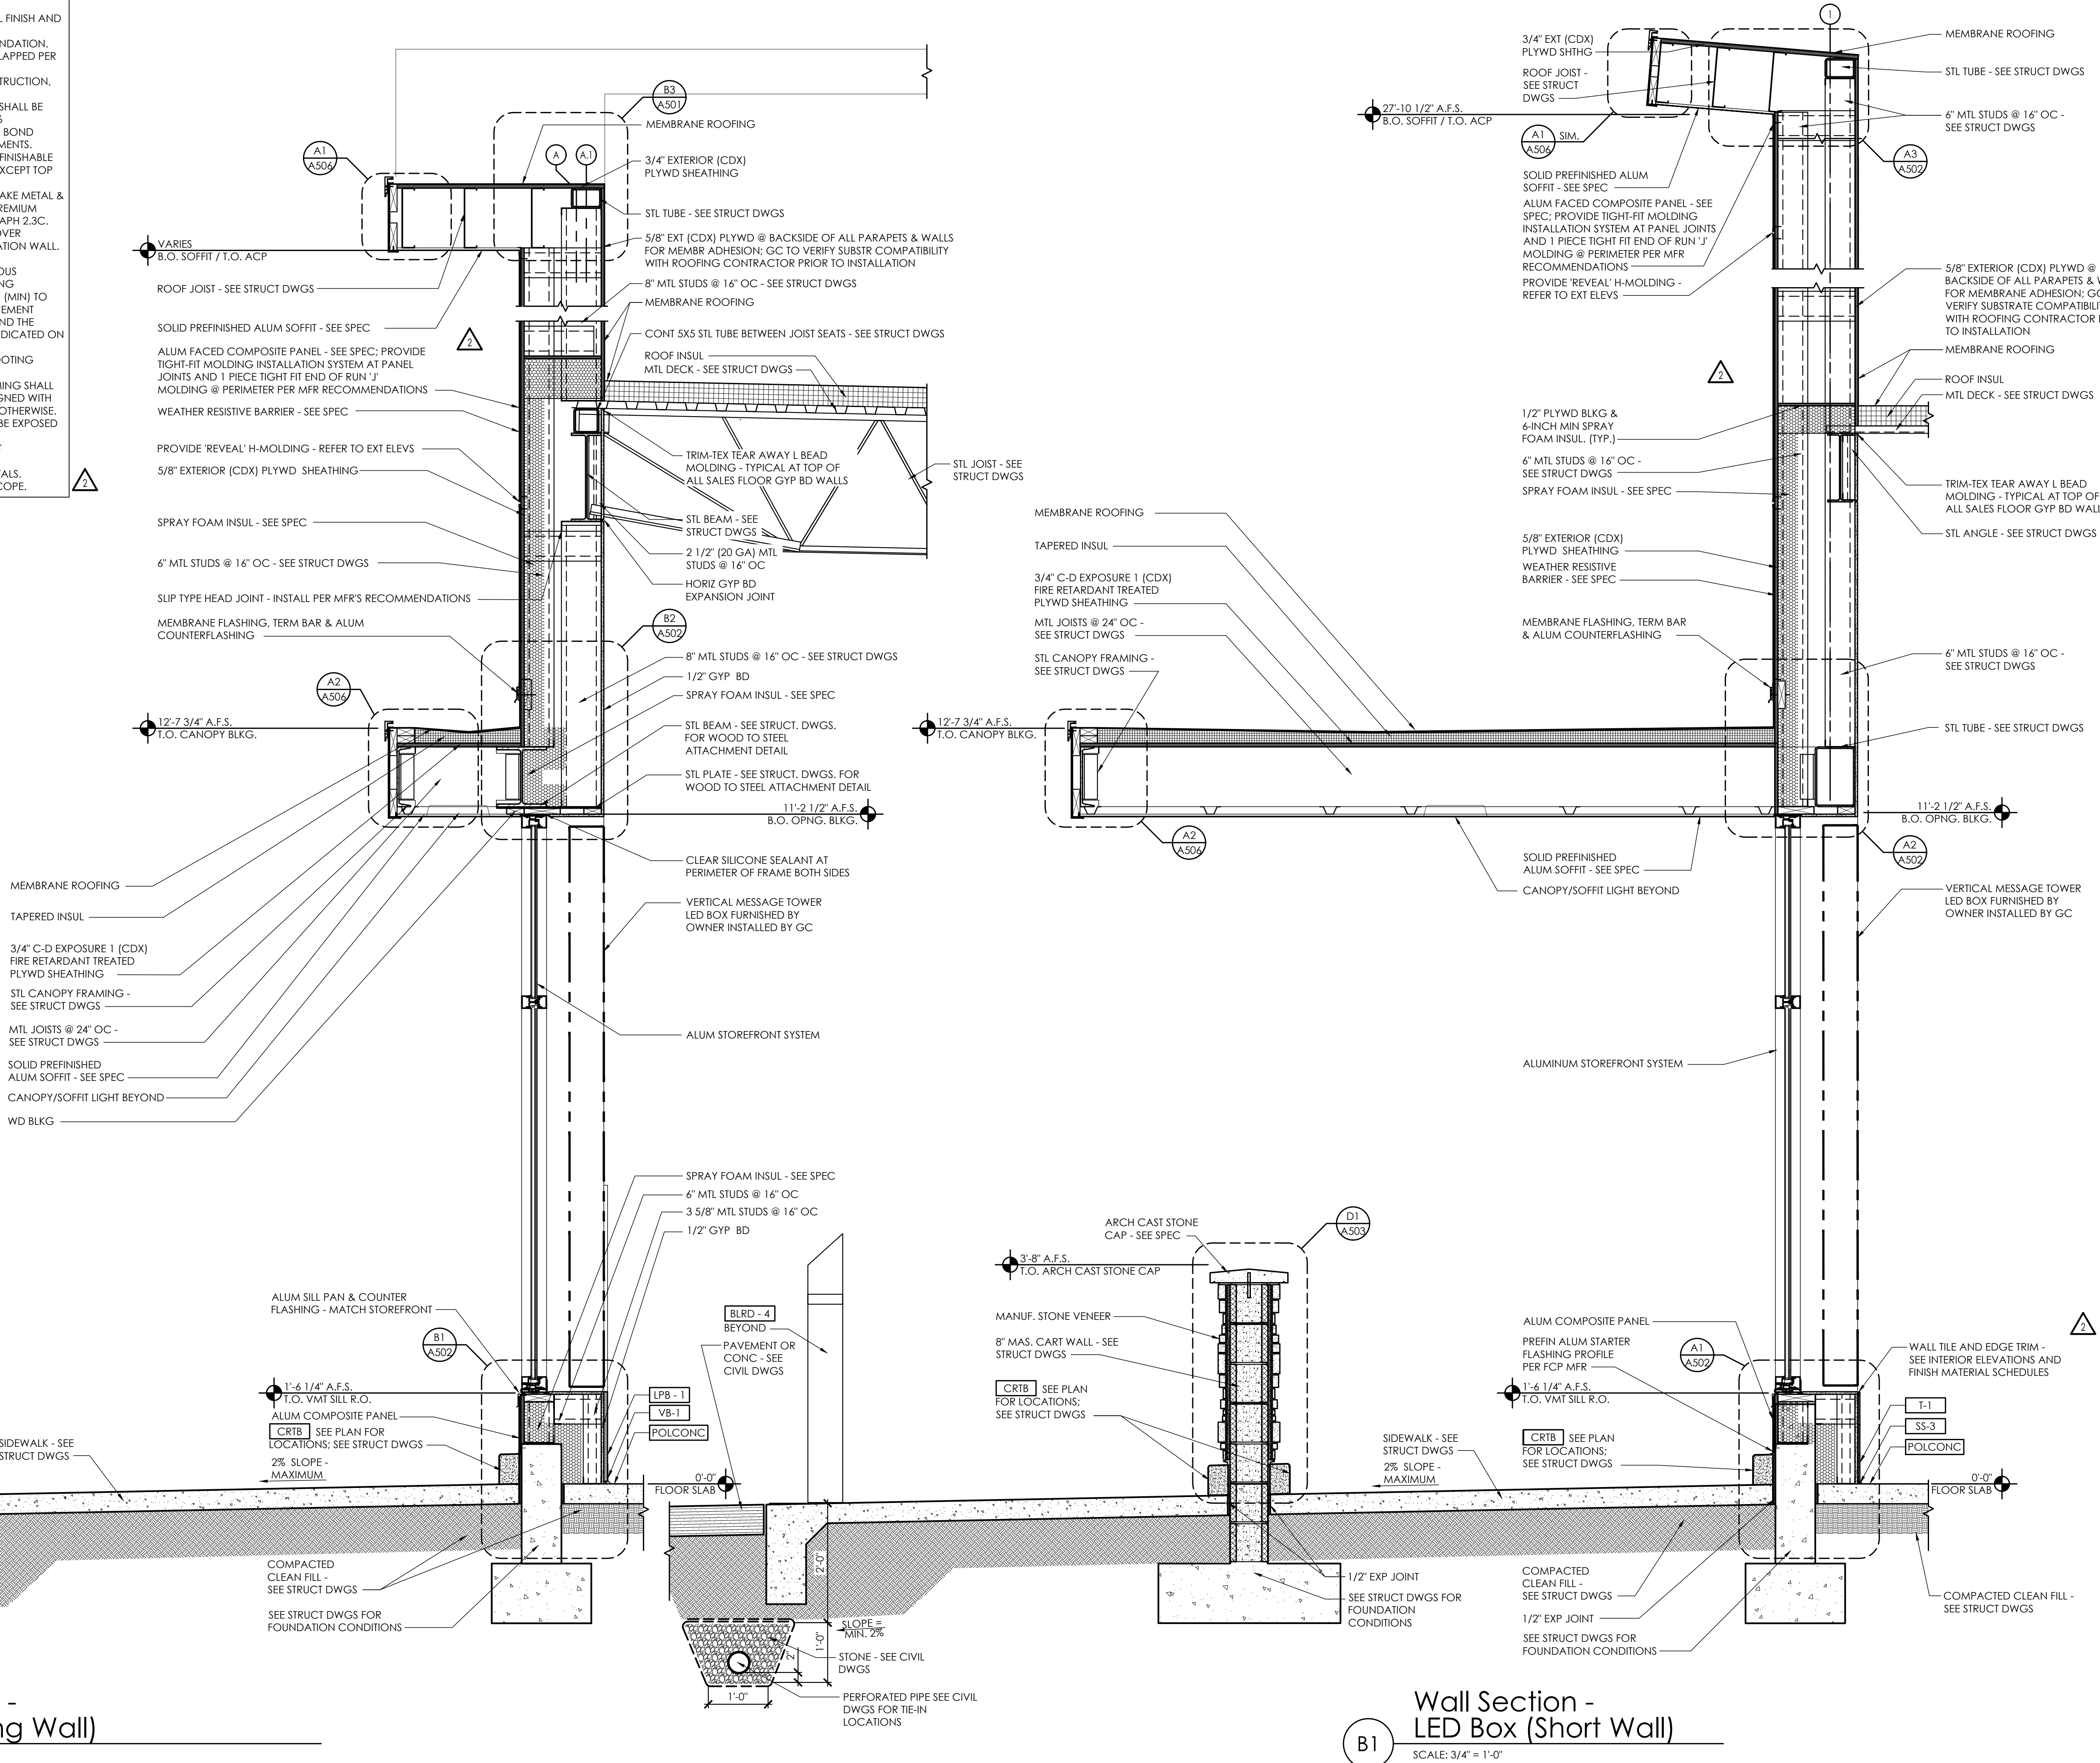

Wall Section -
LED Box (Long Wall)

SCALE: 3/4\" = 1'-0"

Wall Section -
LED Box (Short Wall)

SCALE: 3/4\" = 1'-0"

It is a violation of law for any person, unless acting under the direction of licensed Architect, Professional Engineer, Landscape Architect, or Land Surveyor to alter any item on this document in any way. Any licensee who alters this document is required by law to affix his or her seal and to add the notation "Altered By" followed by his or her signature and the specific description of the alteration or revision.

DO NOT SCALE PLANS

Copying, Printing, Software and other processes required to produce these prints can stretch or shrink the actual paper or layout. Therefore, scaling of this drawing may be inaccurate. Contact APD E&A with any need for additional dimensions or clarifications.

Issued:	Date:
A Issued for Permit	07/08/24
B Issued for Bid	07/29/25
C	
D	
E	

Revisions:	Date:
1 Owner Changes	11/18/24
2 Owner Changes	07/29/25
3	
4	
5	
6	
7	
8	
9	
10	
11	
12	

PROJECT ARCHITECT/ENGINEER

Daniel Sargent

PROJECT LEAD

John Lynch

**NOT FOR
CONSTRUCTION**

Seal Seal

ALDI Inc.
1171 North State Road 7
Royal Palm Beach, FL 33411
(561) 640-8000

ALDI Inc. Store #: 50
Coconut Crossing, FL 
12850 Northlake Boulevard
Palm Beach Gardens, FL 33412
Palm Beach County
Project Name & Location:


Wall

Sections

Drawing Name:

Prototype: V7.08 LHRD	Project No. 22-0267A
Type: GROUND UP	
Drawn By: JAH	
Scale: As Noted	A-303 Drawing No.

- NOTES:
- REFER TO SCHEDULES ON DRAWING A-603 FOR ALL FINISH AND INSULATION CALL-OUTS.
 - WRB TO BE SEALED AND TAPED PER MFR RECOMMENDATION. WRB TO WRAP INSIDE OPENINGS AND ALL JOINTS LAPPED PER MFR INSTALLATION REQMT.
 - PROTECT ALL EXTERIOR SHEATHING DURING CONSTRUCTION, AS REQUIRED BY MFR.
 - ALL MTL STUD FURRING AT PERIMETER CMU WALLS SHALL BE ATTACHED IN ACCORDANCE TO DETAILS: D1/A506
 - REFERENCE STRUCTURAL DRAWINGS FOR ALL CMU BOND BEAM, REINFORCEMENT AND GROUTING REQUIREMENTS.
 - PROVIDE TRIM-TEX TEAR AWAY L-BEAD MOLDING (FINISHABLE EDGE) AT ALL EXPOSED GYPSUM BOARD EDGES (EXCEPT TOP OF WALLS AT ROOF IN THE BACK ROOM).
 - ALL BLOCKING/SUB FASCIA BEHIND ALUMINUM BRAKE METAL & ALUMINUM FACED COMPOSITE PANEL SHALL BE PREMIUM GRADE AS SPECIFIED IN SECTION 061053, PARAGRAPH 2.3C.
 - INSTALL COUNTER FLASHINGS AT BASE OF WALLS OVER SELF-ADHERING FLASHING EXTENDING TO FOUNDATION WALL. LAP WRB OVER COUNTER FLASHING, TYP.
 - ATTACH PLYWOOD WALL SHEATHING & CONTINUOUS INSULATION PANELS TO METAL STUD FRAMING, USING SPECIFIED FASTENERS SPACED 16" O.C. EACH WAY (MIN) TO SUPPORT UP TO 10 PSF DEAD LOAD OF THE FIBER CEMENT WALL PANEL SYSTEM, INSULATION, & SHEATHING AND THE MAXIMUM WIND SPEED AND DESIGN PRESSURES INDICATED ON SHEET S-001.
 - REFER TO STRUCT DWGS FOR ALL FOUNDATION/FOOTING REQUIREMENTS (INCLUDING DEPTHS).
 - ALL ALUMINUM STOREFRONT/CURTAIN WALL FRAMING SHALL BE INSTALLED WITH THE EXTERIOR FRAME FACE ALIGNED WITH THE EXTERIOR BUILDING WALL LINE UNLESS NOTED OTHERWISE. NO GRAY BLOCK OR EXTERIOR SHEATHING SHALL BE EXPOSED AT JAMBS, HEADS, AND SILLS.
 - PROVIDE CONTINUOUS SEALANT ALONG THE CART BUMPER/SIDEWALK JOINT.
 - PROVIDE BOND BREAKER BETWEEN DISSIMILAR METALS.
 - REFER TO RESPONSIBILITY SCHEDULES FOR ROOF SCOPE.

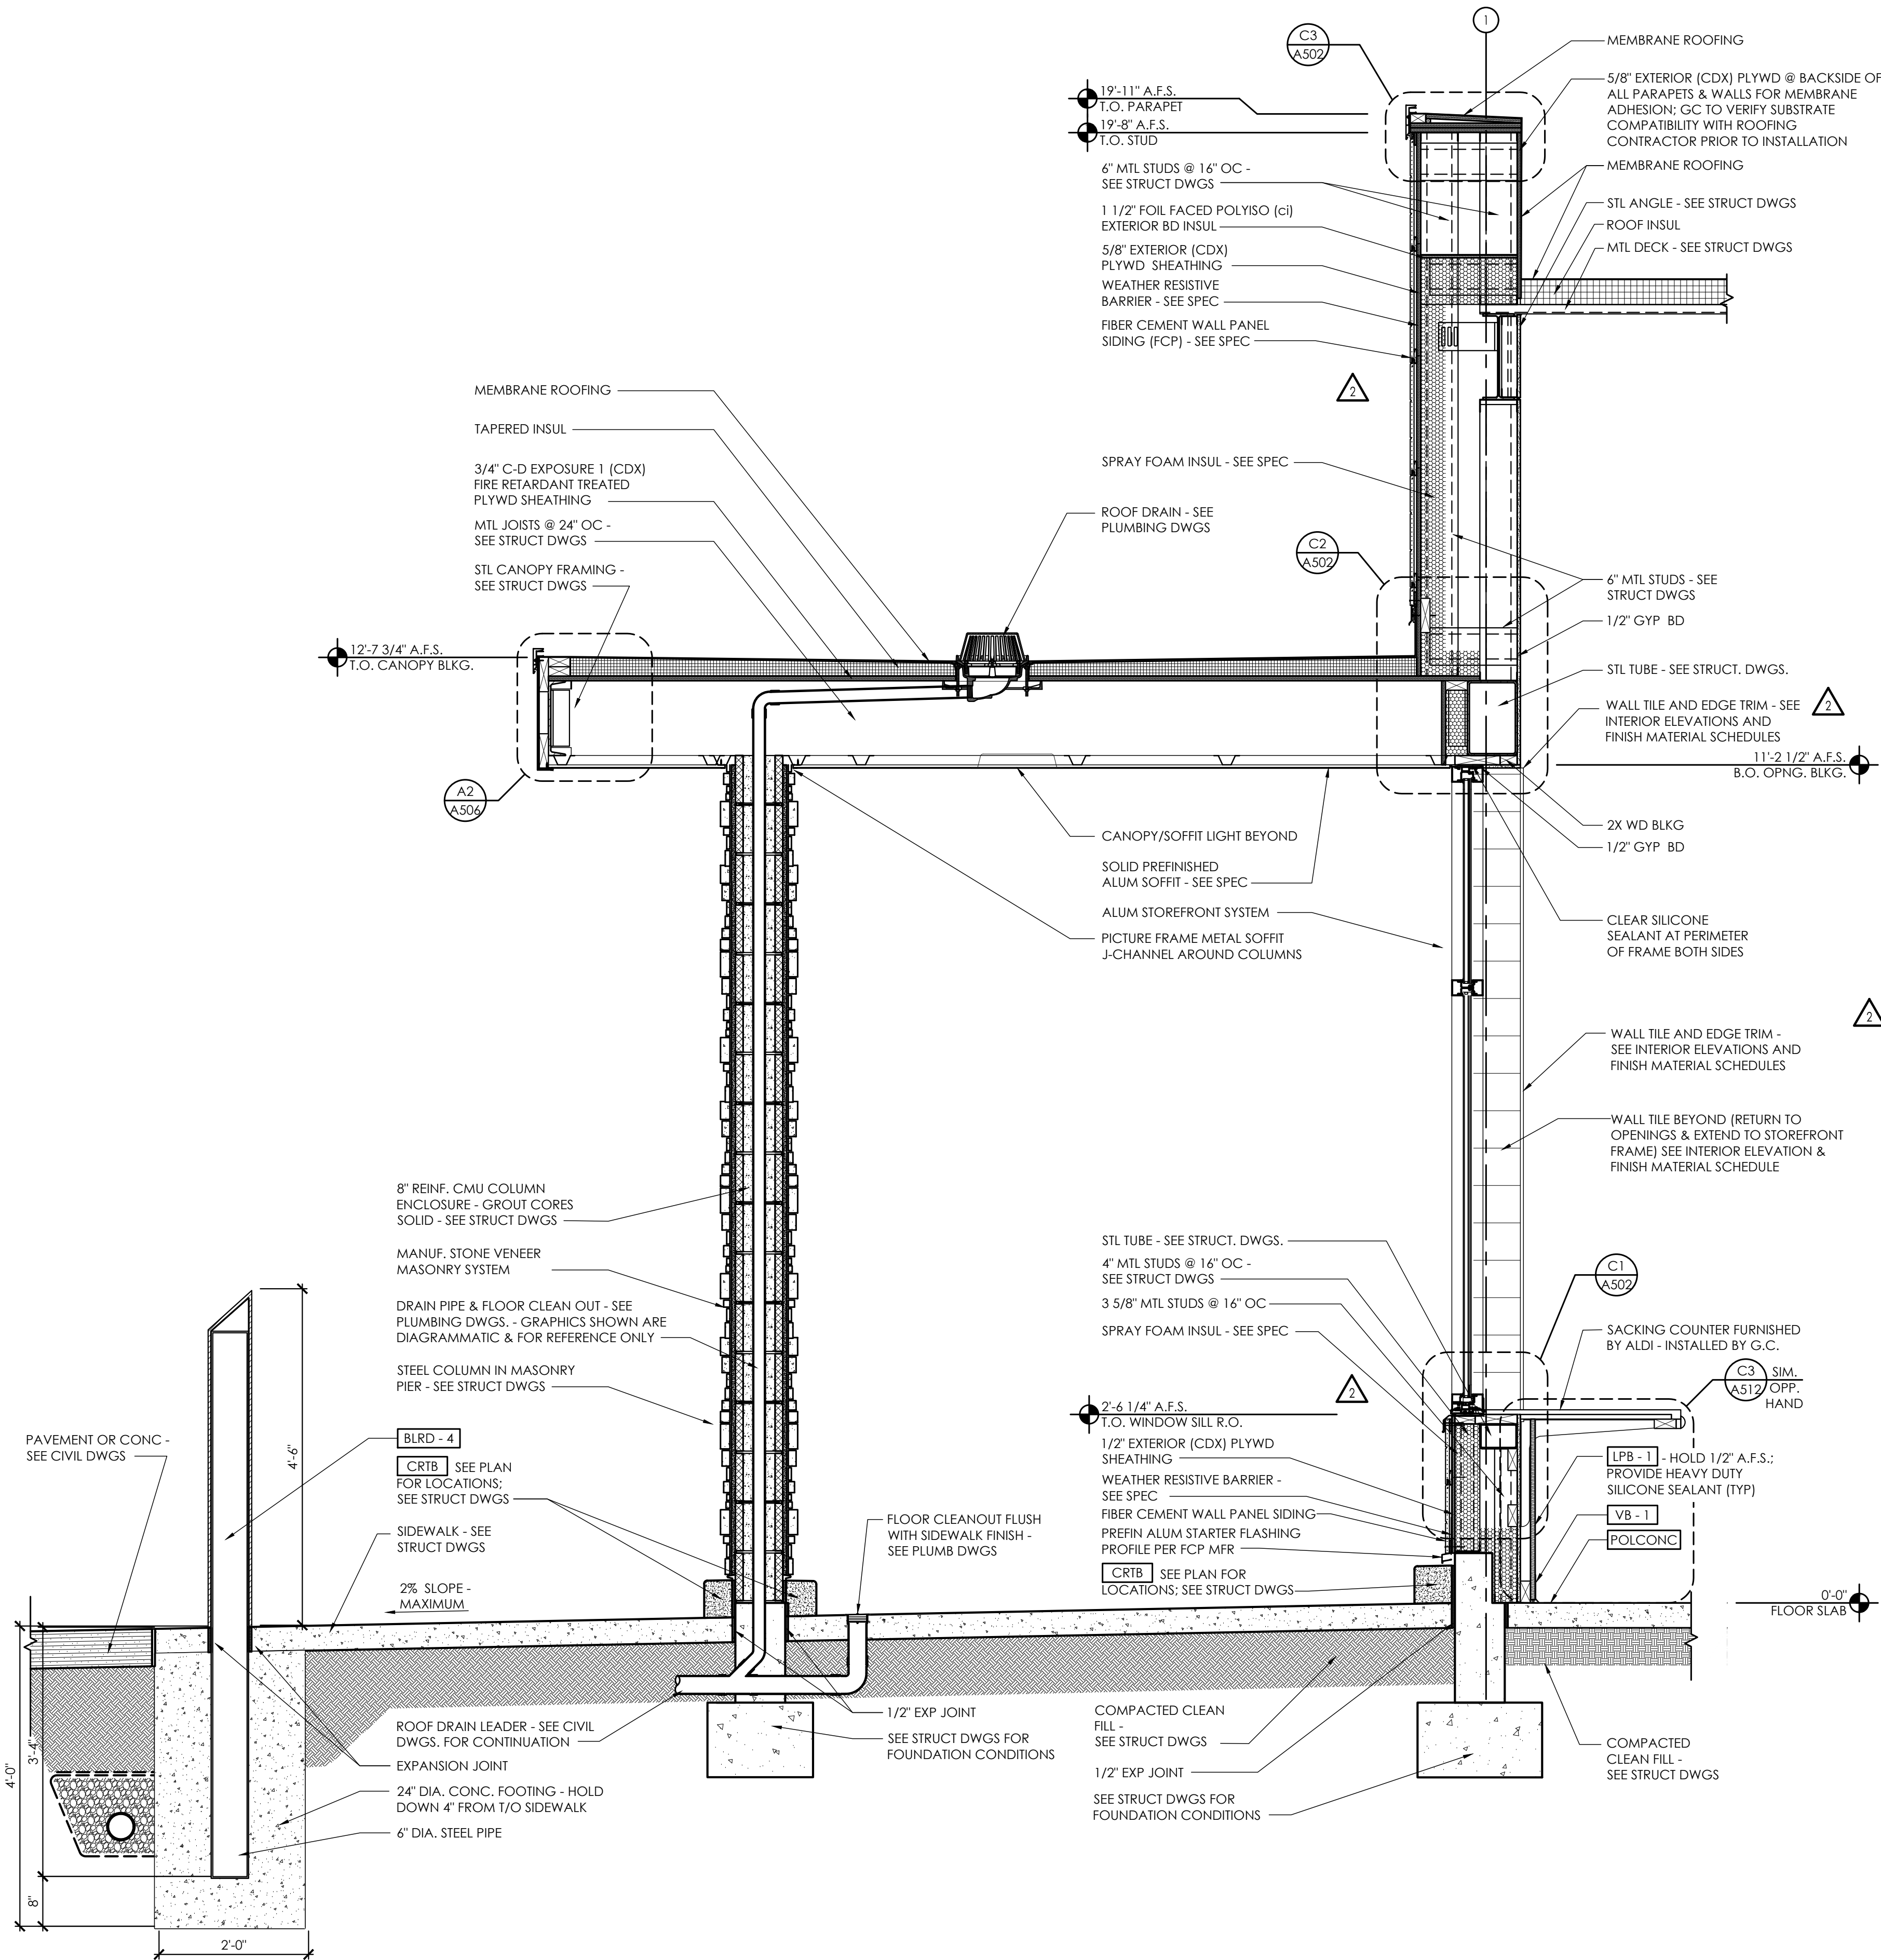

Wall Section -
Sacking Counter

SCALE: 3/4\" = 1'-0"

Copyright © 2024
APD Engineering & Architecture
03/27/2024

Drawing Alteration

It is a violation of law for any person, unless acting under the direction of licensed Architect, Professional Engineer, Landscape Architect, or Land Surveyor to alter any item on this document in any way. Any licensee who alters this document is required by law to affix his or her seal and to add the notation "Altered By" followed by his or her signature and the specific description of the alteration or revision.

DO NOT SCALE PLANS

Copying, Printing, Software and other processes required to produce these prints can stretch or shrink the actual paper or layout. Therefore, scaling of this drawing may be inaccurate. Contact APD E&A with any need for additional dimensions or clarifications.

Issued:	Date:
A Issued for Permit	07/08/24
B Issued for Bid	07/29/25
C	
D	
E	

Revisions:	Date:
1 Owner Changes	11/18/24
2 Owner Changes	07/29/25
3	
4	
5	
6	
7	
8	
9	
10	
11	
12	

PROJECT ARCHITECT/ENGINEER

Daniel Sargent

PROJECT LEAD

John Lynch

**NOT FOR
CONSTRUCTION**

Seal Seal



ALDI Inc.

1171 North State Road 7
Royal Palm Beach, FL 33411
(561) 640-8000

ALDI Inc. Store #: 50
Coconut Crossing, FL
12850 Northlake Boulevard
Palm Beach Gardens, FL 33412
Palm Beach County
Project Name & Location:





Wall

Sections

Drawing Name:

Prototype:	Project No.
V7.08 LHRD	22-0267A
Type:	
GROUND UP	
Drawn By:	
JAH	
Scale:	A-304
As Noted	Drawing No.

PLOTTED: 7/29/2025 9:45 AM

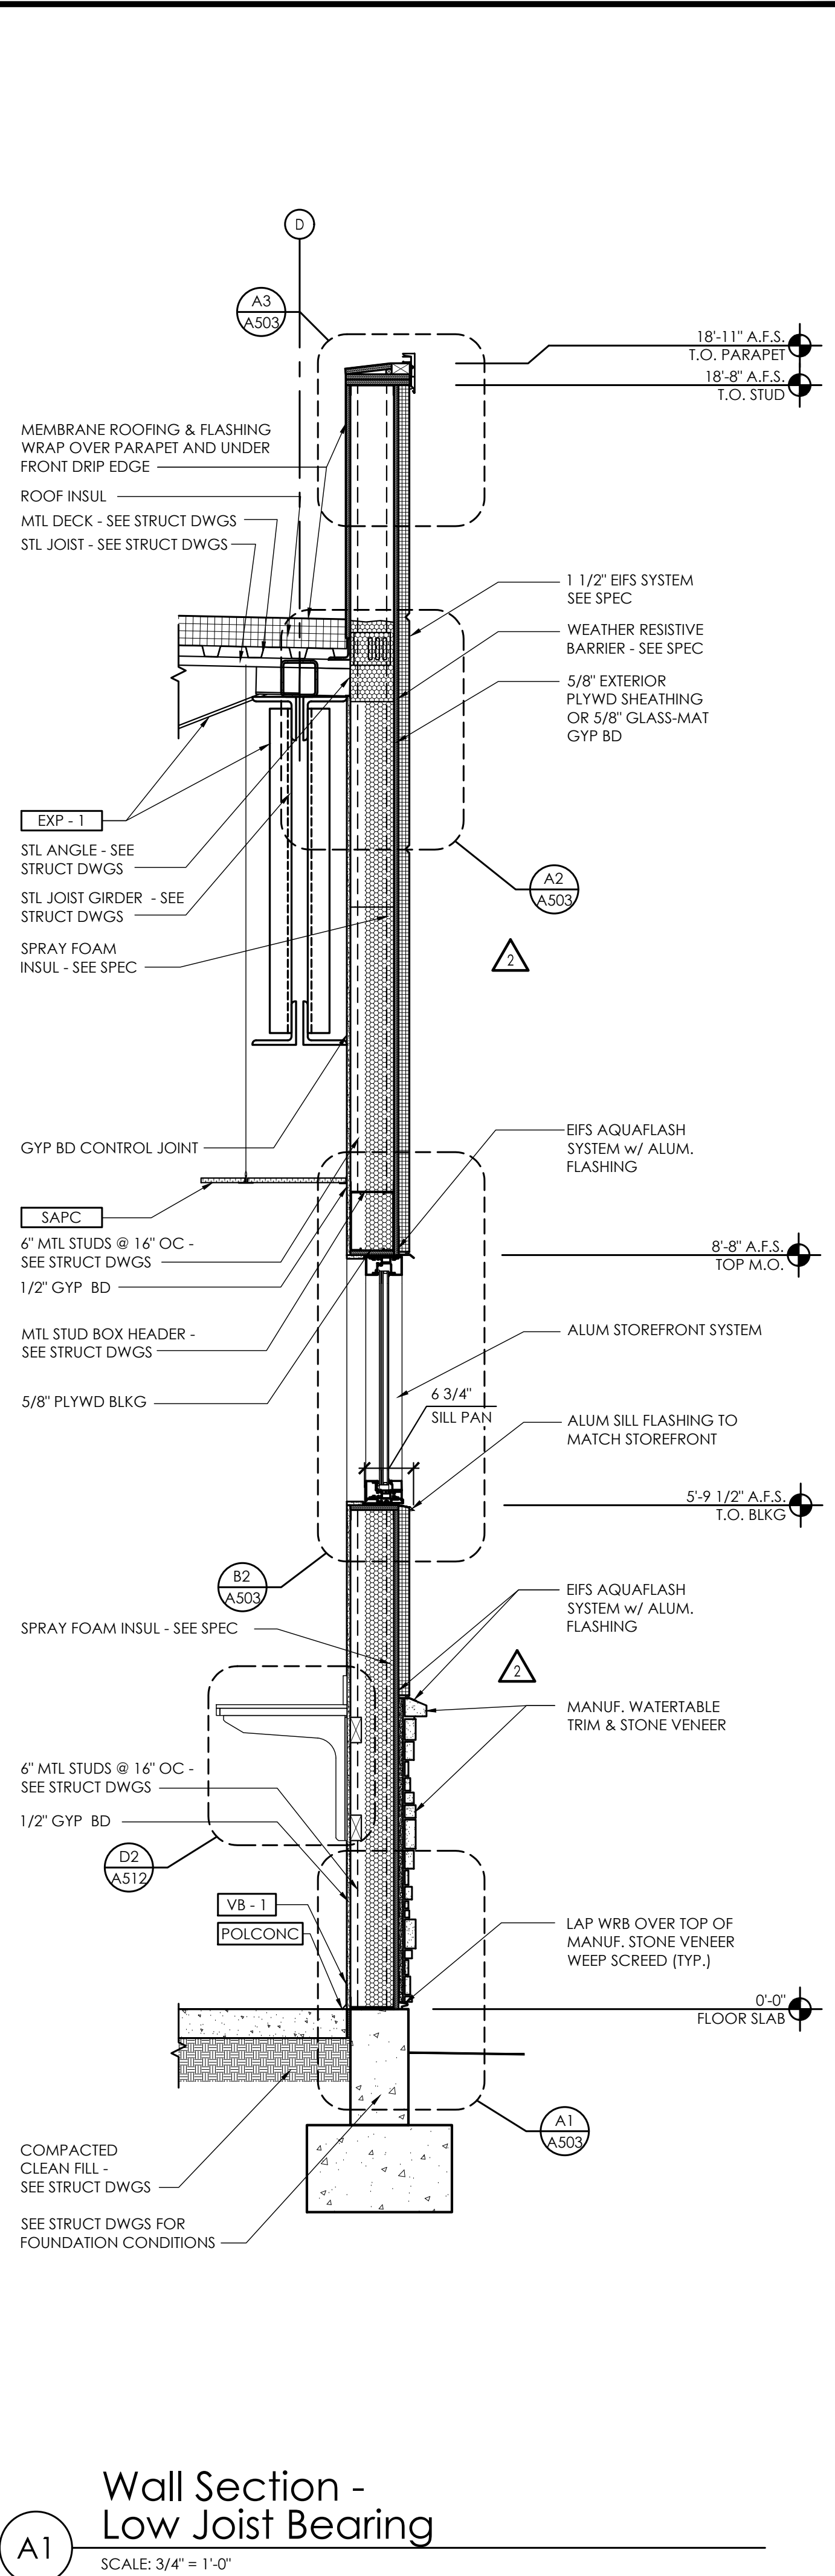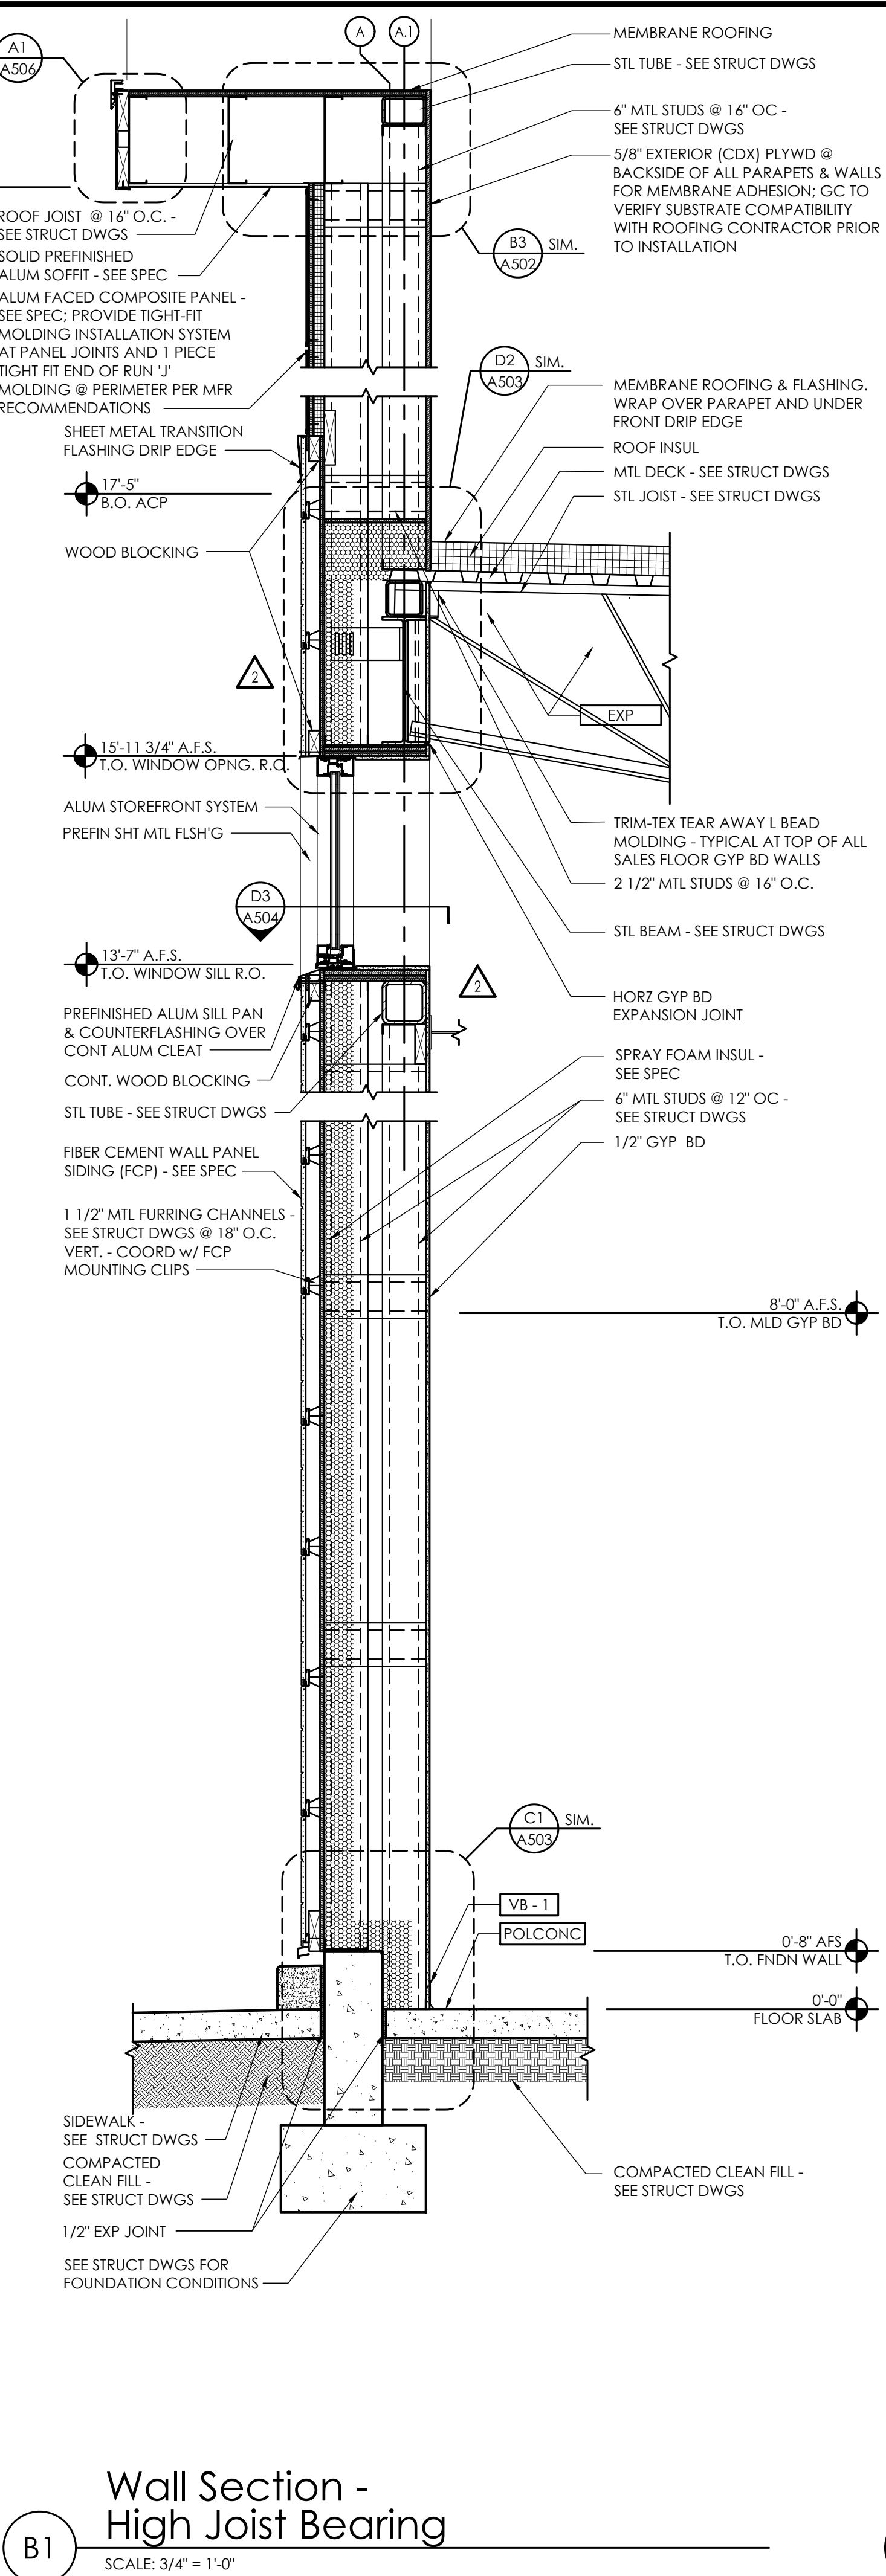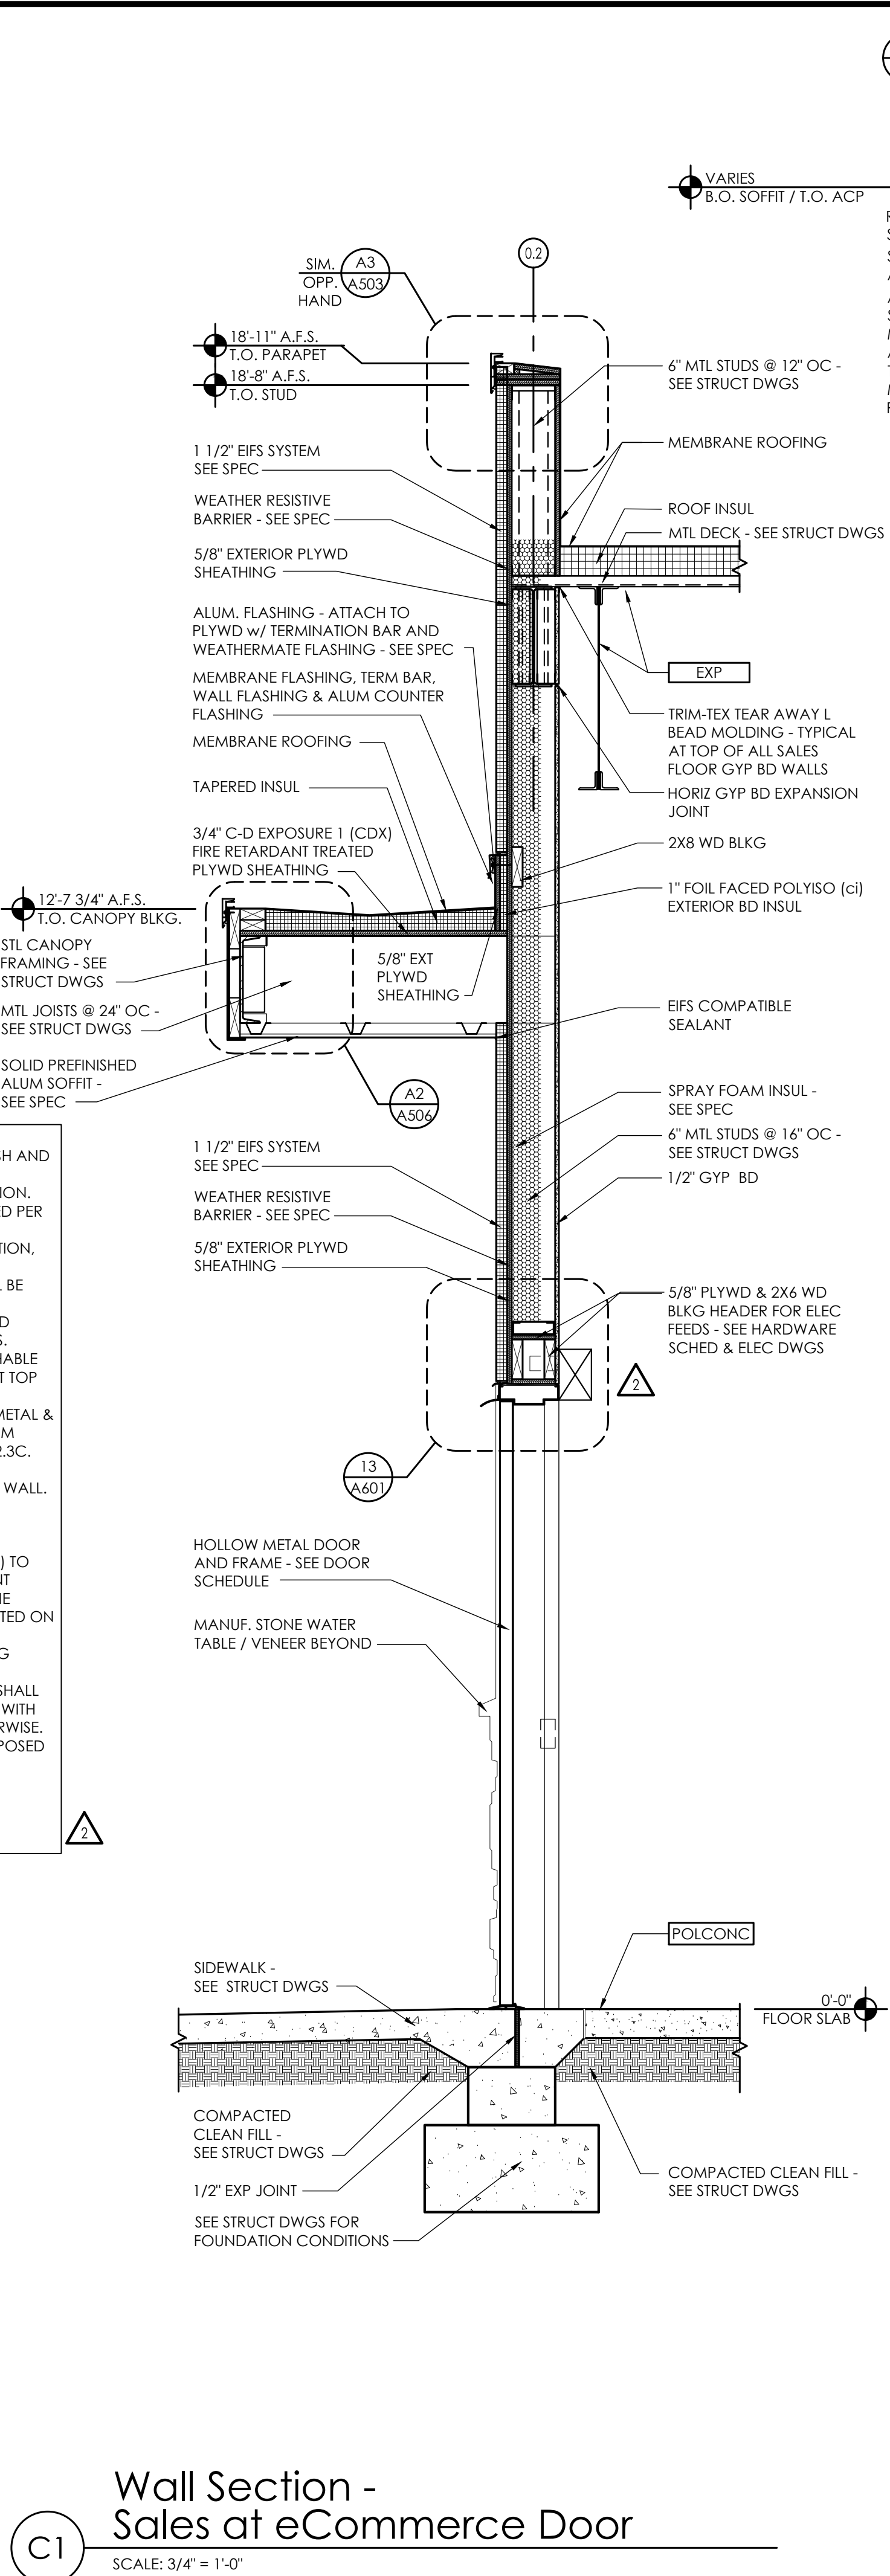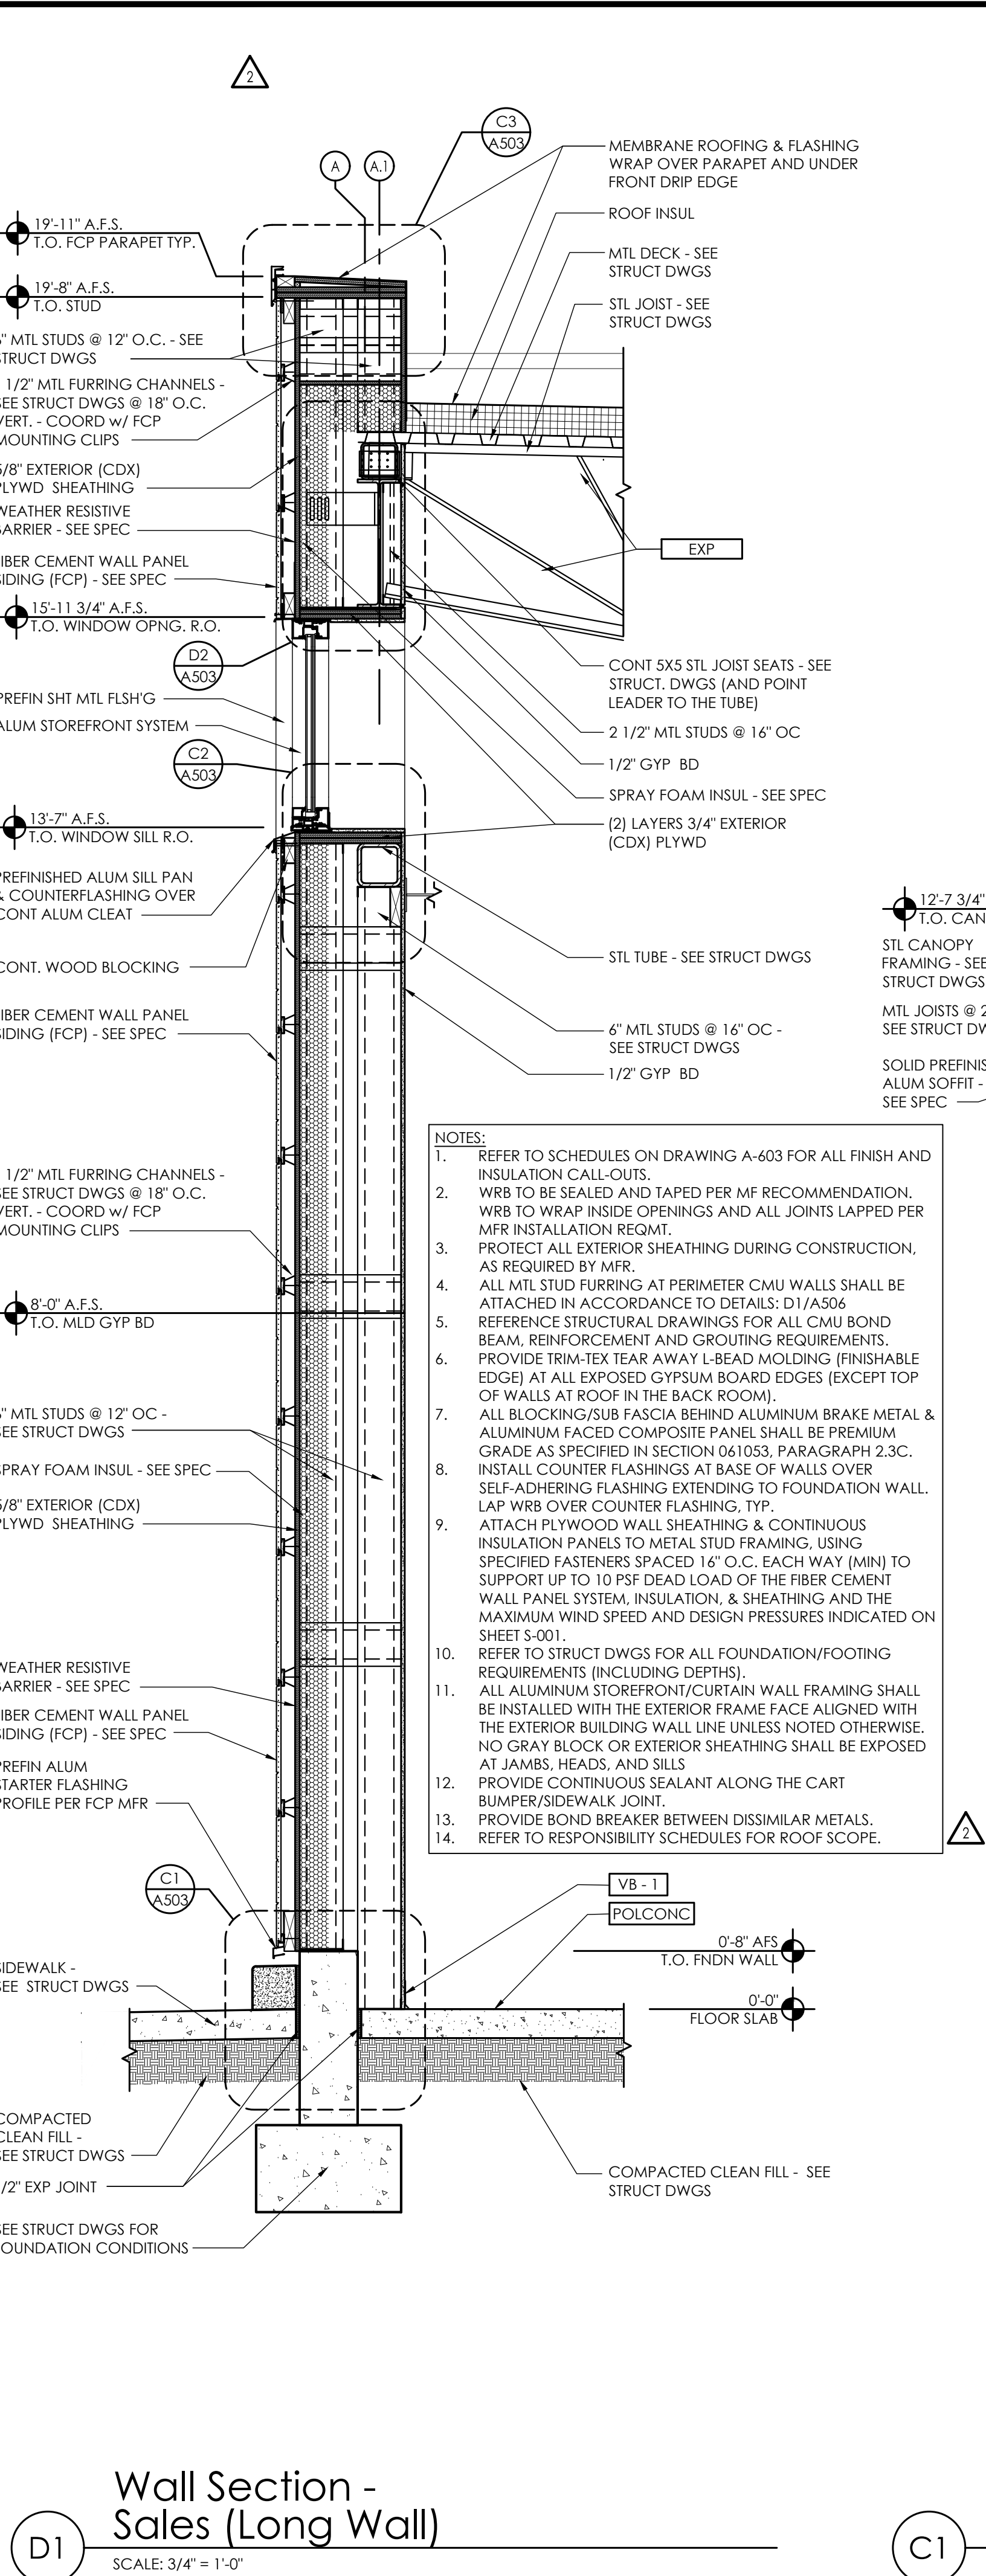

Issued:	Date:
A Issued for Permit	07/08/24
B Issued for Bid	07/29/25
C	
D	
E	

Revisions:	Date:
1 Owner Changes	11/18/24
2 Owner Changes	07/29/25
3	
4	
5	
6	
7	
8	
9	
10	
11	
12	


PROJECT ARCHITECT/ENGINEER

Daniel Sargent

PROJECT LEAD

John Lynch


NOT FOR
CONSTRUCTION

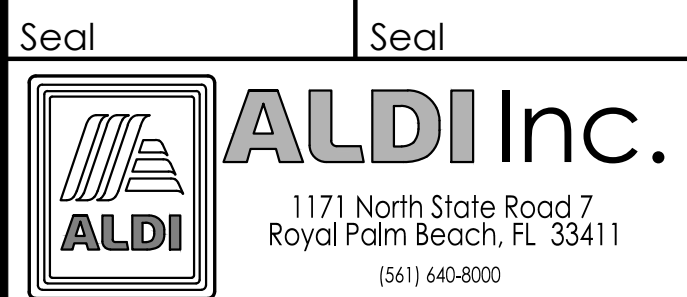

ALDI Inc. Store #: 50
Coconut Crossing, FL
12850 Northlake Boulevard
Palm Beach Gardens, FL 33412
Palm Beach County
Project Name & Location:


Wall	
Sections	
Drawing Name:	
Prototype:	Project No.
V7.08 LHRD	22-0267A
Type:	
GROUND UP	
Drawn By:	
JAH	
Scale:	
As Noted	
	A-305
	Drawing No.

PLOTTED: 7/29/2025 9:45 AM

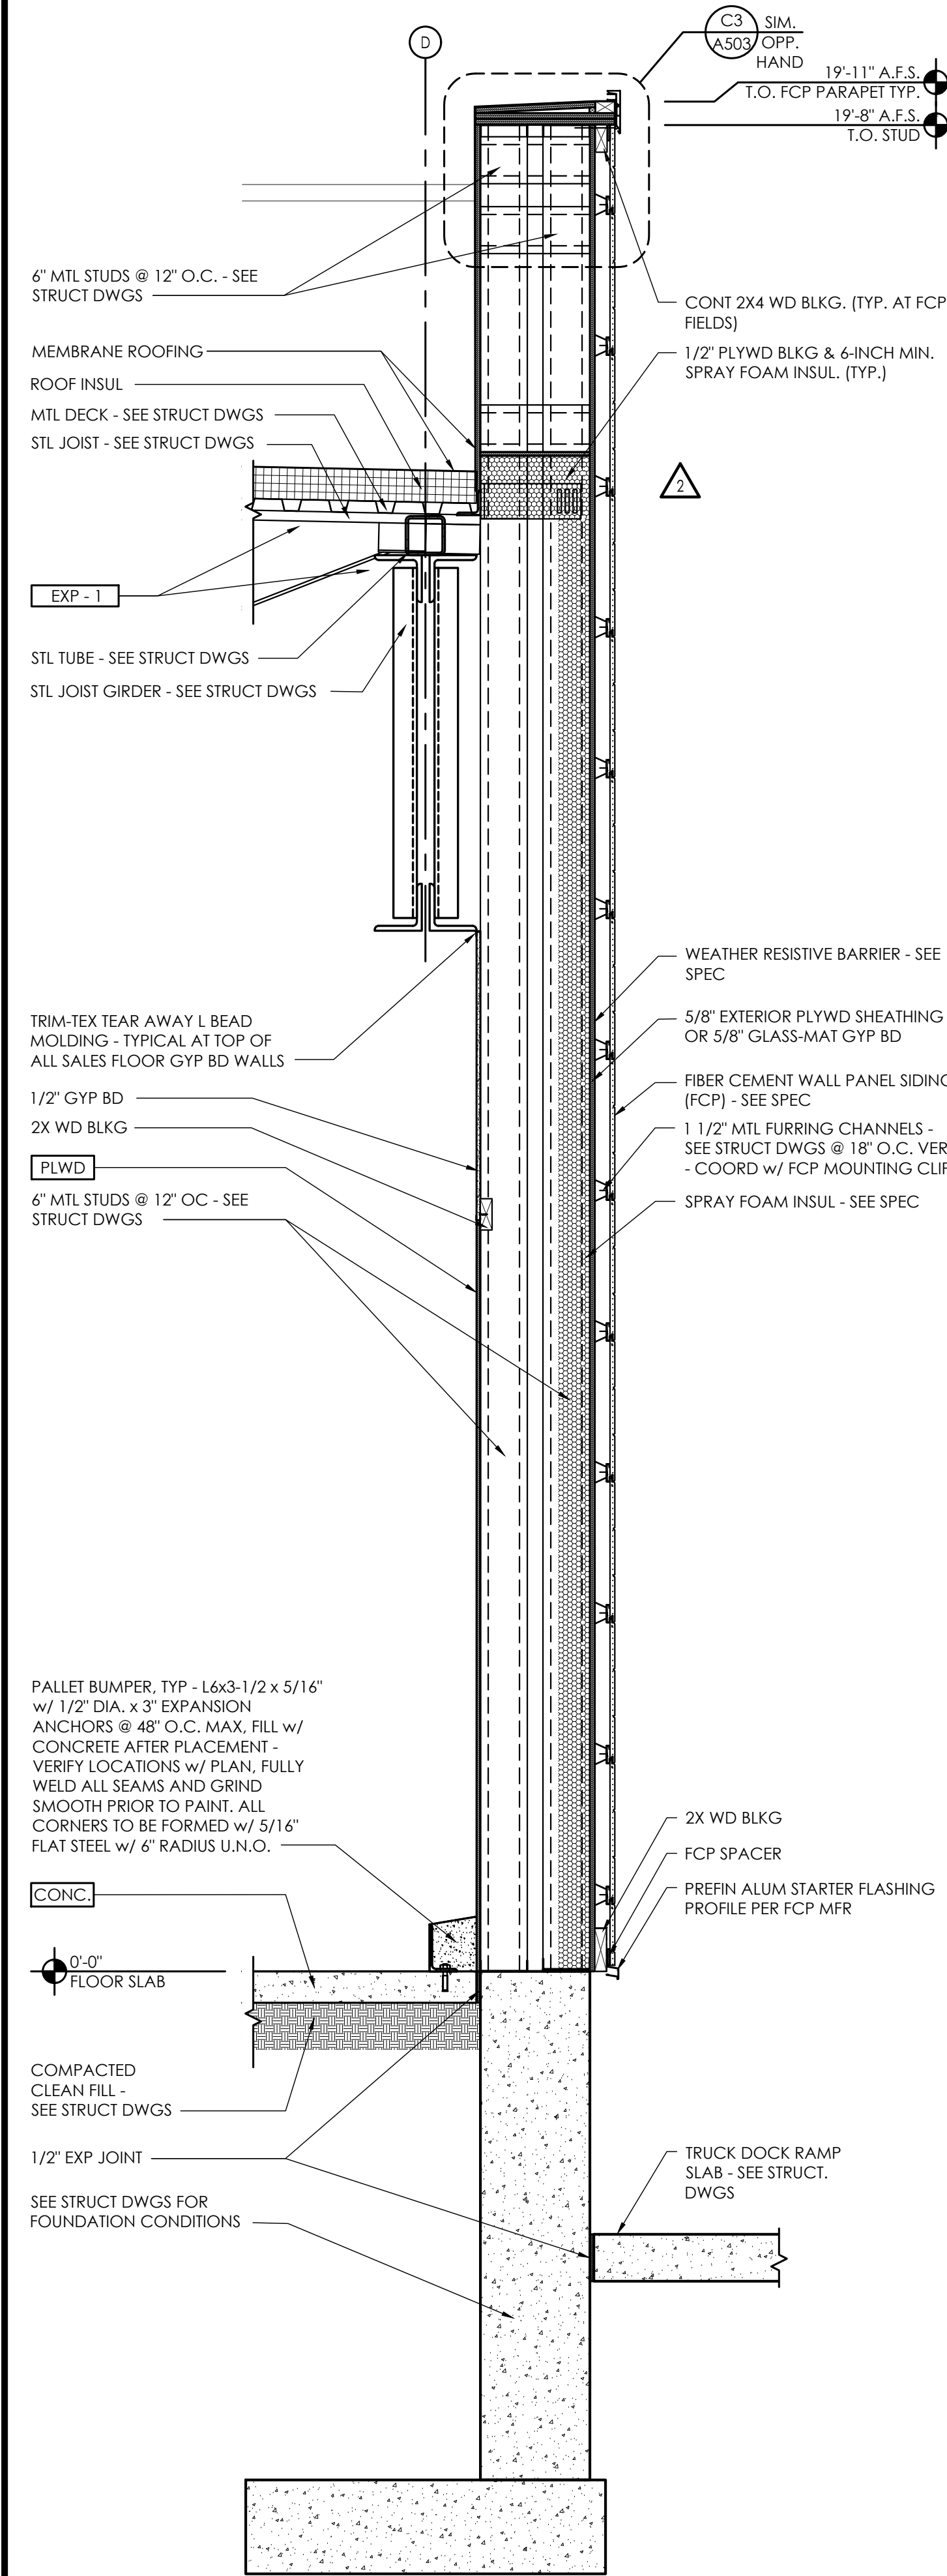


Wall Section -
Fiber Cement Panel at Rear Dock

SCALE: 3/4" = 1'-0"

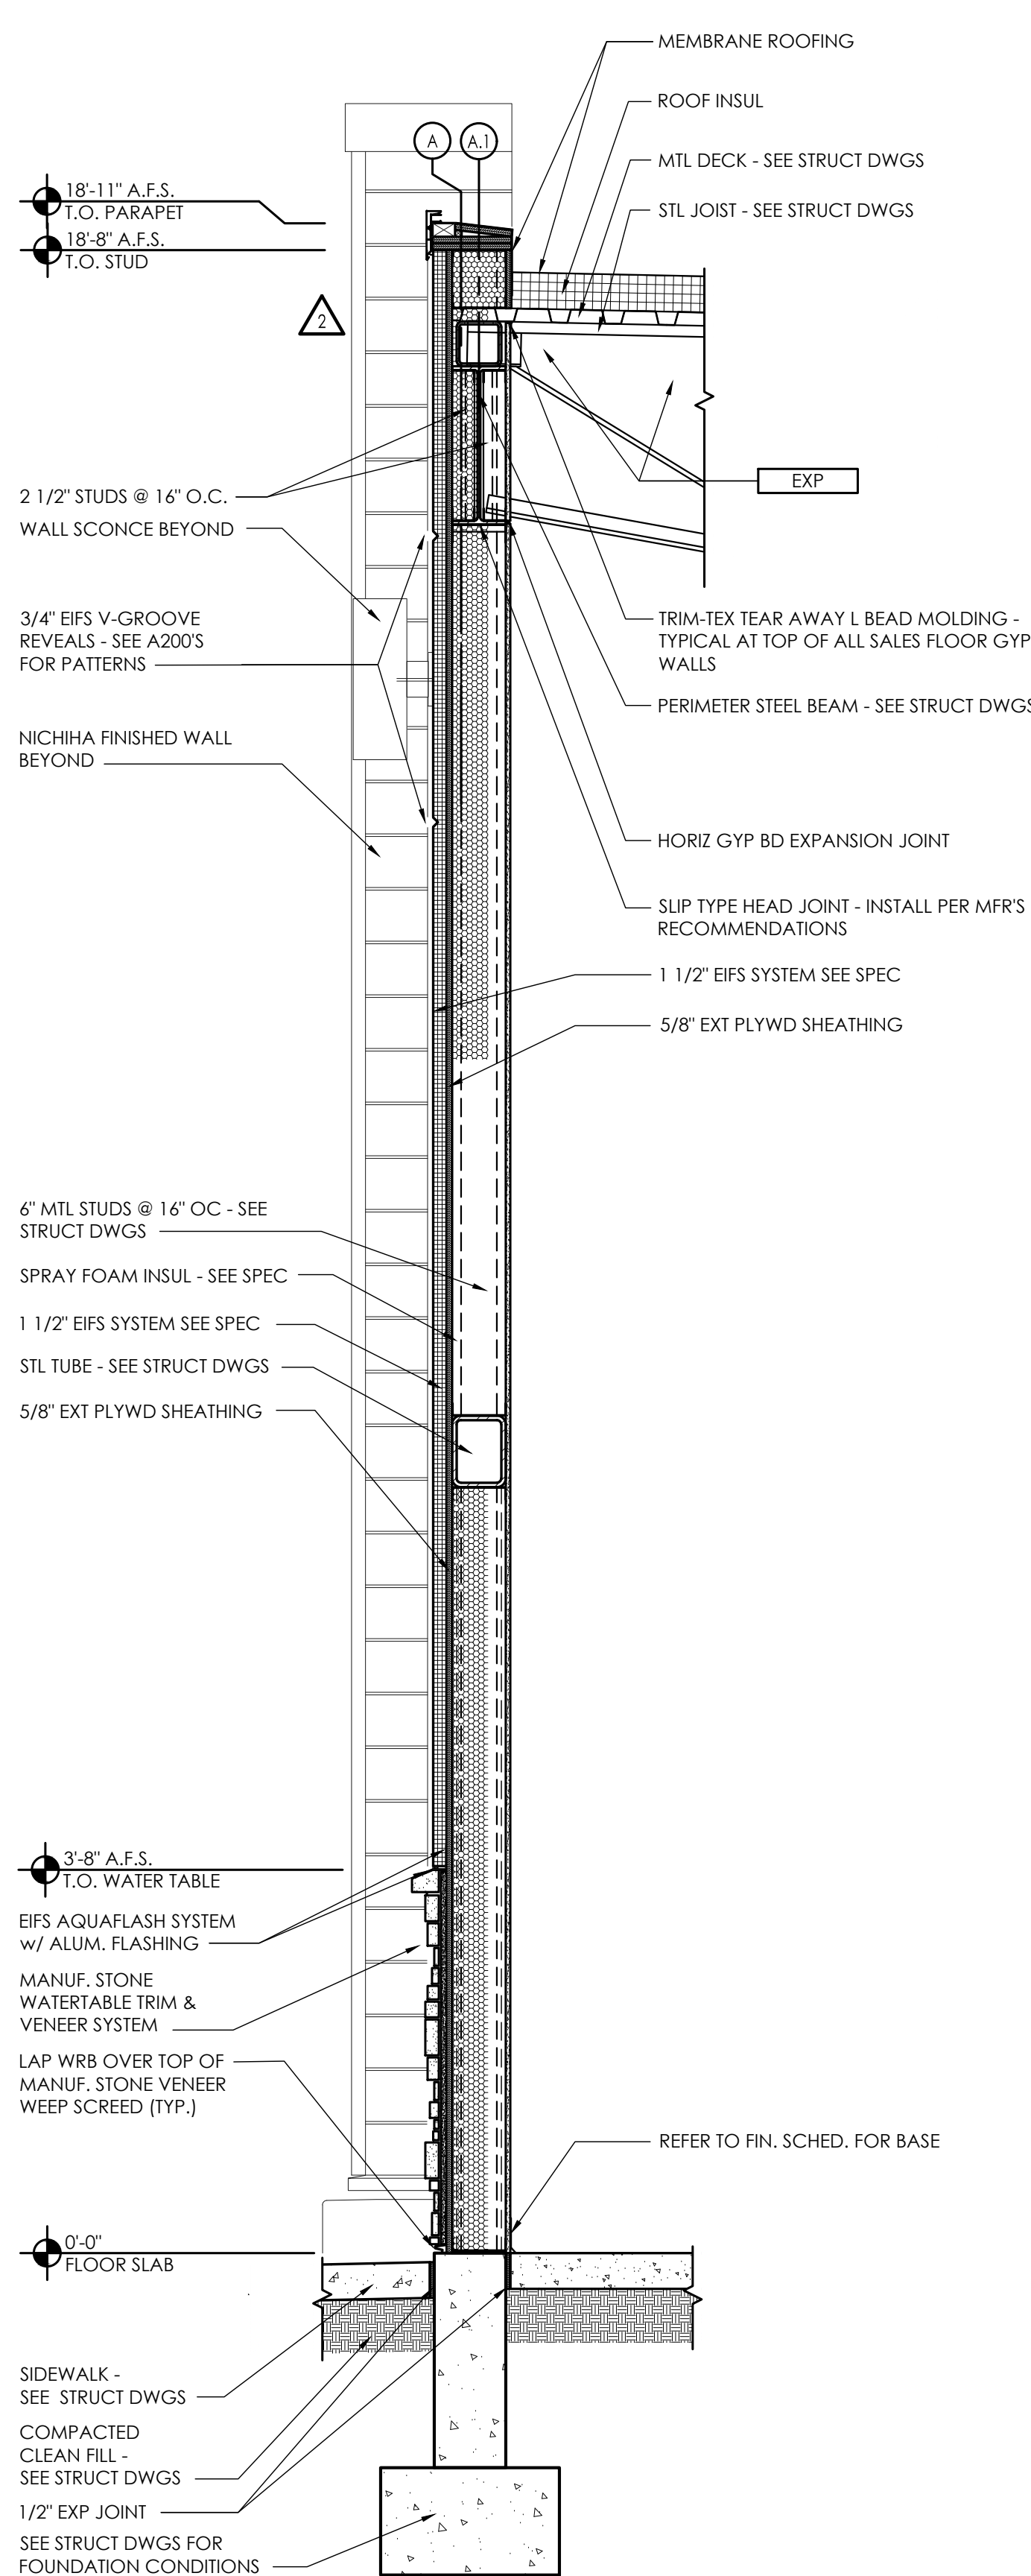


Wall Section -
Water Table at EIFS Field

SCALE: 3/4" = 1'-0"

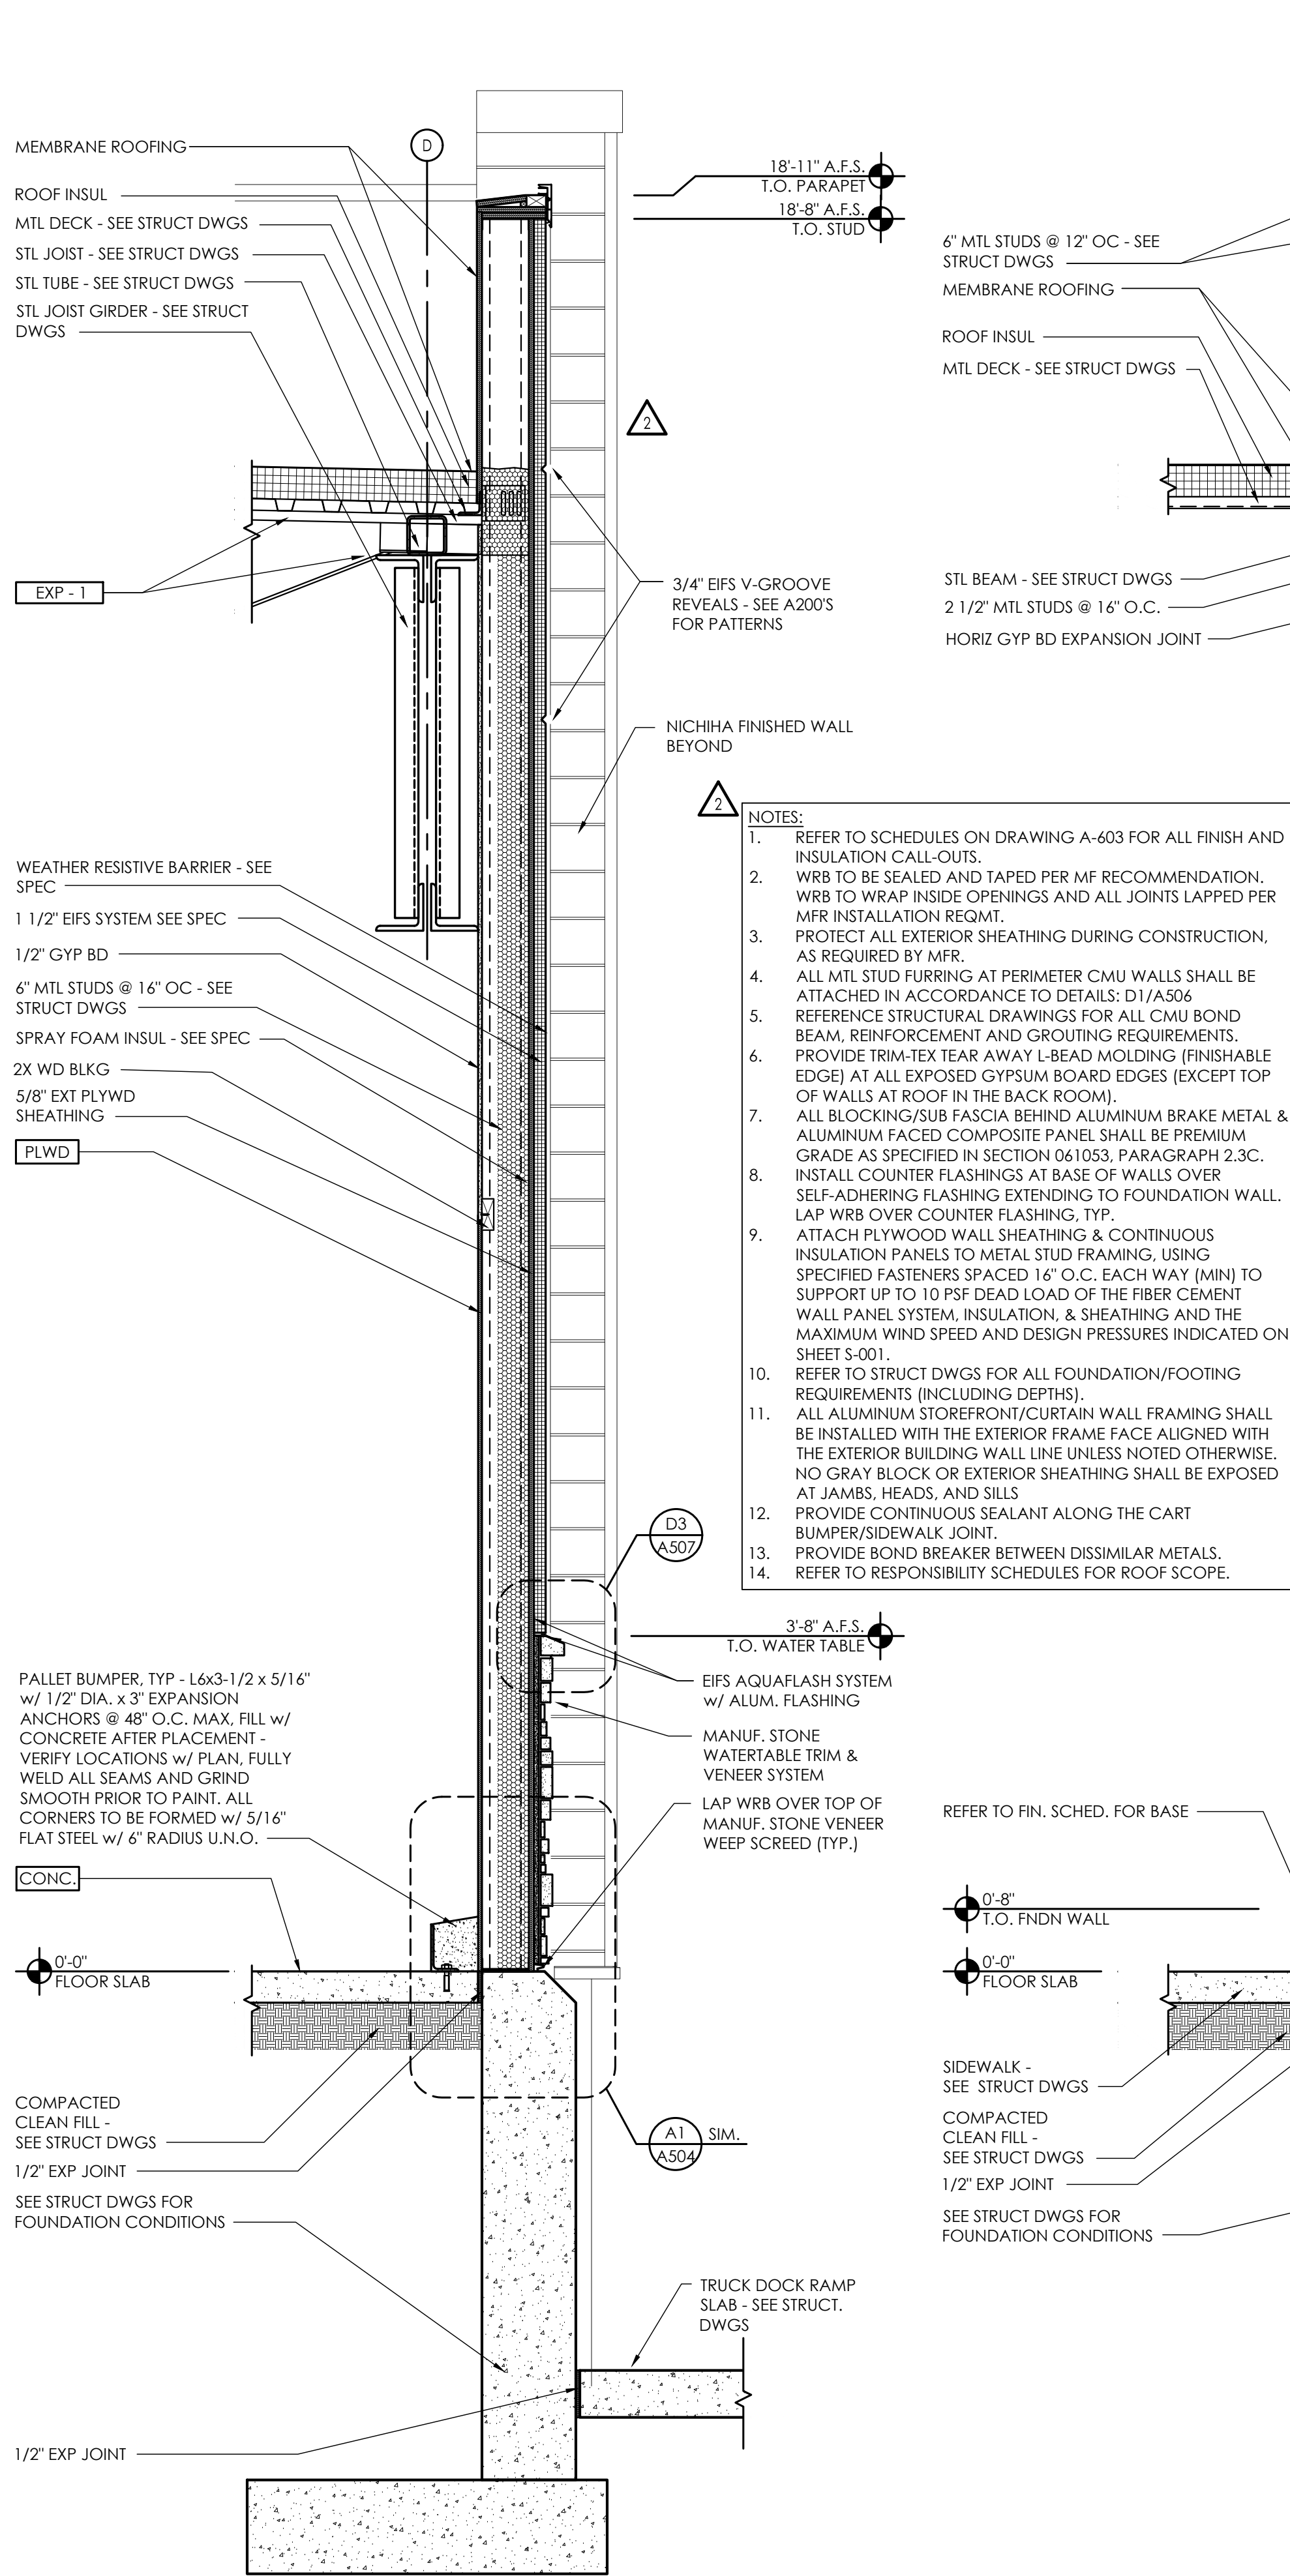

Wall Section -
Water Table at Rear Dock EIFS Field

SCALE: 3/4" = 1'-0"

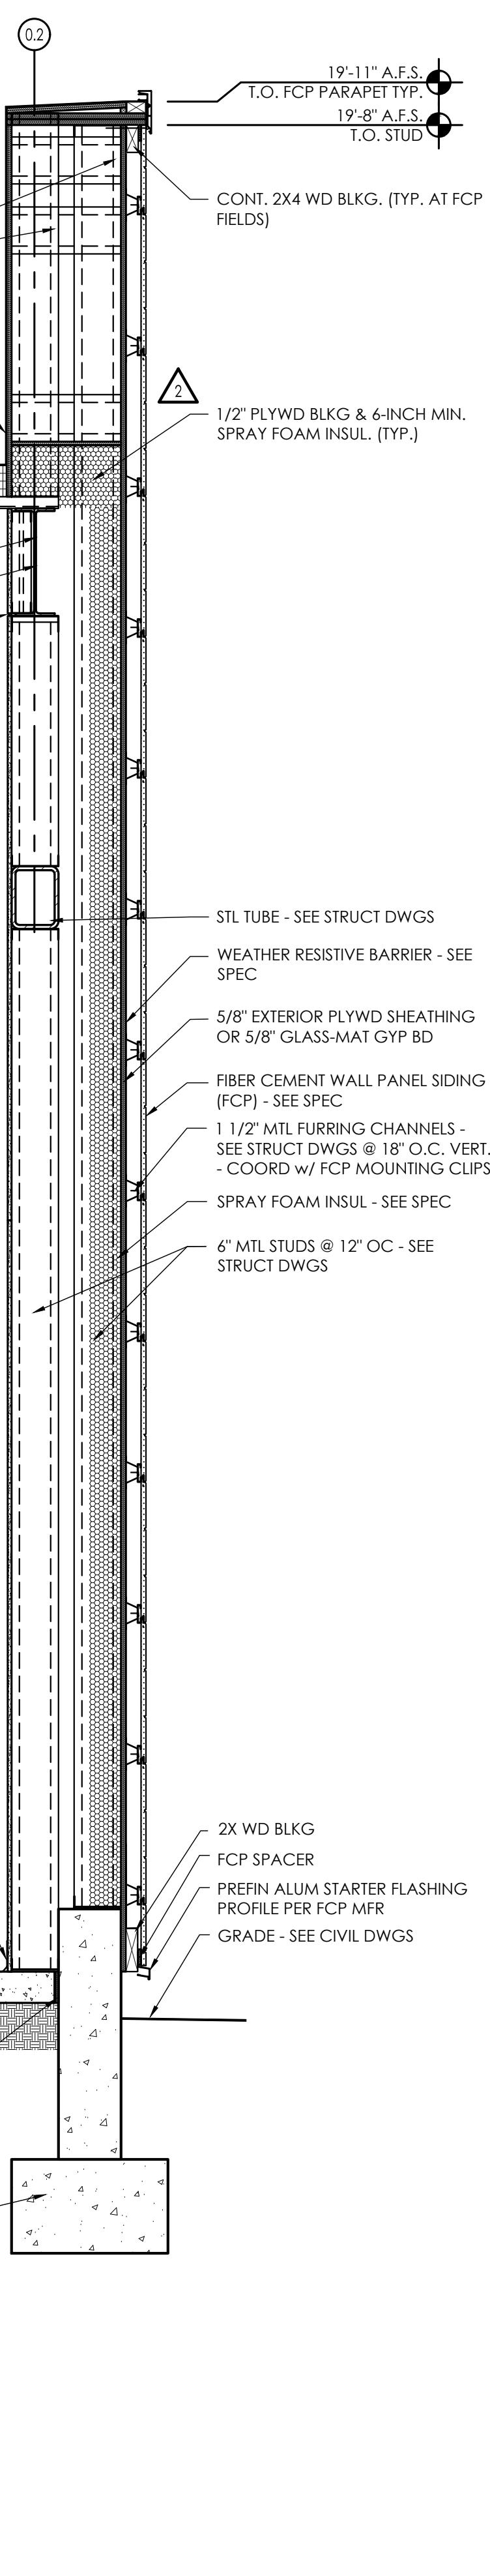

Wall Section -
Fiber Cement Panel at Braced Wall

SCALE: 3/4" = 1'-0"

Copyright © 2024

APD Engineering & Architecture
03/27/19 1224

Drawing Alteration

It is a violation of law for any person, unless acting under the direction of licensed Architect, Professional Engineer, Landscape Architect, or Land Surveyor to alter any item on this document in any way. Any licensee who alters this document is required by law to affix his or her seal and to add the notation "Altered By" followed by his or her signature and the specific description of the alteration or revision.

DO NOT SCALE PLANS

Copying, Printing, Software and other processes required to produce these prints can stretch or shrink the actual paper or layout. Therefore, scaling of this drawing may be inaccurate. Contact APD E&A with any need for additional dimensions or clarifications.

Issued: Date:

A	Issued for Permit	07/08/24
B	Issued for Bid	07/29/25
C		
D		
E		

Revisions: Date:

1	Owner Changes	11/18/24
2	Owner Changes	07/29/25
3		
4		
5		
6		
7		
8		
9		
10		
11		
12		

PROJECT ARCHITECT/ENGINEER


Daniel Sargent

PROJECT LEAD

John Lynch

**NOT FOR
CONSTRUCTION**

Seal Seal

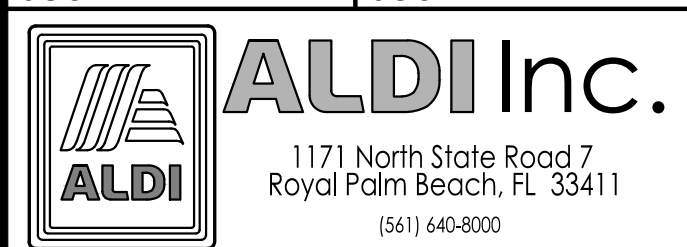

ALDI Inc. Store #: 50
Coconut Crossing, FL
12850 Northlake Boulevard
Palm Beach Gardens, FL 33412
Palm Beach County
Project Name & Location:

Wall

Sections

Drawing Name:

Prototype:	Project No.
V7.08 LHRD	22-0267A
Type:	
GROUND UP	
Drawn By:	
JAH	
Scale:	A-307
As Noted	Drawing No.

Copyright © 2024
APD Engineering & Architecture
03/21/2012

Drawing Alteration

It is a violation of law for any person, unless acting under the direction of licensed Architect, Professional Engineer, Landscape Architect, or Land Surveyor to alter any item on this document in any way. Any licensee who alters this document is required by law to affix his or her seal and to add the notation "Altered By" followed by his or her signature and the specific description of the alteration or revision.

DO NOT SCALE PLANS

Copying, Printing, Software and other processes required to produce these prints can stretch or shrink the actual paper or layout. Therefore, scaling of this drawing may be inaccurate. Contact APD E&A with any need for additional dimensions or clarifications.

Issued:	Date:
A Issued for Permit	07/08/24
B Issued for Bid	07/29/25
C	
D	
E	

Revisions:	Date:
1 Owner Changes	11/18/24
2 Owner Changes	07/29/25
3	
4	
5	
6	
7	
8	
9	
10	
11	
12	

PROJECT ARCHITECT/ENGINEER

Daniel Sargent

PROJECT LEAD

John Lynch

**NOT FOR
CONSTRUCTION**

Seal Seal



ALDI Inc. Store #: 50
Coconut Crossing, FL
12850 Northlake Boulevard
Palm Beach Gardens, FL 33412
Palm Beach County
Project Name & Location:

Enlarged Plans

Drawing Name:

Prototype:
V7.08 LHRD

Type:
GROUND UP

Drawn By:
JWL

Scale:
As Noted


Project No.

22-0267A

A-401

Drawing No.

PLOTTED: 7/29/2025 9:45 AM

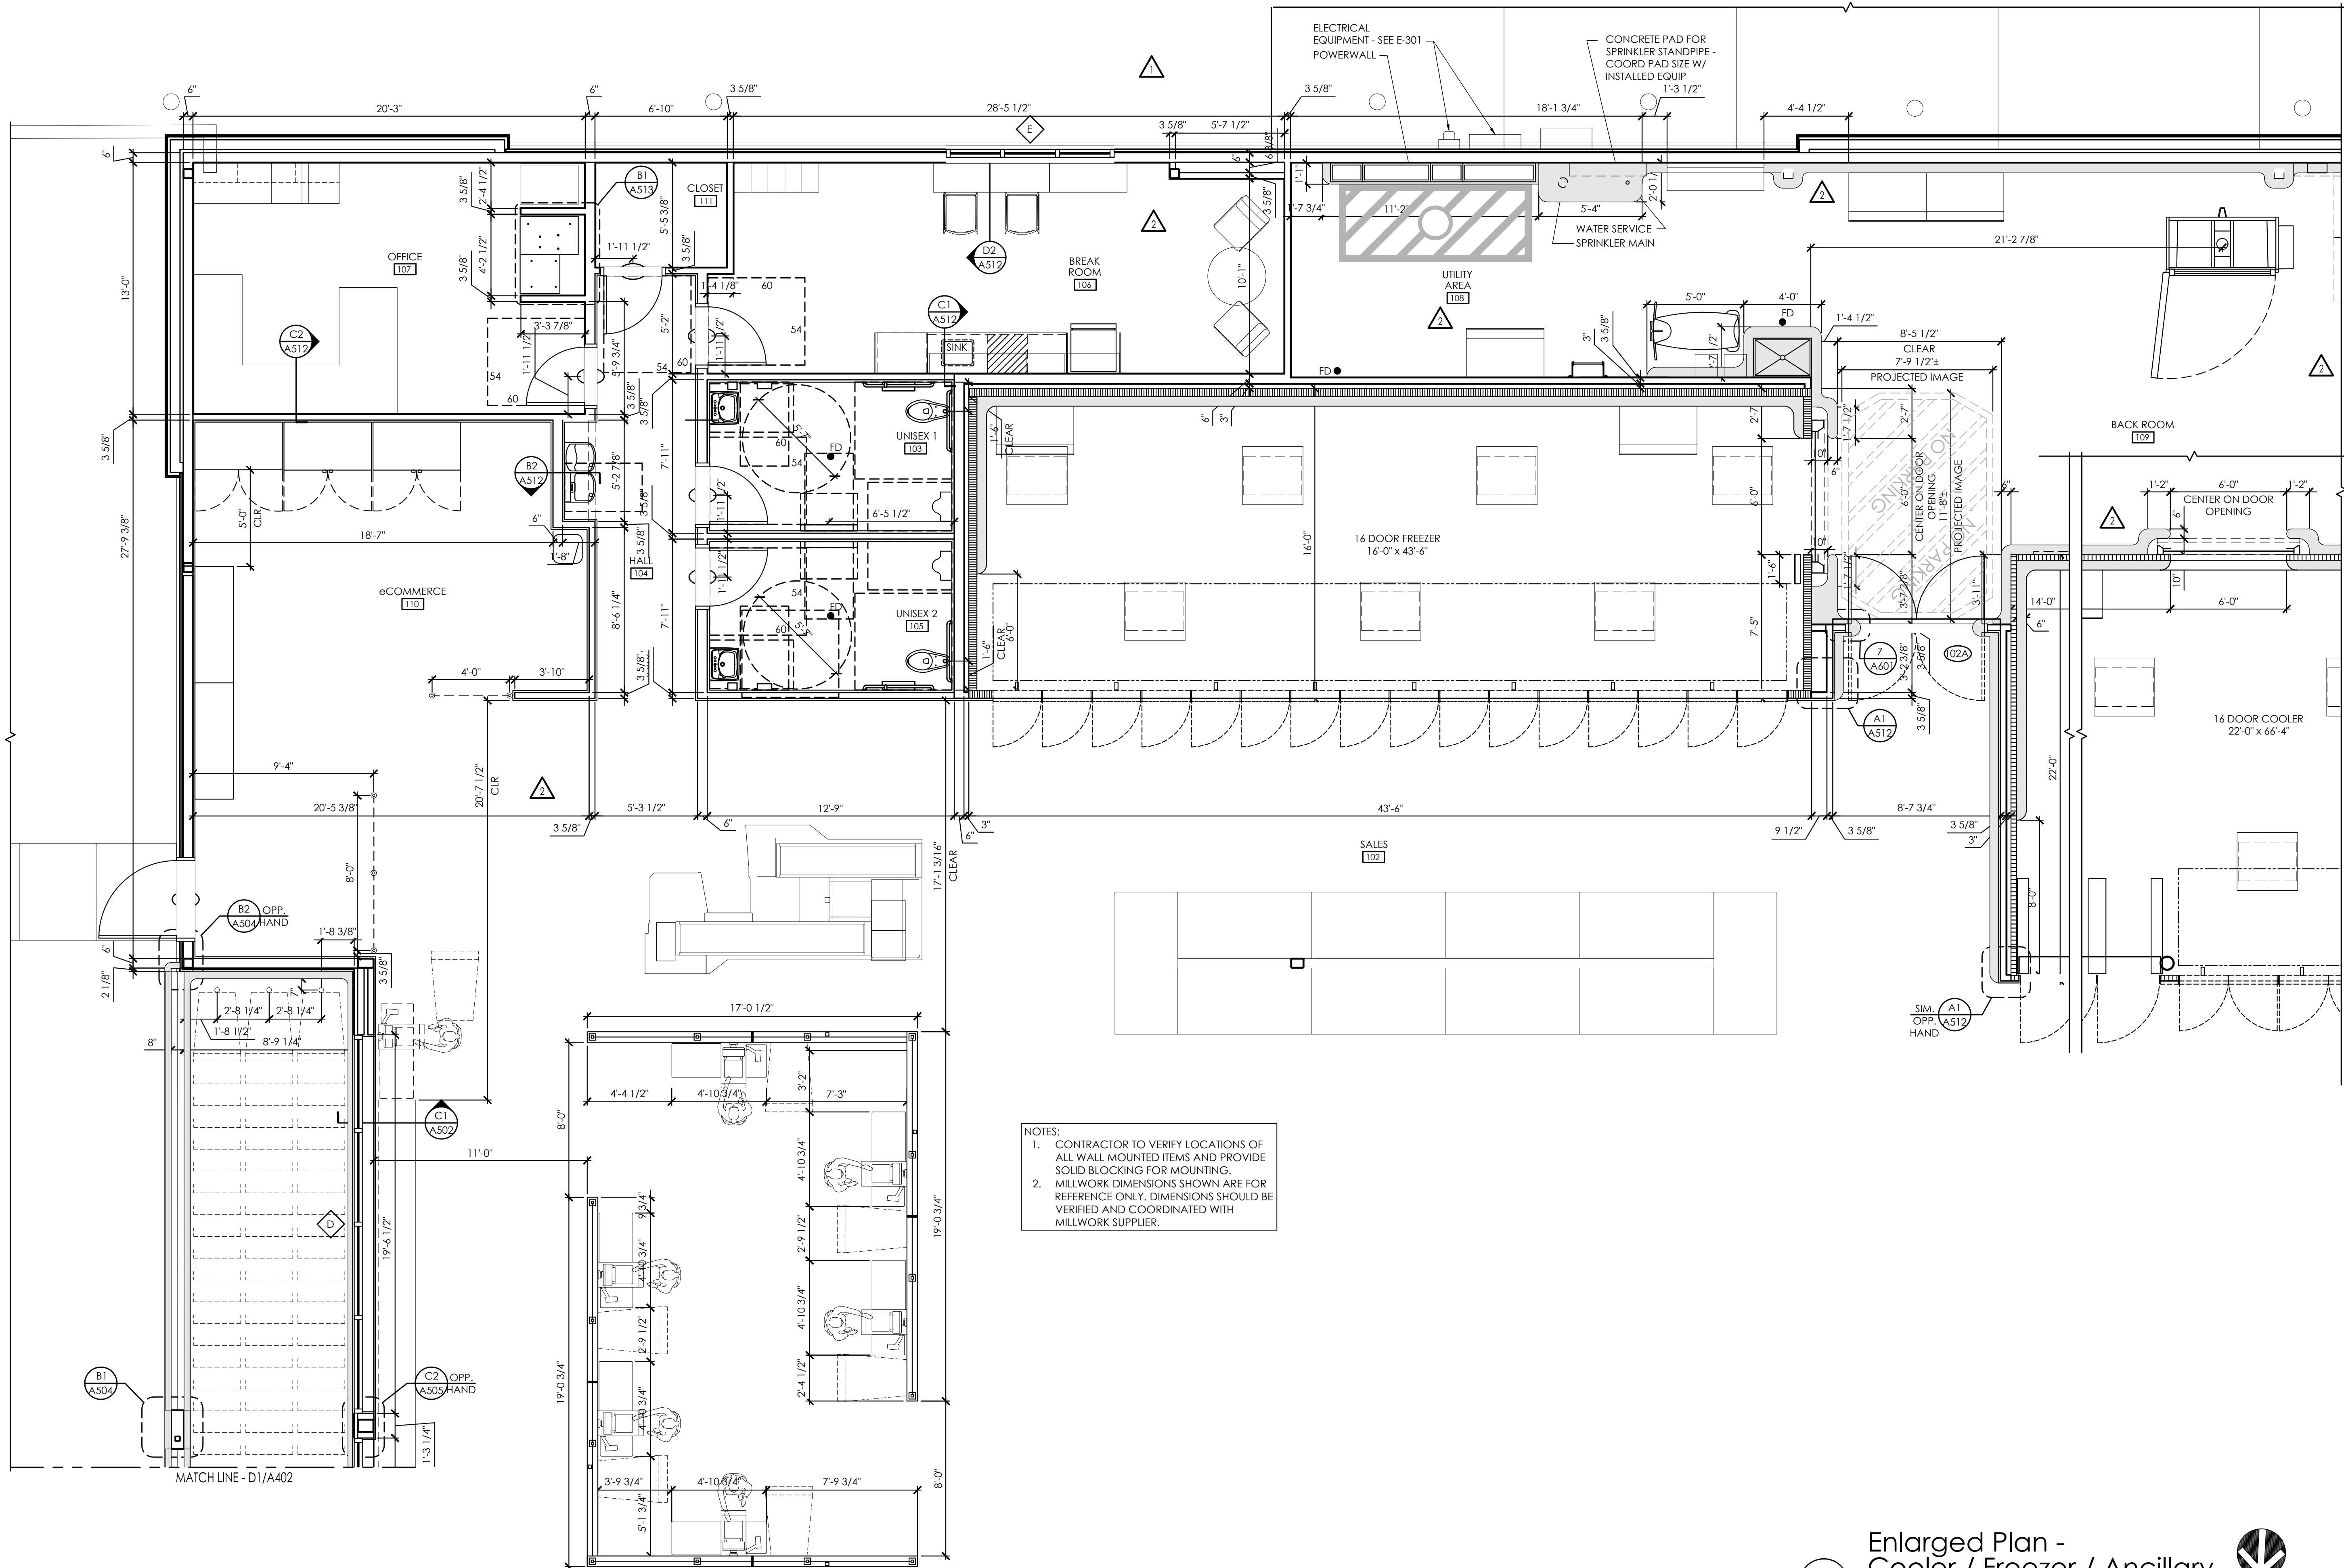

- NOTES:
- CONTRACTOR TO VERIFY LOCATIONS OF ALL WALL MOUNTED ITEMS AND PROVIDE SOLID BLOCKING FOR MOUNTING.
 - MILLWORK DIMENSIONS SHOWN ARE FOR REFERENCE ONLY. DIMENSIONS SHOULD BE VERIFIED AND COORDINATED WITH MILLWORK SUPPLIER.

Enlarged Plan -
Cooler / Freezer / Ancillary
SCALE: 1/4" = 1'-0"



Issued:	Date:
A Issued for Permit	07/08/24
B Issued for Bid	07/29/25
C	
D	
E	

Revisions:	Date:
1 Owner Changes	11/18/24
2 Owner Changes	07/29/25
3	
4	
5	
6	
7	
8	
9	
10	
11	
12	

PROJECT ARCHITECT/ENGINEER
Daniel Sargent
PROJECT LEAD
John Lynch

**NOT FOR
CONSTRUCTION**




ALDI Inc. Store #: 50
Coconut Crossing, FL
12850 Northlake Boulevard
Palm Beach Gardens, FL 33412
Palm Beach County
Project Name & Location:

Enlarged Plans

Drawing Name:	Project No.
Prototype: V7.08 LHRD	22-0267A
Type: GROUND UP	
Drawn By: JWL	A-402
Scale: As Noted	Drawing No.

- NOTES:
- CONTRACTOR TO VERIFY LOCATIONS OF ALL WALL MOUNTED ITEMS AND PROVIDE SOLID BLOCKING FOR MOUNTING.
 - MILLWORK DIMENSIONS SHOWN ARE FOR REFERENCE ONLY. DIMENSIONS SHOULD BE VERIFIED AND COORDINATED WITH MILLWORK SUPPLIER.

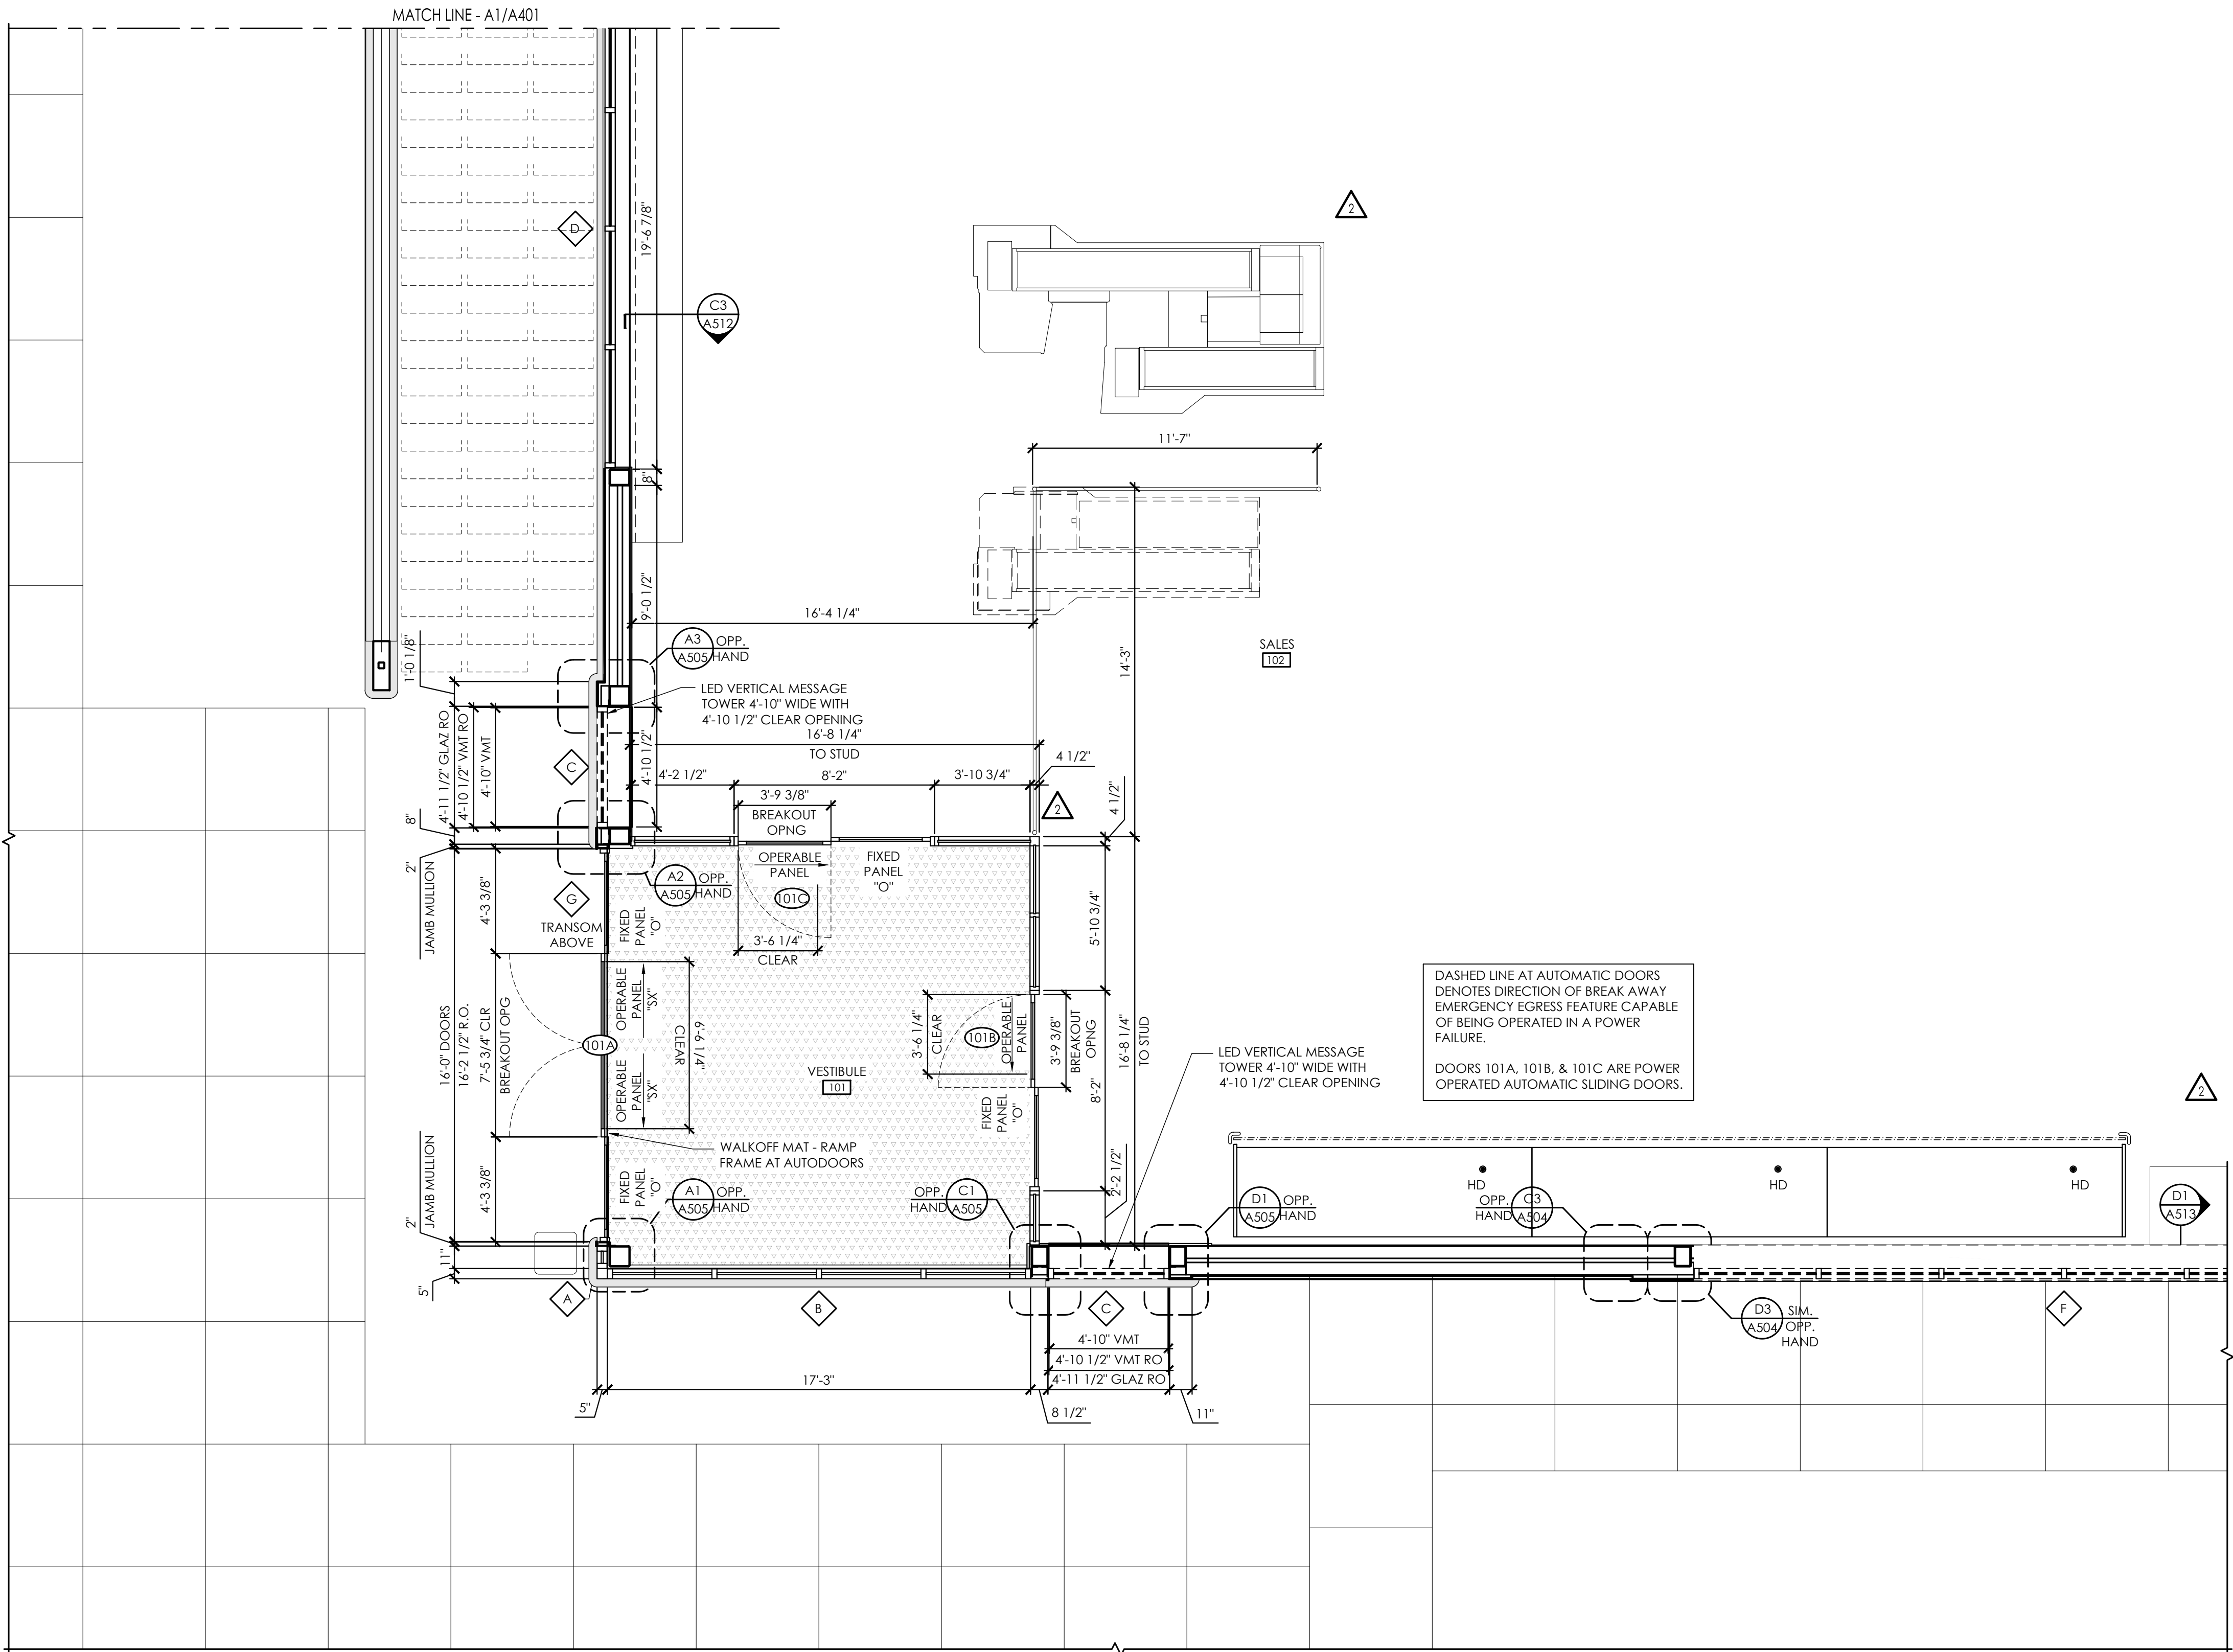


Enlarged Plan -
Entry

SCALE: 1/4" = 1'-0"




PLOTTED: 7/19/2025 9:46 AM

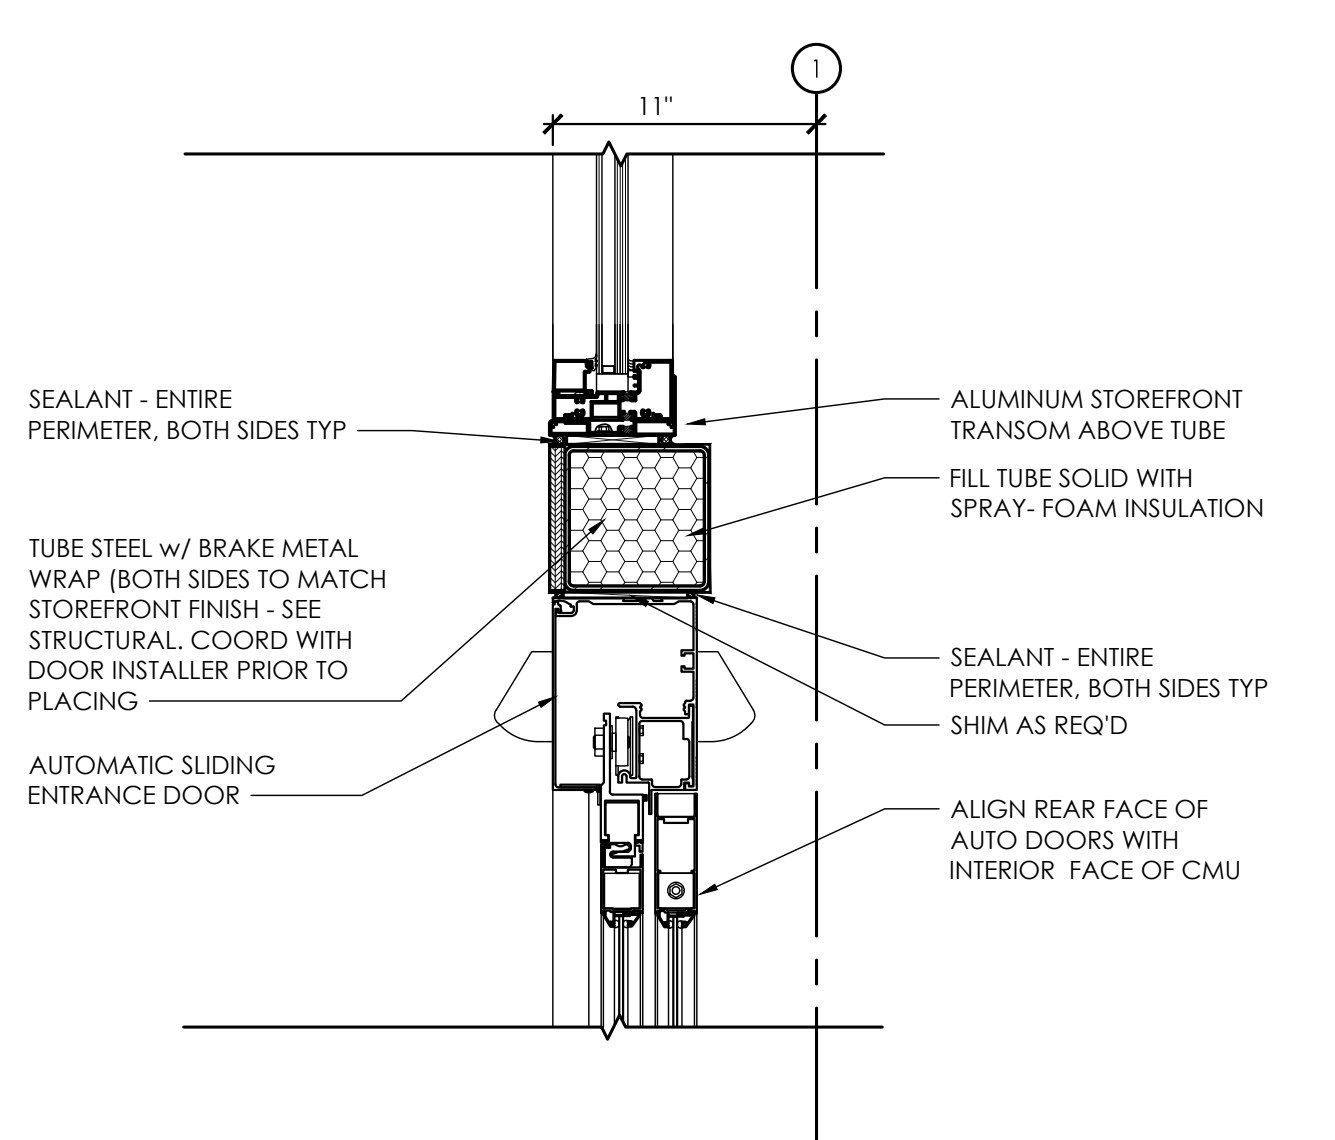


Exterior Section Detail -
Tube Steel at Auto Sliding Door

SCALE: 1 1/2" = 1'-0"

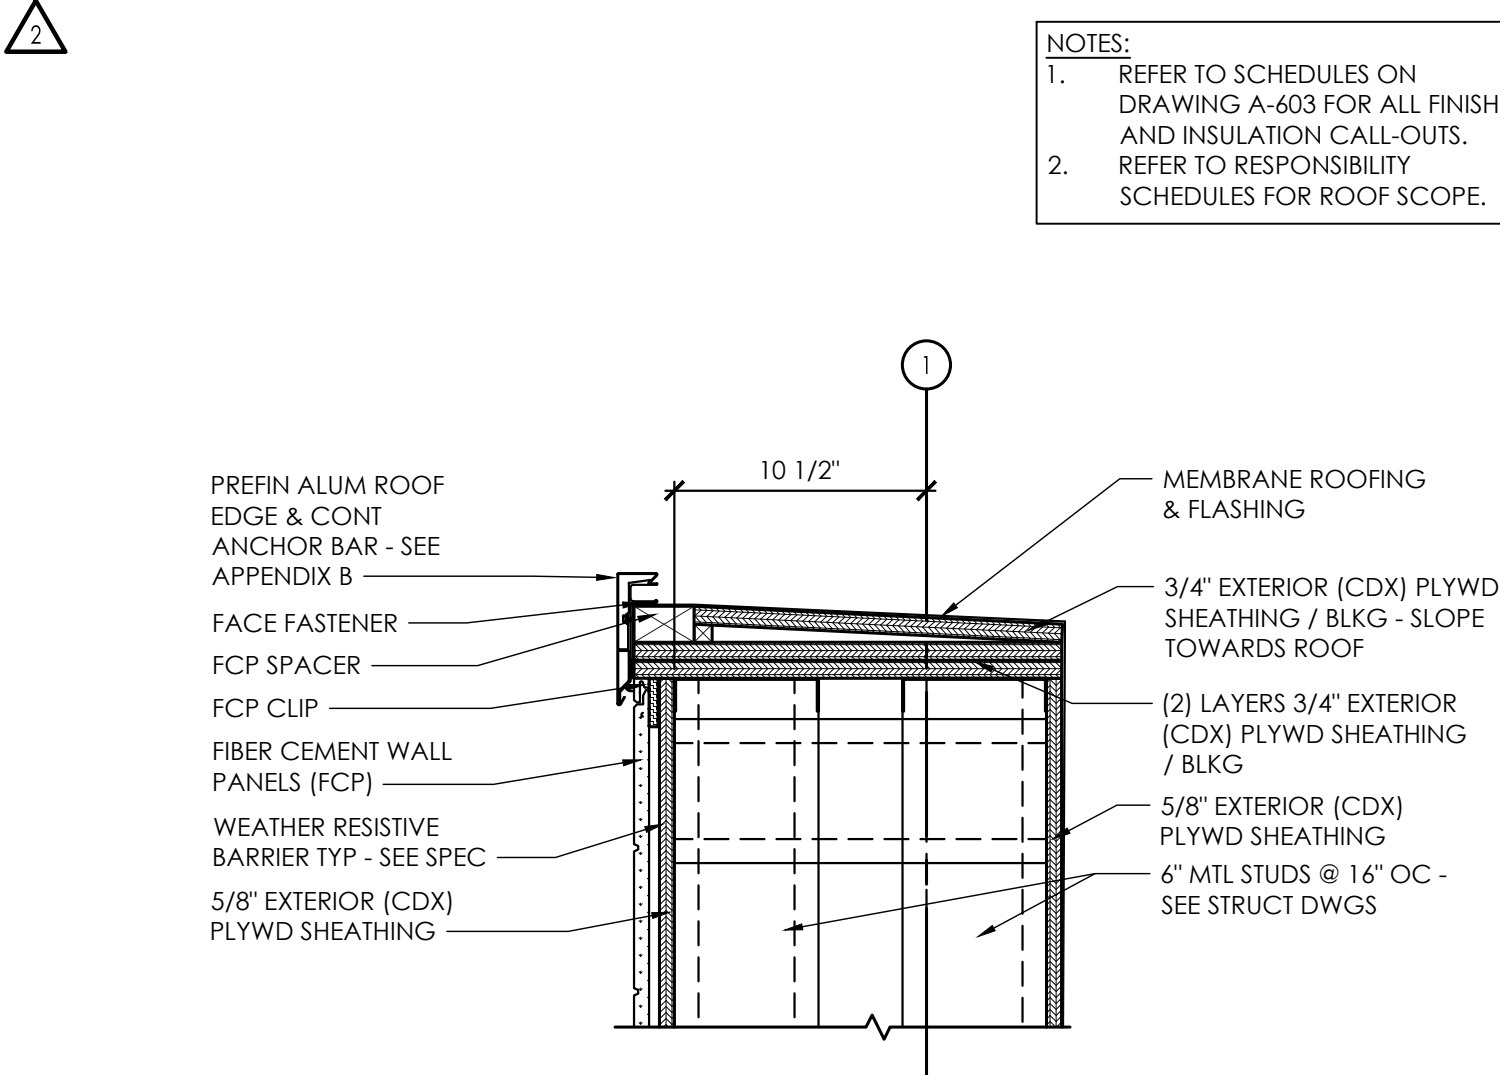


Exterior Section Detail -
ACP to FCP Transition

SCALE: 1 1/2" = 1'-0"

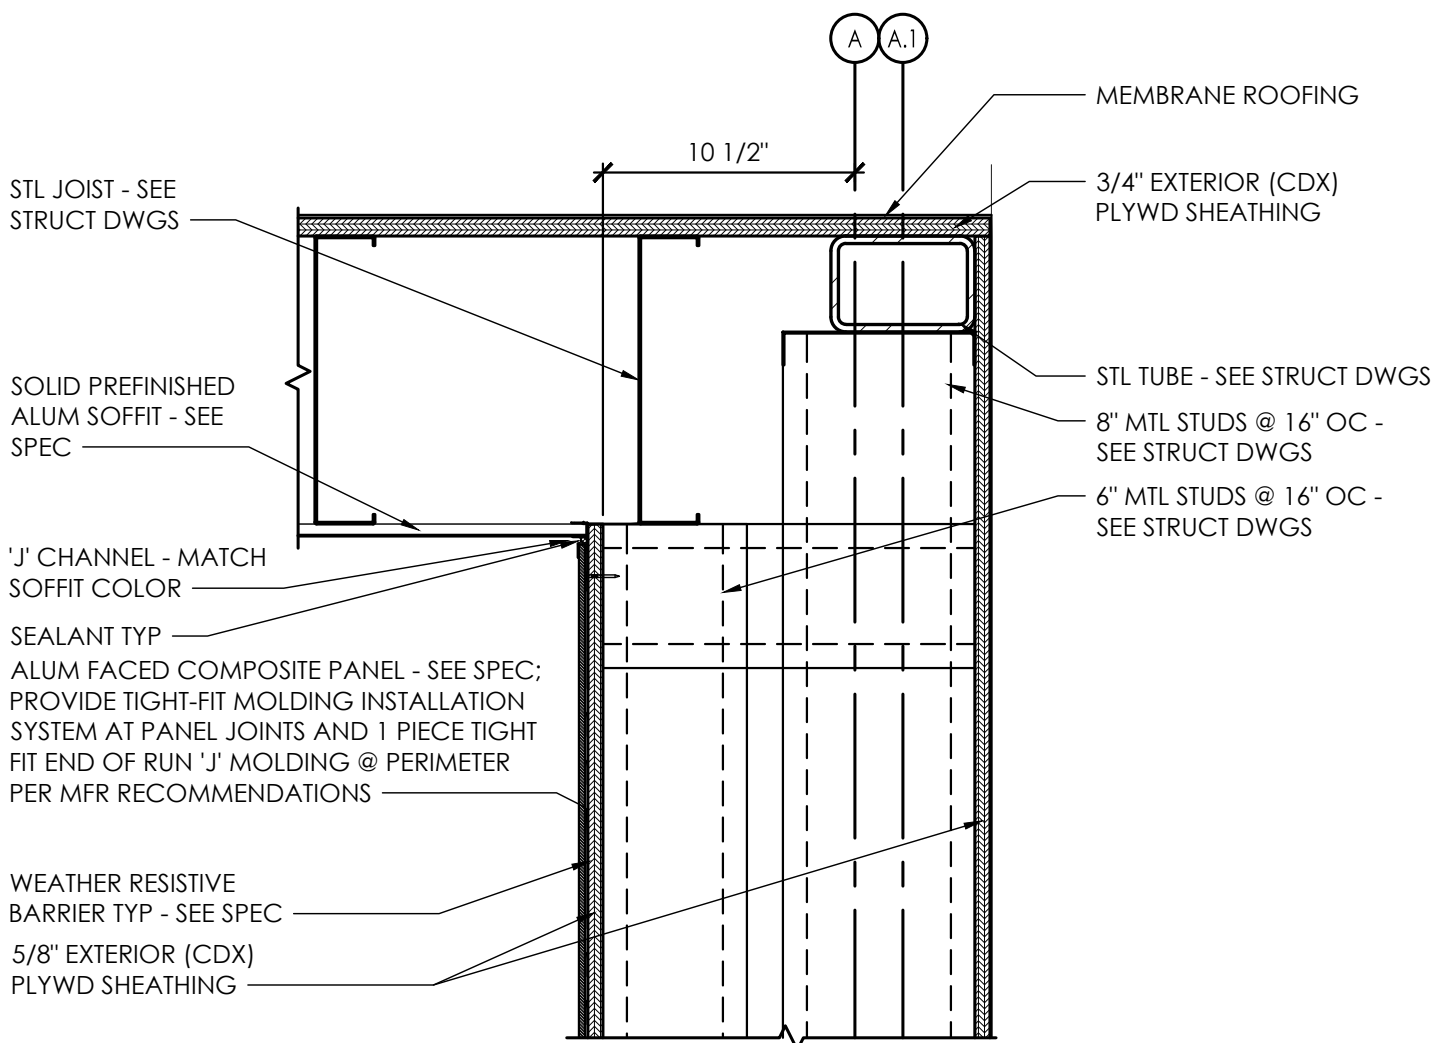


Exterior Section Detail -
ACP at Long Wall High Roof Parapet

SCALE: 1 1/2" = 1'-0"

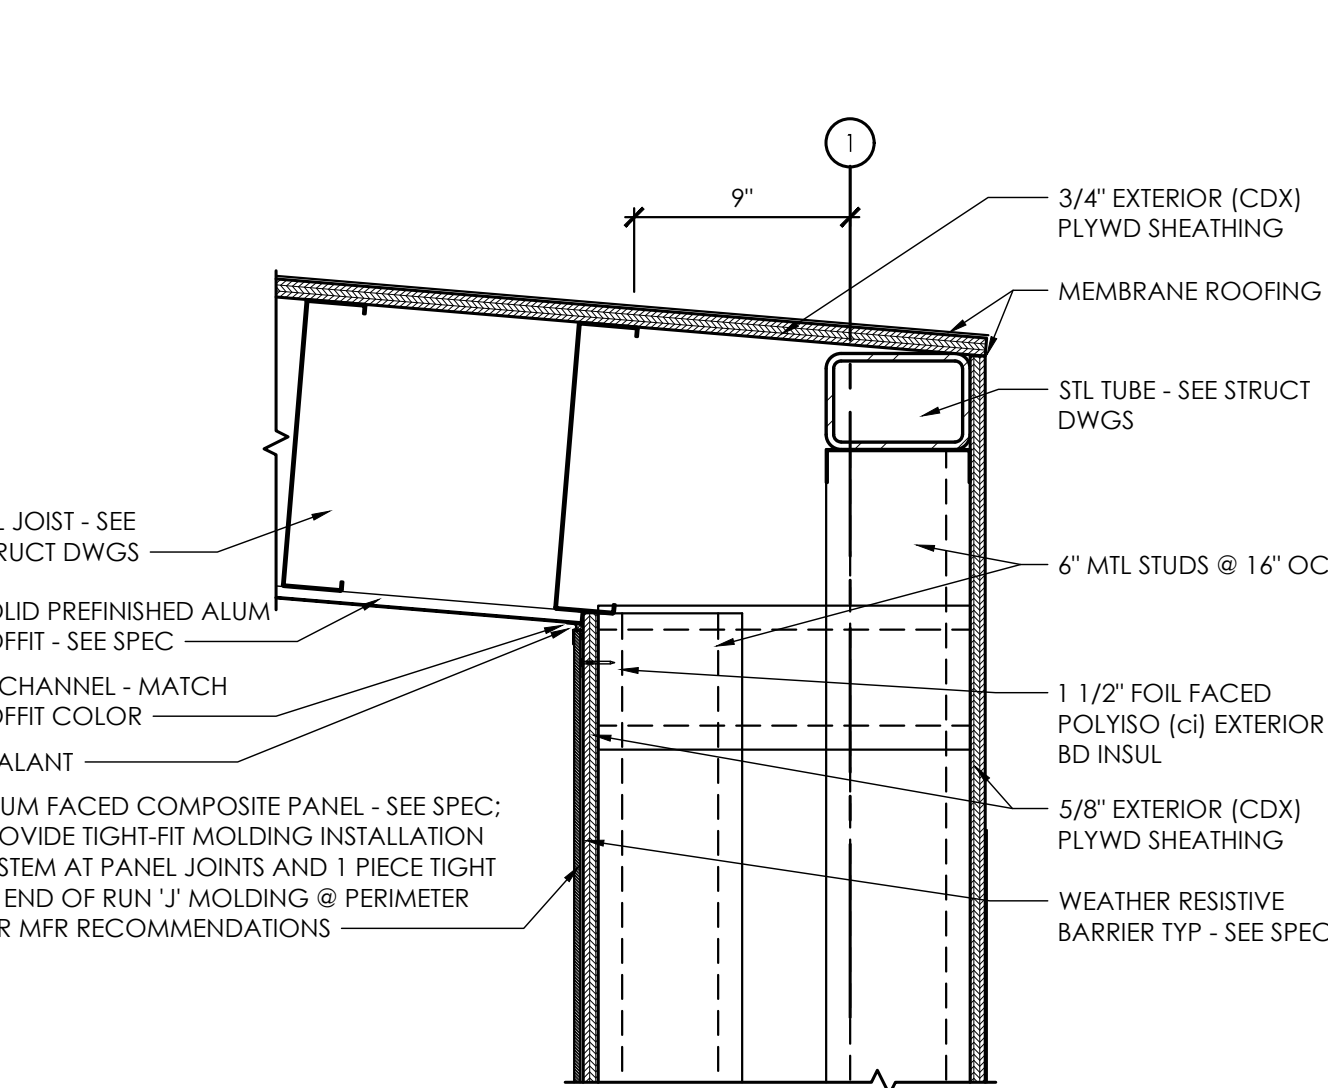


Exterior Section Detail -
ACP at Short Wall High Roof Parapet

SCALE: 1 1/2" = 1'-0"

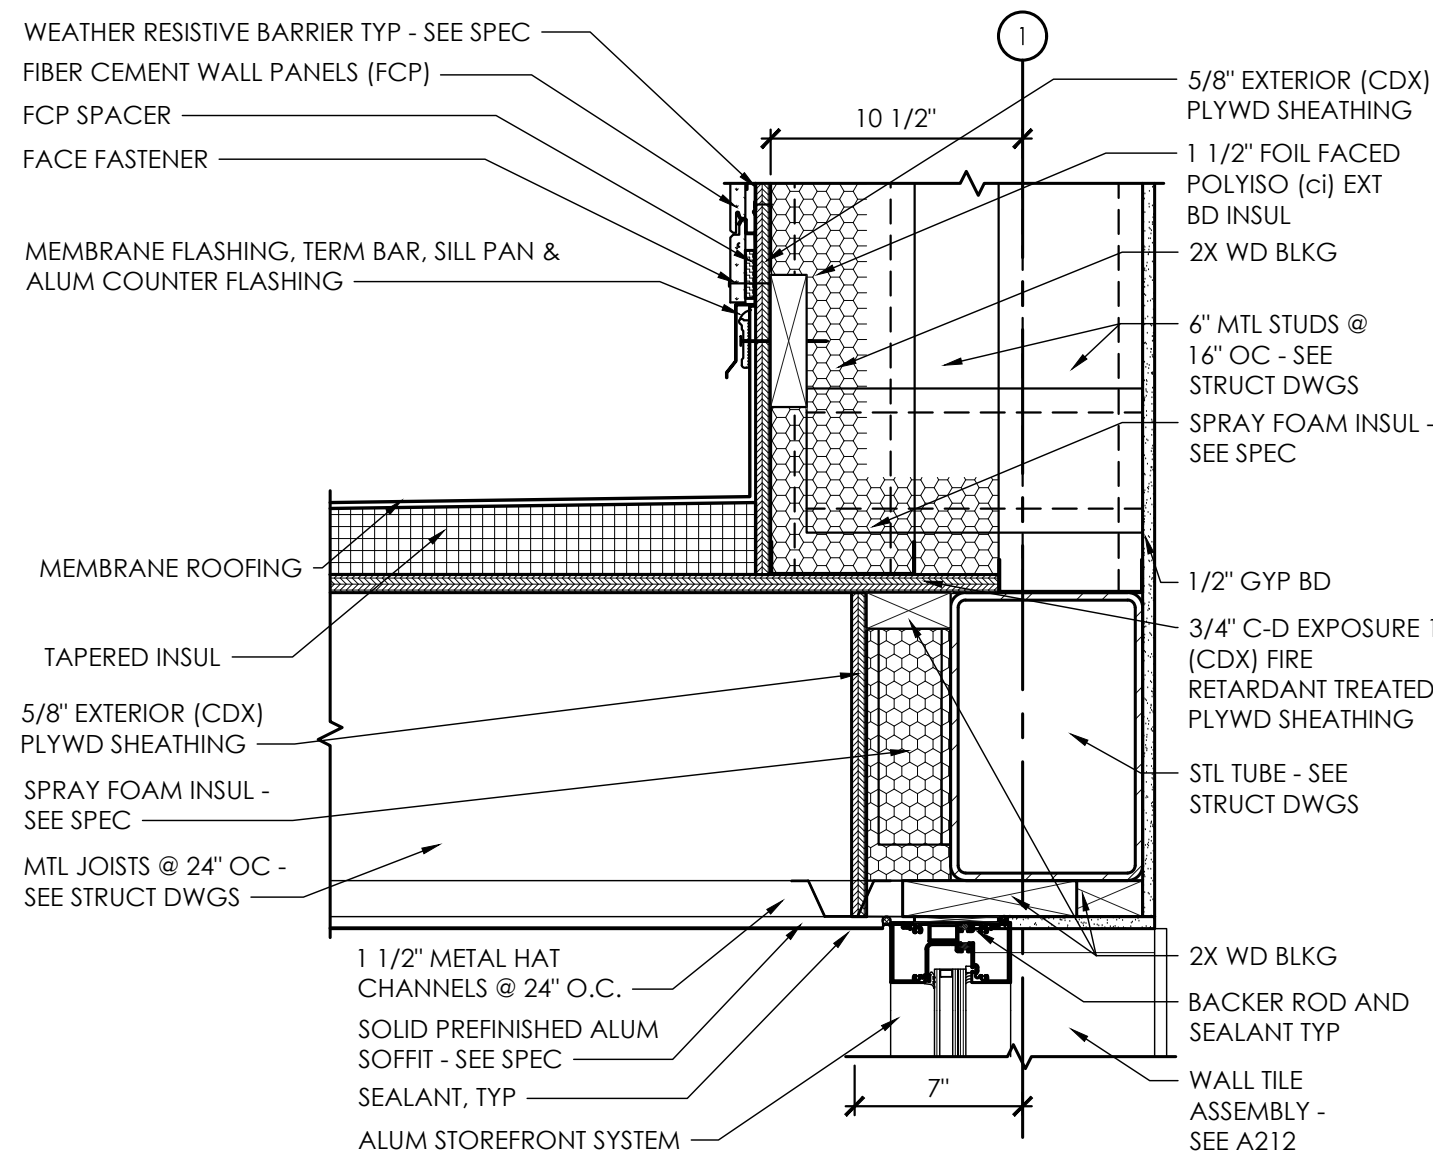


Exterior Section Detail -
Canopy Roof at Storefront

SCALE: 1 1/2" = 1'-0"

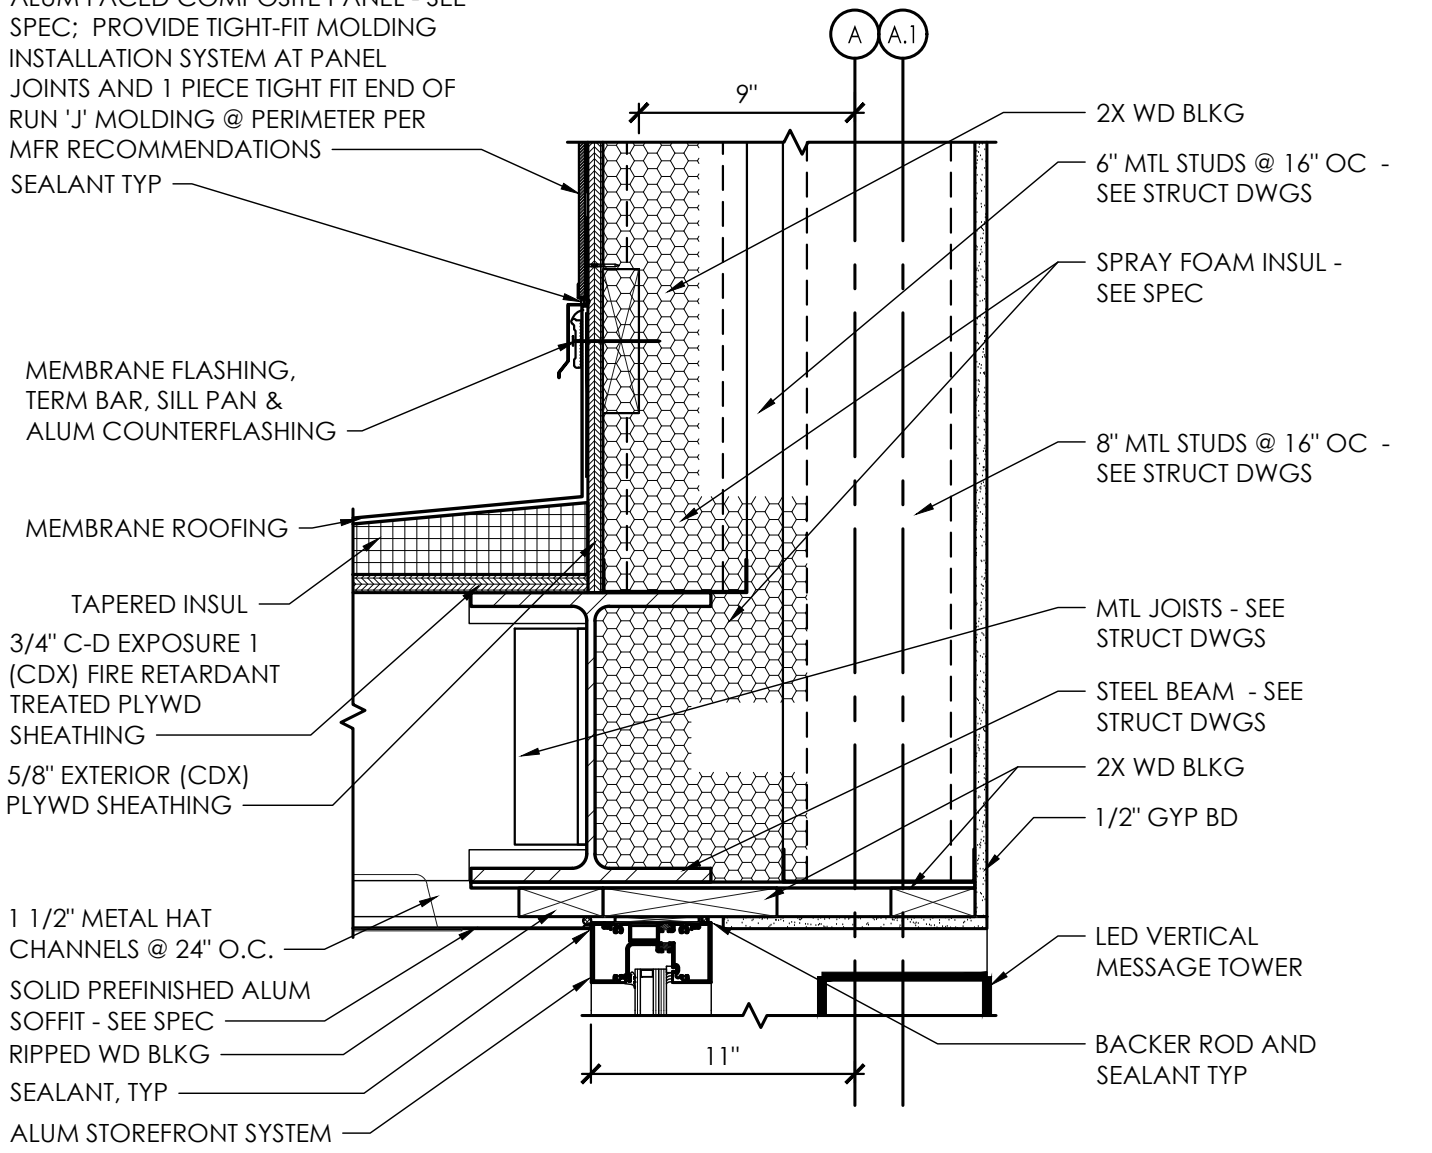


Exterior Section Detail -
Vertical Message Tower Head

SCALE: 1 1/2" = 1'-0"

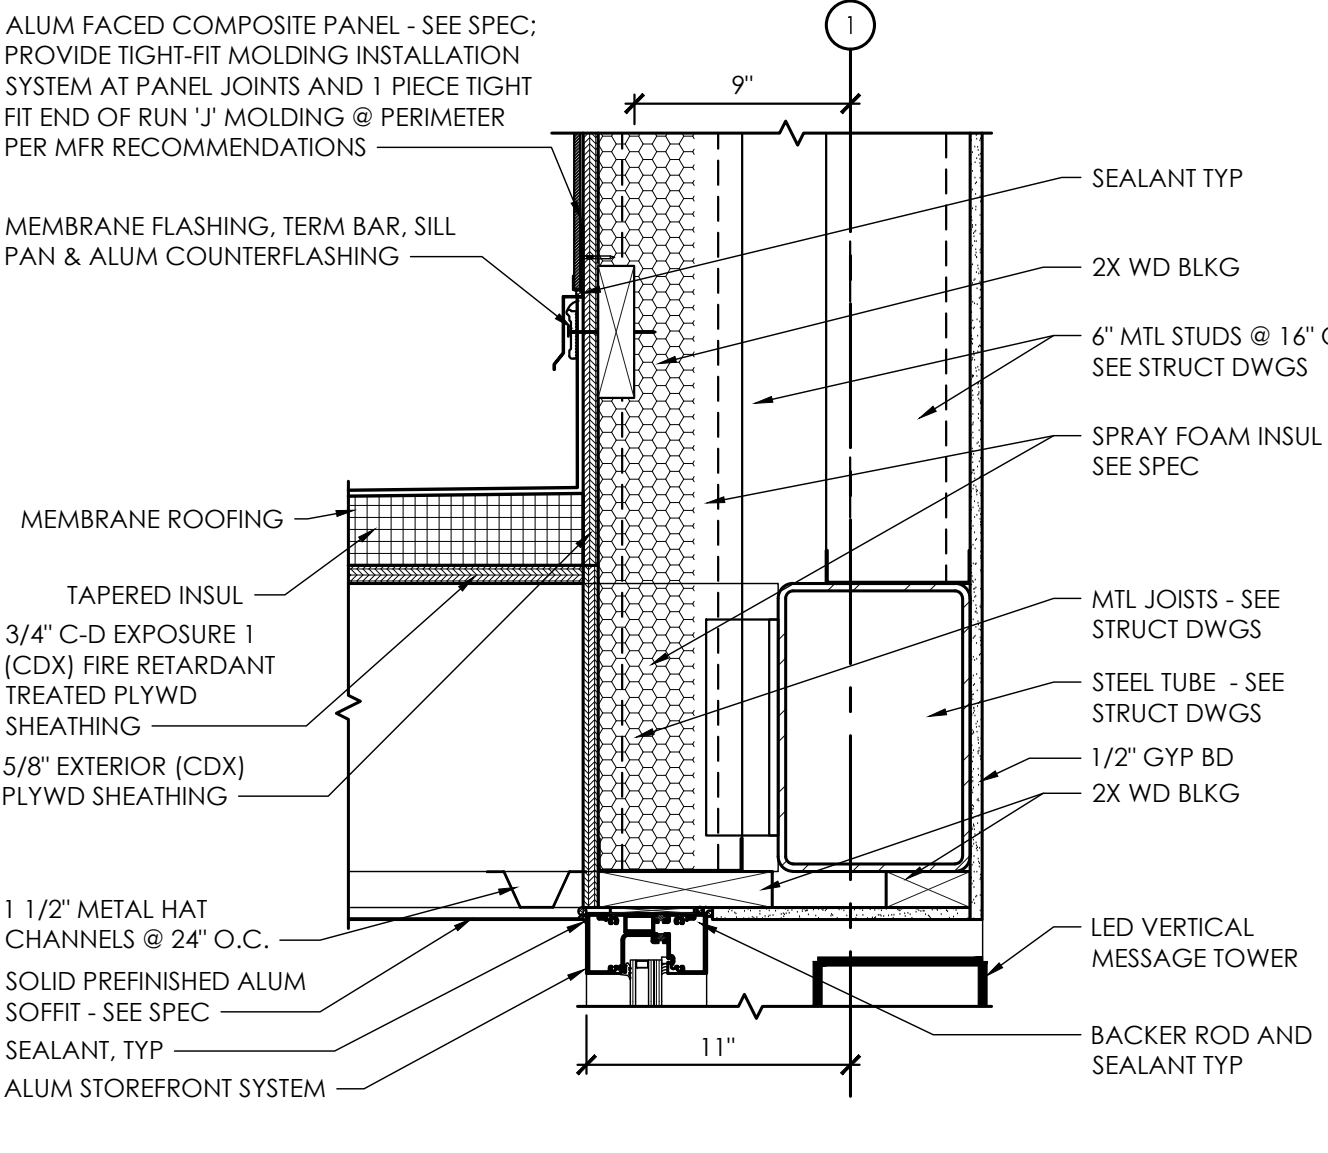


Exterior Section Detail -
Vertical Message Tower Head

SCALE: 1 1/2" = 1'-0"

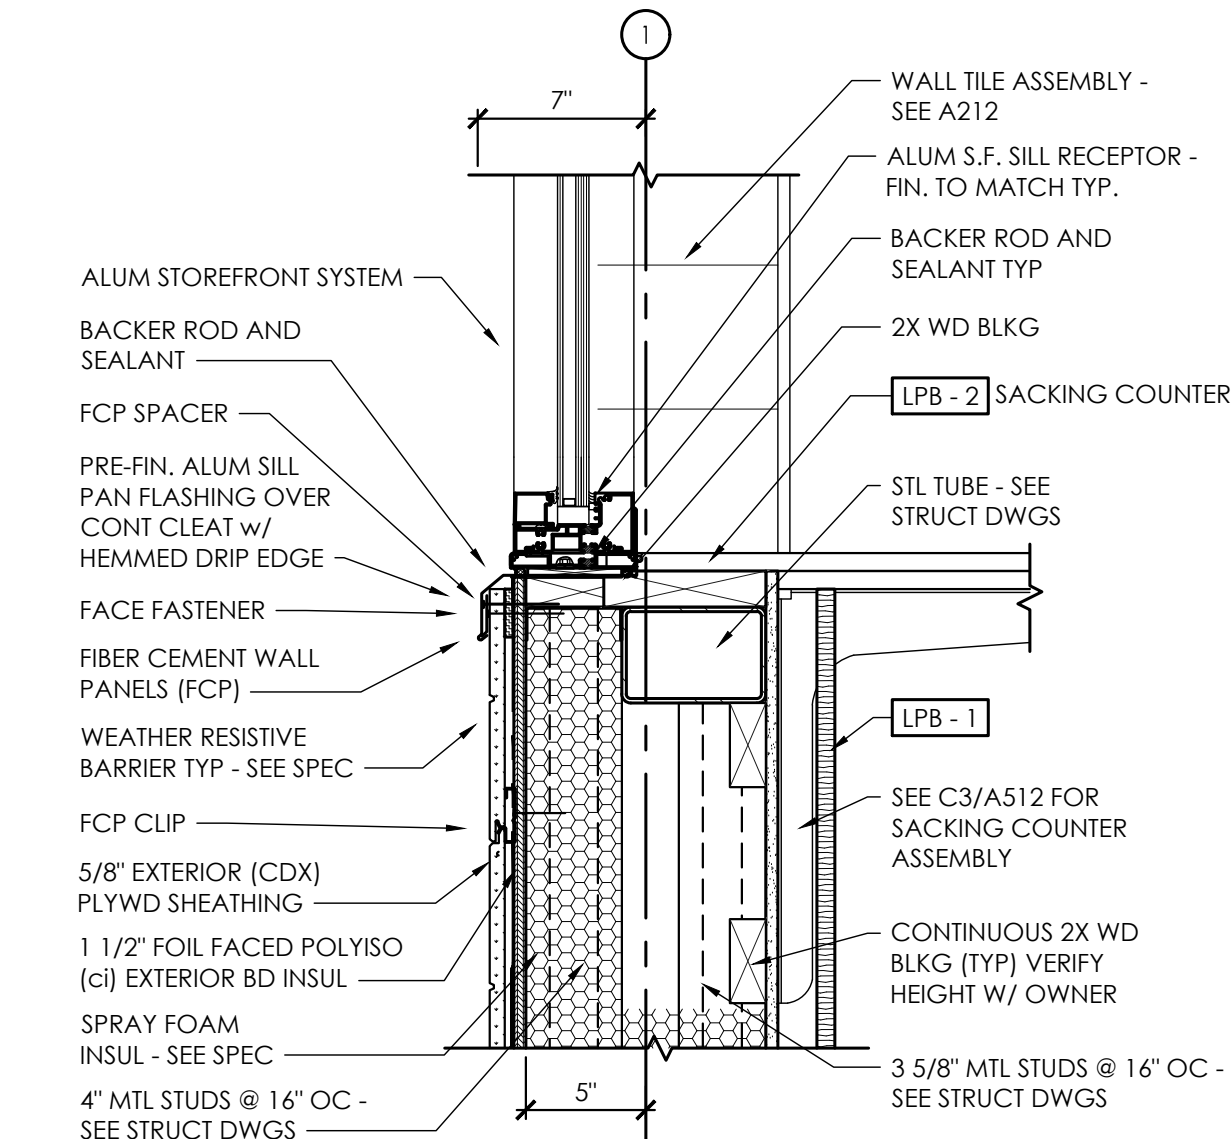


Exterior Section Detail -
Storefront Sill at Sacking Counter

SCALE: 1 1/2" = 1'-0"

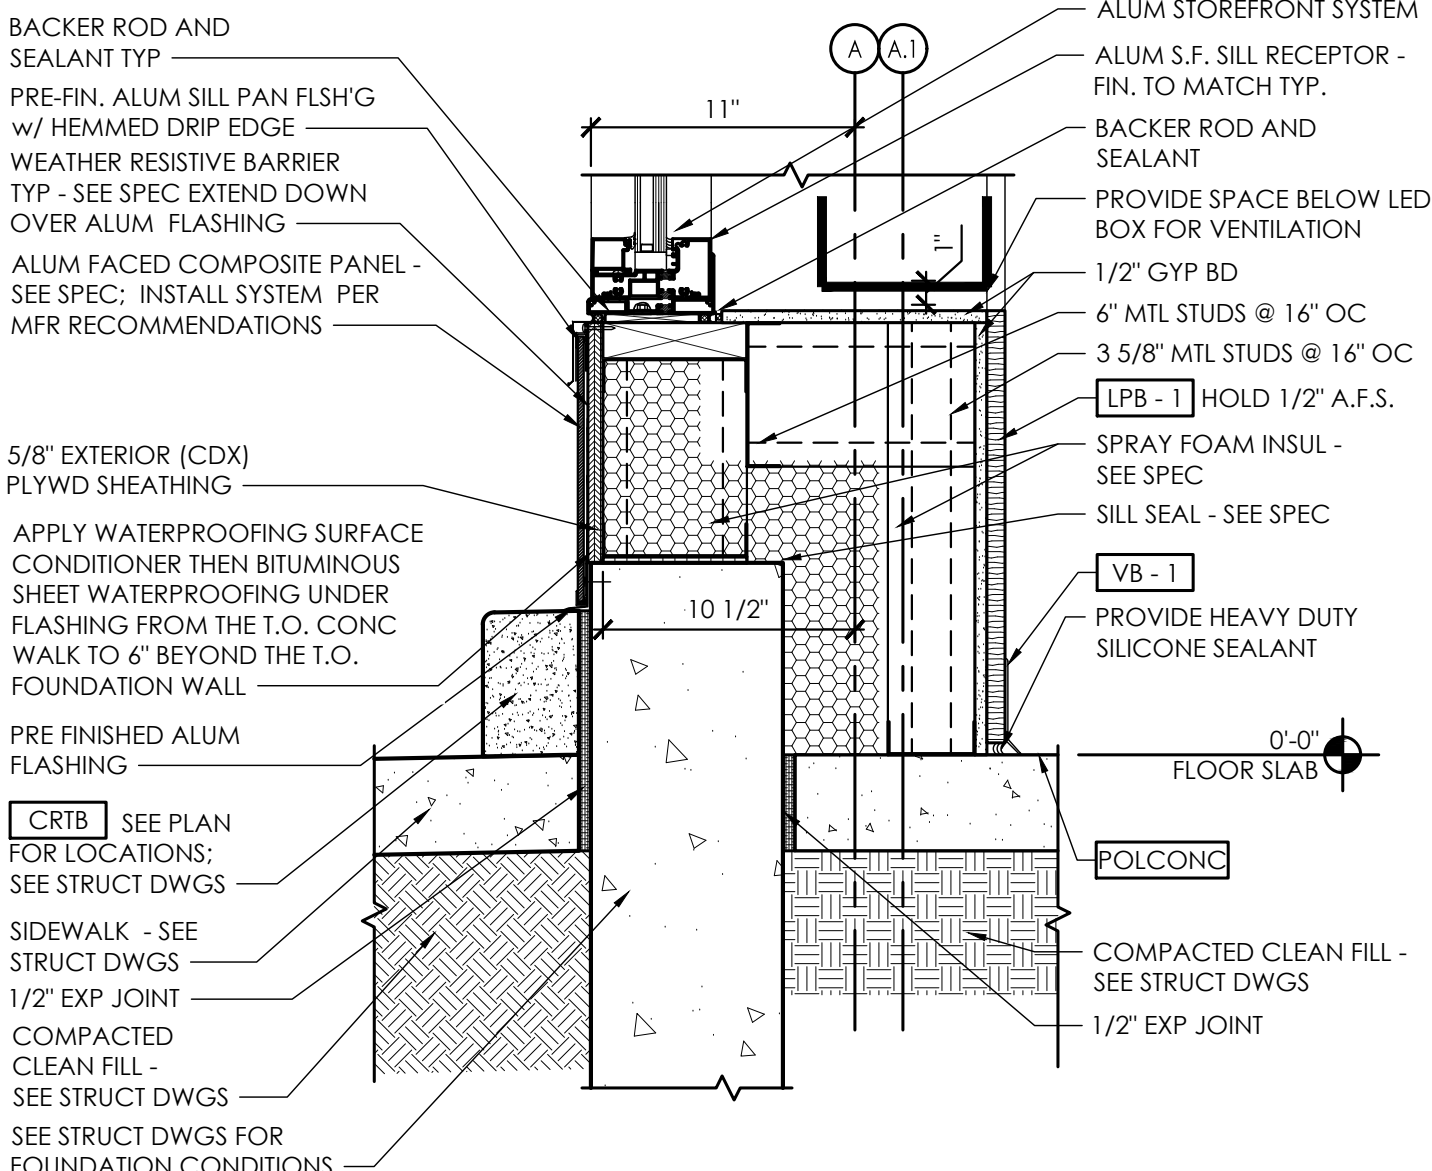

Exterior Section Detail -
Vertical Message Tower Sill

SCALE: 1 1/2" = 1'-0"

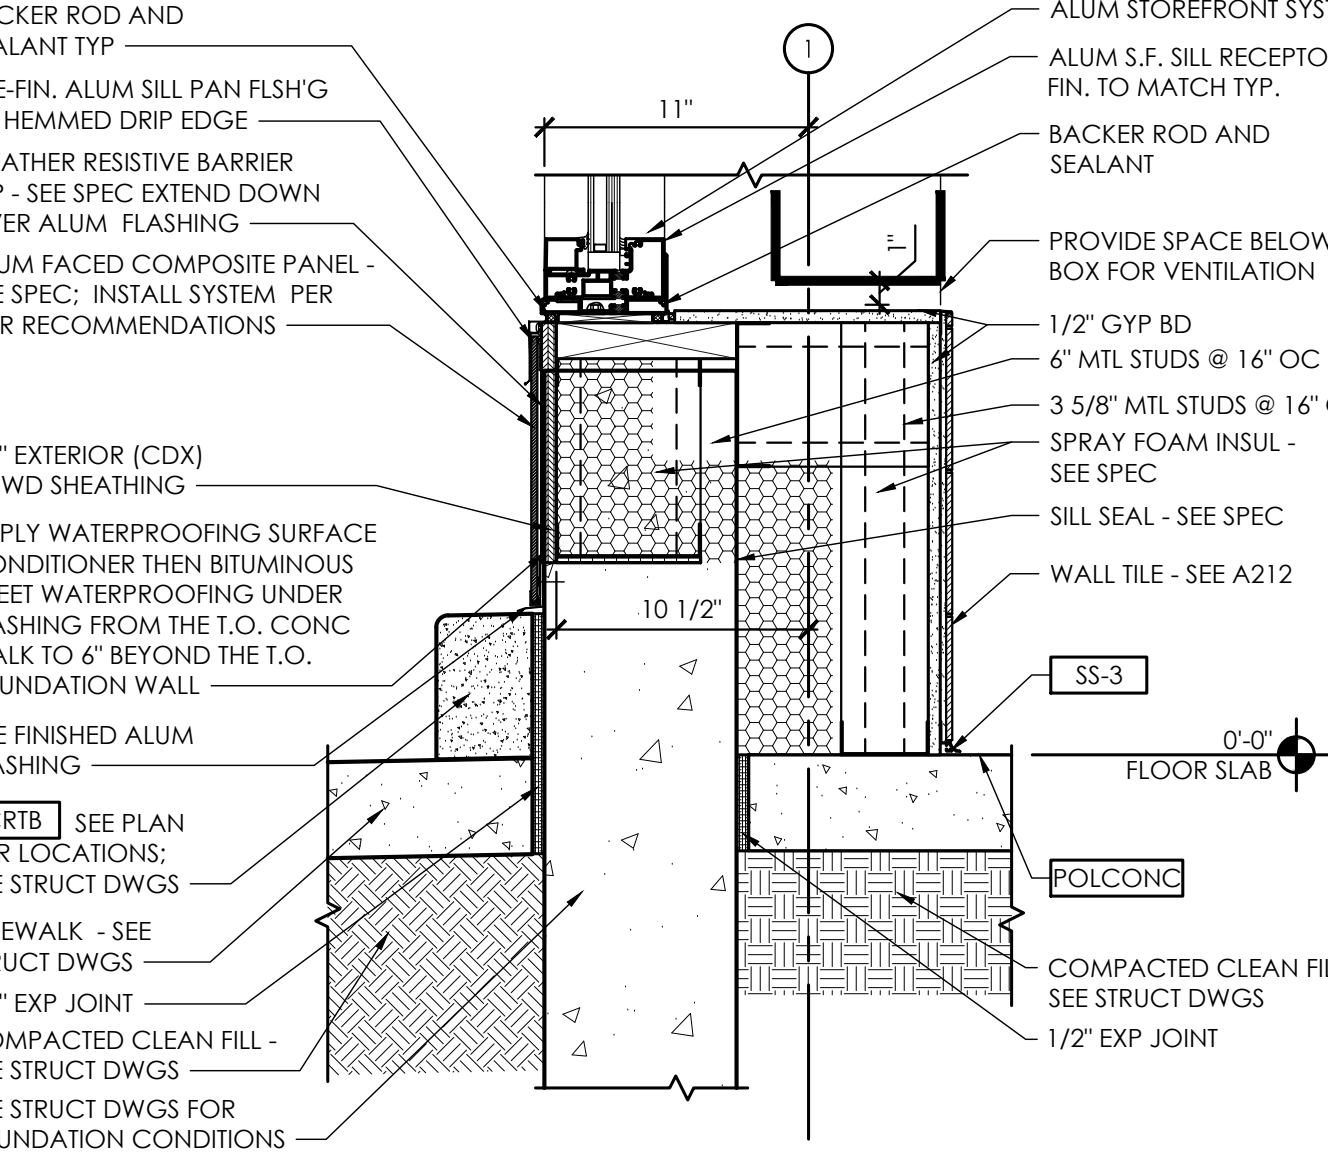

Exterior Section Detail -
Vertical Message Tower Sill

SCALE: 1 1/2" = 1'-0"

Copyright © 2024

APD Engineering & Architecture

03/17/2024

Drawing Alteration

It is a violation of law for any person, unless acting under the direction of licensed Architect, Professional Engineer, Landscape Architect, or Land Surveyor to alter any item on this document in any way. Any licensee who alters this document is required by law to affix his or her seal and to add the notation "Altered By" followed by his or her signature and the specific description of the alteration or revision.

DO NOT SCALE PLANS

Copying, Printing, Software and other processes required to produce these prints can stretch or shrink the actual paper or layout. Therefore, scaling of this drawing may be inaccurate. Contact APD E&A with any need for additional dimensions or clarifications.

Issued: Date:

A Issued for Permit 07/08/24

B Issued for Bid 07/29/25

C

D

E

Revisions: Date:

1 Owner Changes 11/18/24

2 Owner Changes 07/29/25

3

4

5

6

7

8

9

10

11

12

PROJECT ARCHITECT/ENGINEER


Daniel Sargent

PROJECT LEAD

John Lynch

NOT FOR
CONSTRUCTION

Seal Seal

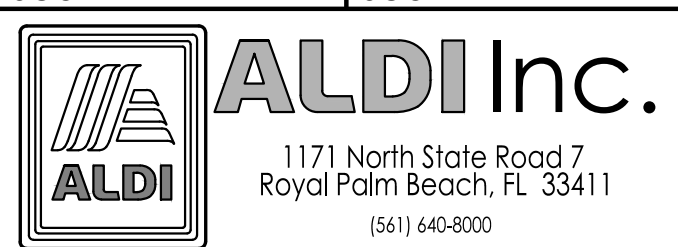

ALDI Inc. Store #: 50
Coconut Crossing, FL

12850 Northlake Boulevard
Palm Beach Gardens, FL 33412

Palm Beach County

Project Name & Location:

Exterior

Details

Drawing Name:

Prototype:

Project No.

V7.08 LHRD

22-0267A

Type:

GROUND UP

Drawn By:

JAH

Scale:

A-502

As Noted


Drawing No.

D

C

B


A

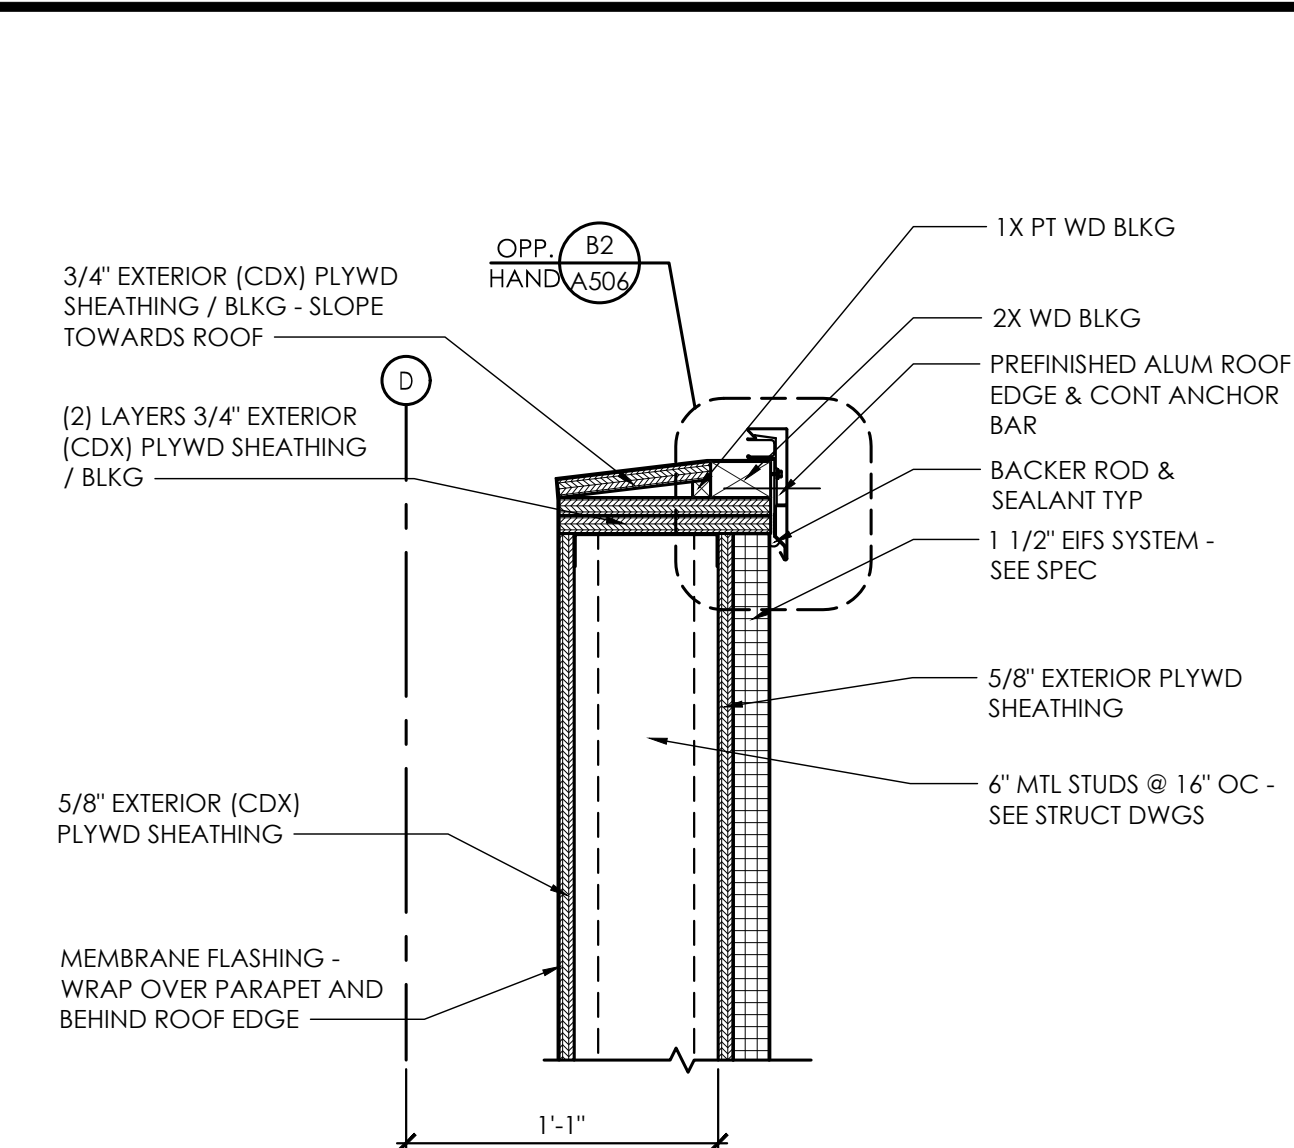

Exterior Detail -
Parapet

A3


SCALE: 1 1/2" = 1'-0"

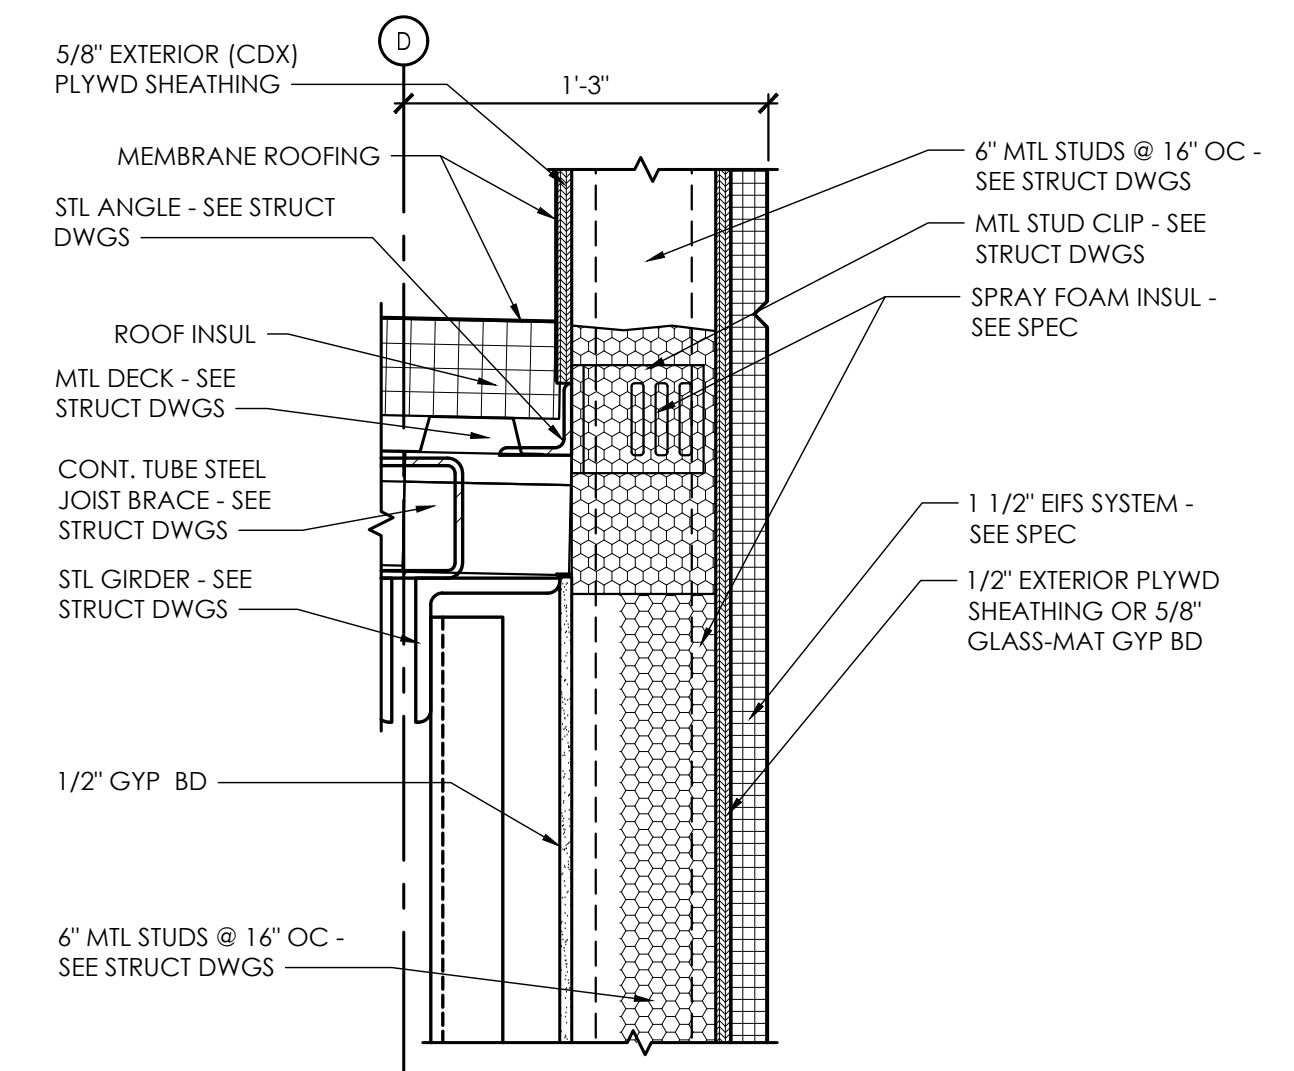

Exterior Section Detail -
Low Joist Bearing

A2

SCALE: 1 1/2" = 1'-0"

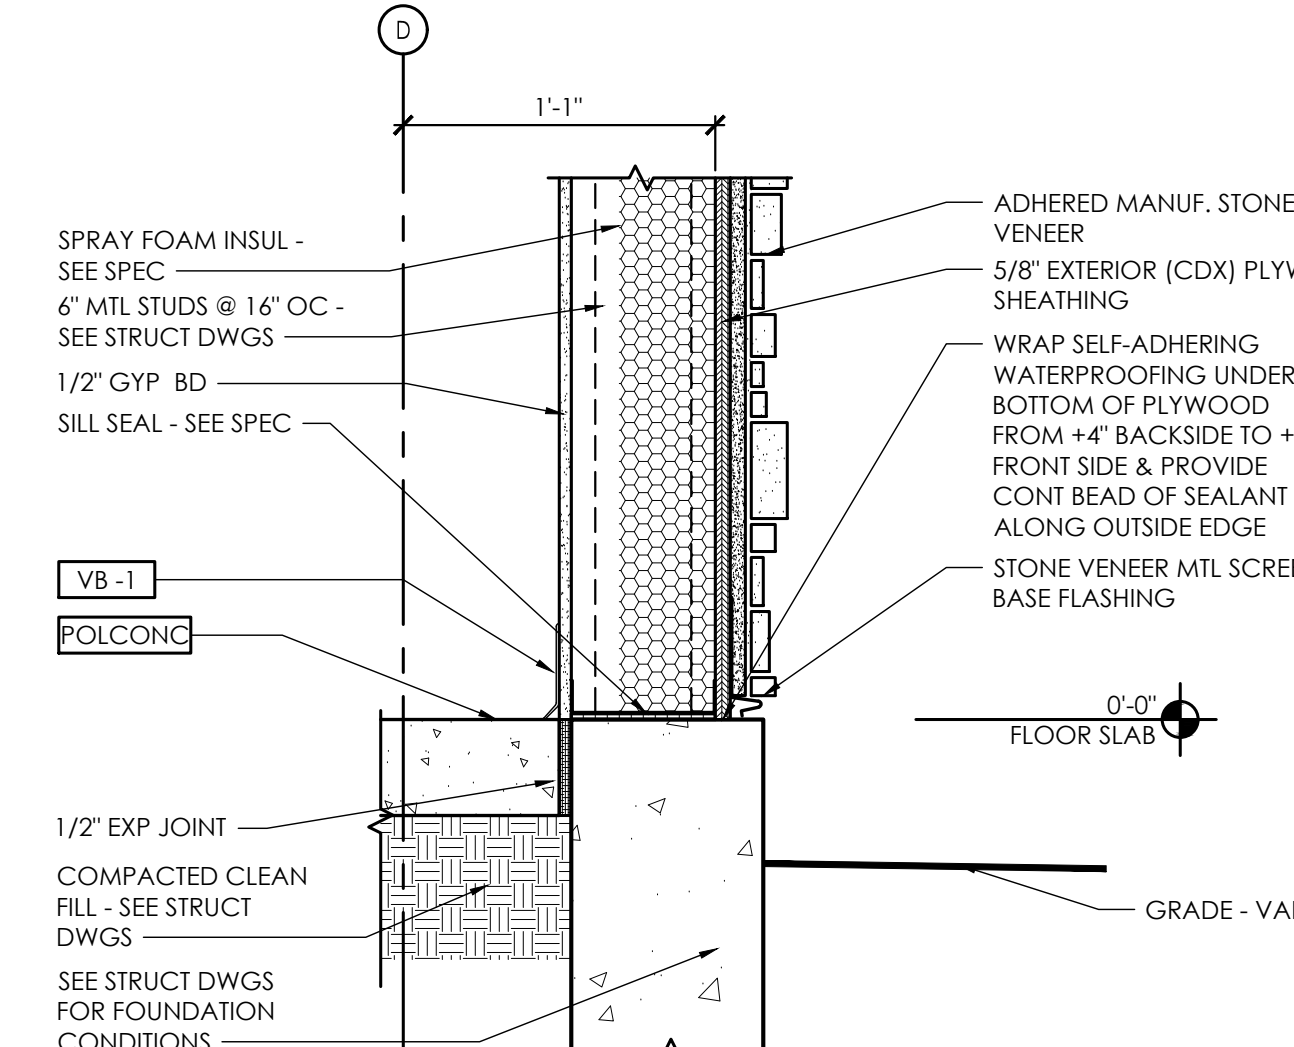


Exterior Section Detail -
Masonry Veneer Wall Base

A1

SCALE: 1 1/2" = 1'-0"

PLOTTED: 7/29/2025 9:47 AM

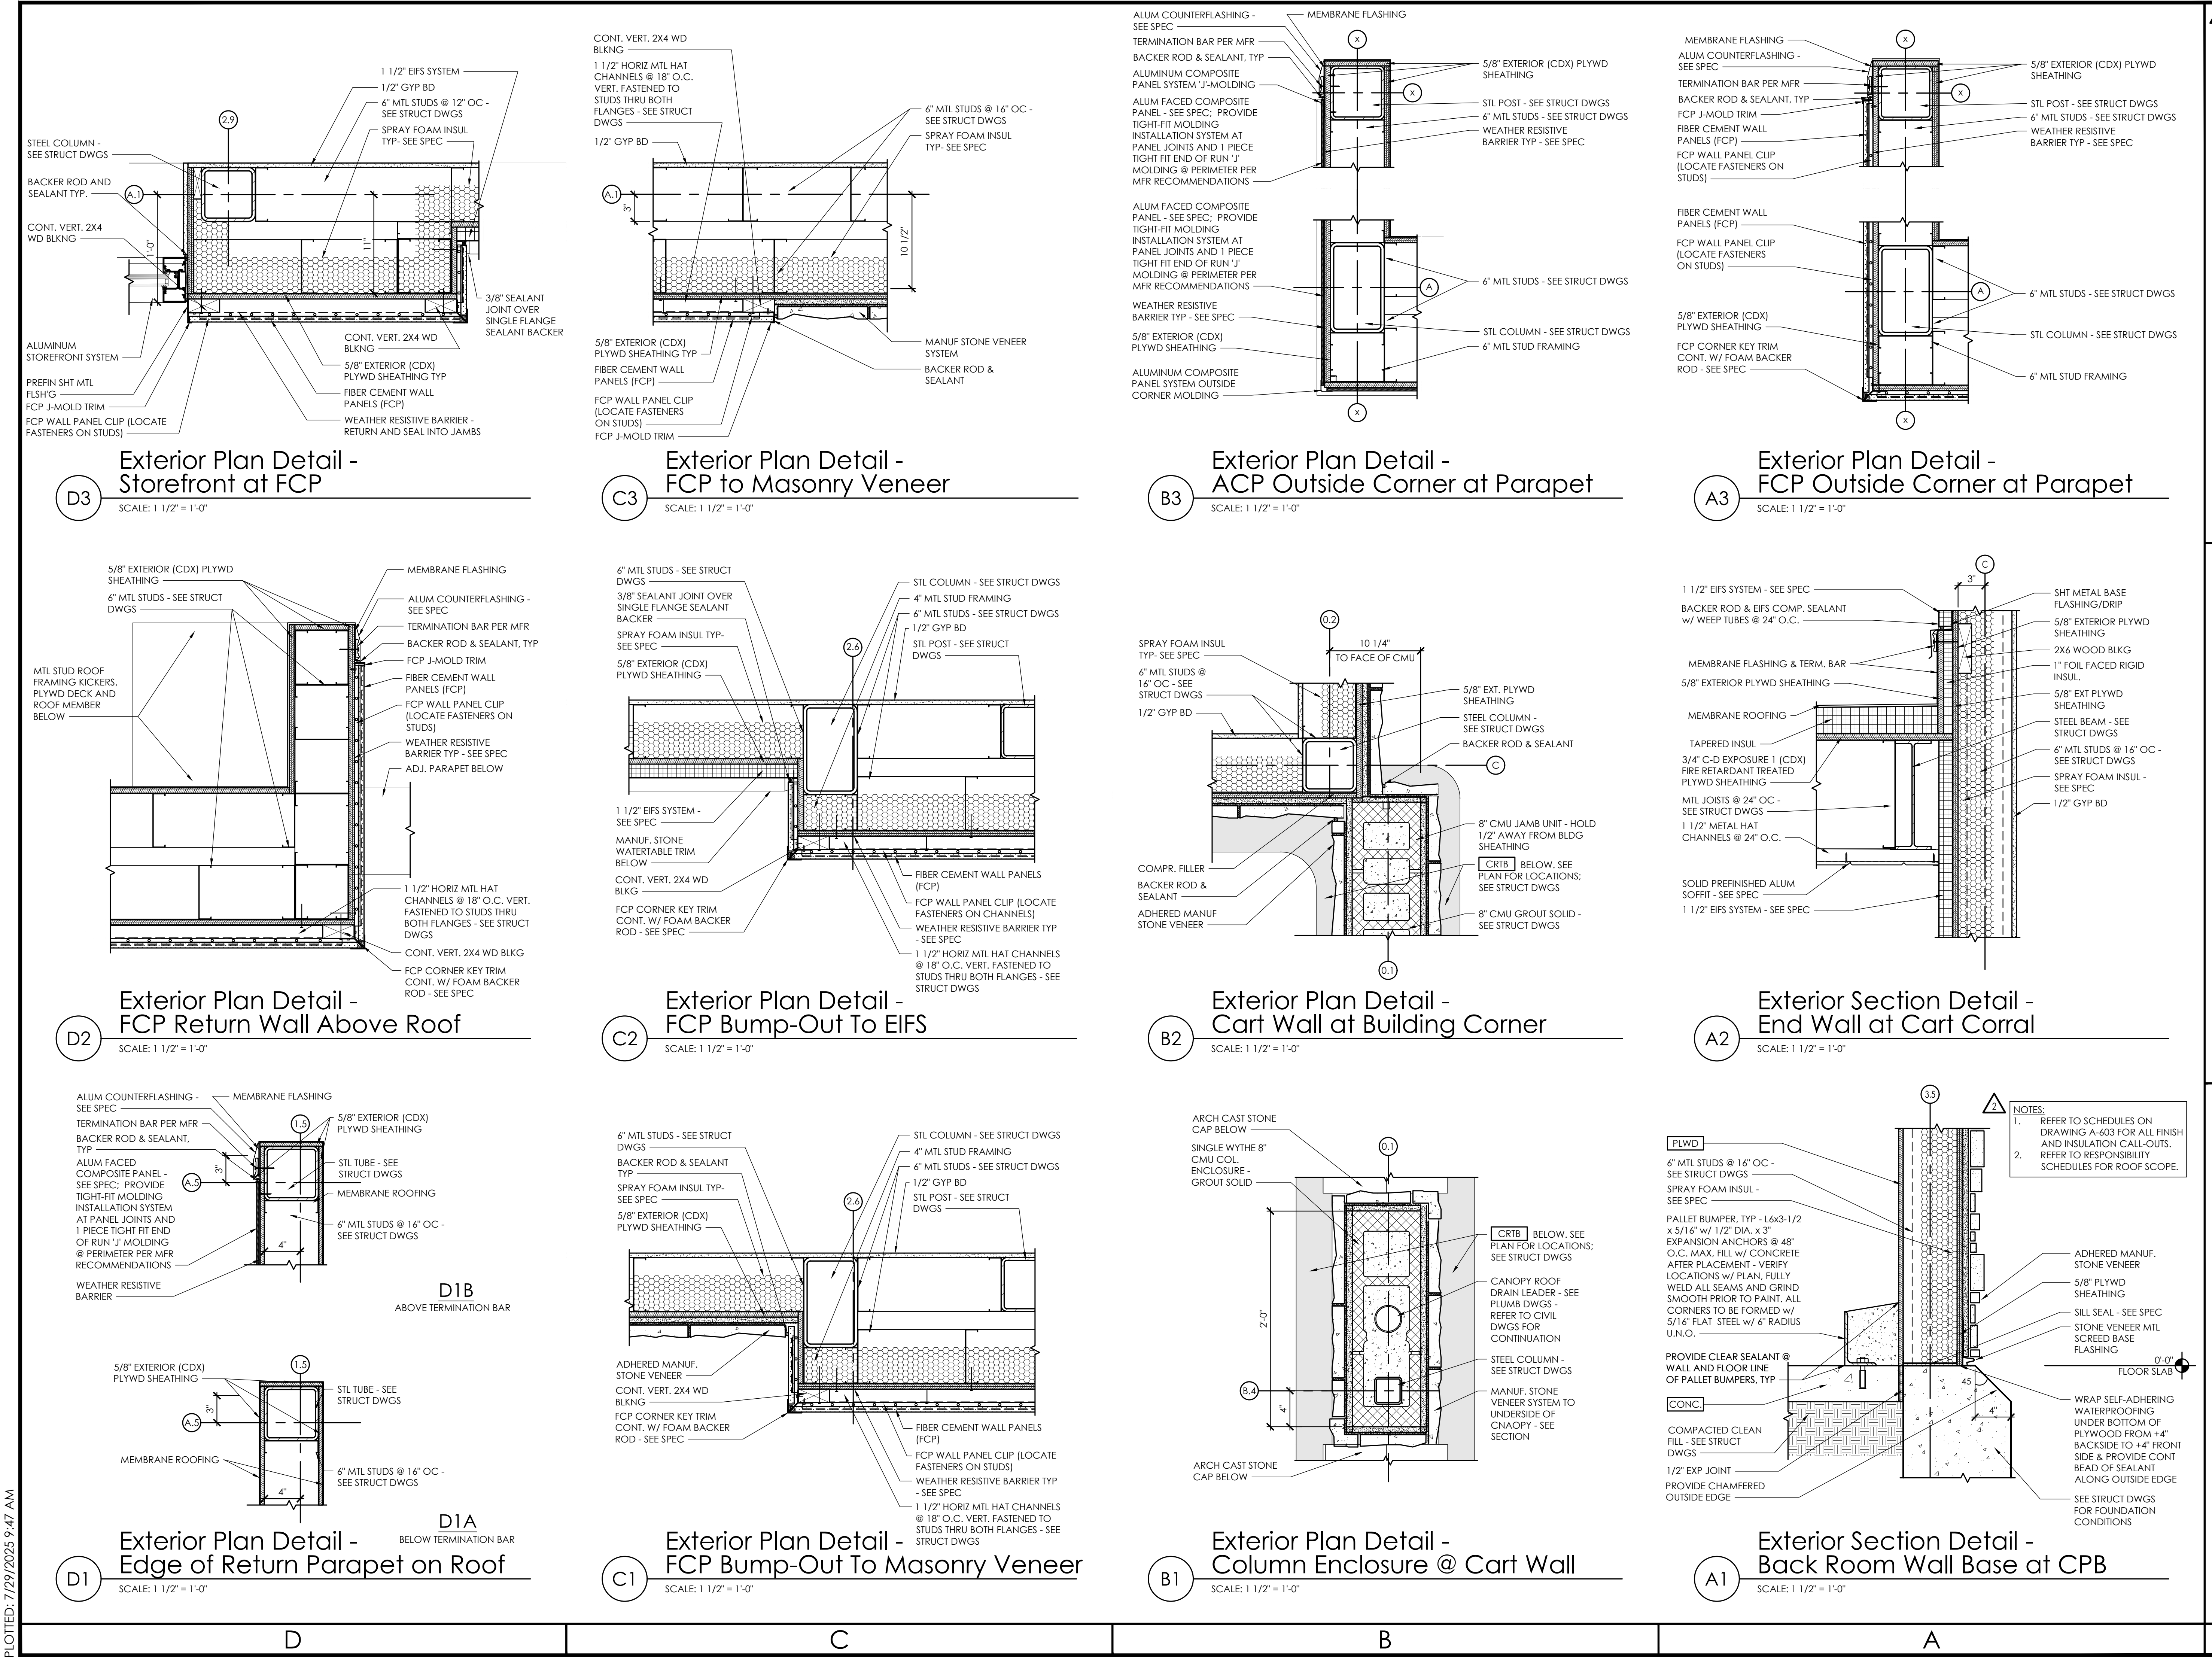

APD
ENGINEERING
ARCHITECTURE
615 Fishers Run Victor, NY 14564
585.742.2222 - www.apd.com

Copyright © 2024
APD Engineering & Architecture
03/27/2012

Drawing Alteration
It is a violation of law for any person, unless acting under the direction of licensed Architect, Professional Engineer, Landscape Architect, or Land Surveyor to alter any item on this document in any way. Any licensee who alters this document is required by law to affix his or her seal and to add the notation "Altered By" followed by his or her signature and the specific description of the alteration or revision.

DO NOT SCALE PLANS
Copying, Printing, Software and other processes required to produce these prints can stretch or shrink the actual paper or layout. Therefore, scaling of this drawing may be inaccurate. Contact APD E&A with any need for additional dimensions or clarifications.

Issued:		Date:
A	Issued for Permit	07/08/24
B	Issued for Bid	07/29/25
C		
D		
E		

Revisions:		Date:
1	Owner Changes	11/18/24
2	Owner Changes	07/29/25
3		
4		
5		
6		
7		
8		
9		
10		
11		
12		

PROJECT ARCHITECT/ENGINEER
Daniel Sargent

PROJECT LEAD
John Lynch

NOT FOR CONSTRUCTION

ALDI Inc.
1171 North State Road 7
Royal Palm Beach, FL 33411
(561) 640-8000

ALDI Inc. Store #: 50
Coconut Crossing, FL
12850 Northlake Boulevard
Palm Beach Gardens, FL 33412
Palm Beach County
Project Name & Location:

Exterior Details
Drawing Name:

Prototype:
V7.08 LHRD

Type:
GROUND UP

Drawn By:
JAH

Scale:
As Noted


Project No.
22-0267A

A-504

Drawing No.



PLOTTED: 7/29/2025 9:48 AM

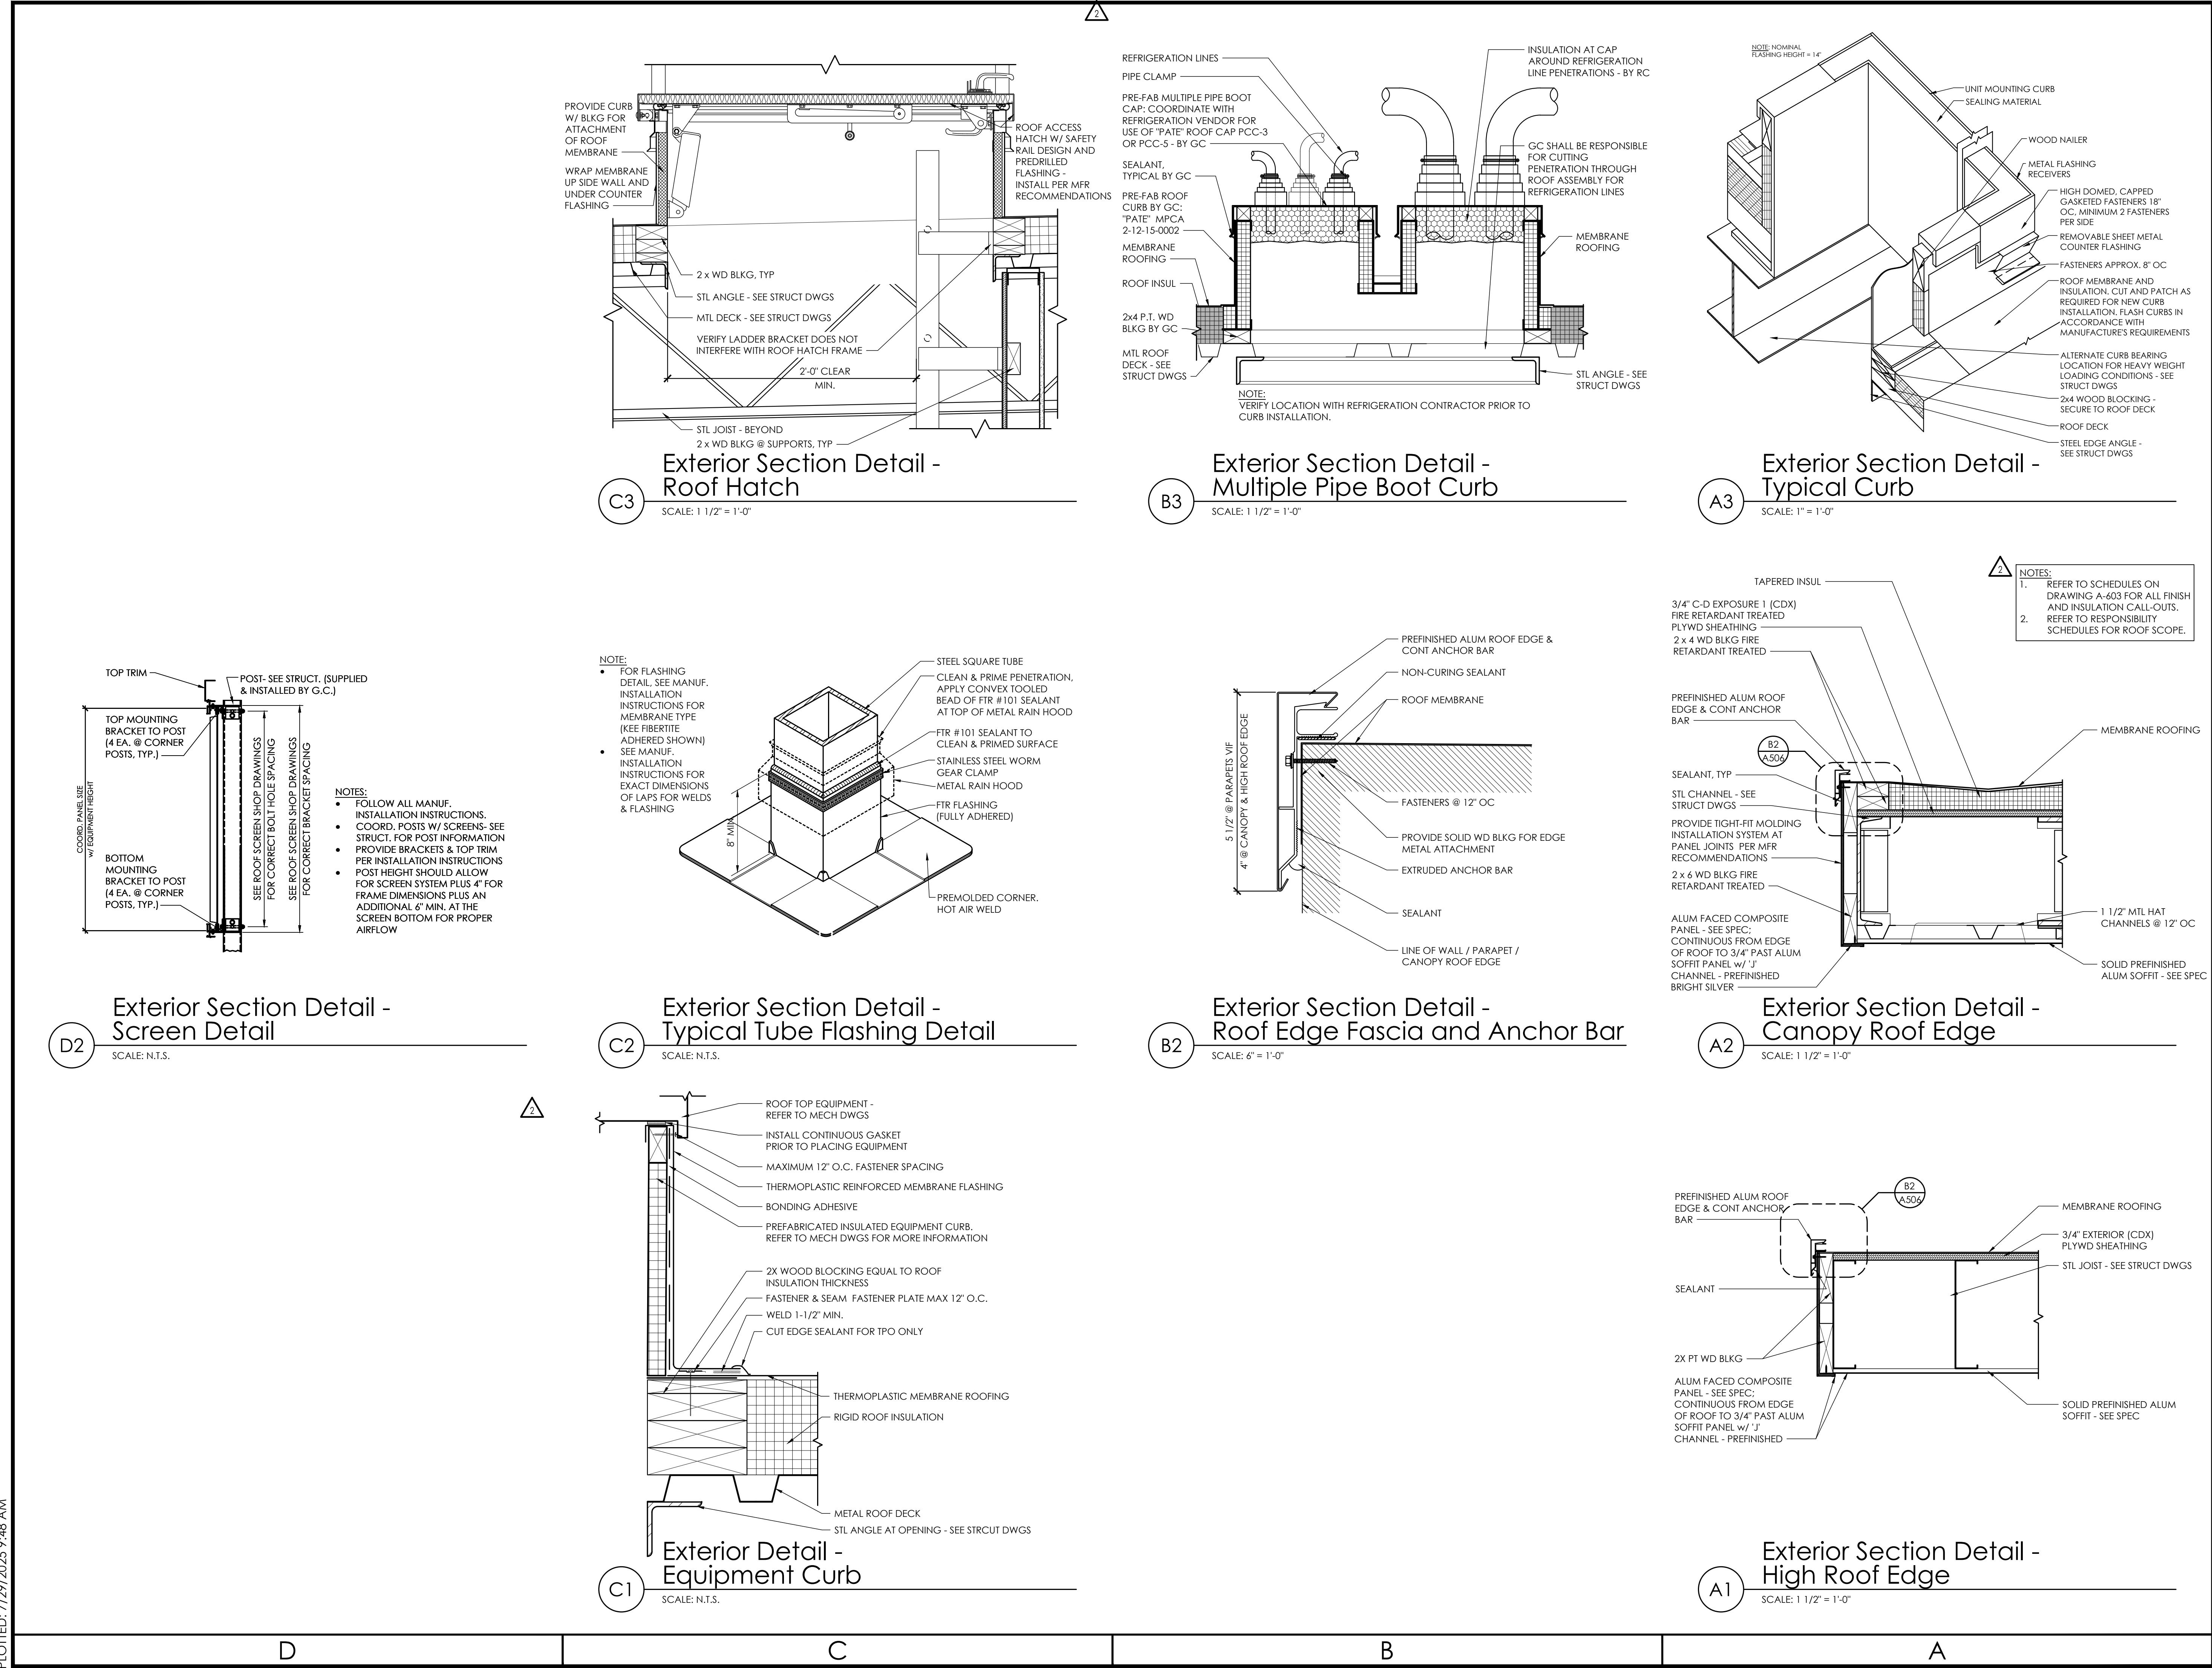

AFD
ENGINEERING
ARCHITECTURE
 615 Fishers Run Victor, NY 14564
 363.742.2222 - www.apd.com

Copyright © 2024

AFD Engineering & Architecture
 03/27/2024

Drawing Alteration
 It is a violation of law for any person, unless acting under the direction of licensed Architect, Professional Engineer, Landscape Architect, or Land Surveyor to alter any item on this document in any way. Any licensee who alters this document is required by law to affix his or her seal and to add the notation "Altered By" followed by his or her signature and the specific description of the alteration or revision.

DO NOT SCALE PLANS
 Copying, Printing, Software and other processes required to produce these prints can stretch or shrink the actual paper or layout. Therefore, scaling of this drawing may be inaccurate. Contact APD E&A with any need for additional dimensions or clarifications.

Issued:

A	Issued for Permit	07/08/24
B	Issued for Bid	07/29/25
C		
D		
E		

Revisions:

1	Owner Changes	11/18/24
2	Owner Changes	07/29/25
3		
4		
5		
6		
7		
8		
9		
10		
11		
12		

PROJECT ARCHITECT/ENGINEER

Daniel Sargent

PROJECT LEAD

John Lynch

NOT FOR CONSTRUCTION

ALDI Inc.
 1171 North State Road 7
 Royal Palm Beach, FL 33411
 (561) 640-8000


ALDI Inc. Store #: 50
 Coconut Crossing, FL
 12850 Northlake Boulevard
 Palm Beach Gardens, FL 33412
 Palm Beach County
 Project Name & Location:

Exterior Details

Drawing Name:


Prototype:	V7.08 LHRD	Project No.	22-0267A
Type:	GROUND UP		
Drawn By:	JAH		A-506
Scale:	As Noted		

Drawing No.

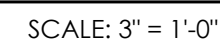


Copying, Printing, Software and other processes required to produce these prints can stretch or shrink the actual paper or layout. Therefore, scaling of this drawing may be inaccurate. Contact APD E&A with any need for additional dimensions or clarifications.

PLOTTED: 7/19/2025 9:48 AM

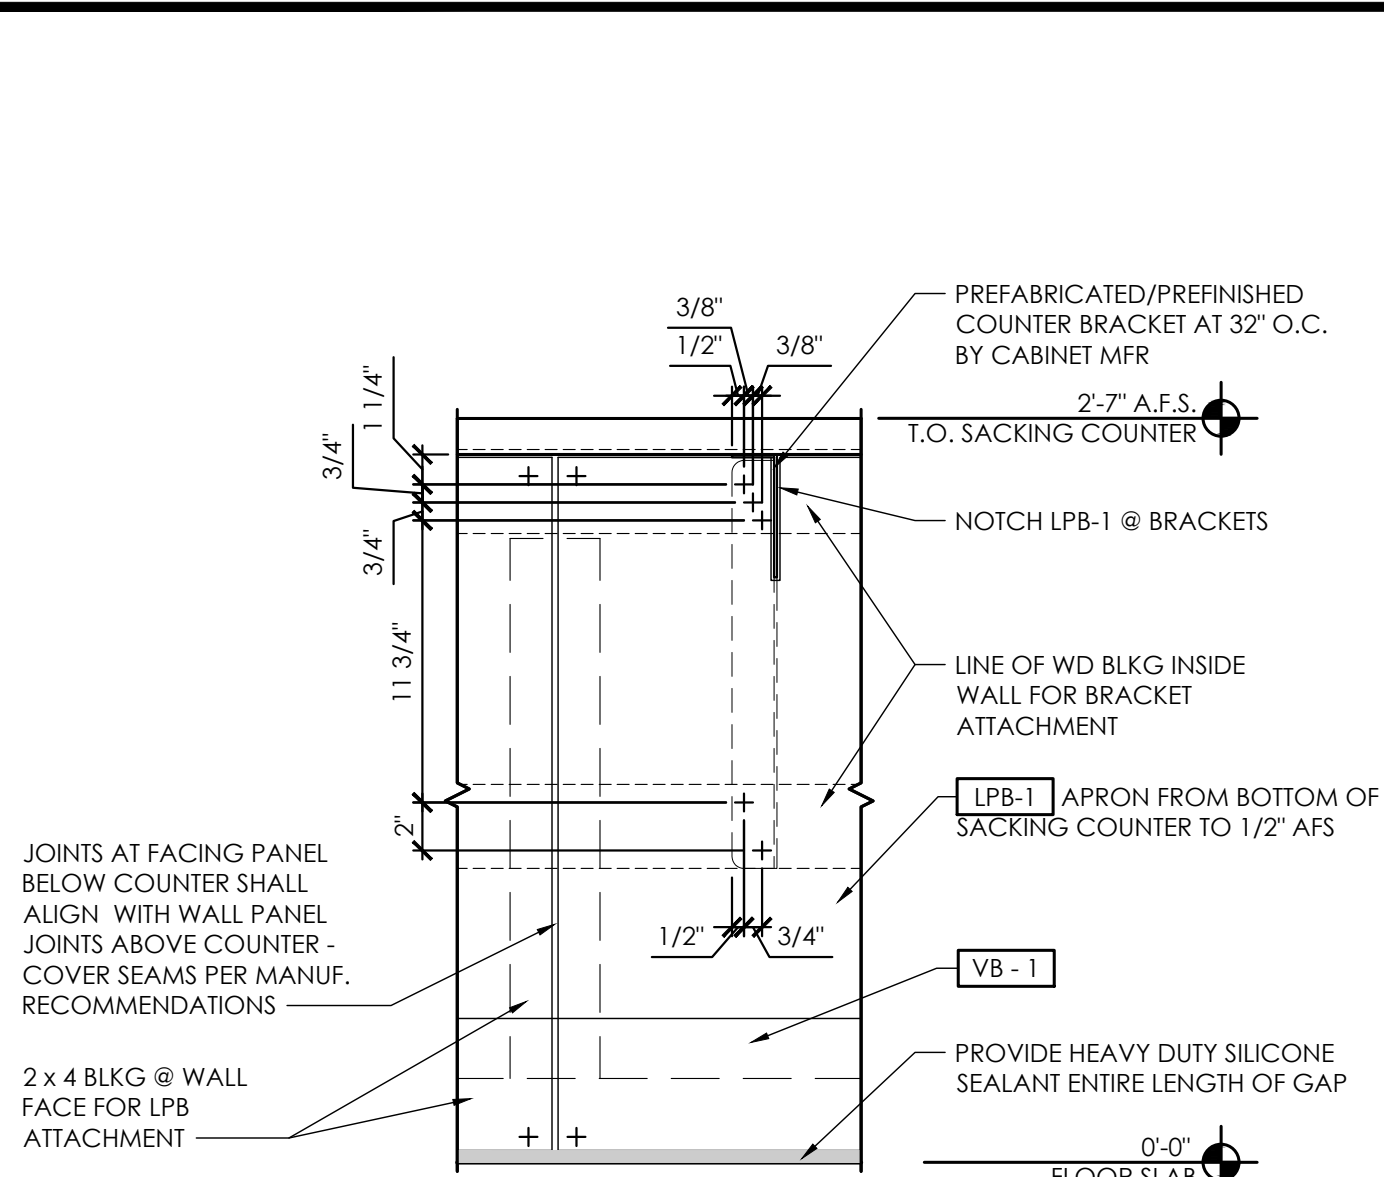


Interior Elevation Detail - Sacking Counter

SCALE: 1 1/2" = 1'-0"

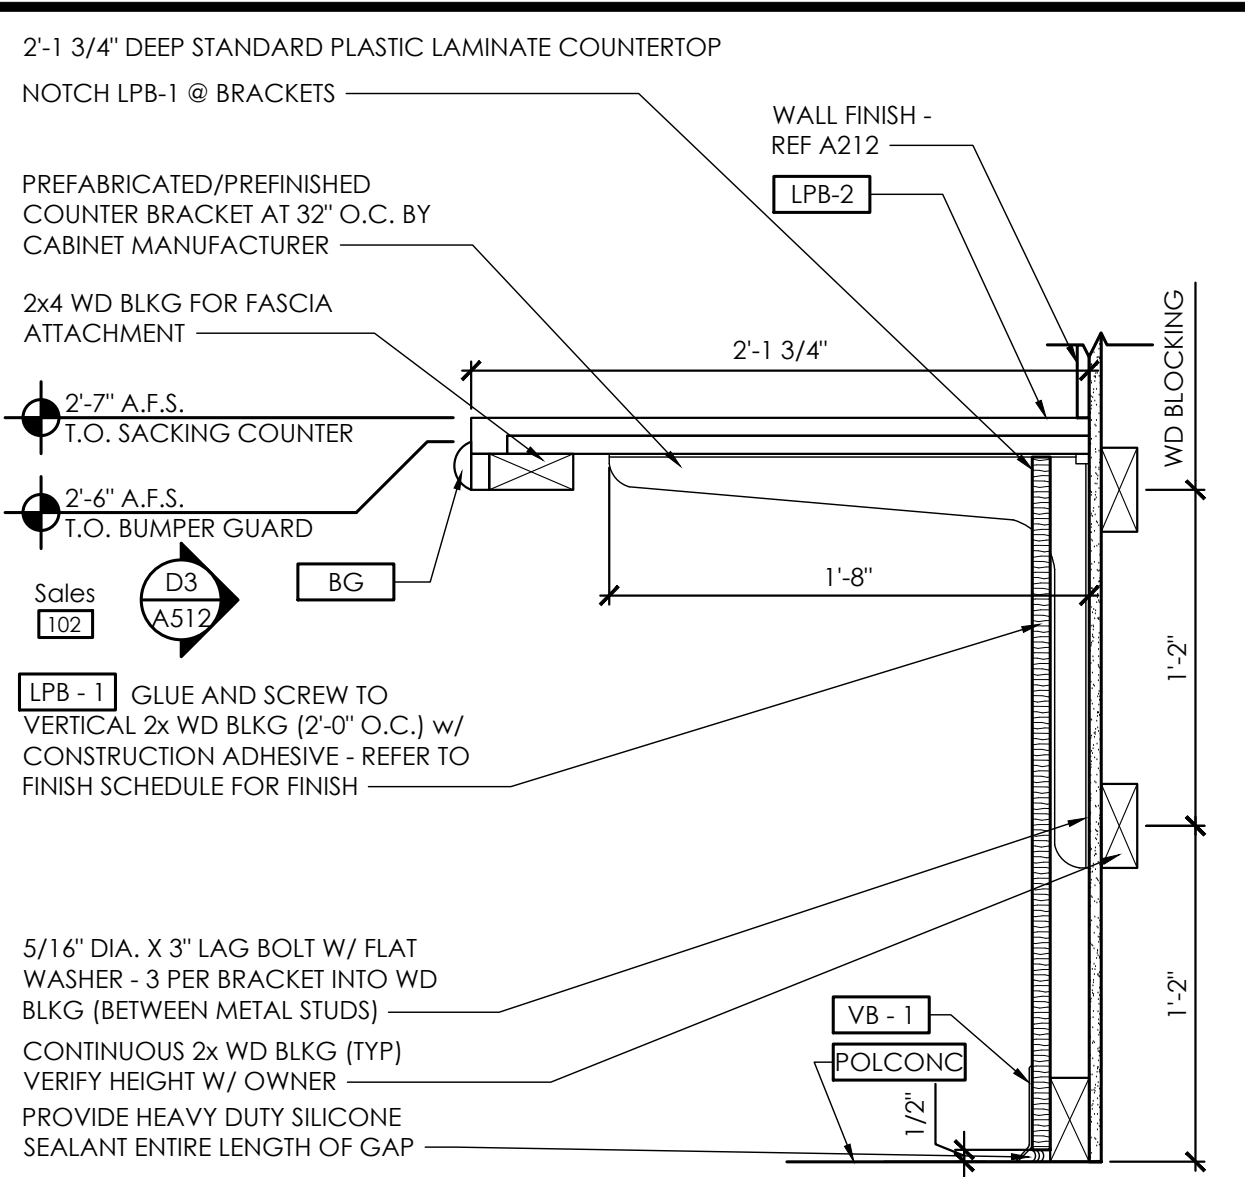


Interior Section Detail - Sacking Counter

SCALE: 1 1/2" = 1'-0"

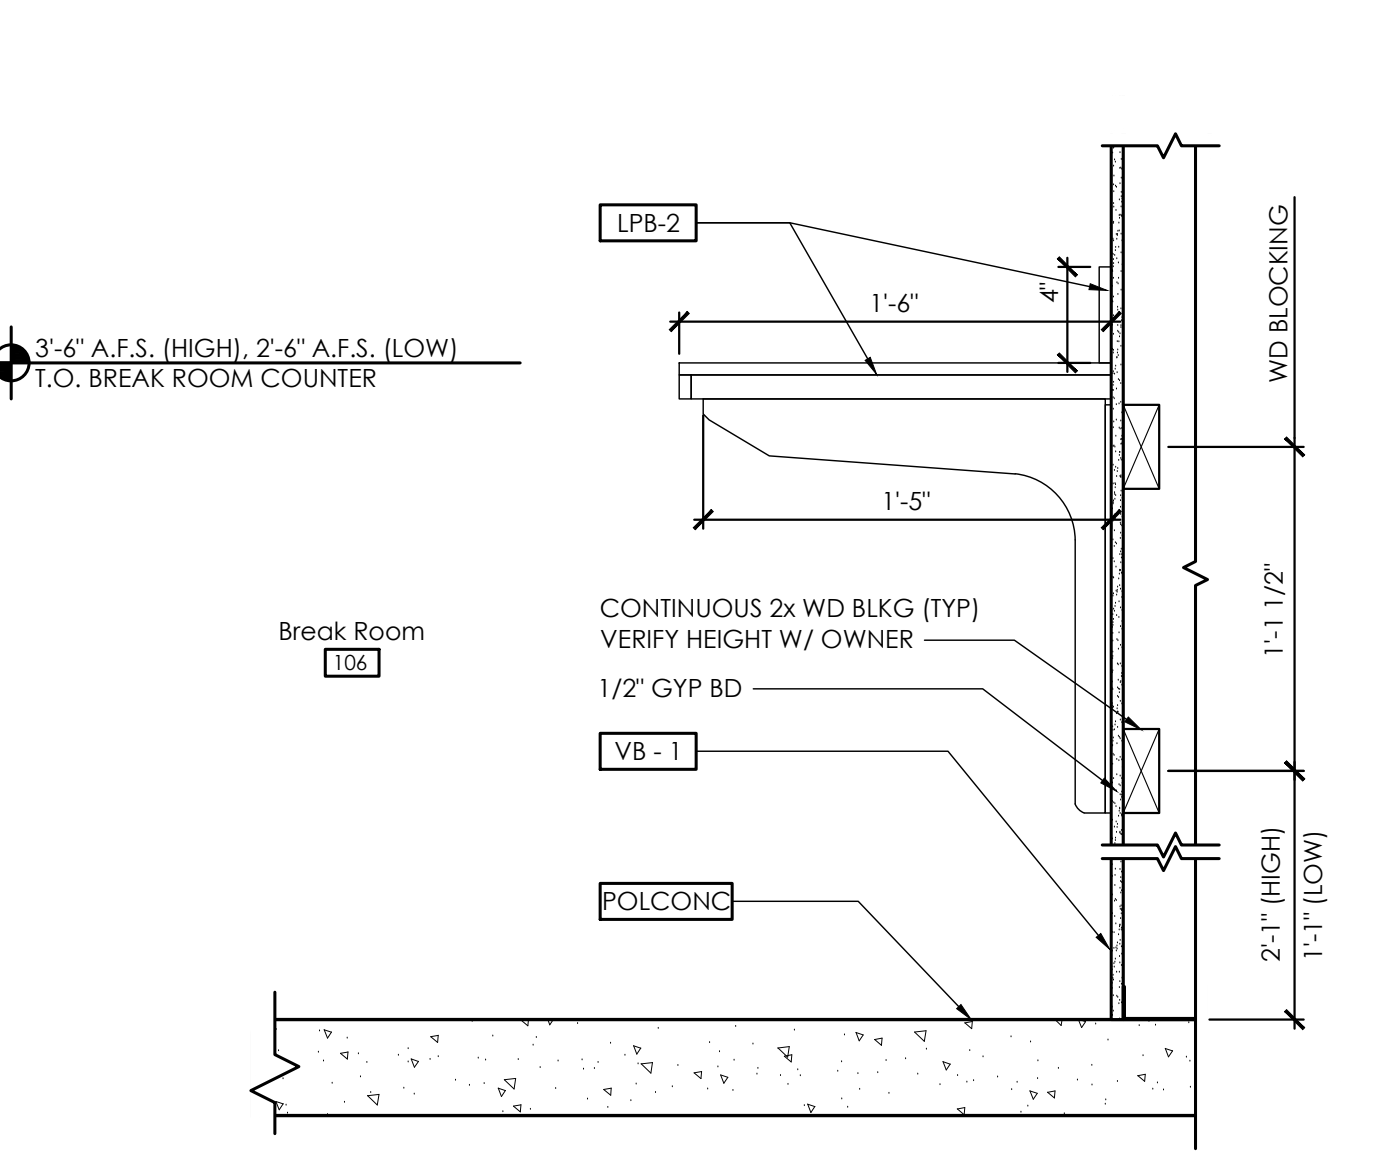


Interior Section Detail - Break Room High Top Counter

SCALE: 1 1/2" = 1'-0"

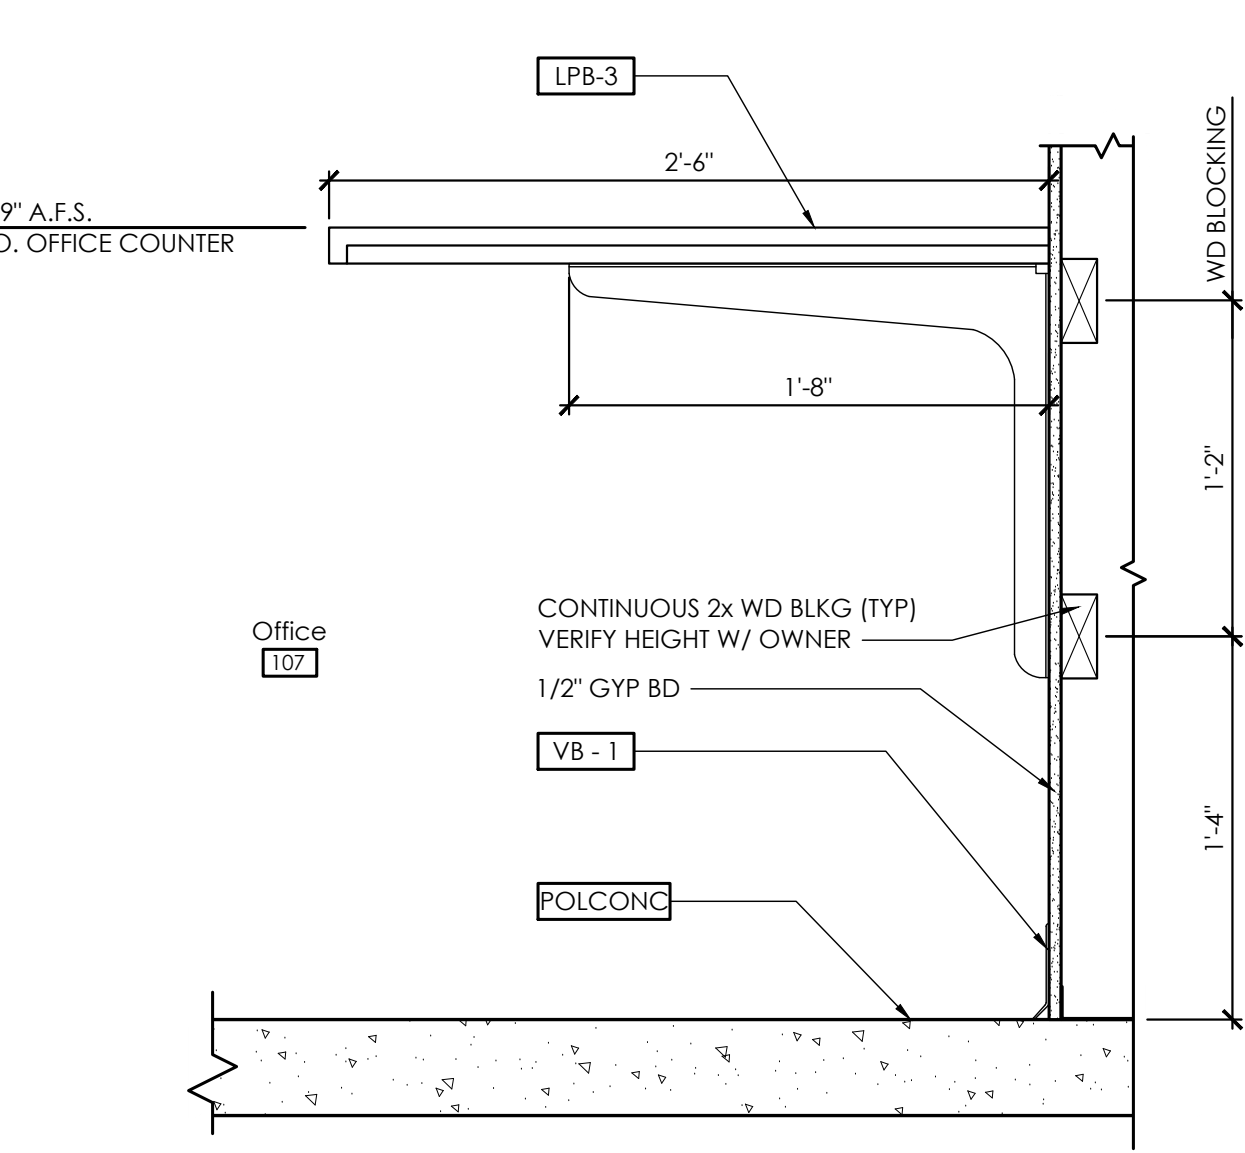


Interior Section Detail - Office Counter

SCALE: 1 1/2" = 1'-0"

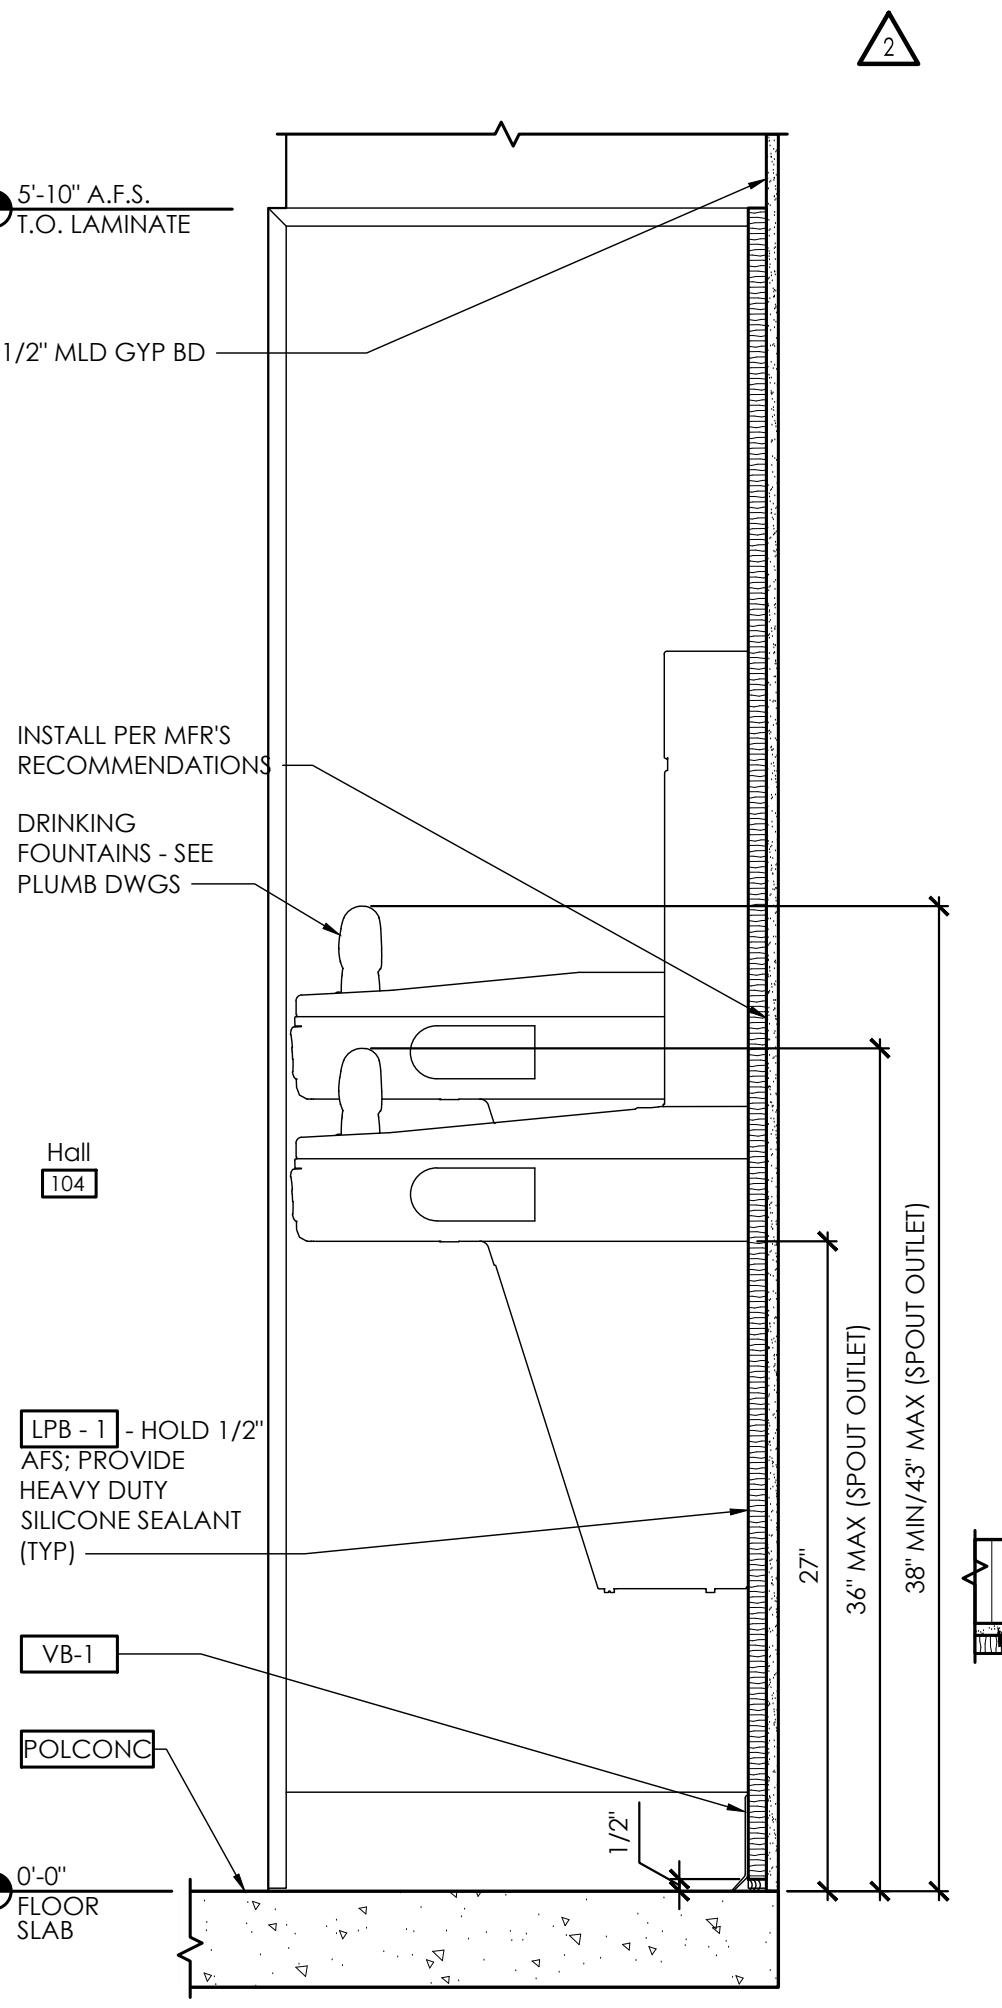


Interior Section Detail - Drinking Fountain

SCALE: 1 1/2" = 1'-0"

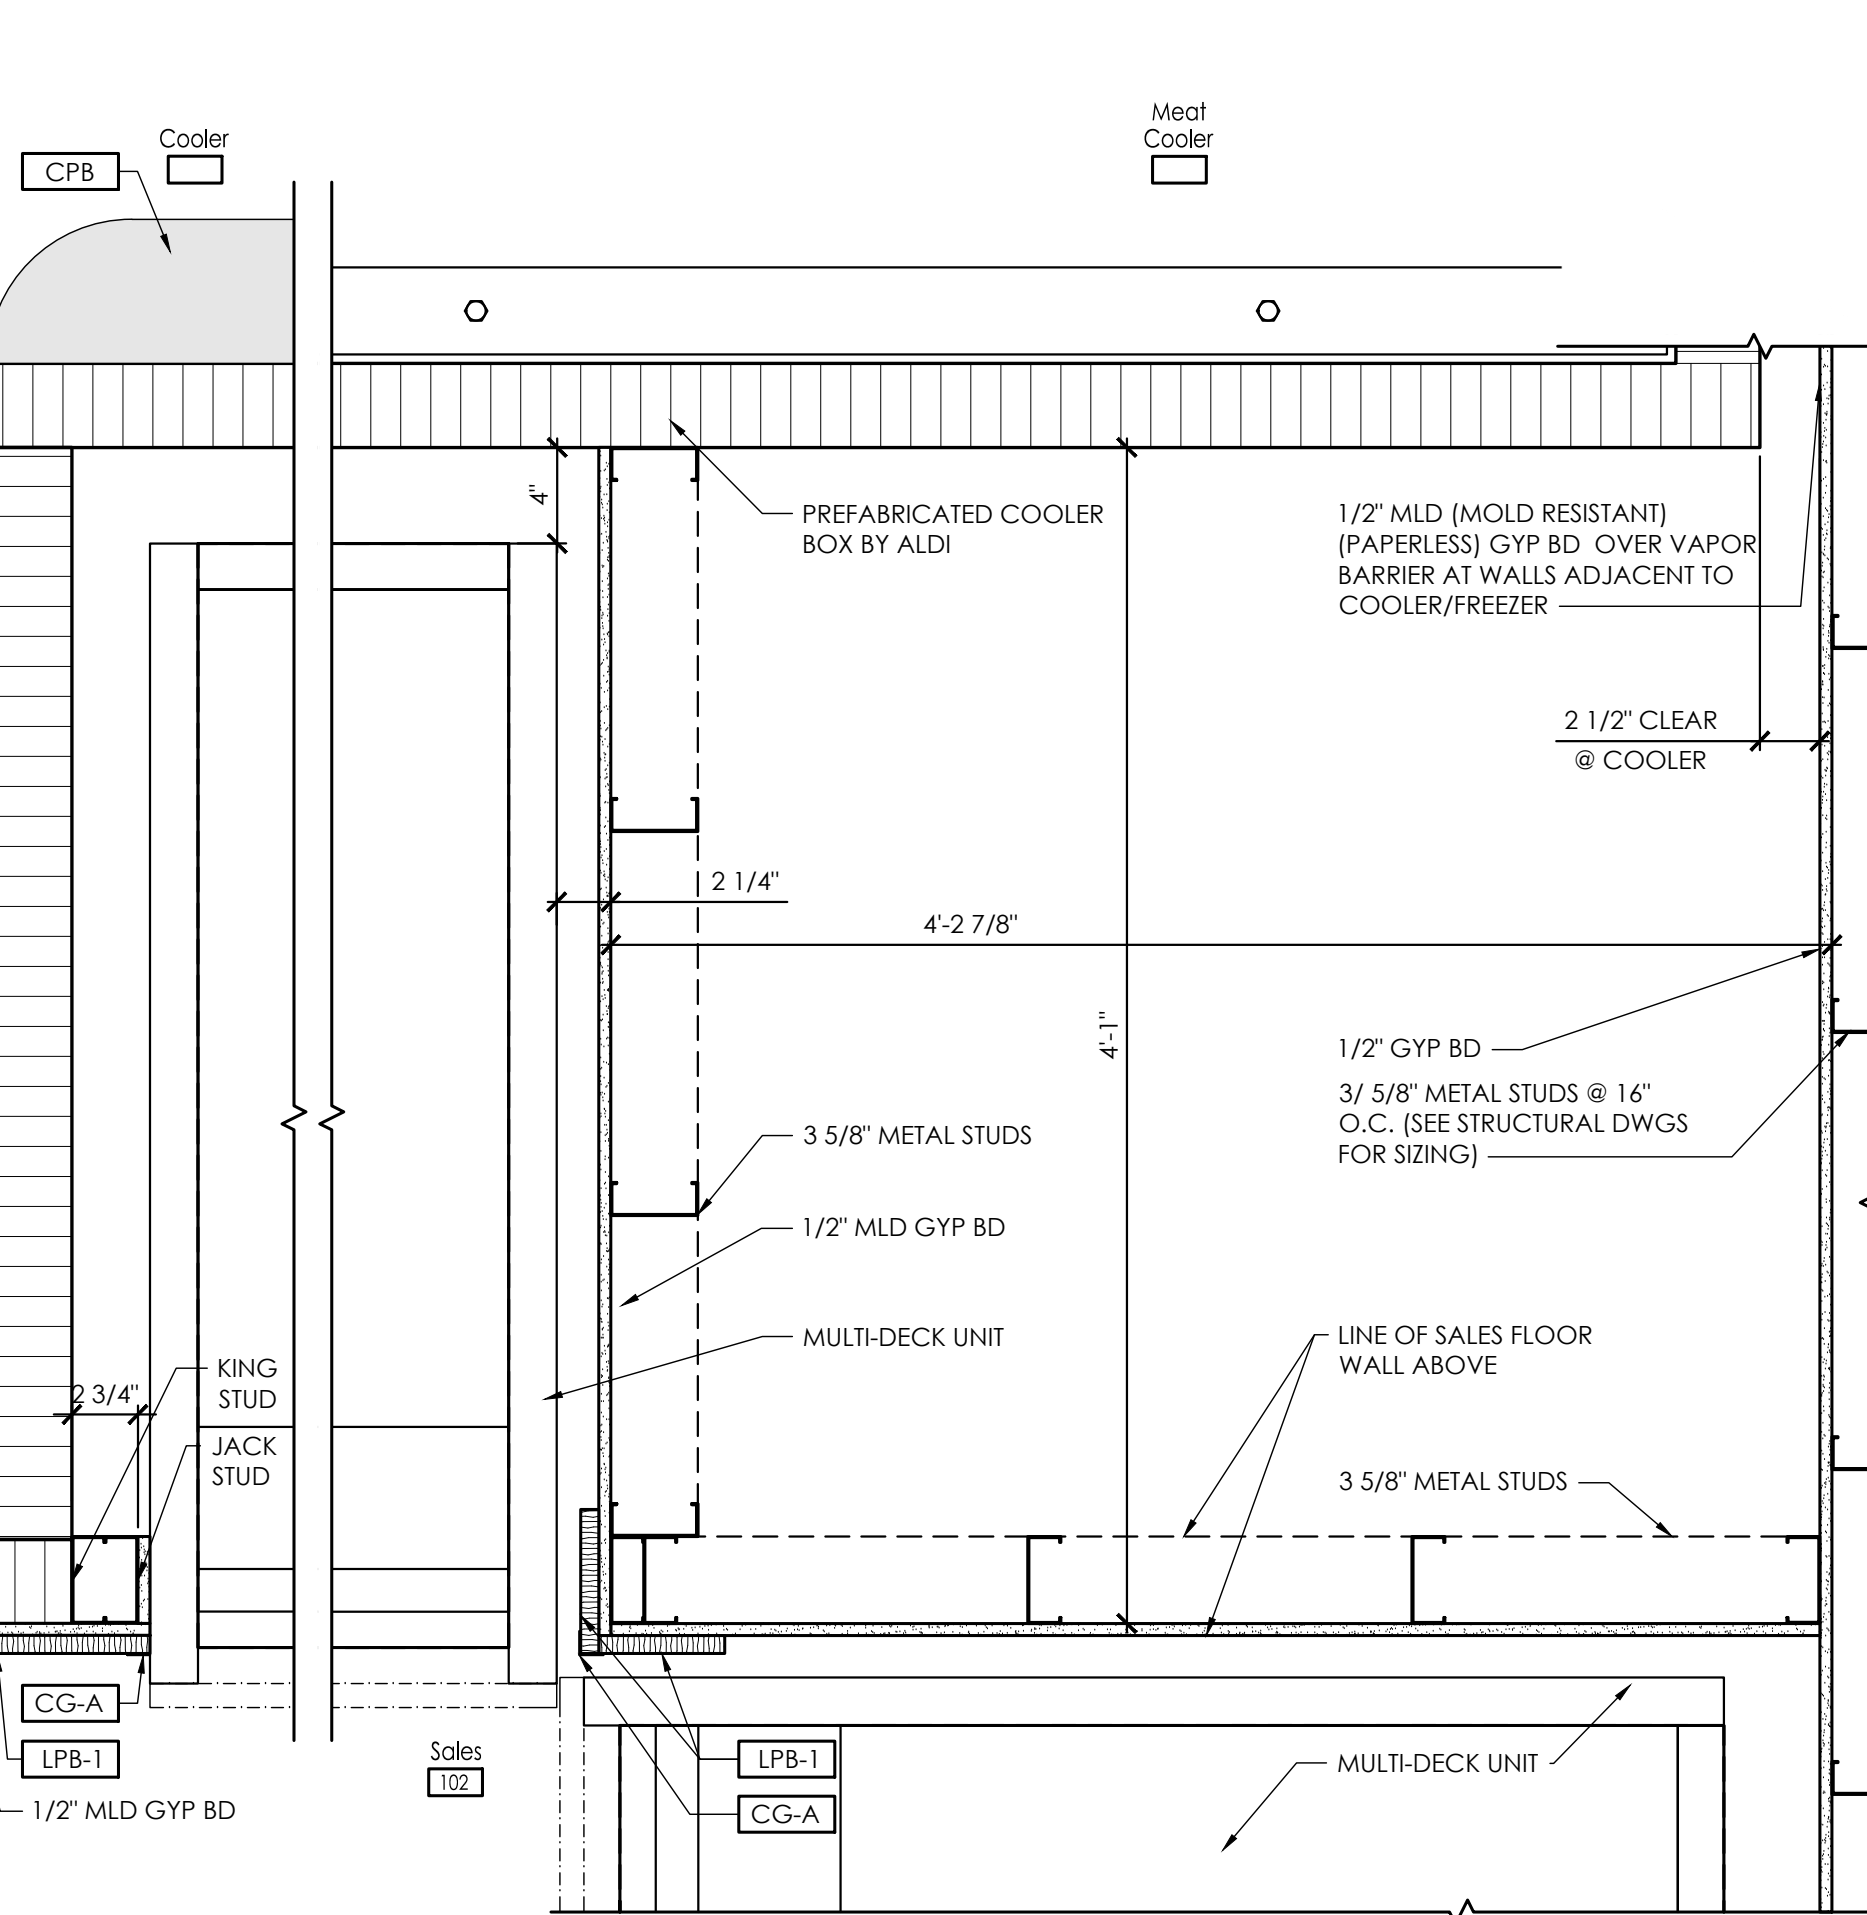


Interior Plan Detail - MDU and Cooler Alcove

SCALE: 1 1/2" = 1'-0"

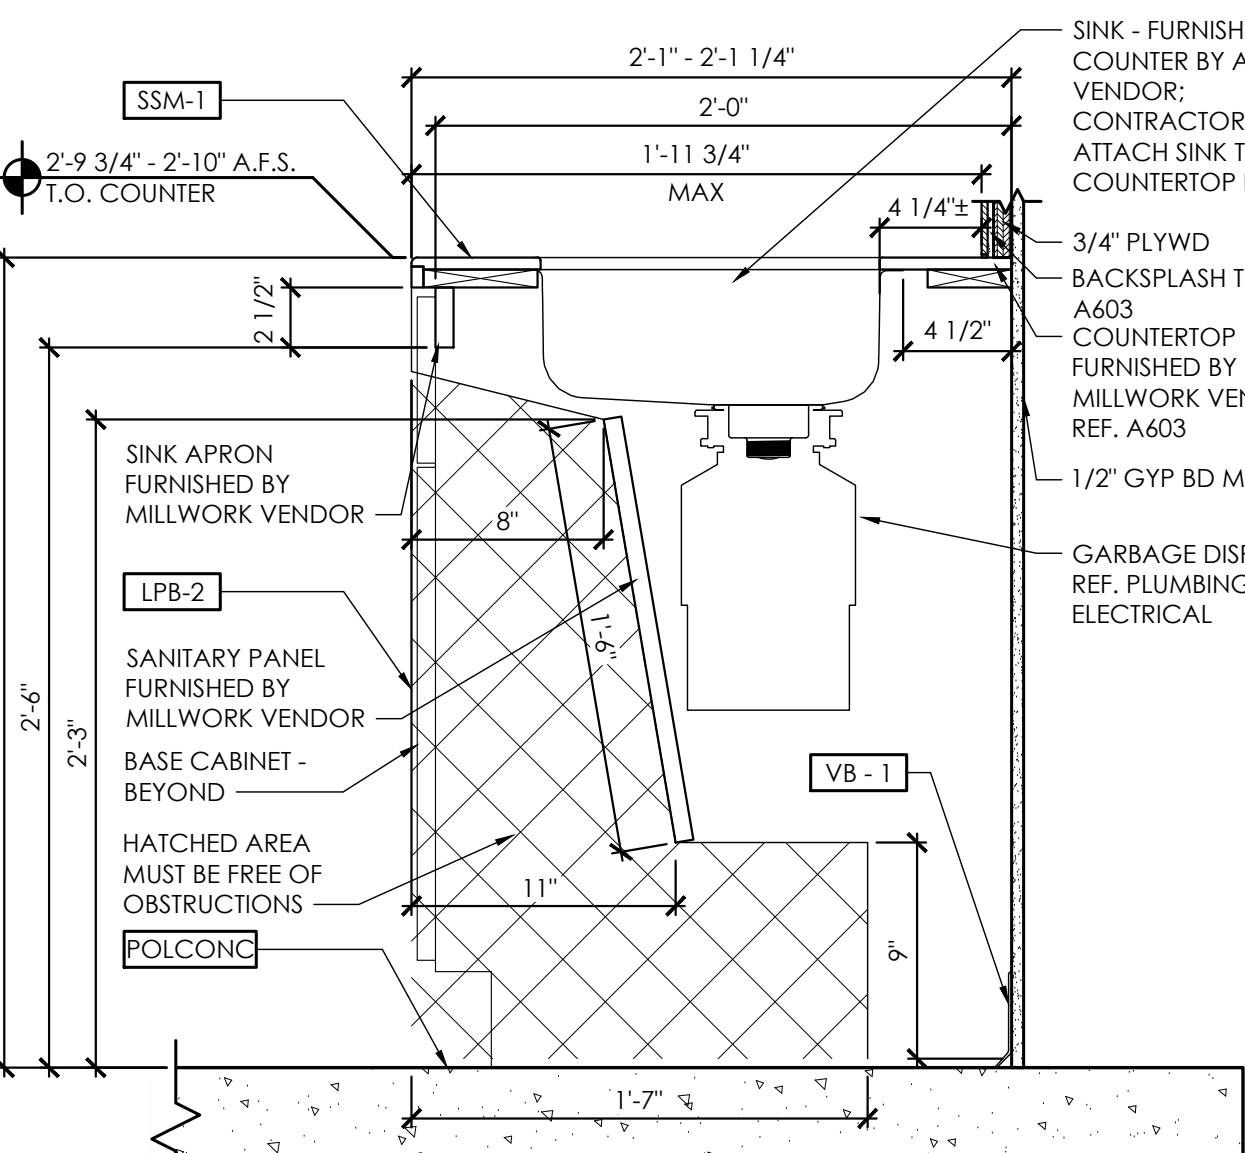

Interior Section Detail - Break Room Sink Cabinet

SCALE: 1 1/2" = 1'-0"

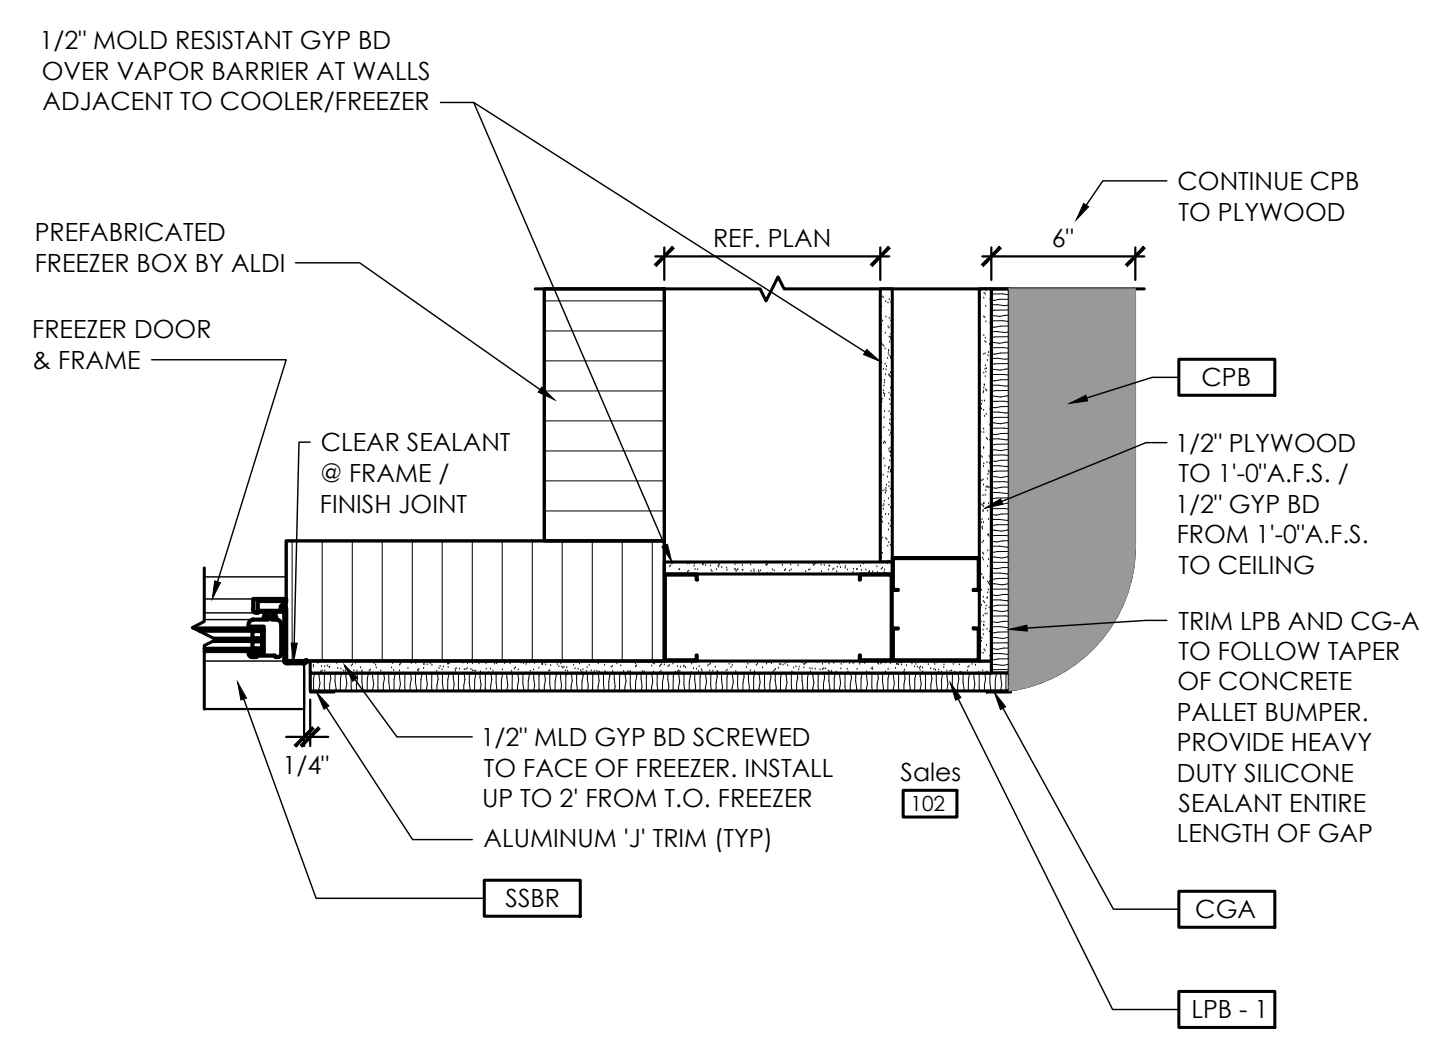

Interior Plan Detail - Wall Near Impact Doors

SCALE: 1 1/2" = 1'-0"

Issued:	Date:
A Issued for Permit	07/08/24
B Issued for Bid	07/29/25
C	
D	
E	

Revisions:	Date:
1 Owner Changes	11/18/24
2 Owner Changes	07/29/25
3	
4	
5	
6	
7	
8	
9	
10	
11	
12	

PROJECT ARCHITECT/ENGINEER	
Daniel Sargent	
PROJECT LEAD	
John Lynch	

NOT FOR
CONSTRUCTION

Seal Seal
ALDI Inc.
 1171 North State Road 7
 Royal Palm Beach, FL 33411
 (561) 640-8000

ALDI Inc. Store #: 50
 Coconut Crossing, FL
 12850 Northlake Boulevard
 Palm Beach Gardens, FL 33412
 Palm Beach County
 Project Name & Location:


Interior Details Drawing Name:	Project No.
Prototype: V7.08 LHRD	22-0267A
Type: GROUND UP	A-512
Drawn By: JWL	Drawing No.
Scale: As Noted	

A

NOTE:


GLAZING SCHEDULE			
KEY	KEY DESCRIPTION	DESCRIPTION -COLOR	REMARKS
GL-1	LAMINATED SAFETY GLASS	CLEAR	SEE PROJECT MANUAL - SECTION 088000
GL-2	LOW E, INSULATING SAFETY GLASS	CLEAR	SEE PROJECT MANUAL - SECTION 088000
GL-3	LOW E, LAMINATED SAFETY GLASS	CLEAR	NOT BY GC. SUPPLIED BY AUTO DOOR VENDOR U.N.O. SEE PROJECT MANUAL SECTION 088000

NOTE:	
1.	ALUMINUM FRAMING: - INTERIOR VESTIBULE: 2" X 4 1/2" CENTER SET STOREFRONT. - EXTERIOR STOREFRONT: 2 1/2" X 5" THERMAL CENTER SET.
2.	SEE SPEC FOR GLASS TYPES
3.	FIELD VERIFY ALL OPENING DIMENSIONS PRIOR TO ORDERING AND FABRICATION.
4.	ALL MULLIONS TO BE EQUAL SPACED U.N.O.
5.	ALL GLAZING IN STOREFRONT, WINDOW OPENINGS, DOORS, SIDELIGHTS, AND TRANSOMS SHALL BE LAMINATED CATEGORY II SAFETY GLASS.

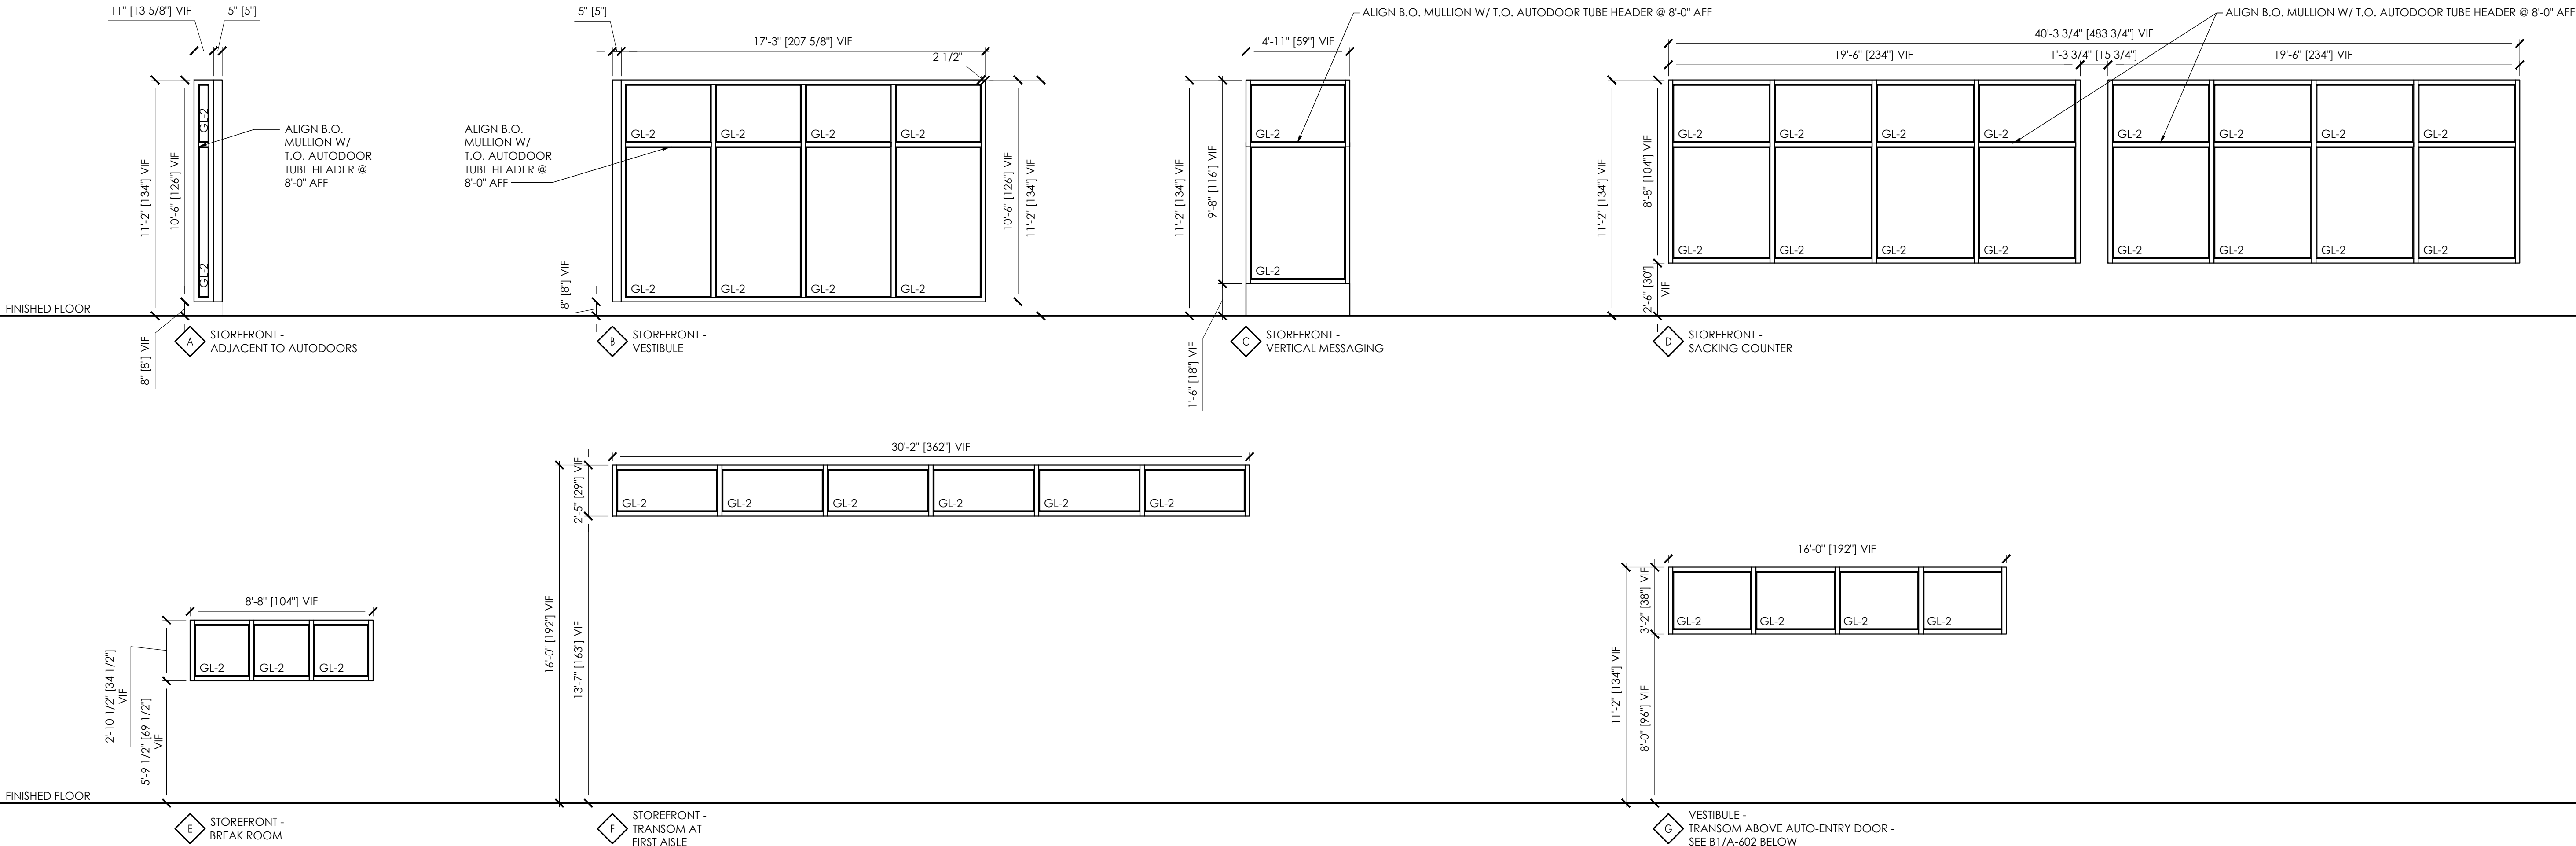


D3 Glazing Systems

SCALE: 1/4" = 1'-0"

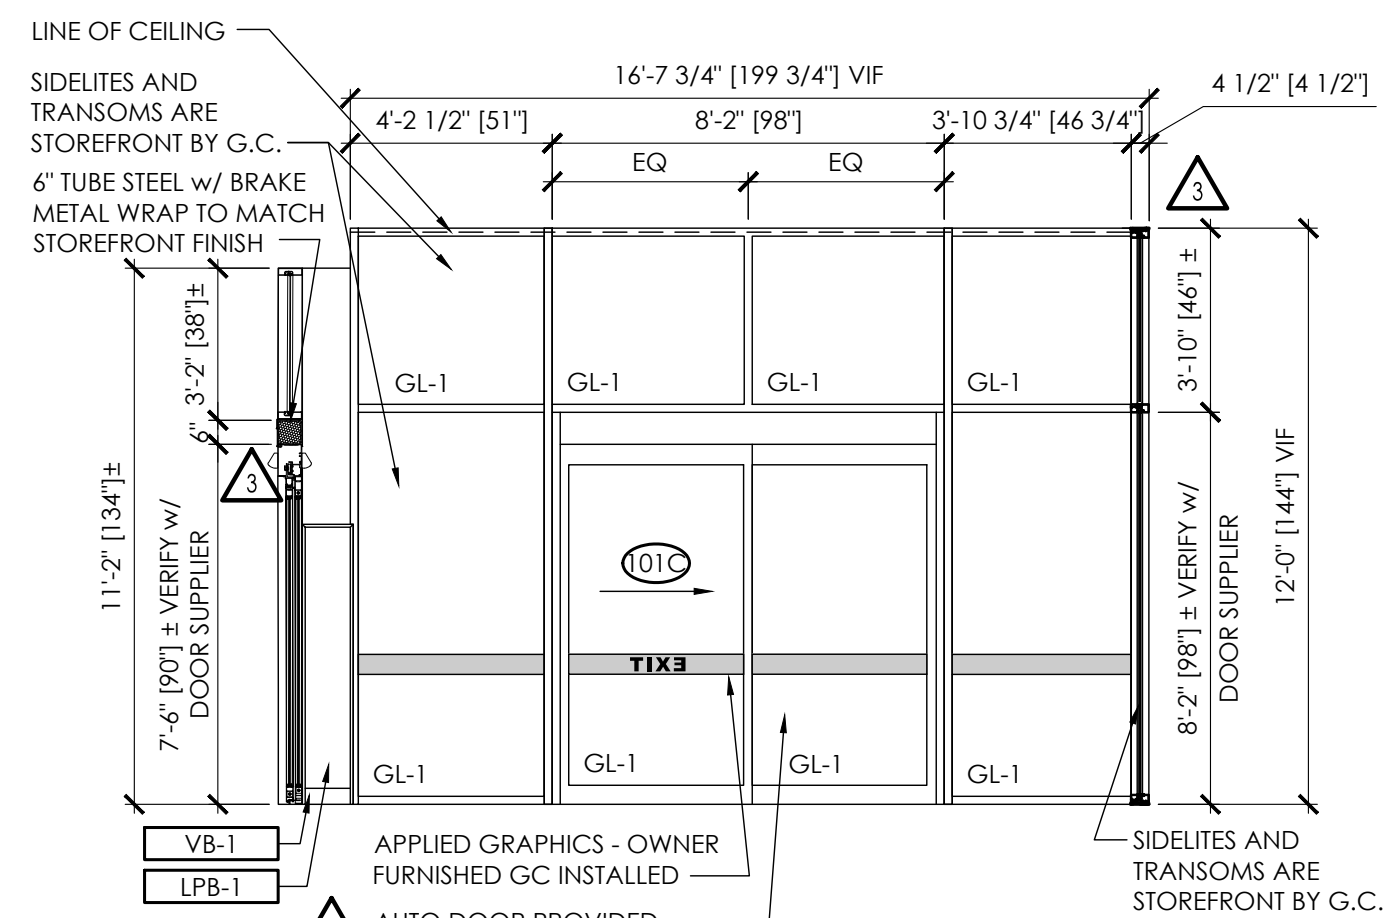


D1 Vestibule

SCALE: 1/4" = 1'-0"

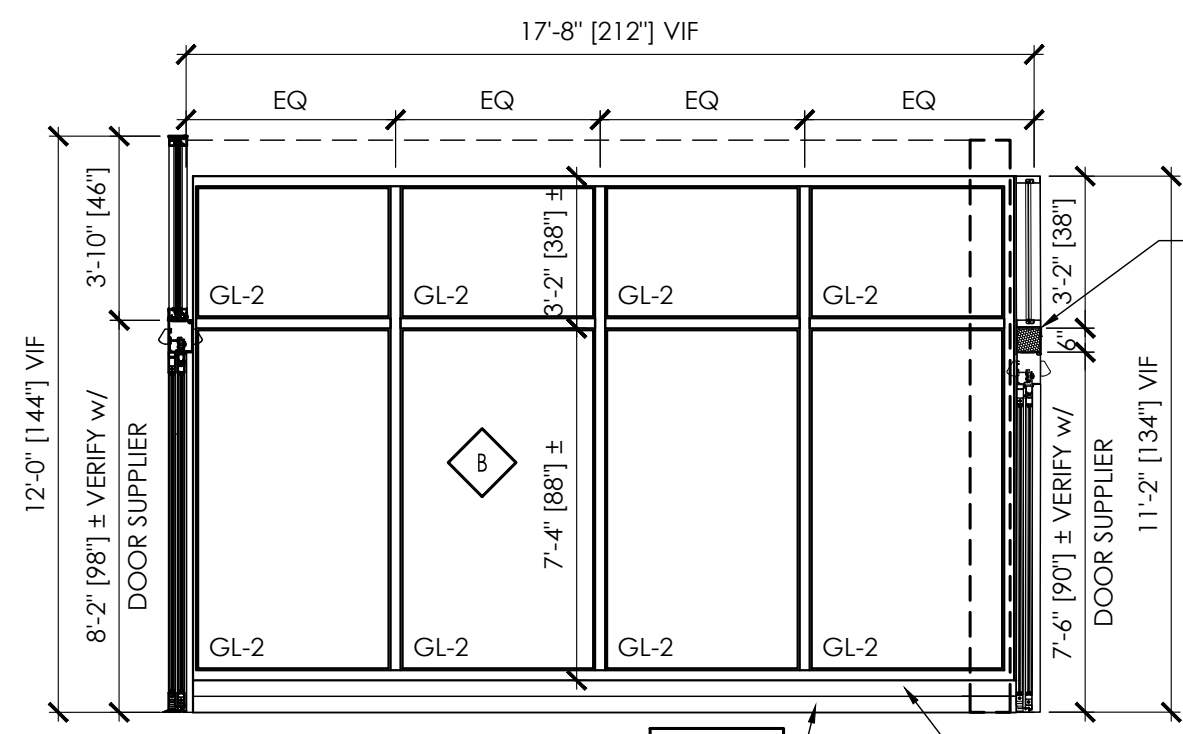


C1 Vestibule

SCALE: 1/4" = 1'-0"

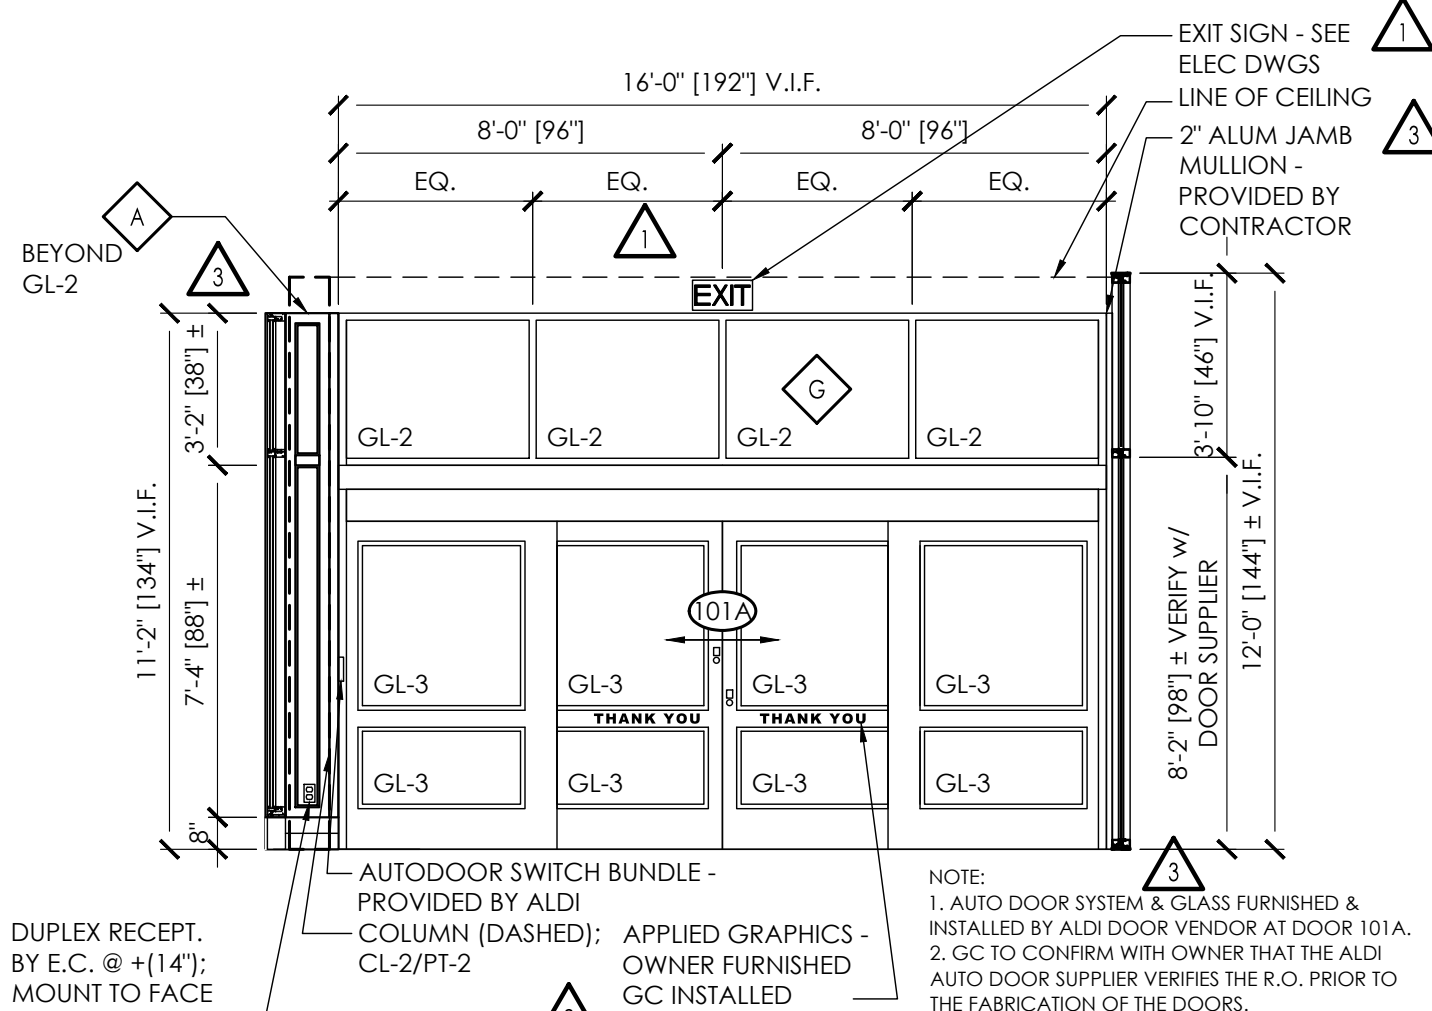

B1 Vestibule

SCALE: 1/4" = 1'-0"

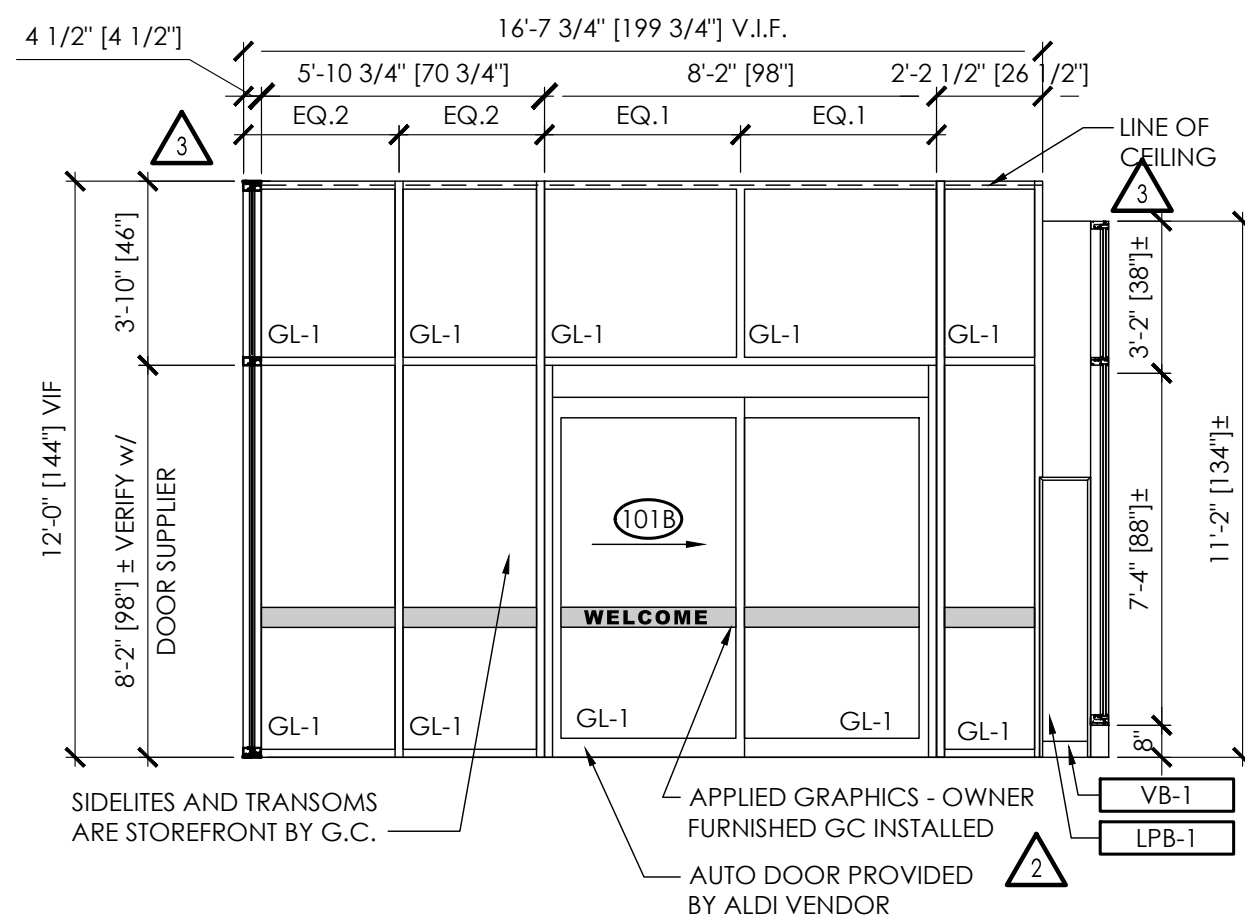

A1 Vestibule

SCALE: 1/4" = 1'-0"

Copyright © 2024
APD Engineering & Architecture
03/17/2024

Drawing Alteration

It is a violation of law for any person, unless acting under the direction of licensed Architect, Professional Engineer, Landscape Architect, or Land Surveyor to alter any item on this document in any way. Any licensee who alters this document is required by law to affix his or her seal and to add the notation "Altered By" followed by his or her signature and the specific description of the alteration or revision.

DO NOT SCALE PLANS

Copying, Printing, Software and other processes required to produce these prints can stretch or shrink the actual paper or layout. Therefore, scaling of this drawing may be inaccurate. Contact APD E&A with any need for additional dimensions or clarifications.

Issued:	Date:
A Issued for Permit	07/08/24
B Issued for Bid	07/29/25
C	
D	
E	

Revisions:	Date:
1 AHJ Responses	10/02/24
2 Owner Changes	11/18/24
3 Owner Changes	07/29/25
4	
5	
6	
7	
8	
9	
10	
11	
12	

PROJECT ARCHITECT/ENGINEER


Daniel Sargent

PROJECT LEAD

John Lynch

NOT FOR CONSTRUCTION

Seal Seal

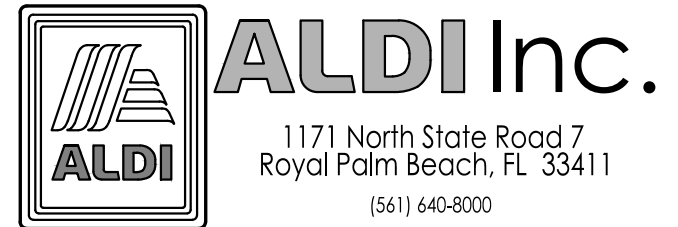

ALDI Inc. Store #: 50
Coconut Crossing, FL
12850 Northlake Boulevard
Palm Beach Gardens, FL 33412
Palm Beach County
Project Name & Location:

Window Elevations & Details

Drawing Name:

Prototype:	Project No.
V7.08 LHRD	22-0267A
Type:	
GROUND UP	
Drawn By:	
JWL	
Scale:	
As Noted	
	A-602
	Drawing No.

PLOTTED: 7/29/2025 9:49 AM

ROOM FINISH SCHEDULE:																							
ROOM NO.	ROOM NAME	FLOOR	BASE	GYP BD THICKNESS	SOUND ATTENUATION BATTS	LPB THICKNESS	TOP WALL		LEFT WALL		BOTTOM WALL		RIGHT WALL		CEILING			GYP BD PAINT SYSTEM			REMARKS	ROOM NO.	
							LOWER	UPPER	LOWER	UPPER	LOWER	UPPER	LOWER	UPPER	MAT.	FIN.	HGT.		CL#	SURFACE			
101	VESTIBULE	CONC	VB-1	1/2"		3/4"	AL/GL / LPB-1	AL/GL / GYP BD	AL/GL	AL/GL / GYP BD	AL/GL	AL/GL / GYP BD	AL/GL / LPB-1	AL/GL / GYP BD	SAPC-1	--	11'-11"	PT-6	CL-2	BELOW CEILING: GYP BD WALLS, SOFFITS, COLUMNS		101	
102	SALES	POLCONC	VB-1/ SS-3/ CPB/ SSBR	1/2" & 1/2 MLD. (A1C)		3/4"	LPB-1	GYP BD	AL/GL / T1 / LPB-1	GYP BD	AL/GL / LPB-1 / GYP BD	AL/GL / GYP BD	LPB-1 / GYP BD	T-4 / WP-1 / GYP BD	EXP	--	VARIES	PT-6	CL-1	COLUMNS ON THE SALES FLOOR, DECK, BAR JOISTS, GIRDER TRUSSES, CONDUIT, SPRINKLER LINES, UNISTRUT, HARD DUCT WORK (U.N.O.), METAL GRILLES, GYP BD ABOVE PAINT LINE & VMT - SEE DWGS (PT-2)		CAULK ALL PINHOLES PRIOR TO PRIME AND PAINT	102
																			CL-2	METAL GRILLES, SACKING COUNTER WALL ABOVE TILE, GYP BD WALLS BELOW PAINT LINE, SOFFITS, HARD DUCT WORK, AND VMT - SEE DWGS			
																			CL-5	CONCRETE PALLET BUMPER			
103	UNISEX 1	POLCONC	SS-7	1/2" MLD (B)	X		T-2	GYP BD	T-2	GYP BD	T-2	GYP BD	T-2	GYP BD	SAPC-1	--	9'-6"	PT-5	CL-7	GYP BD WALLS		103	
104	HALL	POLCONC	VB-1	1/2"	X	3/4"	LPB-1	GYP BD	LPB-1	GYP BD	LPB-1	GYP BD	LPB-1	GYP BD	SAPC-1	--	9'-6"	PT-6	CL-2	GYP BD WALLS, SOFFITS			
105	UNISEX 2	POLCONC	SS-7	1/2" MLD (B)	X		T-2	GYP BD	T-2	GYP BD	T-2	GYP BD	T-2	GYP BD	GYP BD	--	9'-0"		CL-8	CEILING AT DRINKING FOUNTAINS			
105																		PT-5	CL-7	GYP BD WALLS		105	
106	BREAKROOM	POLCONC	VB-1	1/2" MLD (C)	X		GYP BD	AL/GL / GYP BD	GYP BD		GYP BD	GYP BD / T-5	GYP BD		SAPC-1	--	9'-6"	PT-5	CL-7 & 11	GYP BD WALLS		106	
107	OFFICE	POLCONC	VB-1	1/2" MLD (C)	X		GYP BD		GYP BD		GYP BD		GYP BD		SAPC-1	--	9'-6"	PT-5	CL-7	GYP BD WALLS		107	
108	UTILITY AREA	CONC	-	1/2"			PLWD	GYP BD	PLWD	GYP BD	PLWD / FRP	PLWD / GYP BD	PLWD	GYP BD	EXP-1	--	VARIES	PT-5	CL-X	MATCH BACK ROOM		EXTEND FRP 4'-0" ABOVE MOP SINK ON BACK WALL, PLWD FULL HEIGHT BEHIND ROOF ACCESS LADDER - SEE C3/A213	108
109	BACK ROOM	CONC	CPB	1/2"			PLWD	GYP BD	PLWD	GYP BD	PLWD	GYP BD	PLWD	GYP BD	EXP-1	--	VARIES	PT-5	CL-4	EDGE OF OVERHEAD DOOR OPENING, TRACK GUARDS, WARNING STRIPES ON FLOOR (STRIPING TO BE 4" WIDE W/ 12" SPACING IN-BETWEEN)			109
																			CL-6	LOWER PLYWOOD WALLS, TRIM, CONCRETE PALLET BUMPER, COLUMNS, BRACED BAY STEEL, METAL GRILLES CMU (WHEN APPLICABLE)			
																			CL-8	UPPER GYP BD WALLS			
110	ECOMMERCE	POLCONC	VB-1	1/2" MLD. (C)	X	3/4"	LPB-1	GYP BD	LPB-1	GYP BD	LPB-1	GYP BD	LPB-1	GYP BD	EXP-1	--	VARIES	PT-6	CL-1	DECK, BAR JOISTS, GIRDER TRUSSES, CONDUIT, SPRINKLER LINES, UNISTRUT, HARD DUCT WORK (U.N.O.), METAL GRILLES, GYP BD ABOVE PAINT LINE			110
																			CL-2	WALLS ABOVE LPB, SOFFITS & HARD DUCT WORK			
111	CLOSET	POLCONC	VB-1	1/2"			GYP BD		GYP BD		GYP BD		GYP BD		SAPC-1	--	9'-6"	PT-5	CL-7	GYP BD WALLS		111	

FINISH NOTES:	
1	SEE REFLECTED CEILING PLAN FOR ALL CEILINGS AND SOFFITS.
2	REFER TO APPENDIX 'A' FOR ITEMS FURNISHED BY OWNER AND INSTALLED BY CONTRACTOR
3	REFER TO APPENDIX 'B' FOR ITEMS PROVIDED BY OWNER.
4	DO NOT PAINT GALVANIZED DOOR THRESHOLDS
5	USE SOLVENT TO REMOVE ALL MANUFACTURER WORDING ON EXPOSED PVC PIPING.
6	PAINT ALL EXPOSED PIPING TO MATCH ADJACENT CEILING/WALL COVERING.
7	SEE SPECIFICATION SECTION 099100 FOR PAINT SYSTEMS.
8	REFER TO PAINT FINISH SCHEDULES FOR TREATMENT AND COLOR OF WALL FINISHES.

GYP BD KEYNOTES:	
A	MOLD (MLD) RESISTANT GYP BD TO EXTEND UP TO 2' ABOVE T.O. COOLER/FREEZER. MLD GYP BD TO BE INSTALLED UP TO 8' AFS AT ALL WALLS SURROUNDING MULTI-DECK UNITS AND ALONG ENTIRE LENGTH OF FIRST AISLE.
B	MOLD (MLD) RESISTANT GYP BD TO EXTEND TO CEILING ALL WALLS.
C	MOLD (MLD) RESISTANT GYP BD ON WALLS ADJACENT TO FREEZER. APPLY VAPOR BARRIER BETWEEN GYP BD AND STUDS.

SOUND ATTENUATION BATTS:	
1	PROVIDE SOUND BATTS FOR FULL HEIGHT OF WALL ON ALL INTERIOR PARTITIONS SURROUNDING ROOMS WITH "X" IN SCHEDULE ABOVE

VAPOR BARRIER:	
1	PROVIDE VAPOR BARRIER ON WALLS ADJACENT TO FREEZER BETWEEN STUD AND GYP ON FREEZER SIDE OF WALL

FINISH MATERIAL SCHEDULE :				
MAT. KEY	KEY DESCRIPTION	MANUFACTURER	DESCRIPTION - COLOR	REMARKS
AL/GL	ALUMINUM & GLASS STOREFRONT		CLEAR ANODIZED	SEE A602 FOR GLAZING TYPES
CONC.	CONCRETE SLAB			SEE PROJECT MANUAL - SECTION 033000
EXP	EXPOSED STRUCTURE			SALES FLOOR - GC TO ENSURE ALL JOIST AND JOIST GIRDER TAGS ARE PROPERLY SECURED TO JOIST WEBBING AND CONCEALED FROM VIEW PRIOR TO PAINTING.
EXP-1	EXPOSED STRUCTURE			BACK ROOM/ABOVE CEILINGS
FRP	FIBER REINF PLASTIC		P-151 LIGHT GRAY	SEE PROJECT MANUAL - SECTION 066400
GR-1	GROUT	MAPEI	#5047 CHARCOAL	GROUT FOR T-2 AND T-3
GR-2	NOT USED			
GR-3	GROUT	MAPEI	#5220 EGGSHELL	GROUT FOR T-4, T-5
GR-4	NOT USED			
GR-5	GROUT	MAPEI	#5004 BAHAMA BEIGE	GROUT FOR T-1
GYP BD	GYP SUM WALL BOARD			SEE PROJECT MANUAL - SECTION 092900
LPB-1	LAMINATED PARTICLE BOARD - WAINSCOT	FORMICA	#5883-58 PECAN WOODLINE	COORDINATE w/ MILLWORK VENDOR TO BE INSTALLED 1/2" AFS - REFER TO APPENDIX A.
LPB-2	LAMINATED PARTICLE BOARD - WINDOW COUNTER, WINDOW SILLS AND CABINERY, BREAK ROOM HIGH TOP COUNTER	FORMICA	#5884-58 CHESTNUT WOODLINE	COORDINATE w/ MILLWORK VENDOR. REFER TO APPENDIX A.
LPB-3	LAMINATED PARTICLE BOARD - COUNTERTOPS OFFICE	FORMICA	#961-58 FOG	COORDINATE w/ MILLWORK VENDOR. REFER TO APPENDIX A.
LPB-4	NOT USED			
LPB-5	LAMINATED PARTICLE BOARD - COOLER AND FREEZER VALANCES	FORMICA	#2297-58 TERRILL	COORDINATE w/ MILLWORK VENDOR. REFER TO APPENDIX A.
POLCONC	CONCRETE SLAB		GROUND AND POLISHED	COORDINATE W/ POLISHING VENDOR. REFER TO APPENDIX B.
PLWD	PLYWOOD - PAINTED		PT-7 / CL-6; SEMIGLOSS	BACK ROOM; SEE PROJECT MANUAL - SECTION 061053 (RUN PLWD VERTICAL)
SAPC-1	SUSPENDED ACOUSTIC PANEL CEILING		WHITE	SEE PROJECT MANUAL - SECTION 095113
SS-1	SCHLUTER STRIP - SACKING COUNTER TILE	SCHLUTER	SCHIENE; AE 100; SATIN ANODIZED ALUMINUM FINISH	THIN SET PORCELAIN WALL TILE EDGE - SIZE TO FIT TILE; INCLUDE ALL SPECIAL CORNER AND TRIM SHAPES (GC FURNISH AND INSTALL)
SS-2	SCHLUTER STRIP - RESTROOM WALL	SCHLUTER	RONDEC; DB 14 AE; SATIN ANODIZED ALUMINUM FINISH	WALL TILE EDGE - SIZE TO FIT TILE; INCLUDE ALL SPECIAL CORNER AND TRIM SHAPES (GC FURNISH AND INSTALL)
SS-3	SCHLUTER STRIP - SACKING COUNTER BASE	SCHLUTER	DILEX-AHKA; AHKA 100 AE; SATIN ANODIZED ALUMINUM FINISH	WALL TILE BASE - SIZE TO FIT TILE; INCLUDE ALL SPECIAL CORNER AND TRIM SHAPES; INSTALL FLANGE ON VERTICAL SURFACE (GC FURNISH AND INSTALL)
SS-4	SCHLUTER STRIP - SACKING COUNTER TILE	SCHLUTER	QUADEC; Q100 AE; SATIN ANODIZED ALUMINUM FINISH	THIN SET PORCELAIN TILE CORNERS - SIZE TO FIT TILE; INCLUDE ALL SPECIAL CORNER AND TRIM SHAPES (GC FURNISH AND INSTALL)
SS-5	NOT USED			
SS-6	NOT USED			
SS-7	SCHLUTER STRIP - RESTROOM WALL BASE	SCHLUTER	DILEX-AHKA; AHKA 80 AE; SATIN ANODIZED ALUMINUM FINISH	WALL TILE BASE - SIZE TO FIT TILE; INCLUDE ALL SPECIAL CORNER AND TRIM SHAPES; INSTALL FLANGE ON VERTICAL SURFACE (GC FURNISH AND INSTALL)
SSM-1	SOLID SURFACE MATERIAL - COUNTER BREAKROOM	WILSONART	#9175 ML(3) AVALANCHE MELANGE	COORDINATE w/ MILLWORK VENDOR. REFER TO APPENDIX A.
T-1	GLAZED TILE	DALTILE	WILLOW BEND - DARK BROWN WB03, 6'X24" (½ BOND)	SACKING COUNTER ACCENT TILE; (GC FURNISH AND INSTALL) GROUT: GR-5
T-2	PORCELAIN TILE	DALTILE	DB PORTFOLIO PORC - 12'X24" PF05 ASH GRAY STD (RUNNING BOND)	RESTROOM WALL TILE; (GC FURNISH AND INSTALL); GROUT: GR-1
T-3	PORCELAIN TILE	DALTILE	DB PORTFOLIO PORC - 12'X24" PF05 ASH GRAY STD (1/3 RUNNING BOND)	ANCILLARY FLOOR TILE; (GC FURNISH AND INSTALL); GROUT: GR-1
T-4	GLAZED TILE	DALTILE	RITTENHOUSE SQUARE - WHITE 0100 SEMI-GLOSS, 3'X6" (RUNNING BOND)	SALES FLOOR REAR WALL ACCENT TILE; (GC FURNISH AND INSTALL); GROUT: GR-3
T-5	PORCELAIN TILE	DALTILE	RITTENHOUSE SQUARE - ARCTIC WHITE MATTE, 3'X6" (RUNNING BOND)	BREAKROOM BACKSPLASH TILE; (GC FURNISH AND INSTALL) GROUT: GR-5
VB-1	VINYL BASE	ROPPE	193 BLACK /BROWN	SEE PROJECT MANUAL - SECTION 096513
WP-1	WOOD PANEL	ARCH SYSTEMS	INTERPLAIT ECO-PANELS - WPVEP141	FOR NATIONAL ACCOUNT ORDERING, CONTACT RACHEL COOPER OF ARCH SYSTEMS VIA PHONE: 646-460-8222 OR EMAIL: RCOOPER@ARCHSYSTEMS.COM AND CC NEAMP@ARCHSYSTEMS.COM
		ALTERNATE: SKYLINE FLOORSCAPES	ALTERNATE: SFS-W-0024	FOR NATIONAL ACCOUNT ORDERING, CONTACT BLAKE CHAFFEE OF SKYLINE FLOORSCAPES VIA PHONE 512-782-8484 OR EMAIL BLAKEC@SKYLINEFLOORSCAPES.COM

WALL AND SURFACE PROTECTION SCHEDULE :				
MAT. KEY	KEY DESCRIPTION	MANUFACTURER	DESCRIPTION - COLOR	REMARKS
BG	BUMPER GUARD	McCUE	STAINLESS STEEL	SEE PROJECT MANUAL - SECTION 102600
BR	BUMPER RAIL	McCUE	CART STOP SSR	SEE PROJECT MANUAL - SECTION 102600
BR-C	BUMPER RAIL	McCUE	CART STOP UG150 12"H. - 101 (GREY)	SEE PROJECT MANUAL - SECTION 102600
CG-A	CORNER GUARD		CLEAR ANODIZED ALUMINUM	SEE PROJECT MANUAL - VOL. 3, APPENDIX A, SECTION 064023
CG-ST	CORNER GUARD		STEEL - PT-3 / CL-6; SEMIGLOSS	REFER TO CG-A SCHEDULE FOR SIZE AND LOCATION
CPB	CONC. PALLET BUMPER		PT-3 / CL-6; SEMIGLOSS(BACK ROOM, COOLER, FREEZER)	SEE DETAIL B1/A511 FOR ASSEMBLY
CRTB	CART BUMPER		PT-3 / CL-8; SEMIGLOSS(SALES)	SEE DETAIL 7/A601 FOR COLOR BREAK
KP	KICK PLATE		CONC NATURAL - RUBBED FINISH	SEE DETAIL D1/S301
SSBR	STAINLESS STEEL BUMPER RAIL	TARPENING - LAFOLLETTE CO	STAINLESS STEEL	SEE PROJECT MANUAL - VOL. 3, APPENDIX A, SECTION 087100

BOLLARD SCHEDULE :				
MAT. KEY	KEY DESCRIPTION	MANUFACTURER	DESCRIPTION - COLOR	REMARK
BLRD-1	NOT USED			
BLRD-2	10" Ø BOLLARD		STEEL PIPE FILLED w/ GROUT - PT-19 / CL-4; SEMIGLOSS	@ LOADING DOCK - SEE STRUCTURAL DWG.
BLRD-3	3" Ø BOLLARD		GALV STEEL PIPE POST	@ CART CORRAL - CENTER WITHIN ROWS. ATTACH OWNER PROVIDED STARTER CHAINS FOR CART SYSTEM - COORD LAYOUT WITH ALDI CONSTRUCTION REPRESENTATIVE; SEE PROJECT MANUAL - SECTION 055000
BLRD-4	6" Ø STEEL PIPE BOLLARD W/ COVER	McCUE CORPORATION	SLOPED PLASTIC COVER C5PC-65-54-155	SLOPED SIDE OF COVER TO FACE AWAY FROM BUILDING. FOR ORDERING, CONTACT JOHN ROMANO, 574-532-0221, ROMKTG@AOL.COM

EQUIPMENT AND ACCESSORY SCHEDULE :				
MAT. KEY	KEY DESCRIPTION	MANUFACTURER	DESCRIPTION - COLOR	REMARK
AC-X	TOILET ROOM ACC.	BY CONTRACTOR		SEE PROJECT MANUAL - SECTION 102800
MDU	MULTIDECK UNITS W/INTEGRAL FASCIA	HUSSMAN		BY OWNER
TR-1	TRASH RECEPTACLE	DAWN ENTERPRISES	MODEL # RP40S-ALDI - FACTORY FINISH	FOR ORDERING, CONTACT DAWN ENTERPRISES VIA PHONE: 800-262-3296 OR EMAIL: brenda@godawn.com
R-1	REFRIGERATOR	FRIGIDAIRE		OWNER SUPPLIED CONTRACTOR INSTALLED
MW-1	MICROWAVE OVEN	WHIRLPOOL		OWNER SUPPLIED CONTRACTOR INSTALLED
DW-1	DISHWASHER	FRIGIDAIRE		OWNER SUPPLIED CONTRACTOR INSTALLED
R-2	REFRIGERATOR	TRUE		OWNER SUPPLIED CONTRACTOR INSTALLED
F-1	FREEZER	TRUE		OWNER SUPPLIED CONTRACTOR INSTALLED

CG-A SCHEDULE (U.N.O.) :		
TYPE	SIZE	REMARKS
INSIDE CORNERS	1" x 1" x 1/16" x 80" LENGTHS	INSTALL AT LPB ONLY. OWNER FURNISHED CONTRACTOR INSTALLED
OUTSIDE CORNERS	2" x 2" x 1/16" x 80" LENGTHS	INSTALL AT LPB ONLY. OWNER FURNISHED CONTRACTOR INSTALLED
J CHANNEL	3/4" x 96" LENGTHS	INSTALLED AT ALL LPB EDGES. LONG LEG ON THE BACK SIDE OF LPB AND SHORT LEG LEFT EXPOSED. OWNER FURNISHED CONTRACTOR INSTALLED
ANGLE	FRY REGLET JDM-50	INSTALLED AT BOTTOM OF GYP. BD. ABOVE COOLER AND FREEZER DOORS. CONTRACTOR PROVIDED

INTERIOR MTL. STUD SCHEDULE (U.N.O.) :			
3 5/8" STUD DESIGNATION	MAXIMUM HEIGHT	6" STUD DESIGNATION	MAXIMUM HEIGHT
362S125-30 @ 16" O.C. (20 GAUGE)	16'-1"	600S125-30 @ 16" O.C. (20 GAUGE)	23'-0"
362S125-43 @ 16" O.C. (18 GAUGE)	17'-5"	600S125-43 @ 16" O.C. (18 GAUGE)	26'-2"
362S125-54 @ 16" O.C. (16 GAUGE)	18'-8"	600S125-54 @ 16" O.C. (16 GAUGE)	28'-0"

STUD DEPTH INDICATED ON DRAWINGS	
STUDS PER THIS TABLE REQUIRE SHEATHING BOTH SIDES OF STUD AND/OR BRIDGING AT 4'-0" O.C.	
STRUCTURAL DRAWINGS & PROJECT SPECIFIC LIGHT GAUGE SHOP DRAWINGS SUPERSEDE THIS TABLE	
PROVIDE DOUBLE KING STUDS ON BOTH SIDES OF OPENING.	
THIS TABLE IS FOR GENERAL REFERENCE ONLY. STUD MANUFACTURER'S SPAN TABLES SHOULD SUPERSEDE THIS TABLE BASED ON STUD DESIGNATION SELECTED AND SPAN REQUIREMENTS.	

PAINT COLOR SCHEDULE :				
MAT. KEY	KEY DESCRIPTION	MANUFACTURER	DESCRIPTION - COLOR	REMARKS
CL-1	PAINT COLOR	SHERWIN WILLIAMS	#7510 CHATEAU BROWN	
CL-2	PAINT COLOR	SHERWIN WILLIAMS	#6071 POPULAR GRAY	
CL-3	PAINT COLOR	SHERWIN WILLIAMS	#6073 PERFECT GREIGE	USED ABOVE PAINT BREAK LINE ONLY WITH SUSPENDED CEILING
CL-4	PAINT COLOR	SHERWIN WILLIAMS	SAFETY YELLOW	
CL-5	PAINT COLOR	SHERWIN WILLIAMS	#7504 KEYSTONE GRAY	
CL-6	PAINT COLOR	SHERWIN WILLIAMS	#7073 NETWORK GRAY	
CL-7	PAINT COLOR	SHERWIN WILLIAMS	#7015 REPOSE GRAY	
CL-8	PAINT COLOR	SHERWIN WILLIAMS	#7757 HIGH REFLECTIVE WHITE	
CL-9	PAINT COLOR	SHERWIN WILLIAMS	#6089 GROUNDED (197-C6)	
CL-10	NOT USED			
CL-11	PAINT COLOR	SHERWIN WILLIAMS	#6499 STREAM	
PT-X	PAINT SYSTEM	BY CONTRACTOR		SEE PAINT SYSTEM SCHEDULE ON THIS SHEET. REFER TO SPEC SECTION 099100 FOR PRODUCT REQUIREMENTS.

INTERIOR PAINT SYSTEM SCHEDULE				EXTERIOR PAINT SYSTEM SCHEDULE			
PT #	SYSTEM	SUBSTRATE	SYSTEM	PT #	SYSTEM	SUBSTRATE	SYSTEM
PT-1	LATEX SEMI-GLOSS	CONCRETE BLOCK	1C. PRIMER B25W25 1C. B31-2600 1C. B31-2600	PT-15	LATEX SATIN	CAST CONCRETE	1C. PRIMER A24W8300 1C. K62-650 1C. K62-650
PT-2	DRY-FALL (RETROFIT/ RENOVATION/ REFRESH STORES)	EXPOSED STEEL, WOOD, DUCTS, CONDUIT & SCRIM	1C. PRIMER B66-1560 1C. B66-1560	PT-16	URETHANE GLOSS	CONCRETE BLOCK	1C. PRIMER A2W200 1C. 646-100 1C. B65-720
PT-2	DRY-FALL (NEW CONSTRUCTION STORES)	EXPOSED STEEL, WOOD, DUCTS, CONDUIT & SCRIM	STEEL DECKS: 1C. PRIMER B66-310 1C. B42W181 GALVANIZED DECKS: 1C. PRIMER B42W181 1C. B42W181	PT-17	LATEX SATIN	EXISTING EIFS /STUCCO	1C. PRIMER B28W2600 1C. B20-2600 1C. B20-2600
PT-3	LATEX SEMI-GLOSS	STEEL & CONC.	1C. PRIMER B66-310 1C. B66-650 1C. B66-650	PT-18	LATEX SATIN	P.T. WOOD	1C. PRIMER B24W804 1C. K43 1C. K43
PT-4	LATEX SEMI-GLOSS	GALVANIZED METAL GRILLES	1C. PRIMER B66-310 1C. B66-650 1C. B66-650	PT-19	LATEX GLOSS	STEEL	1C. PRIMER 646-100 1C. B65-720 1C. B65-720
PT-5	LATEX EGGSHELL	GYPSUM BOARD	1C. PRIMER B28W2600 1C. B20-2600 1C. B20-2600	PT-20	LATEX OVER ALKALI-RESISTANT PRIMER SYSTEM	CMU	1C. PRIMER A24W200 1C. K43 1C. K43
PT-6	LATEX FLAT	GYPSUM BOARD	1C. PRIMER B28W2600 1C. B30-2600 1C. B30-2600	PAINT NOTES:			
PT-7	LATEX SEMI-GLOSS	PLYWOOD AND TRIM	1C. PRIMER B28W8111 1C. B31 1C. B31	1	PAINT COLORS MUST BE PROVIDED BY MANUFACTURER INDICATED; NO SUBSTITUTIONS WILL BE ACCEPTED FOR COLOR.		
PT-8	WATER-BORNE URETHANE	STEEL	1C. PRIMER 646-100 1C. B65-720 1C. B65-720	2	ALL PAINTS ARE FROM SHERWIN-WILLIAMS NATIONAL ACCT. CONTACT: TODD MCMARTIN 630-617-1714 / TODD.R.MCMARTIN@SHERWIN.COM		
PT-9	WATER-BORNE EPOXY URETHANE	CONCRETE	1C. PRIMER 3460 WBE 1C. 3460 WBE/5150-15 1C. 4A08				
PT-10	WATER-BORNE EPOXY	CONCRETE	1C. PRIMER 8100 1C. 8100 1C. 8100				