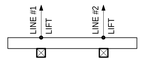

A1

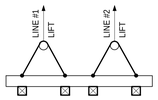

B1

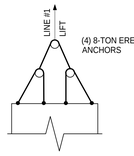

PANEL WEIGHT **GREATER** THAN 32,000#

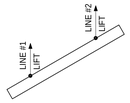

A2

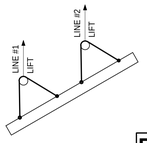

B2

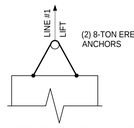

PANEL WEIGHT **LESS** THAN 32,000#

LINE #1 STEP 4 ALL PANEL LENGTHS WHEN USING ERECTION ANCHORS

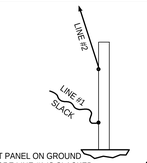

REST PANEL ON GROUND BEFORE LINE #1 IS SLACKED AND REMOVED

A3

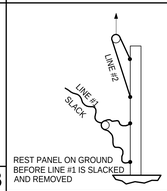

REST PANEL ON GROUND BEFORE LINE #1 IS SLACKED AND REMOVED

B3

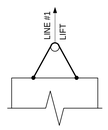

ALL PANEL WEIGHTS

LINE #1 STEP 4 ALL PANEL LENGTHS WHEN USING 1/2" DIA. STRAND LOOPS

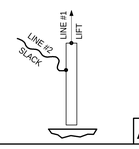

A4

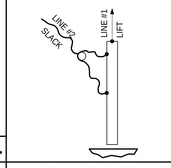

B4

LIFTING METHOD FOR PANELS W/(4)STRIPPING DEVICES	LIFTING METHOD FOR PANELS W/(8)STRIPPING DEVICES
LIFTING METHOD FOR COLUMNS W/(2)STRIPPING DEVICES	LIFTING METHOD FOR COLUMNS W/(4)STRIPPING DEVICES

DO NOT USE COLUMN BASE PLATES FOR LIFTING!

ERECTOR NOTE

ERECTION BY METROMONT CORPORATION (MC)

GENERAL NOTES

(1) ACCESS TO THE JOBSITE FOR DELIVERY, UNLOADING AND ERECTING OF MEMBERS AND OPERATION OF ERECTION EQUIPMENT ON DRY AND STABILIZED GRADE IS TO BE MAINTAINED BY THE GENERAL CONTRACTOR AT ALL TIMES. THE GC SHALL BE RESPONSIBLE FOR ALL NECESSARY RIGHTS TO ACCESS FOR DELIVERY AND ERECTION EQUIPMENT. THIS INCLUDES REMOVAL OR DISCONNECTION OF ALL ELECTRICAL OR TELEPHONE LINES, OVERHANGING TREES, CURBS, OR OVERHEAD OBSTRUCTION WHICH INTERFERE WITH EQUIPMENT MOVEMENT OR ACCESS. GC SHALL BE RESPONSIBLE FOR PROTECTION OF ALL UNDERGROUND UTILITIES, CONDUITS OR STRUCTURES.

(2) ALL OPENINGS LESS THAN 10 INCH DIAMETER OR NOT SHOWN ON MC DRAWINGS ARE TO BE CUT IN FIELD BY GC. HOLE CUTTING THROUGH STRAND OR STEM SHALL NOT BE MADE WITHOUT WRITTEN PERMISSION OF MC.

(3) MEMBERS WILL BE FABRICATED TO TOLERANCES SPECIFIED IN DIVISION 6, SECTION 4 OF PCI MNL116-99 (FOURTH EDITION) MANUAL FOR QUALITY CONTROL FOR PLANTS AND PRODUCTION OF PRECAST/PRESTRESSED CONCRETE PRODUCTS.

(4) PRESTRESSED CONCRETE MEMBERS HAVE AN INHERENT CAMBER THAT ARCHITECTURAL DETAILS SHOULD TAKE INTO CONSIDERATION. TOPPING THICKNESS MAY VARY WITH CAMBER. LONG TERM DEFLECTIONS PRECLUDE THE USE OF CAMBER FOR DRAINAGE, THEREFORE, POSITIVE DRAINAGE BY SLOPING IS RECOMMENDED. REFER TO DESIGN CALCULATIONS FOR ANTICIPATED CAMBER OF MEMBERS.

(5) MC DOES NOT ASSUME RESPONSIBILITY FOR COORDINATION OF OUR DRAWINGS WITH OTHER TRADES INVOLVED.

(6) DRAWINGS RECEIVED BY THE ARCHITECT AND/OR ENGINEER AND NOT REJECTED AND TRANSMITTED BY THE GENERAL CONTRACTOR TO MC SHALL CONSTITUTE APPROVAL AND RELEASE FOR PRODUCTION OF THE MEMBERS COVERED. MC SHALL NOT BE HELD LIABLE FOR ANY DELAYS IN SHIPMENT OCCURING AS A RESULT OF DELAYED RECEIPT OF APPROVED DRAWINGS.

(7) NO MODIFICATIONS SHALL BE MADE TO ANY METROMONT SUPPLIED MATERIAL (PRODUCTS OR LOOSE MATERIAL) WITHOUT PRIOR APPROVAL OF THE METROMONT CORPORATION.

FOUNDATION NOTES:

(1) ALL FOOTING AND/OR FOUNDATION WALLS WHICH ARE PLACED BY OTHER TRADES WITH BEARING SURFACES FOR PRECAST/PRESTRESSED MEMBERS SHALL BE TRUE TO ELEVATION (+/- 1/4" MAXIMUM). MC TO BE NOTIFIED IN WRITING OF ANY DISCREPENCIES PRIOR TO MC MOBILIZING FOR ERECTION.

(2) A TWO (2) FOOT MINIMUM WORKING CLEARANCE MUST BE MAINTAINED FROM FOOTING AND/OR FOUNDATION WALLS FOR PRECAST ERECTION. FOOTINGS AND TRENCHES SHALL BE CLEAN AND FREE OF WATER WITH COLUMN LINES CLEARLY MARKED ON EACH FOOTING AHEAD OF ERECTION CREWS BY GC.

(3) ALL CONNECTION PLATES CAST INTO POURED-IN-PLACE CONCRETE TO BE SET TRUE TO LINE AND GRADE AND PROTECTED FROM RUST AND DAMAGE BY GC.

(4) ANCHOR BOLTS FOR COLUMNS, INCLUDING THREE (3) NUTS AND TWO (2) WASHERS EACH ARE TO BE SET TRUE TO LINE (+/- 1/4 INCH MAXIMUM) AND GRADE AND TO BE PLUMB AND PROTECTED FROM RUST AND DAMAGE BY GC.

(5) ALL FOUNDATION WALLS AND POURED-IN-PLACE RETAINING WALLS ARE TO BE POURED WITH A 1" JOINT AT ALL PRECAST COLUMN FACES.

MAXIMUM ALLOWED PASSENGER VEHICLE WEIGHTS AND SPEED

1. GARAGE DESIGNED AND CONSTRUCTED FOR PASSENGER VEHICLES ONLY.
2. MAXIMUM GROSS PASSENGER VEHICLE WEIGHT IS 10,000 LBS, WITH NO ONE AXLE WEIGHING MORE THAN 5000 LBS, AS LOADED.
3. MAXIMUM SPEED IS 10 MPH.

DRILLING, ANCHORING, OR CORING DO'S & DON'TS:

COLUMNS

1. DRILLING FOR ANCHORAGE IS PERMITTED BUT MUST BE A MINIMUM OF 5" CLEAR OF THE CORNER.
2. CORE DRILLING IS NOT ALLOWED.
3. DO NOT DRILL THROUGH REINFORCEMENT.

INVERTED TEE BEAMS

1. DO NOT DRILL, CORE, OR SHOOT ANY ANCHORS INTO THE BOTTOM OF THE INVERTED TEE BEAM.
2. DRILLING OR SHOOTING OF ANY ANCHORS INTO THE LEDGE OF THE INVERTED TEE BEAM IS PERMITTED, HOWEVER; THE ANCHORS MUST BE NO CLOSER THAN 3" FROM TOP OR BOTTOM OF THE LEDGE AND NOT WITHIN 2'-0"" OF A DOUBLE TEE STEM.
3. NO CORING IN THE LEDGE.
4. DRILLING OR ANCHORING IN TO THE INVERTED TEE BEAM MUST BE A MINIMUM OF 4" ABOVE THE TOP OF THE LEDGE AND 8' DOWN FROM THE TOP OF THE BEAM.
5. DO NOT DRILL THROUGH REINFORCEMENT.

DOUBLE TEES

1. NO DRILLING, CORING, SHOOTING, OR ANCHORING ANYTHING INTO THE BOTTOM OF THE DOUBLE TEE STEM.
2. NO EXPANSION ANCHORING INTO DOUBLE TEE STEM.
3. ONLY THROUGH BOLTING IS AN ACCEPTABLE ATTACHMENT METHOD INTO THE UPPER PORTION OF THE DOUBLE TEE STEM. SEE SKETCH SHOWING ACCEPTABLE LOCATION FOR THROUGH BOLTING (PROVIDED ON A PROJECT-BY-PROJECT BASIS).
4. EXPANSION ANCHORING INTO DOUBLE TEE FLANGE IS PERMITTED BUT ONLY AFTER THE TOPPING HAS BEEN POURED. MAXIMUM EMBEDMENT IS 3".
5. DRILLING, ANCHORING, OR THROUGH BOLTING INTO THE DOUBLE TEE FLANGE IS PERMITTED. METROMONT CORPORATION IS NOT RESPONSIBLE FOR ANY CHIPS OR SPALLS THAT MAY OCCUR.
6. CORING OF THE DOUBLE TEE FLANGE IS PERMITTED. THE HOLE MUST BE A MINIMUM OF 6" CLEAR FROM EDGE OF HOLE TO EDGE OF DOUBLE TEE.

BUILDING WALL PANELS (SOLID OR INSULATED)

1. TYPICAL WALL PANELS HAVE MAIN REINFORCING (PRESTRESS STRAND OR MILD REINFORCEMENT) RUNNING LONGITUDINALLY. ALL CORING MUST BE A MINIMUM OF 3" CLEAR DISTANCE FROM EDGE OF HOLE TO MAIN REINFORCING. ANCHORING DEVICES MUST MEET THE REQUIREMENTS OF THE MANUFACTURER AND NOT CUT OUR MAIN REINFORCEMENT.
2. FOR INSULATED WALL PANELS, MAXIMUM EMBEDMENT DEPTH FOR ANCHORS IS 1'-5 IN SHEAR GRID INSULATED WALL PANELS, ANCHORAGE SHOULD BE MADE IN THE 20"" WIDE TROUGH WHICH PROVIDES 3.5" OF EMBEDMENT DEPTH FOR ANCHORS. NO DRILLING OR CORING THROUGH REINFORCEMENT AND SHEAR GRID MESH IS ALLOWED.
3. A SKETCH DETAILING THE LOCATION AND SIZE OF A CORED HOLE MUST BE SUBMITTED TO METROMONT CORPORATION FOR REVIEW PRIOR TO ANY WORK BEING PERFORMED

DRAWING LOG (ALL SHEETS)

DATE	ISSUE #	ISSUE	SHEET	DESCRIPTION
*	1	**	E0.01	COVER, DESIGN CRITERIA, DRAWING LOG, GEN. NOTES
*	1	**	E0.02	STANDARD STRUCTURAL PRODUCT FINISHES
*	1	**	E1.01	FOUNDATION PLAN
*	1	**	E1.02	FOUNDATION CONNECTIONS
*	1	**	E2.01	FRAMING PLAN - LEVEL 1
*	1	**	E2.02	FRAMING PLAN - LEVEL 2
*	1	**	E2.03	FRAMING PLAN - LEVEL 3
*	1	**	E2.04	FRAMING PLAN - LEVEL 4
*	1	**	E2.05	FRAMING PLAN - LEVEL 5
*	1	**	E2.06	FRAMING PLAN - LEVEL 6
*	1	**	E3.00	OVERALL KEY PLAN
*	1	**	E3.01	EXTERIOR ELEVATION
*	1	**	E3.02	EXTERIOR ELEVATION
*	1	**	E3.03	EXTERIOR ELEVATION
*	1	**	E3.04	EXTERIOR/INTERIOR ELEVATION
*	1	**	E3.05	METROWALL ELEVATION
*	1	**	E3.06	METROWALL ELEVATION
*	1	**	E3.07	SHEARWALL ELEVATIONS
*	1	**	E4.01	STAIR #2 PLANS
*	1	**	E4.02	STAIR #2 ELEVATIONS
*	1	**	E4.03	STAIR #1 PLANS
*	1	**	E4.04	ELEVATOR ELEVATIONS
*	1	**	E4.05	ELEVATOR/STAIR #1 ELEVATIONS
*	1	**	E4.06	ELEVATOR/STAIR #1 ELEVATIONS
*	1	**	E4.07	STAIR #1 ELEVATIONS
*	1	**	E4.08	COVERED WALKWAY PLANS
*	1	**	E4.09	COVERED WALKWAY ELEVATIONS
*	1	**	E4.10	COVERED WALKWAY ELEVATIONS
*	1	**	E5.01	SECTIONS & DETAILS
*	1	**	E5.02	SECTIONS & DETAILS
*	1	**	E5.03	SECTIONS & DETAILS

A. DESIGN CRITERIA

ALL WORK CONFORMS TO THE FOLLOWING:
1. 2023 FLORIDA BUILDING CODE (2021 IBC)
2. AMERICAN CONCRETE INSTITUTE STANDARD BUILDING CODE REQUIREMENTS FOR REINFORCED CONCRETE (ACI 318-14)
3. THE PRECAST/PRESTRESSED CONCRETE INSTITUTE DESIGN HANDBOOK (PCI MNL-120, 8TH ED.)
4. ASCE 7-22
5. RISK CATEGORY II

METROMONT IS TO DESIGN PRECAST/PRESTRESSED STRUCTURAL MEMBERS AND CONNECTIONS ONLY. ALL OTHER DESIGN WORK ON THE PROJECT IS THE RESPONSIBILITY OF OTHERS.

B. WIND LOADS:

1. ULTIMATE DESIGN WIND SPEED = 161 MPH
2. WIND IMPORTANCE FACTOR: I= 1.0
3. WIND EXPOSURE CATEGORY: C
4. BASE V (N-S) =494 K V (E-W) = 1080 K

C. SEISMIC DATA:

1. SEISMIC IMPORTANCE FACTOR; I = 1.0
2. Ss = 0.05g AND S1 = 0.028g
3. SITE CLASS D
4. SEISMIC DESIGN CATEGORY A
5. Cs = 0.010

D. DEAD LOADS:

1. PRECAST MEMBER SELF WEIGHT
2. MISC. SDL: 5 PSF
3. ROOFING: 15 PSF

E. LIVE LOADS

1. ROOF: 20 PSF
2. SNOW + RAIN: 0 PSF
3. FLOOR: 40 PSF PARKING
4. WHEEL: 3k ON 20 SQ. IN.
5. STAIR: 100 PSF
6. IMPACT: 6k @ 18" OR 27" ABOVE DECK

MAXIMUM ALLOWED PASSENGER VEHICLE WEIGHTS AND SPEED

1. GARAGE DESIGNED AND CONSTRUCTED FOR PASSENGER VEHICLES ONLY.
2. MAXIMUM GROSS PASSENGER VEHICLE WEIGHT IS 10,000 lbs, WITH NO ONE AXLE WEIGHING MORE THAN 5000 lbs AS LOADED.
3. MAXIMUM SPEED IS 10 mph.

PRECAST CONCRETE:

A. REINFORCING STEEL: ASTM A615 GRADE 60; ASTM A706 GRADE 60 WELDABLE
WELDED WIRE FABRIC: ASTM A1064 MESH
ANCHOR BOLTS: ASTM A36
PRE-TENSIONING: ASTM A416 (GRADE 270) LOW-LAX 270K
PLATE STEEL: ASTM A36

B. UNLESS OTHERWISE NOTED ON THE DRAWINGS, LAP SPLICES SHALL BE A CLASS B SPLICE.

C. CONCRETE (28 DAY STRENGTH): 5000 PSI MIN. NORMAL WEIGHT FOR ALL PRECAST PRODUCT (UNO)

D. CONCRETE (RELEASE STRENGTH): 2500 PSI MIN. RELEASE STRENGTH FOR NON-PRESTRESSED MEMBERS (UNO)
3500 PSI MIN. RELEASE STRENGTH FOR PRESTRESSED MEMBERS (UNO)

CONSTRUCTION TYPE/FIRE RESISTANCE:

1. CONSTRUCTION TYPE = 2-B
2. FIRE RESISTANCE RATING (PER FBC 2020 TABLE 601)

(A.) FLOOR CONSTRUCTION (DOUBLE TEES) = 0 HR
(B.) STRUCTURAL FRAME (COLUMNS, GIRDERS, BEAMS, SPANDRELS) = 0 HR
(C.) BEARING WALLS = 0 HR
(D.) STAIRS / ELEVATOR SHAFTS = 0 HR

DEVITA COMMENTS IN BLUE

HCA FLORIDA ST. LUCIE HOSPITAL PD

PORT ST. LUCIE, FL

DEVITA
ATLANTA • GREENVILLE - RICHMOND
877.4.DEVITA • corp@devitainc.com
devita & associates, inc. / mepec

DESCRIPTION	DATE	BY	ISSUE

Preliminary
07/12/2024 11:21:19 AM

DESCRIPTION	DATE	BY	ISSUE
	*	JCW	1

DRAWING COVERS: COVER, DESIGN CRITERIA, DRAWING LOG, GEN. NOTES
PROJECT: HCA FLORIDA ST. LUCIE HOSPITAL PD
LOCATION: PORT ST. LUCIE, FL
ARCH. OR ENG.: TMPARTNERS, PLLC
CONTRACTOR: BRASFIELD & GORRIE, LLC
CHECKED BY: LKC DATE: 06/17/2024
DRAWN BY: JCW DATE: 06/17/2024

METROMONT
20 TWO NOTCH ROAD
GREENVILLE, SOUTH CAROLINA 29605
(864) 295-0295

JOB NUMBER 20979

DRAWING NUMBER E0.01

Proprietary Note: This document contains information which may be confidential and proprietary to Metromont Corporation and shall not be reproduced or transferred to other documents, disclosed to others or used for any purpose other than that which it was obtained without the prior written authorization from Metromont Corporation.

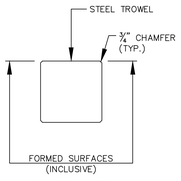

1. COLUMN

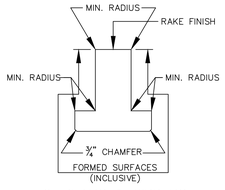

2. BEAMS & GIRDERS

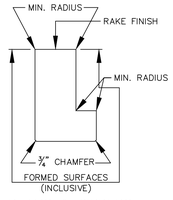

2. BEAMS & GIRDERS

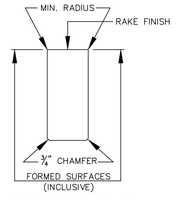

2. BEAMS & GIRDERS

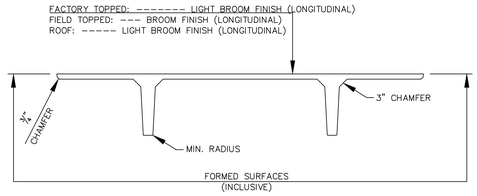

3. DOUBLE TEES

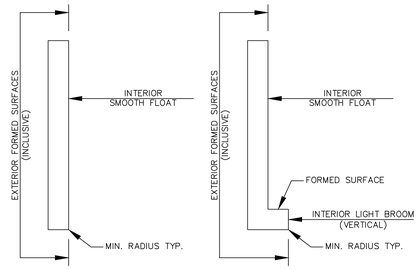

4. SPANDRELS

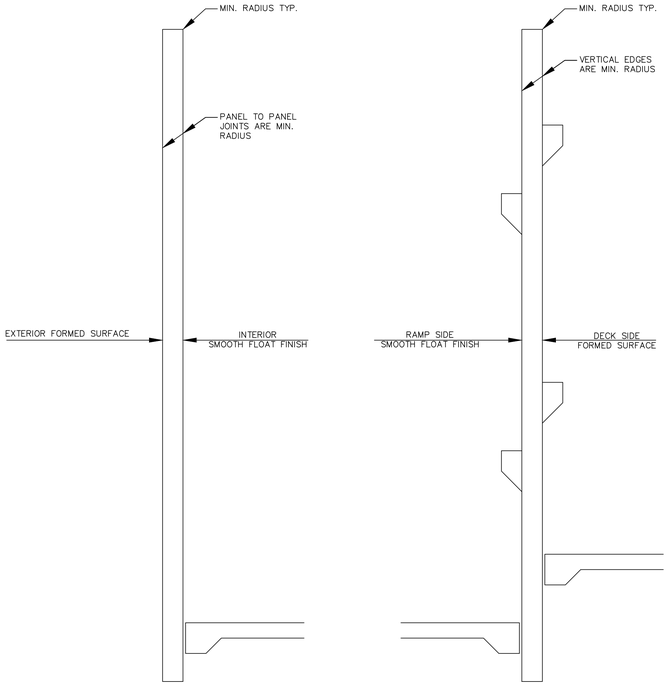

5. WALL PANELS AND SHEARWALLS

5. METROWALL

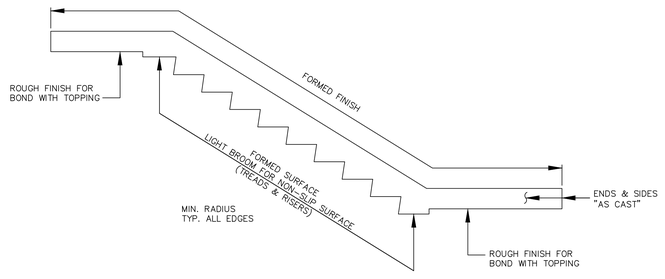

6. STAIR RUN (LANDING & TREADS)

METROMONT STANDARD PLANT RUN FINISH

1. COLUMN:
   FORMED SURFACE --------- FORM FINISH
   UP FACE ---------- STEEL TROWEL FINISH
   ENDS ---------- AS CAST
2. BEAMS AND GIRDERS:
   FORMED SURFACE --------- FORM FINISH
   TOP SURFACE ---------- RAKE FINISH
   ENDS ---------- AS CAST
3. DOUBLE TEES:
   FORMED SURFACE --------- FORM FINISH
   TOP SURFACE---------- FACTORY TOPPED: LIGHT BROOM FINISH
   FIELD TOPPED: BROOM FINISH (LONGITUDINAL)
   ROOF: LIGHT BROOM FINISH (LONGITUDINAL)
   ENDS ---------- AS CAST
4. SPANDRELS:
   FORMED SURFACE --------- FORM FINISH
   BACK FACE ---------- SMOOTH FLAOT FINISH
   ENDS ---------- AS CAST
5. WALL PANELS & SHEAR WALLS:
   FORMED SURFACE --------- FORM FINISH
   BACK FACE ---------- SMOOTH FLOAT FINISH
   ENDS ---------- AS CAST
6. STAIR RUN (LANDING & TREADS):
   FORMED SURFACE --------- FORM FINISH
   BACK FACE ---------- LIGHT BROOM FINISH
   ENDS & SIDES---------- AS CAST

FINISH DESCRIPTIONS:

FORM FINISH: (STANDARD UNDERSIDE)
CASTING AGAINST STEEL FORMS OR GLAZED WOOD FORMS. SURFACE HOLES CAUSED BY AIR BUBBLES UP TO ½" DIA. ARE ALLOWED, NORMAL COLOR VARIATIONS, FORM JOINT MARKS AND MINOR CHIPS AND SPALLS ARE PERMITTED.

BROOM FINISH: (STANDARD TOP)
TOP OF PRODUCT IS MECHANICAL SCREEDED, THEN A BROOM FINISH IS APPLIED. (SEE PRODUCT CROSS SECTION FOR DIRECTION OF BROOM.)

ROUGH BROOM FINISH: (STANDARD TOP)
TOP OF PRODUCT IS MECHANICAL SCREEDED, THEN A BROOM FINISH IS APPLIED WITH 1/4" AMPLITUDE. (SEE PRODUCT CROSS SECTION FOR DIRECTION OF BROOM.)

LIGHT BROOM FINISH: (STANDARD TOP)
TOP OF PRODUCT IS WET TROWELED AFTER MECHANICAL SCREEDING, THEN A BROOM FINISH IS APPLIED. (SEE PRODUCT CROSS SECTION FOR DIRECTION OF BROOM.)

SWIRL FINISH:
A SLIGHTLY IRREGULAR OVERLAPPING HALF CIRCLE PATTERN APPLIED TO WET TROWEL FINISH CONCRETE USING STIFF BRISTLED BROOMS

RAKE FINISH:
AFTER MECHANICAL SCREEDING, SURFACE RECIEVES BULL FLOAT PLUS ONE PASS WITH RAKE .

STEEL TROWEL FINISH:
AFTER MECHANICAL SCREEDING, SURFACE RECEIVES BULL FLOAT PLUS ONE MACHINE FLOAT, LEAVING SURFACE SANDY AND SLIGHTLY ROUGH THEN ONE MACHINE TROWEL WITH BLADES SET TO FINISH.

ENDS "AS CAST":
STRAND (IF PRESTRESS) ARE CUT FLUSH WITH END OF MEMBER IF EDGES ARE TO RECEIVE CAULKING, EDGES ARE CLEANED AND FINISHED TO MIN. RADIUS

"SACK" FINISH:
BUGHOLES ARE FILLED WITH GROUT PASTE AND EXCESS GROUT IS REMOVED WITH BURLAP CLOTH. FORMED SURFACE IS NOT BROKEN.

"RUB" FINISH:
FORMED SURFACE IS BROKEN WITH MECHANICAL RUBBING ROCK. A THIN LAYER OF GROUT PASTE IS APPLIED AND ALLOWED TO CURE. FINAL RUB IS THEN APPLIED, SMOOTHING OUT ROUGH AREAS WITH A FINE RUBBING ROCK.

GRADE "B" FINISH:
ALL AIR POCKETS AND HOLES OVER ¼" DIA. ARE FILLED WITH GROUT PASTE. ALL FORM OFFSETS OR FINS ARE GROUND SMOOTH.

GRADE "A" FINISH:
IN ADDITION TO THE REQUIREMENTS FOR GRADE "B" FINISH, ALL EXPOSED SURFACES ARE COATED WITH A NEAT CEMENT PASTE USING AN ACCEPTABLE FLOAT. AFTER PASTECOAT HAS DRIED, THE SURFACE IS RUBBED USING BURLAP TO REMOVE LOOSE PARTICLES.

SPECIAL ARCH. FINISHES:
SPECIFIED AS " PER APPROVED SAMPLE # 0000 "

PRODUCT FINISHES:

ALL PRODUCTS ARE METROMONT STANDARD PLANT RUN STRUCTURAL FINISH UNLESS NOTED OTHERWISE.

DEVITA
ATLANTA • GREENVILLE • RICHMOND
877.4.DEVITA • corp@devitainc.com
devita & associates, inc. chapter

*	DATE	BY	DESCRIPTION
1	JCW		
**			

Preliminary
07/12/2024 11:21:49 AM

DRAWING COVERS: STANDARD STRUCTURAL PRODUCT FINISH
PROJECT: HCA FLORIDA ST. LUCIE HOSPITAL PD
LOCATION: PORT ST. LUCIE, FL
ARCH. OR ENG.: TMPARTNERS, PLLC
CONTRACTOR: BRASFIELD & GORRIE, LLC
DRAWN BY: JCW DATE: 06/17/2024 CHECKED BY: LKC DATE: 06/17/2024

METROMONT
20 TWO NOTCH ROAD
GREENVILLE, SOUTH CAROLINA 29605
(864) 295-0295

JOB NUMBER
20979

DRAWING NUMBER
E0.02

Proprietary Note: This document contains information which may be confidential and proprietary to Metromont Corporation and shall not be reproduced or transferred to other documents, disclosed to others or used for any purpose other than that which it was obtained without the prior written authorization from Metromont Corporation.

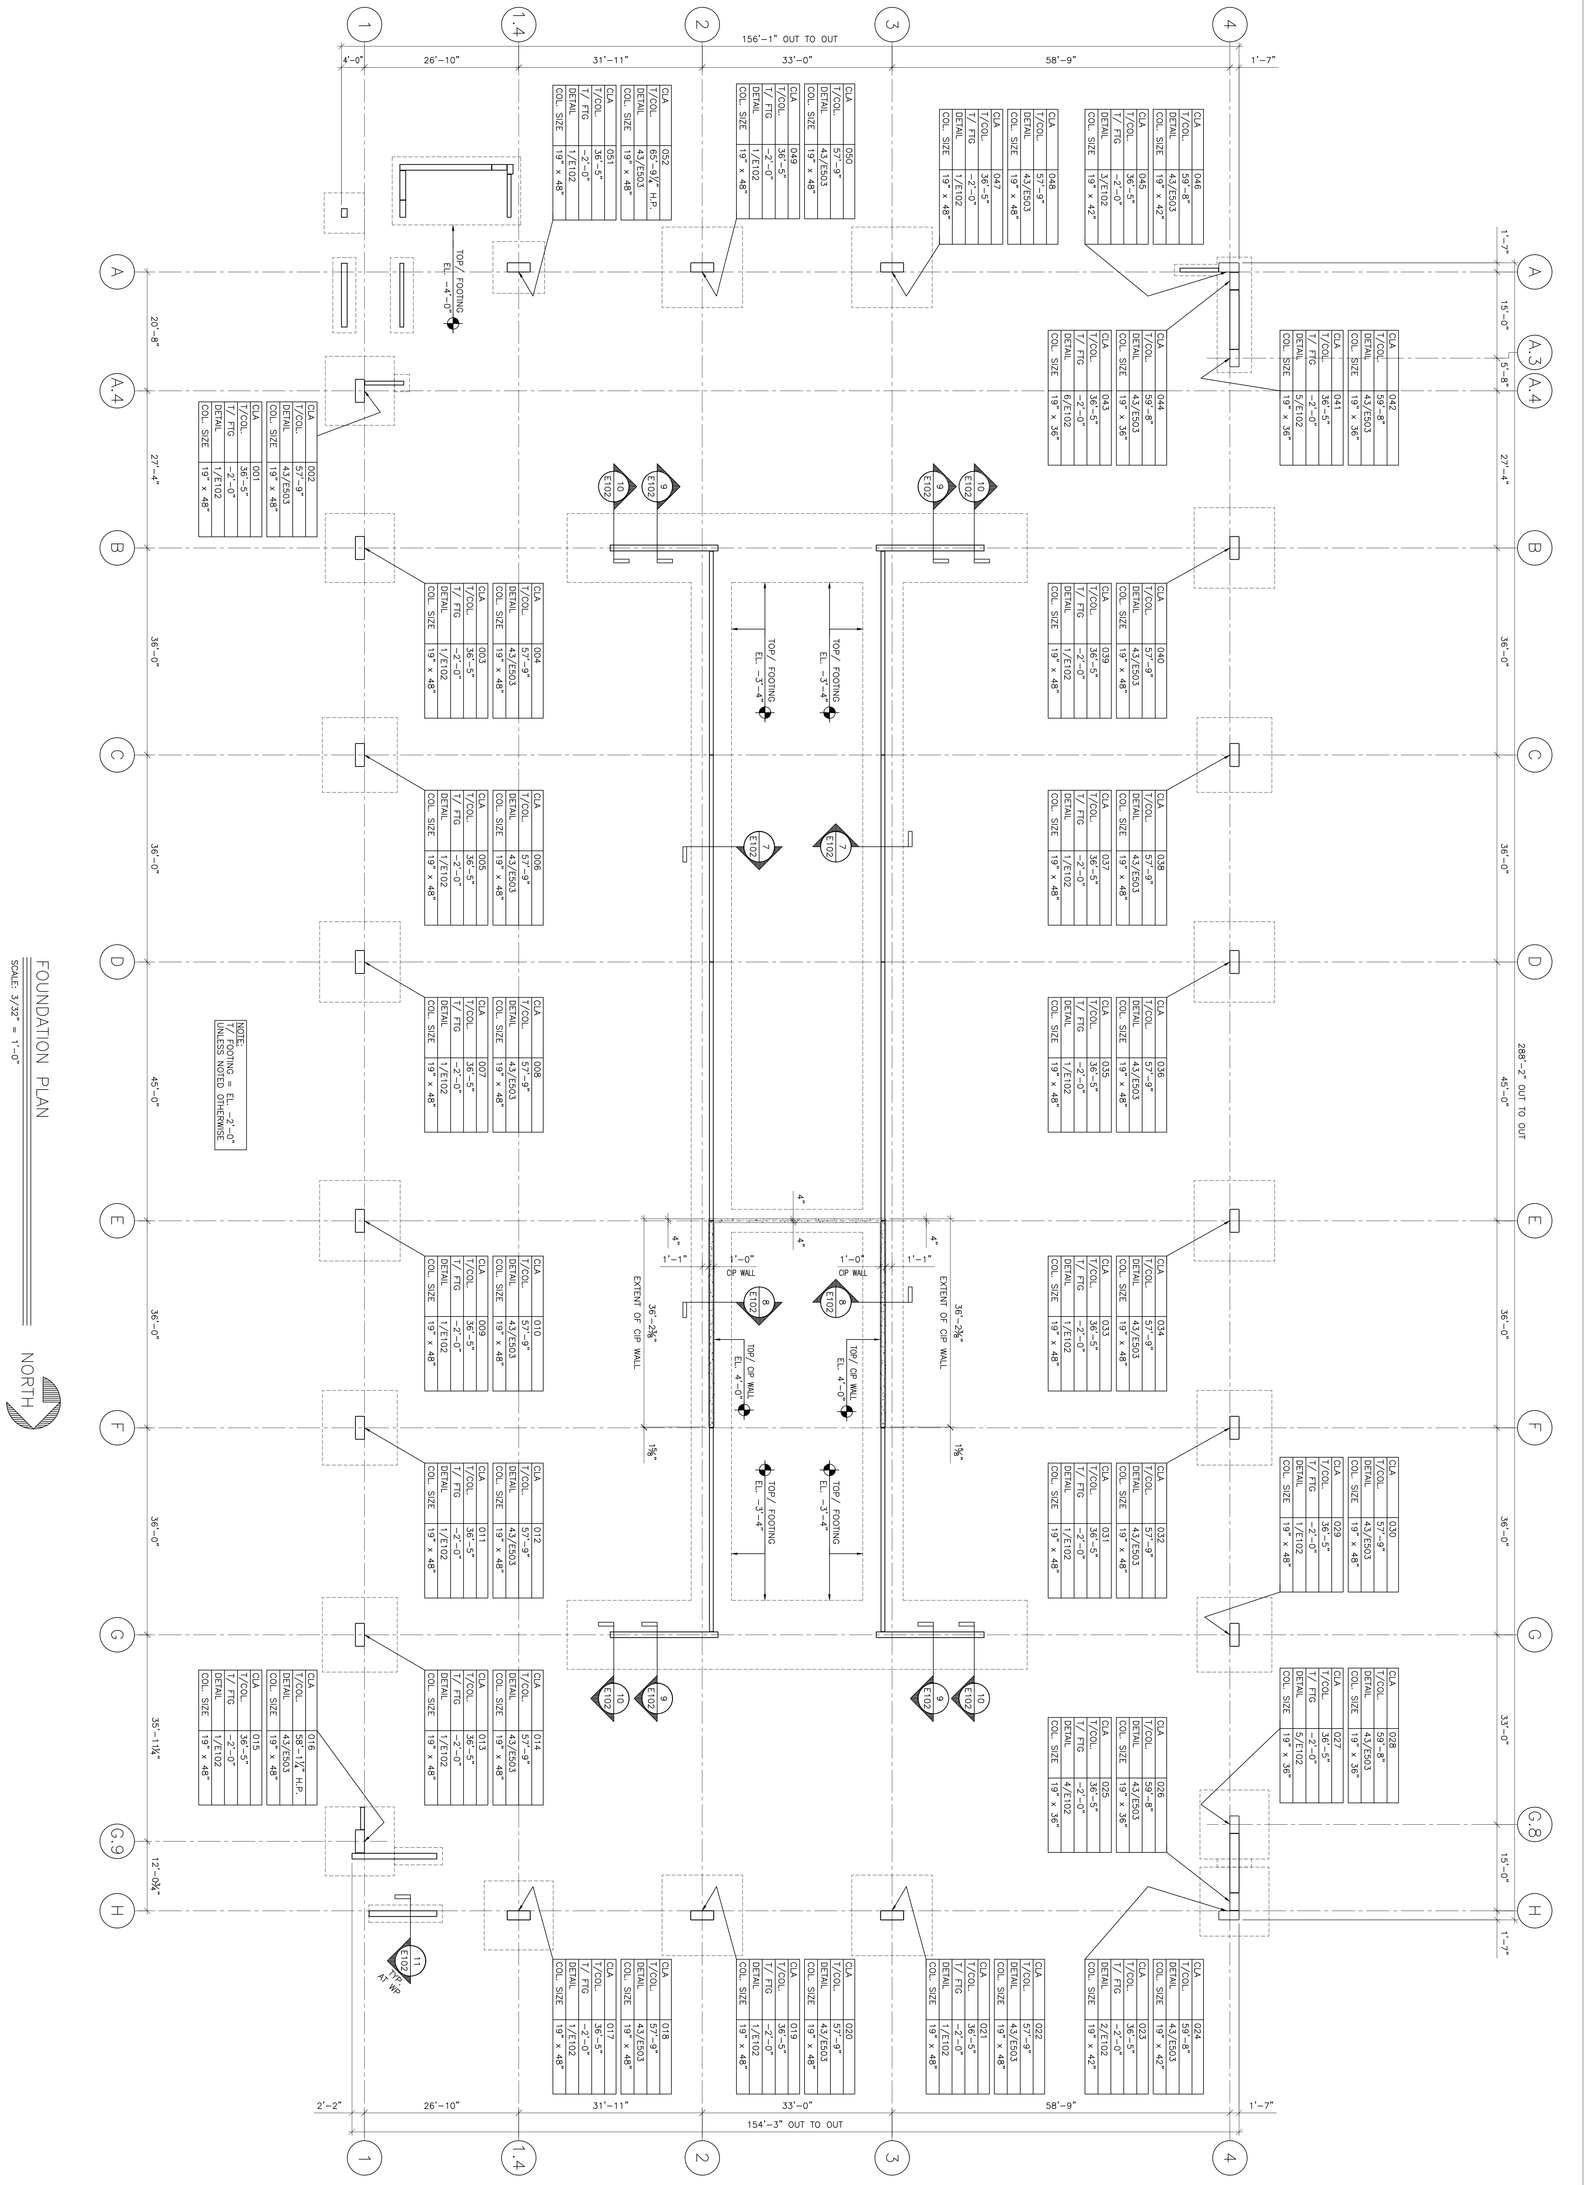

FOUNDATION PLAN

SCALE: 3/32" = 1'-0"

Proprietary Note: This document contains information which may be confidential and proprietary to Metromont Corporation and shall not be reproduced or transferred to other documents, disclosed to others or used for any purpose other than that which it was obtained without the prior written authorization from Metromont Corporation.

METROMONT™
20 TWO NOTCH ROAD
GREENVILLE, SOUTH CAROLINA 29605
(864) 295-0295

JOB NUMBER 20979
DRAWING NUMBER E1.01

DRAWING COVERS	FOUNDATION PLAN
PROJECT	HCA FLORIDA ST. LUCIE HOSPITAL PD
LOCATION	PORT ST. LUCIE, FL
ARCH. OR ENG.	TMPARTNERS, PLLC
CONTRACTOR	BRASFIELD & GORRIE, LLC

DRAWN BY: JCW DATE: 6/25/2024 CHECKED BY: LKC DATE: 6/25/2024

Preliminary
07/12/2024 11:21:49 AM

*	JCW	1	**
DATE	BY	ISSUE	DESCRIPTION

DATE	BY	ISSUE	DESCRIPTION

DEVITA
ATLANTA • GREENVILLE • RICHMOND
877.4.DEVITA • corp@devitainc.com
DeVita & Associates, Inc. Project

CONTROL NUMBERS USED: XXXX – XXXX
CONTROL NUMBERS NOT USED: XXXX – XXXX
CONTROL NUMBERS VOIDED: XXXX – XXXX
CONTROL NUMBER

Proprietary Note: This document contains information which may be confidential and proprietary to Metromont Corporation and shall not be reproduced or transferred to other documents, disclosed to others or used for any purpose other than that which it was obtained without the prior written authorization from Metromont Corporation.

DRAWING COVERS	FOUNDATION CONNECTIONS
PROJECT	HCA FLORIDA ST. LUCIE HOSPITAL PD
LOCATION	PORT ST. LUCIE, FL
ARCH. OR ENG.	TMPARTNERS, PLLC
CONTRACTOR	BRASFIELD & GORRIE, LLC
DRAWN BY: JCW	DATE: 6/25/2024 CHECKED BY: LKC DATE: 6/25/2024

METROMONT™

20 TWO NOTCH ROAD
GREENVILLE, SOUTH CAROLINA 29605
(864) 295-0295

JOB NUMBER 20979

DRAWING NUMBER E1.02

DATE	BY	ISSUE
	JCW	1
		**

Preliminary
07/12/2024 11:21:49 AM

DESCRIPTION
*
**

DATE	BY	ISSUE

DESCRIPTION

DEVITA
ATLANTA • GREENVILLE • RICHMOND
877.4.DEVITA • corp@devitainc.com
Devita & Associates, Inc. Project

1
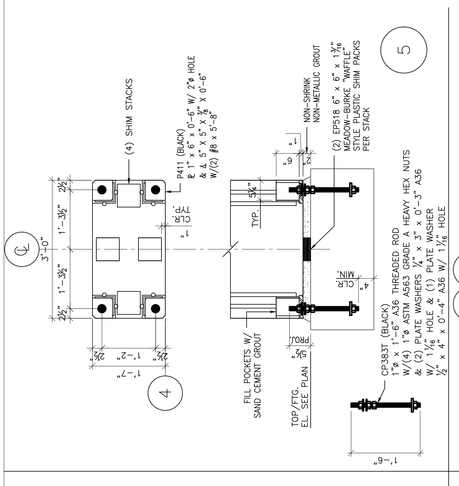

2
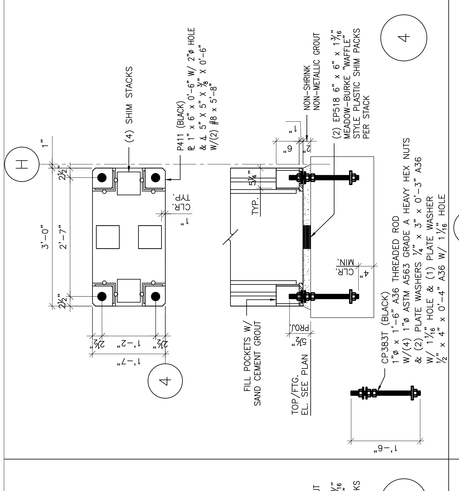

3
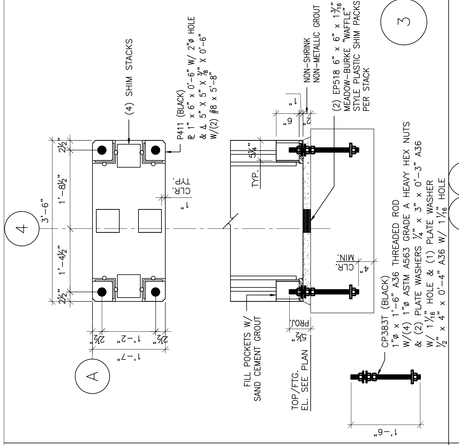

4

5

6
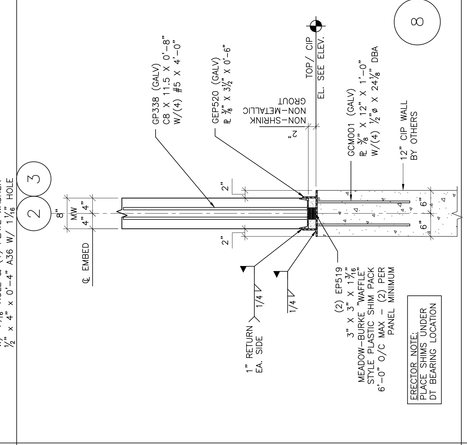

7
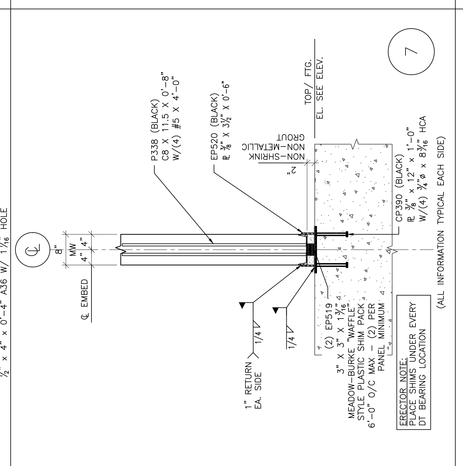

8

9
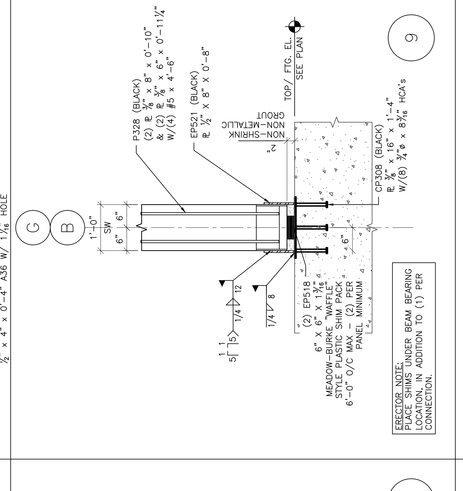

10
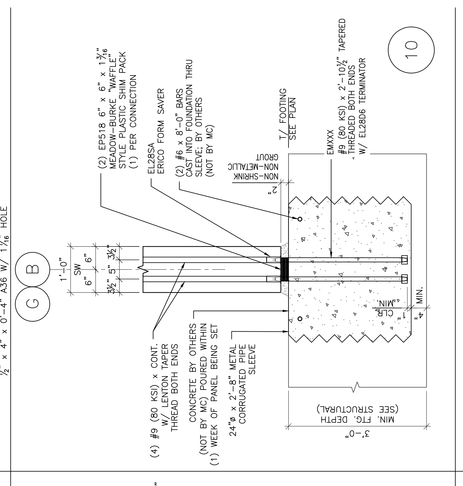

11
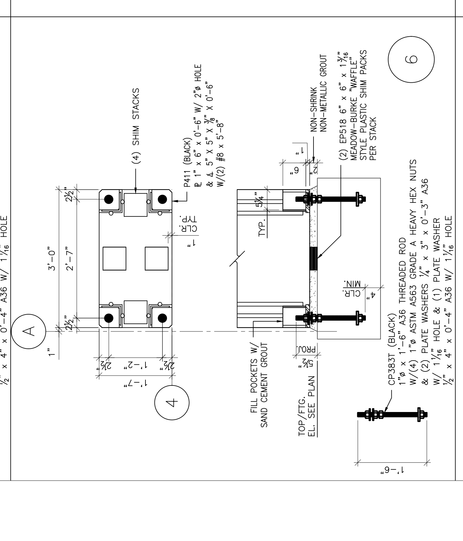

12

13

14

15

16

17

18

19

20

CONTROL NUMBERS USED:
103 – 112

CONTROL NUMBERS NOT USED:
XXX – XXX

CONTROL NUMBERS VOIDED:
XXXX – XXXX

DATUM NUMBER
CONTROL NUMBER


DESCRIPTION	ISSUE	BY	DATE

Preliminary
07/12/2024 11:21:49 AM

DESCRIPTION	ISSUE	BY	DATE
**	1	JCW	*

DRAWING COVERS	FRAMING PLAN
PROJECT	HCA FLORIDA ST. LUCIE HOSPITAL PD
LOCATION	PORT ST. LUCIE, FL
ARCH. OR ENG.	TMPARTNERS, PLLC
CONTRACTOR	BRASFIELD & GORRIE, LLC
DRAWN BY: JCW	DATE: 06/18/2024 CHECKED BY: LKC DATE: 6/18/2024

METROMONT

GREENVILLE, SOUTH CAROLINA 29605
20 TWO NOTCH ROAD
(864) 295-0295

JOB NUMBER 20979

DRAWING NUMBER E2.01

Proprietary Note: This document contains information which may be confidential and proprietary to Metromont Corporation and shall not be reproduced or transferred to other documents, disclosed to others or used for any purpose other than that which it was obtained without the prior written authorization from Metromont Corporation.

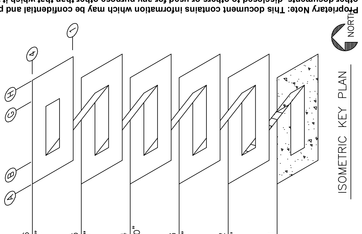

ISOMETRIC KEY PLAN

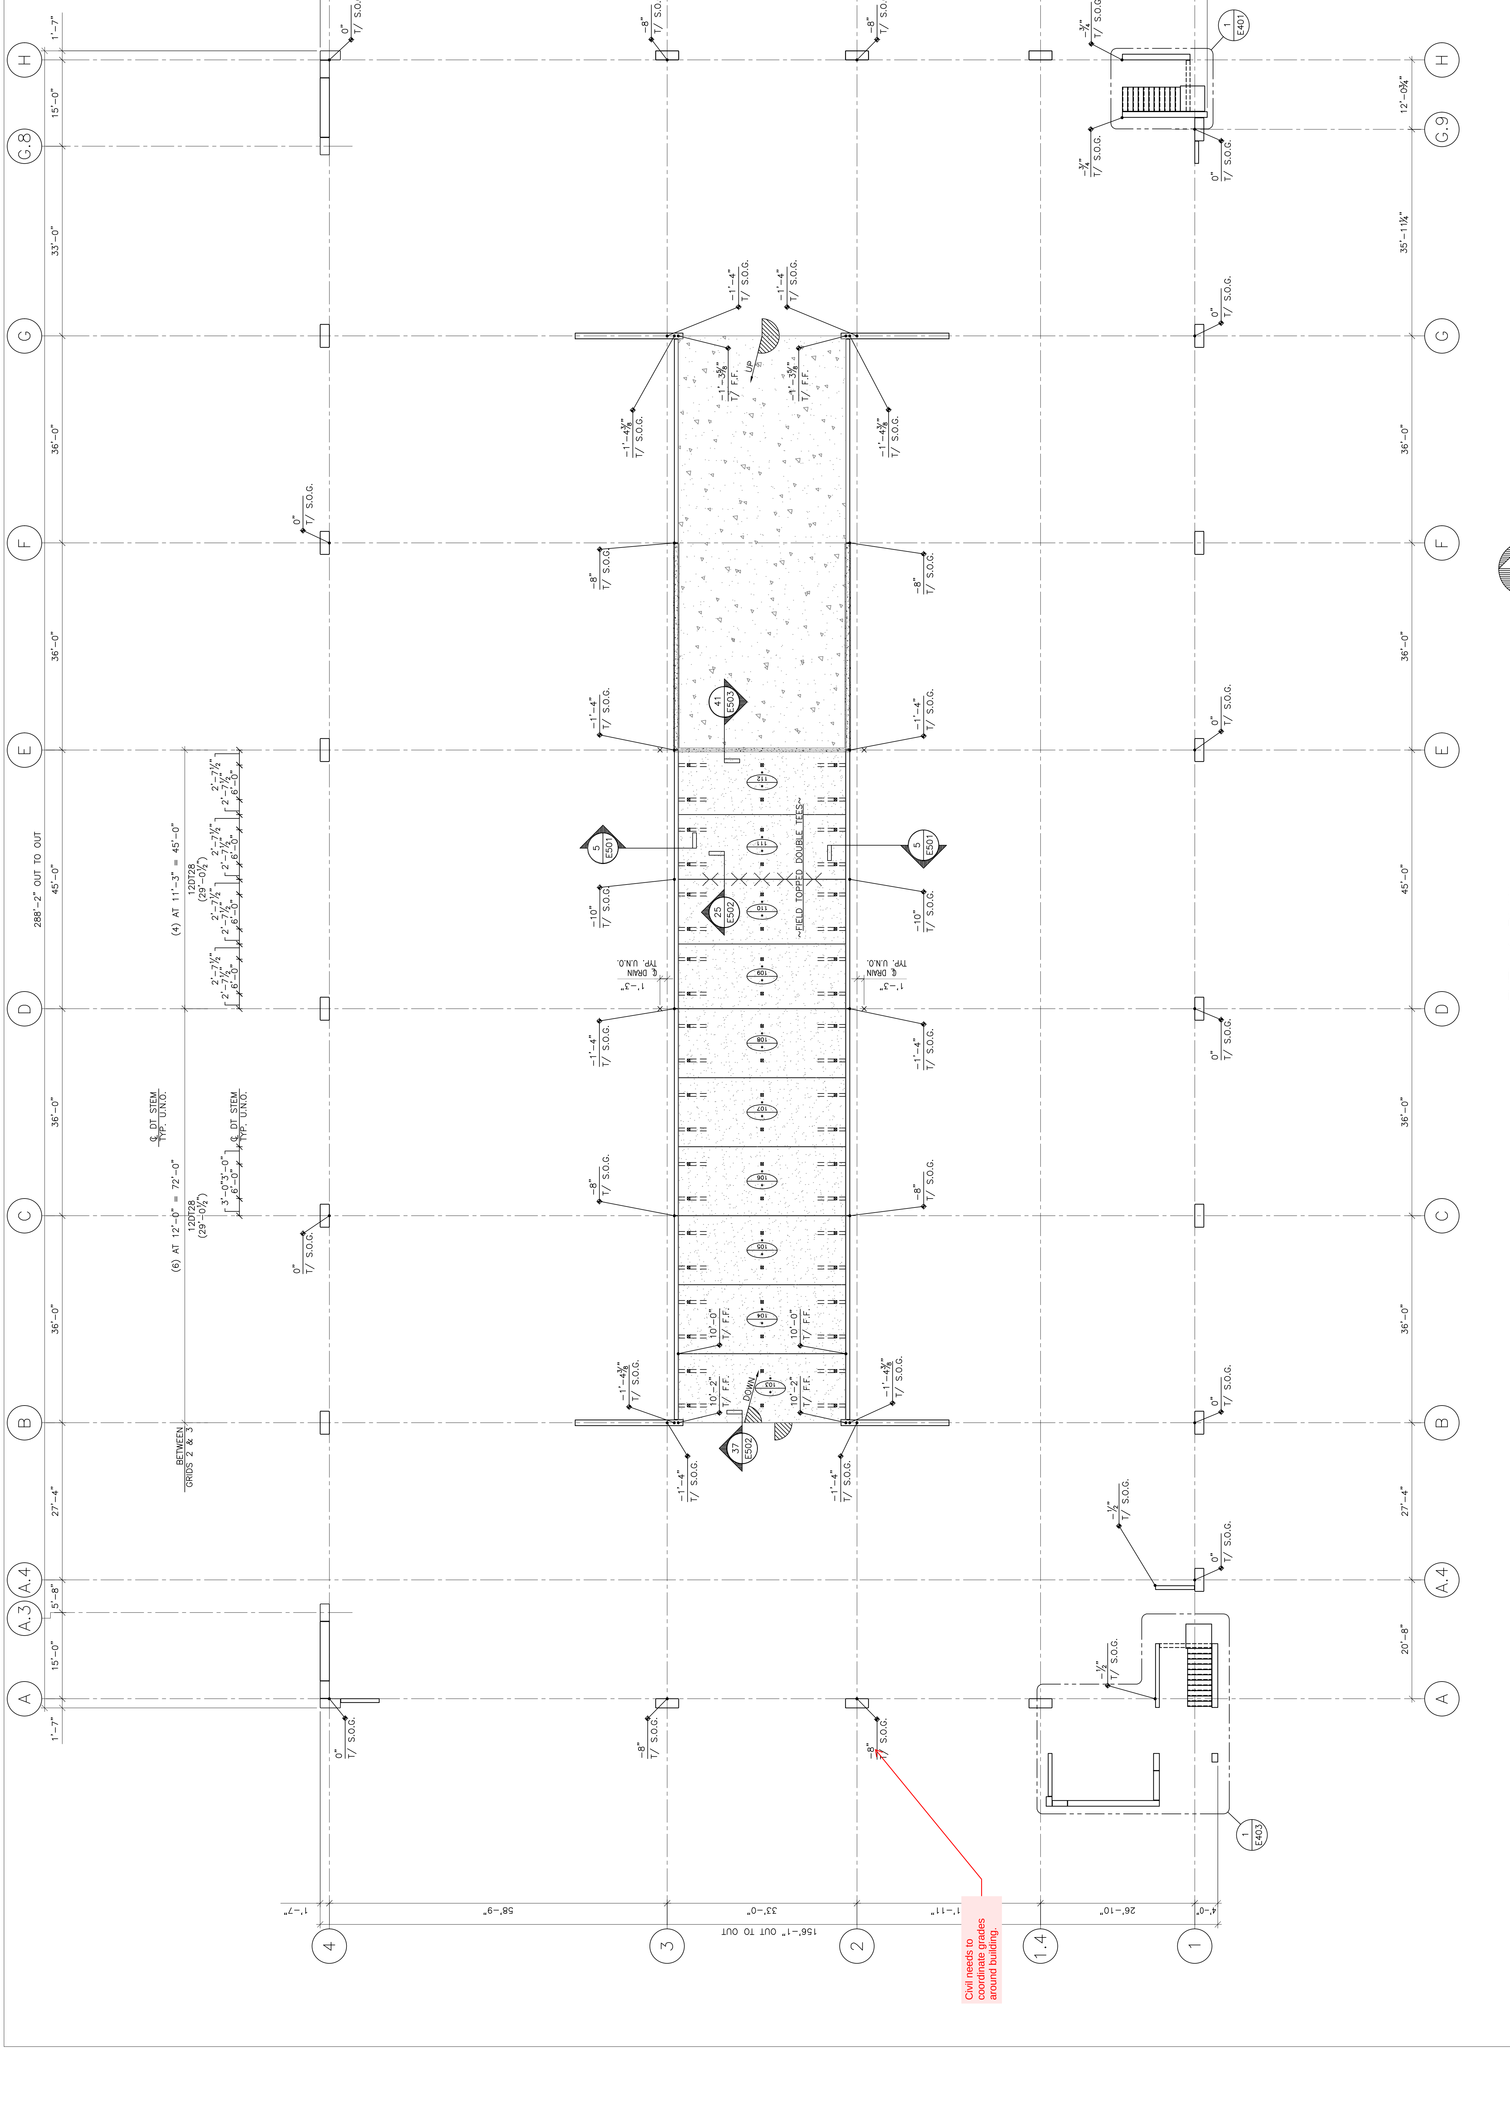

NORTH

LEVEL 1 PLAN

SCALE: 3/32" = 1'-0"

CONTROL NUMBERS USED:
053 - 062, 113 - 186
CONTROL NUMBERS NOT USED: XXXX - XXXX
CONTROL NUMBERS VOIDED:
XXXX - XXXX
DARK NUMBER
CONTROL NUMBER

DEVITA
ATLANTA • GREENVILLE • RICHMOND
877.4.DEVITA • corp@devitainc.com
Devita & Associates, Inc. Project:

DESCRIPTION	ISSUE	BY	DATE

Preliminary
07/12/2024 11:21:49 AM

DESCRIPTION	ISSUE	BY	DATE
**	1	JCW	
*			

METROMONT
20 TWO NOTCH ROAD
GREENVILLE, SOUTH CAROLINA 29605
(864) 295-0295

JOB NUMBER 20979
DRAWING NUMBER E2.02

DRAWING COVERS	FRAMING PLAN
PROJECT	HCA FLORIDA ST. LUCIE HOSPITAL PD
LOCATION	PORT ST. LUCIE, FL
ARCH. OR ENG.	TMPARTNERS, PLLC
CONTRACTOR	BRASFIELD & GORRIE, LLC

DRAWN BY: JCW DATE: 06/18/2024 CHECKED BY: LKC DATE: 6/18/2024

Proprietary Note: This document contains information which may be confidential and proprietary to Metromont Corporation and shall not be reproduced or transferred to other documents, disclosed to others or used for any purpose other than that which it was obtained without the prior written authorization from Metromont Corporation.

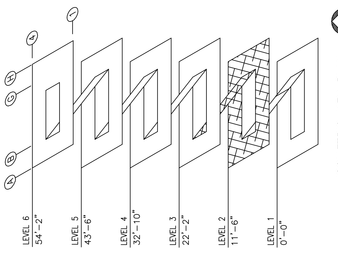

ISOMETRIC KEY PLAN

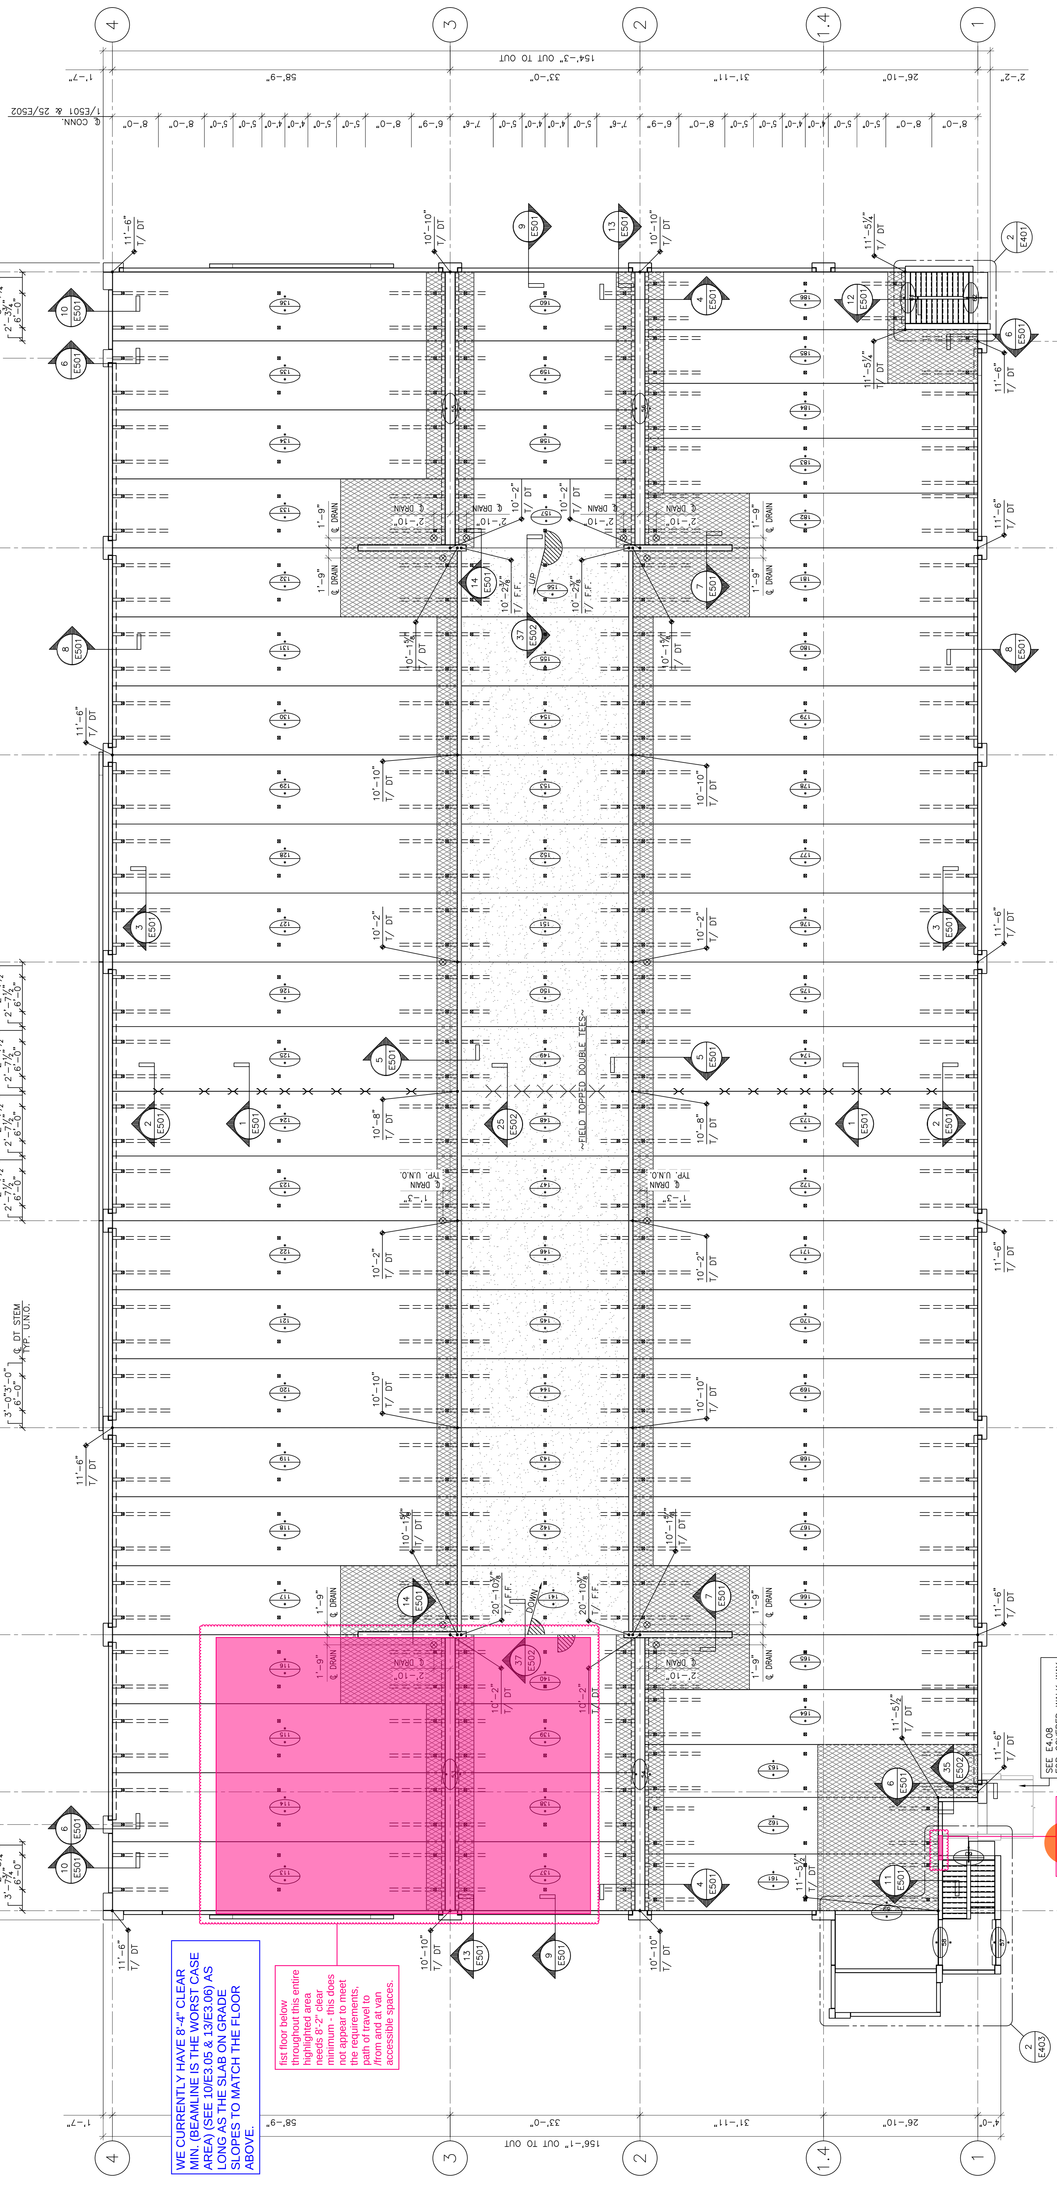

LEVEL 2 PLAN
SCALE: 3/32" = 1'-0"

Proprietary Note: This document contains information which may be confidential and proprietary to Metromont Corporation and shall not be reproduced or transferred to other documents, disclosed to others or used for any purpose other than that which it was obtained without the prior written authorization from Metromont Corporation.

CONTROL NUMBERS USED: 063 – 072, 187 – 260	
CONTROL NUMBERS NOT USED: XXXX – XXXX	
CONTROL NUMBERS VOIDED: XXXX – XXXX	
CONTROL NUMBER	MARK NUMBER

DEVITA
ATLANTA • GREENVILLE • RICHMOND
877.4.DEVITA • corp@devitainc.com
Devita & Associates, Inc. Project :

DESCRIPTION	ISSUE	BY	DATE

Preliminary
07/12/2024 11:21:50 AM

DESCRIPTION	ISSUE	BY	DATE
**	1	JCW	*

DRAWING COVERS	FRAMING PLAN
PROJECT	HCA FLORIDA ST. LUCIE HOSPITAL PD
LOCATION	PORT ST. LUCIE, FL
ARCH. OR ENG.	TMPARTNERS, PLLC
CONTRACTOR	BRASFIELD & GORRIE, LLC
DRAWN BY: JCW	DATE: 06/18/2024 CHECKED BY: LKC DATE: 6/18/2024

METROMONT
20 TWO NOTCH ROAD
GREENVILLE, SOUTH CAROLINA 29605
(864) 295-0295

JOB NUMBER 20979
DRAWING NUMBER E2.03

ISOMETRIC KEY PLAN

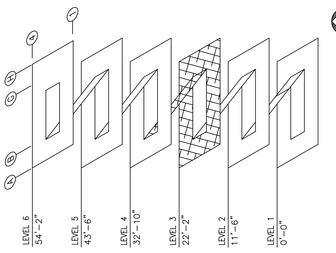

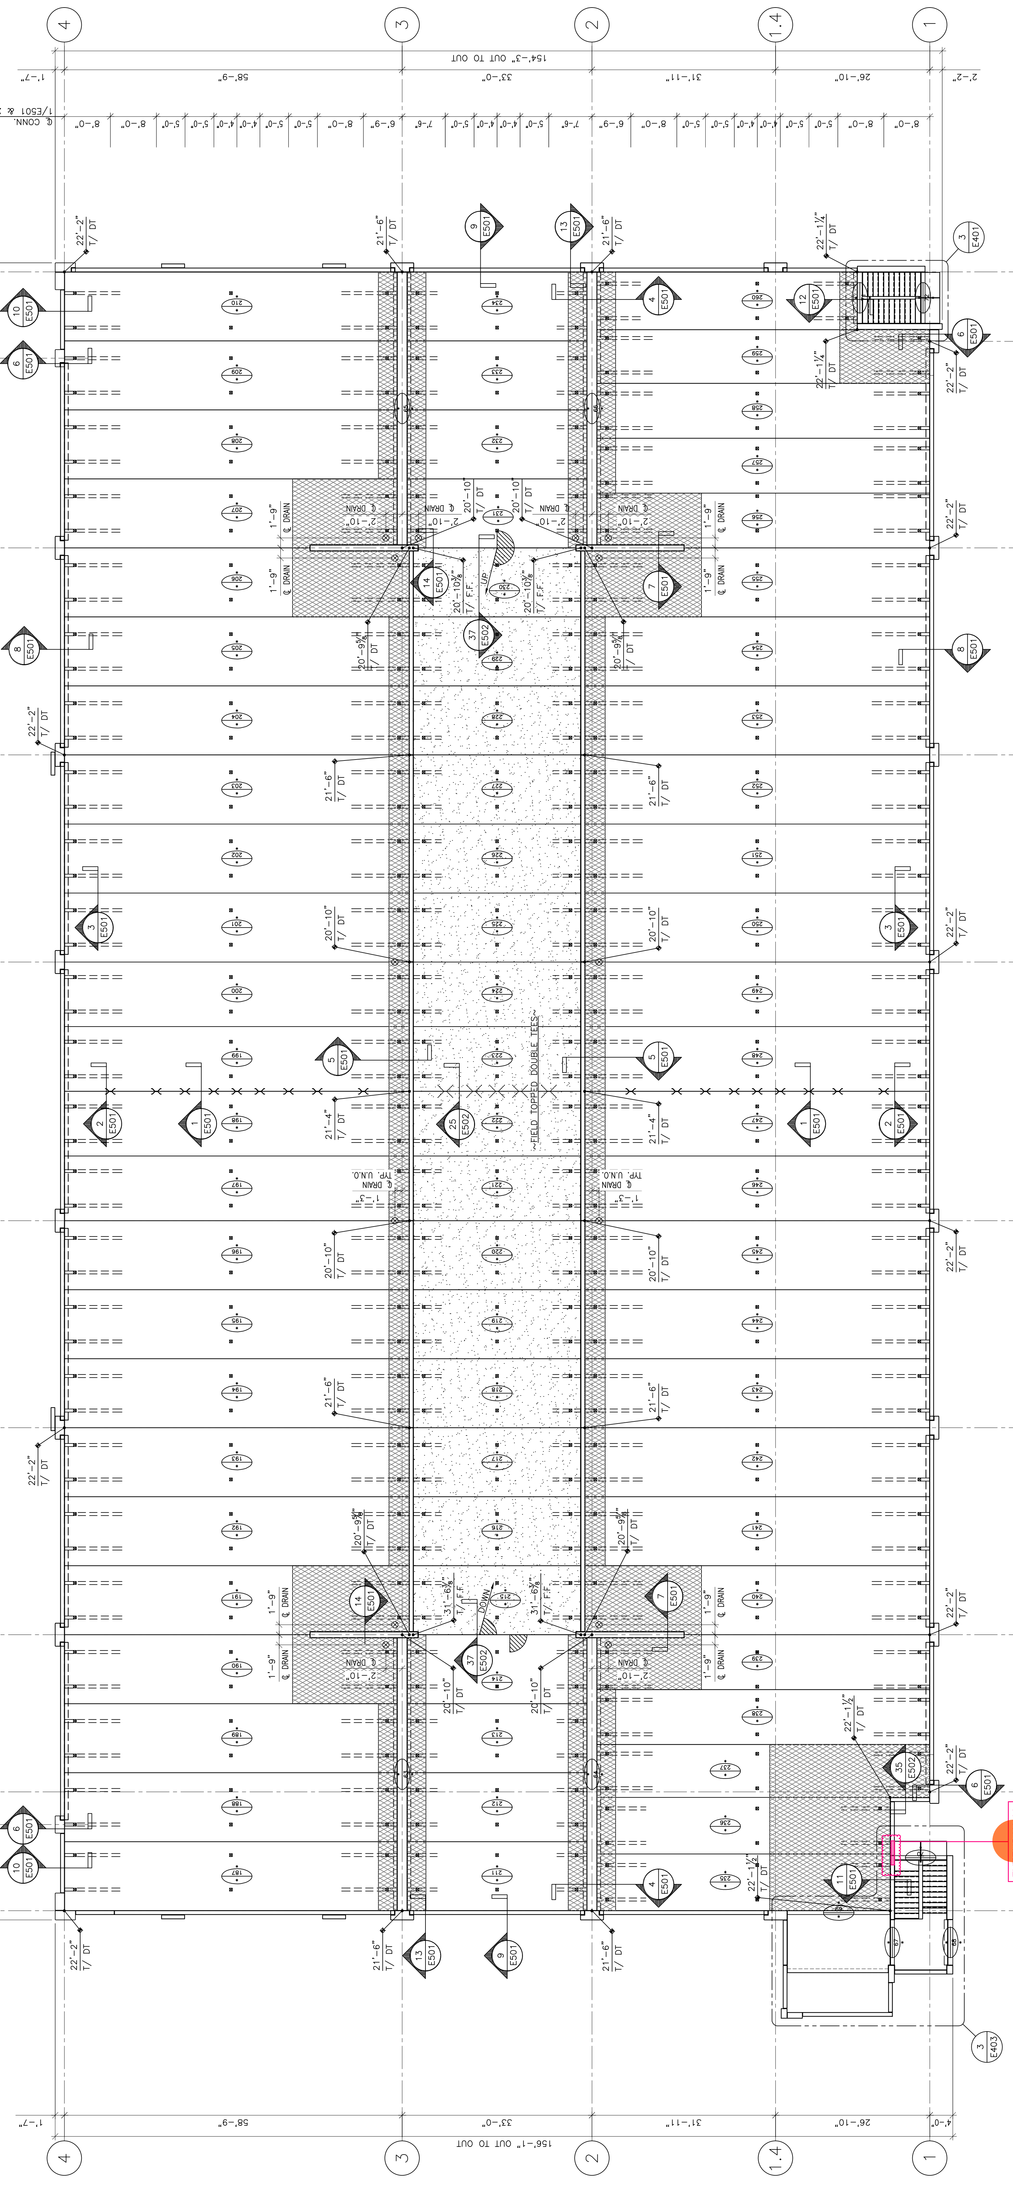

LEVEL 3 PLAN
SCALE: 3/32" = 1'-0"

CONTROL NUMBERS USED:
073 - 082, 261 - 334
CONTROL NUMBERS NOT USED: XXXX - XXXX
CONTROL NUMBERS VOIDED: XXXX - XXXX

DATA NUMBER
CONTROL NUMBER

DEVITA
ATLANTA • GREENVILLE • RICHMOND
877.4.DEVITA • corp@devitainc.com
Devita & Associates, Inc. Project :

DESCRIPTION	ISSUE	BY	DATE

Preliminary
07/12/2024 11:21:50 AM

DESCRIPTION	ISSUE	BY	DATE
**	1	JCW	
*			

METROMONT
GREENVILLE, SOUTH CAROLINA 29605
20 TWO NOTCH ROAD
(864) 295-0295

JOB NUMBER 20979
DRAWING NUMBER E2.04

DRAWING COVERS	FRAMING PLAN
PROJECT	HCA FLORIDA ST. LUCIE HOSPITAL PD
LOCATION	PORT ST. LUCIE, FL
ARCH. OR ENG.	TMPARTNERS, PLLC
CONTRACTOR	BRASFIELD & GORRIE, LLC

DRAWN BY: JCW DATE: 06/18/2024 CHECKED BY: LKC DATE: 6/18/2024

Proprietary Note: This document contains information which may be confidential and proprietary to Metromont Corporation and shall not be reproduced or transferred to other documents, disclosed to others or used for any purpose other than that which it was obtained without the prior written authorization from Metromont Corporation.

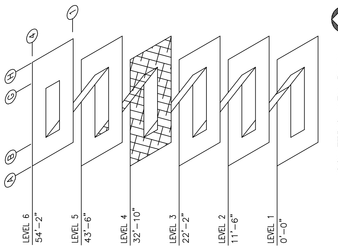

ISOMETRIC KEY PLAN

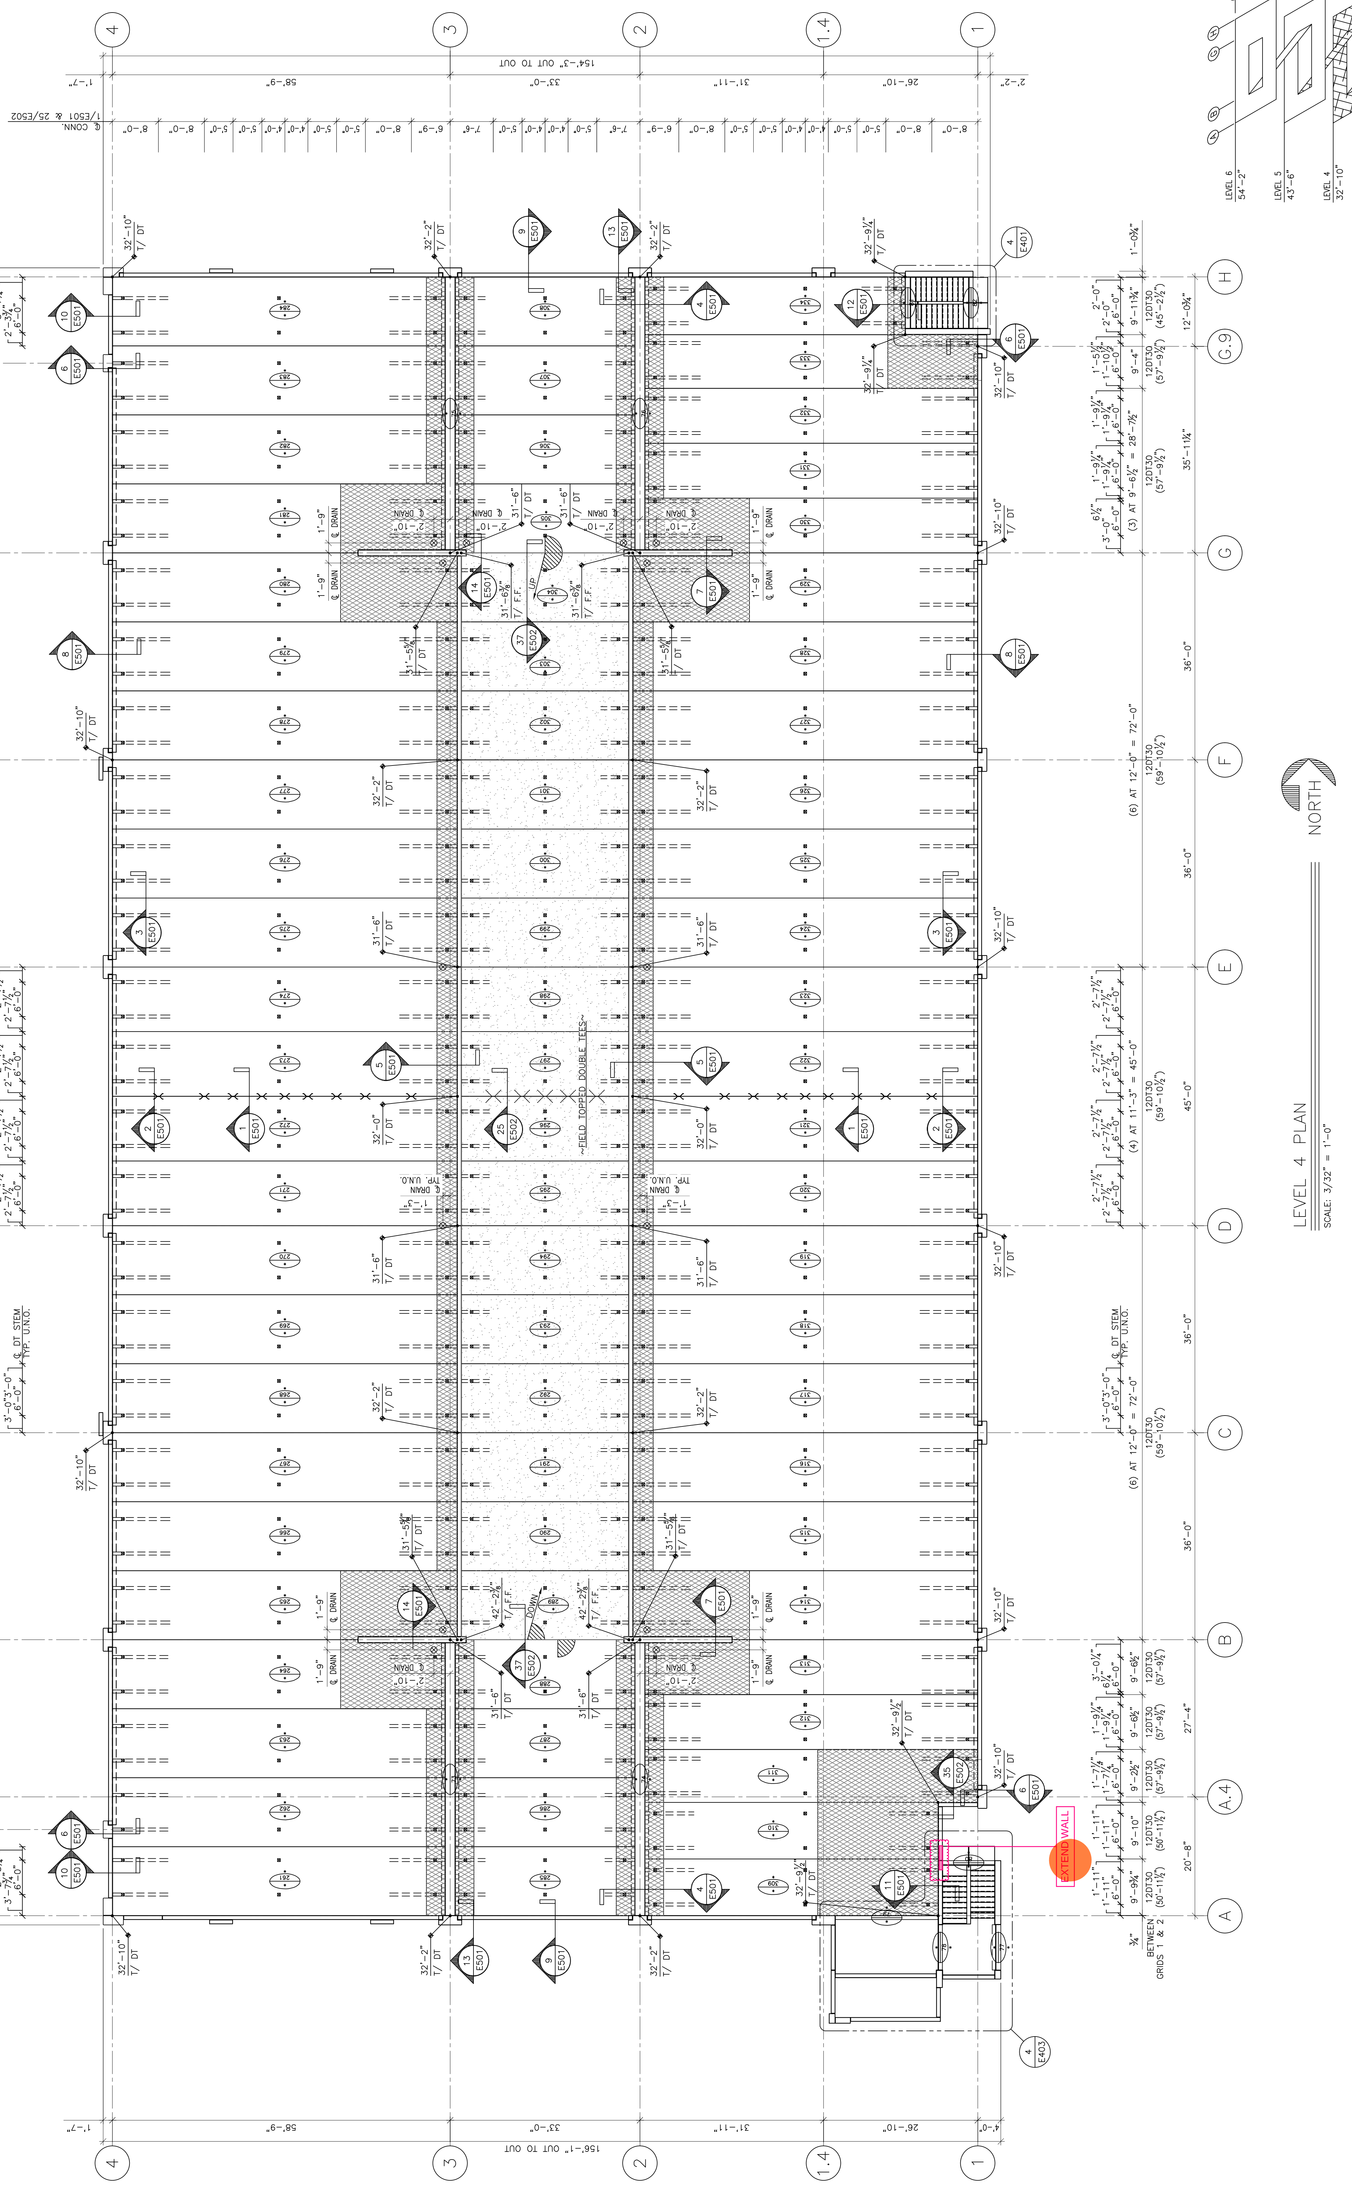

LEVEL 4 PLAN
SCALE: 3/32" = 1'-0"

LEVEL 5 PLAN

SCALE: 3/32" = 1'-0"

NORTH

EXTEND WALL

156'-1" OUT TO OUT

154'-3" OUT TO OUT

~FIELD TOPPED DOUBLE TEES~

ISOMETRIC KEY PLAN

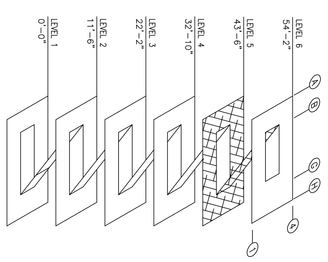

NORTH

Proprietary Note: This document contains information which may be confidential and proprietary to Metromont Corporation and shall not be reproduced or transferred to other documents, disclosed to others or used for any purpose other than that which it was obtained without the prior written authorization from Metromont Corporation.

METROMONT™
20 TWO NOTCH ROAD
GREENVILLE, SOUTH CAROLINA 29605
(864) 295-0295

JOB NUMBER 20979
DRAWING NUMBER E2.05

DRAWING COVERS	FRAMING PLAN
PROJECT	HCA FLORIDA ST. LUCIE HOSPITAL PD
LOCATION	PORT ST. LUCIE, FL
ARCH. OR ENG.	TMPARTNERS, PLLC
CONTRACTOR	BRASFIELD & GORRIE, LLC

DRAWN BY: JCW DATE: 06/18/2024 CHECKED BY: LKC DATE: 6/18/2024

Preliminary
07/12/2024 11:21:50 AM

*	BY	ISSUE	**
DATE	JCW	1	DESCRIPTION

DATE	BY	ISSUE	DESCRIPTION

DEVITA
ATLANTA • GREENVILLE • RICHMOND
877.4.DEVITA • corp@devitainc.com
DeVita & Associates, Inc. Project :

CONTROL NUMBERS USED: XXXX – XXXX
CONTROL NUMBERS NOT USED: XXXX – XXXX
CONTROL NUMBERS VOIDED: XXXX – XXXX
CONTROL NUMBER

Proprietary Note: This document contains information which may be confidential and proprietary to Metromont Corporation and shall not be reproduced or transferred to other documents, disclosed to others or used for any purpose other than that which it was obtained without the prior written authorization from Metromont Corporation.

DRAWING COVERS	FRAMING PLAN
PROJECT	HCA FLORIDA ST. LUCIE HOSPITAL PD
LOCATION	PORT ST. LUCIE, FL
ARCH. OR ENG.	TMPARTNERS, PLLC
CONTRACTOR	BRASFIELD & GORRIE, LLC
DRAWN BY: JCW	DATE: 06/18/2024 CHECKED BY: LKC DATE: 6/18/2024

METROMONT
20 TWO NOTCH ROAD
GREENVILLE, SOUTH CAROLINA 29605
(864) 295-0295

JOB NUMBER 20979
DRAWING NUMBER E2.06

DATE	BY	ISSUE	DESCRIPTION
*	JCW	1	** Preliminary 07/12/2024 11:21:50 AM

DATE	BY	ISSUE	DESCRIPTION

CONTROL NUMBERS USED: 093 – 102, 409 – 467
CONTROL NUMBERS NOT USED: XXXX – XXXX
CONTROL NUMBERS VOIDED: XXXX – XXXX
DARK NUMBER / CONTROL NUMBER

DEVITA
ATLANTA • GREENVILLE • RICHMOND
877.4.DEVITA • corp@devitainc.com
Devita & Associates, Inc. Project:

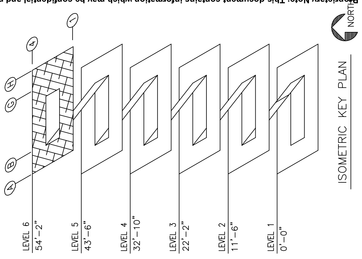

ISOMETRIC KEY PLAN

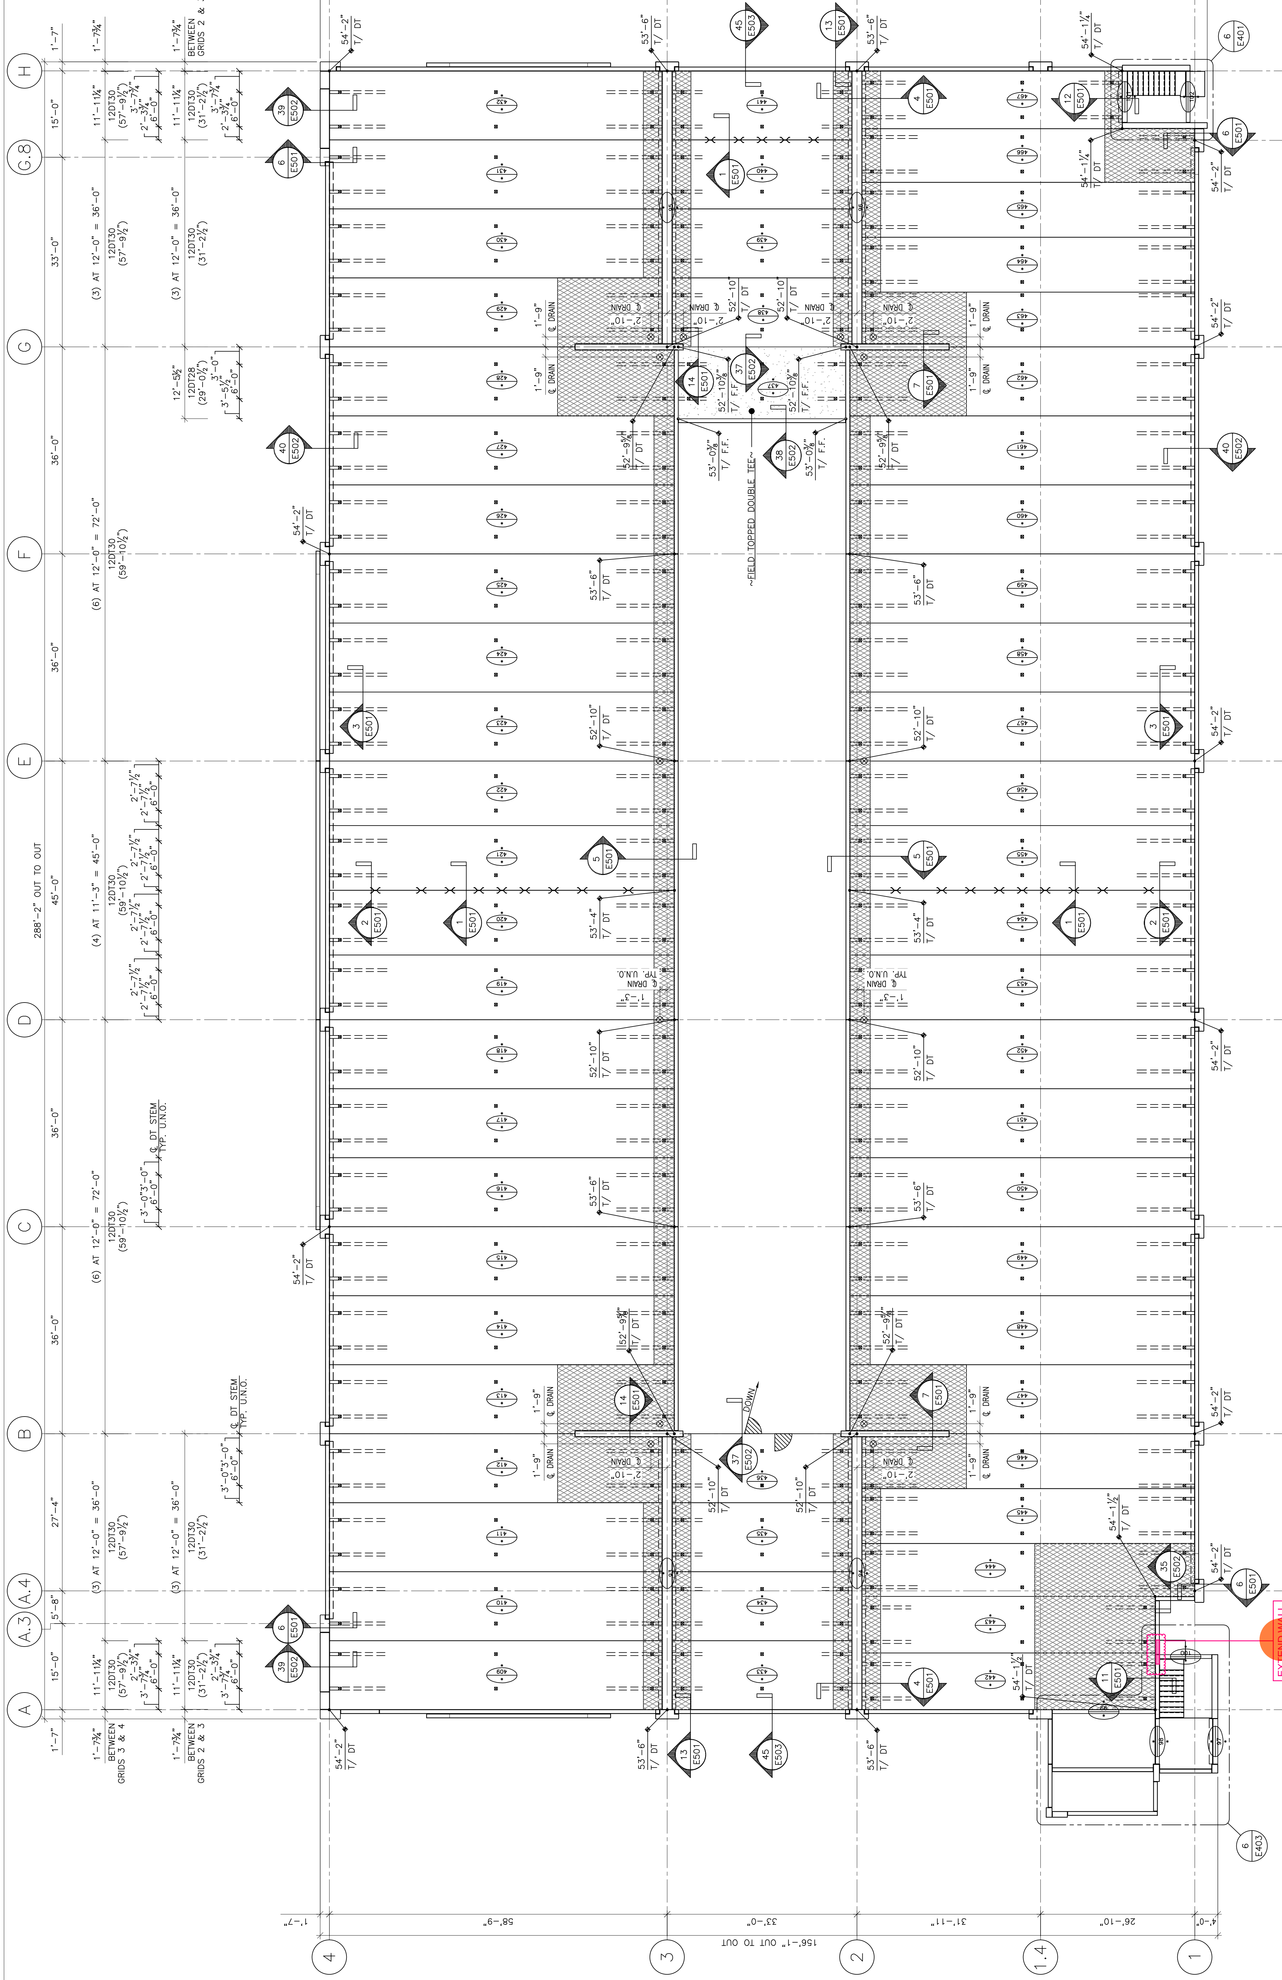

LEVEL 6 PLAN
SCALE: 3/32" = 1'-0"

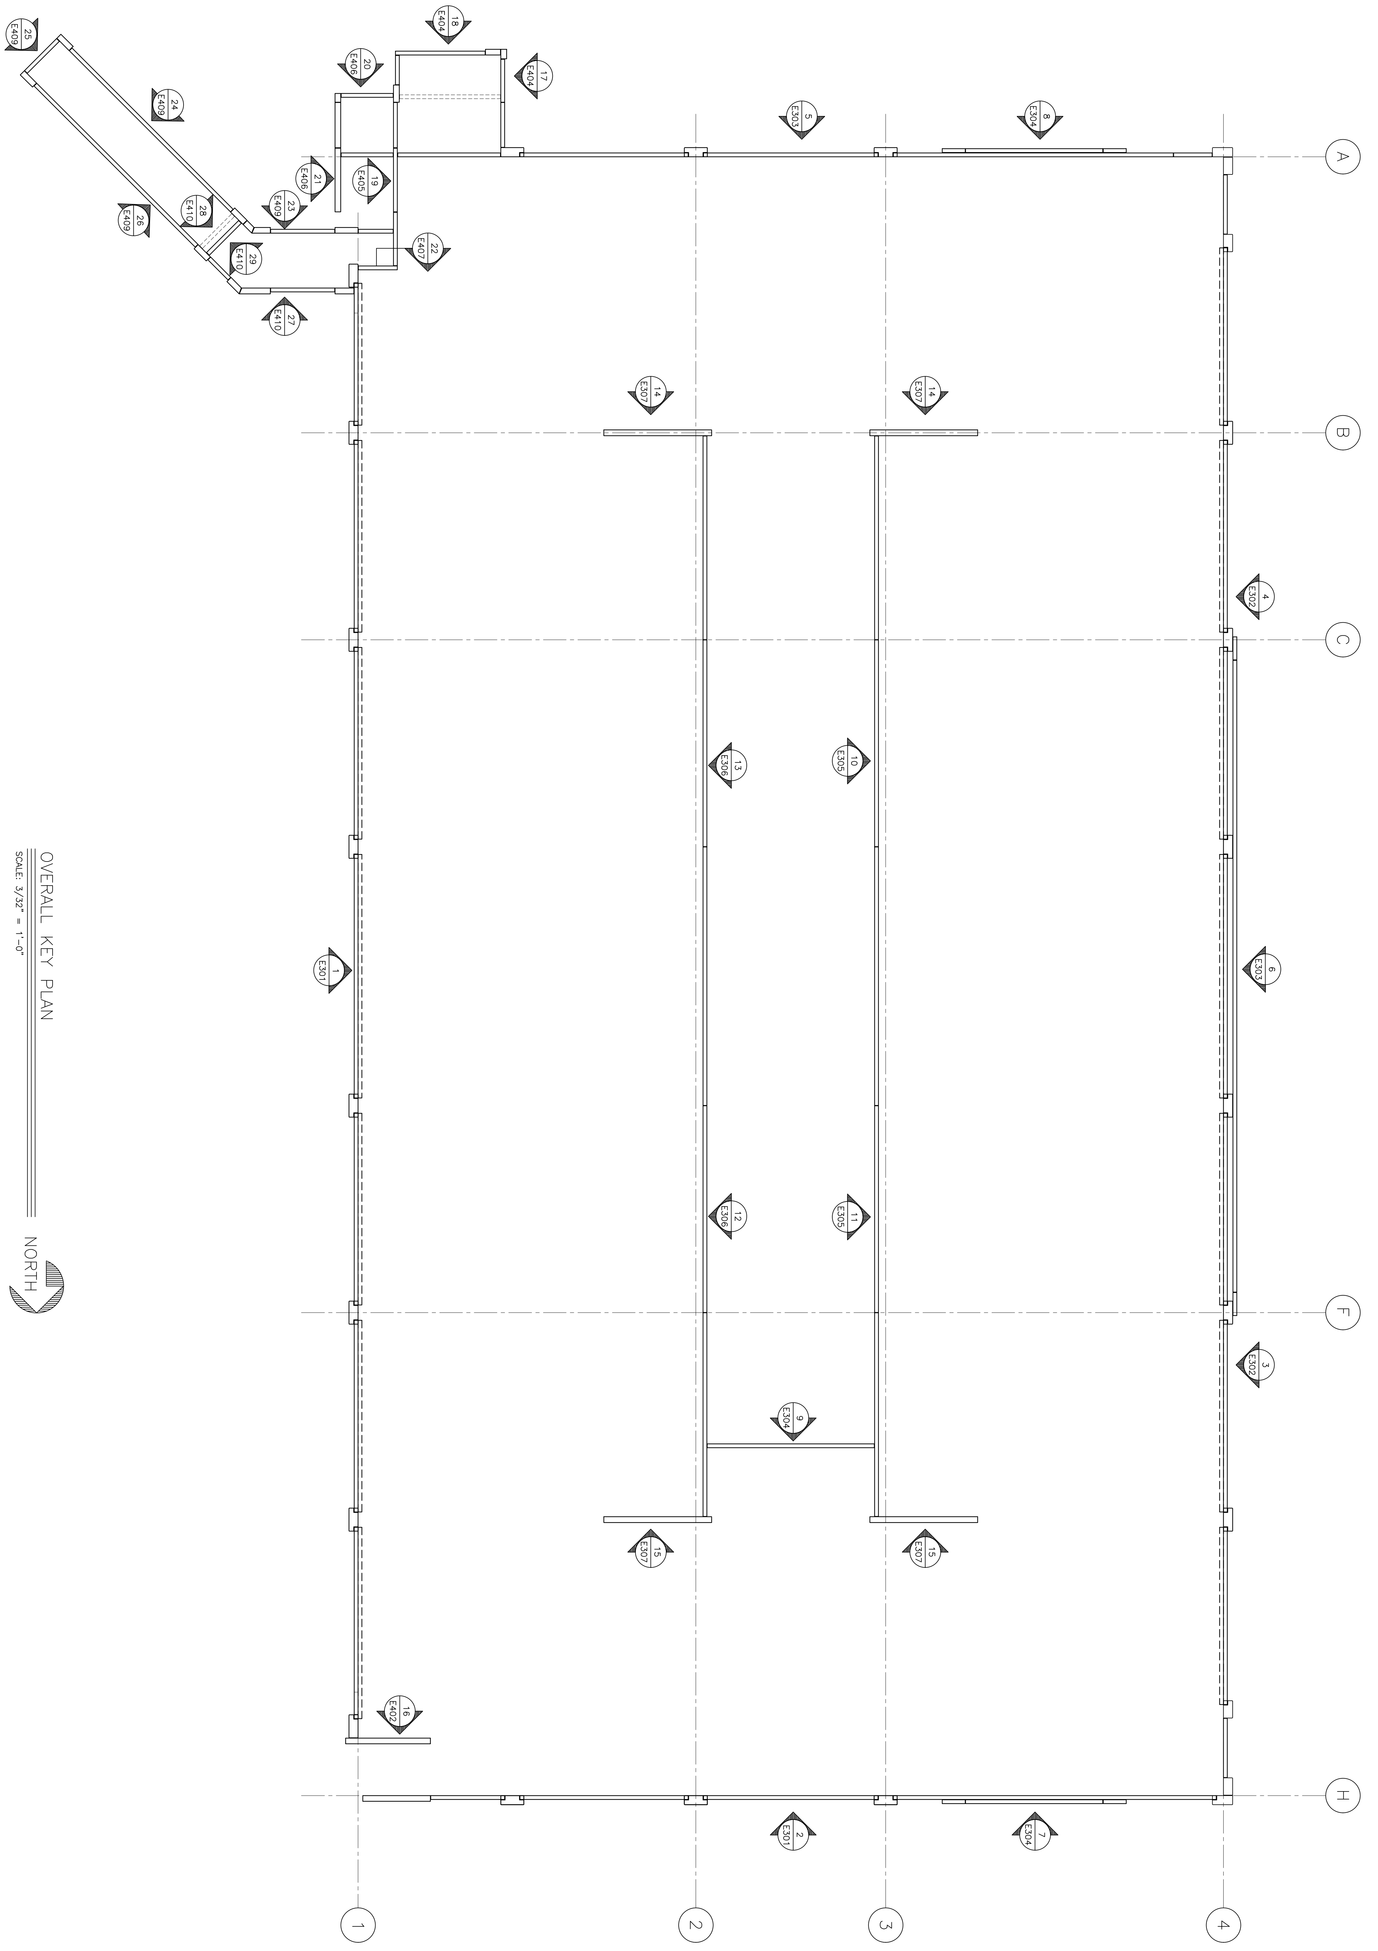

OVERALL KEY PLAN

SCALE: 3/32" = 1'-0"

Proprietary Note: This document contains information which may be confidential and proprietary to Metromont Corporation and shall not be reproduced or transferred to other documents, disclosed to others or used for any purpose other than that which it was obtained without the prior written authorization from Metromont Corporation.

DRAWING NUMBER E3.00

JOB NUMBER 20979

METROMONT™
20 TWO NOTCH ROAD
GREENVILLE, SOUTH CAROLINA 29605
(864) 295-0295

DRAWING COVERS	OVERALL KEY PLAN
PROJECT	HCA FLORIDA ST. LUCIE HOSPITAL PD
LOCATION	PORT ST. LUCIE, FL
ARCH. OR ENG.	TMPARTNERS, PLLC
CONTRACTOR	BRASFIELD & GORRIE, LLC
DRAWN BY: JCW	DATE: 06/21/2024 CHECKED BY: LKC DATE: 06/21/2024

Preliminary
07/12/2024 11:21:50 AM

	DATE	BY	ISSUE	DESCRIPTION
*		JCW	1	**

DATE	BY	ISSUE	DESCRIPTION

DEVITA
ATLANTA • GREENVILLE • RICHMOND
877.4.DEVITA • corp@devitainc.com
DeVita & Associates, Inc. Project :

Proprietary Note: This document contains information which may be confidential and proprietary to Metromont Corporation and shall not be reproduced or transferred to other documents, disclosed to others or used for any purpose other than that which it was obtained without the prior written authorization from Metromont Corporation.

DRAWING COVERS	EXTERIOR ELEVATION
PROJECT	HCA FLORIDA ST. LUCIE HOSPITAL PD
LOCATION	PORT ST. LUCIE, FL
ARCH. OR ENG.	TMPARTNERS, PLLC
CONTRACTOR	BRASFIELD & GORRIE, LLC
DRAWN BY: JCW	DATE: 06/21/2024 CHECKED BY: LKC DATE: 06/21/2024

METROMONT
20 TWO NOTCH ROAD
GREENVILLE, SOUTH CAROLINA 29605
(864) 295-0295

JOB NUMBER 20979
DRAWING NUMBER E3.01

DATE	BY	ISSUE	DESCRIPTION
*	JCW	1	07/12/2024 11:21:50 AM
		**	

Preliminary

DATE	BY	ISSUE	DESCRIPTION

DEVITA
ATLANTA • GREENVILLE • RICHMOND
877.4.DEVITA • corp@devitainc.com
Devita & Associates, Inc. Project:

CONTROL NUMBERS USED: 468 – 502, 538 – 557, 574 – 589
CONTROL NUMBERS NOT USED: XXXX – XXXX
CONTROL NUMBERS VOIDED: XXXX – XXXX
MARK NUMBER
CONTROL NUMBER

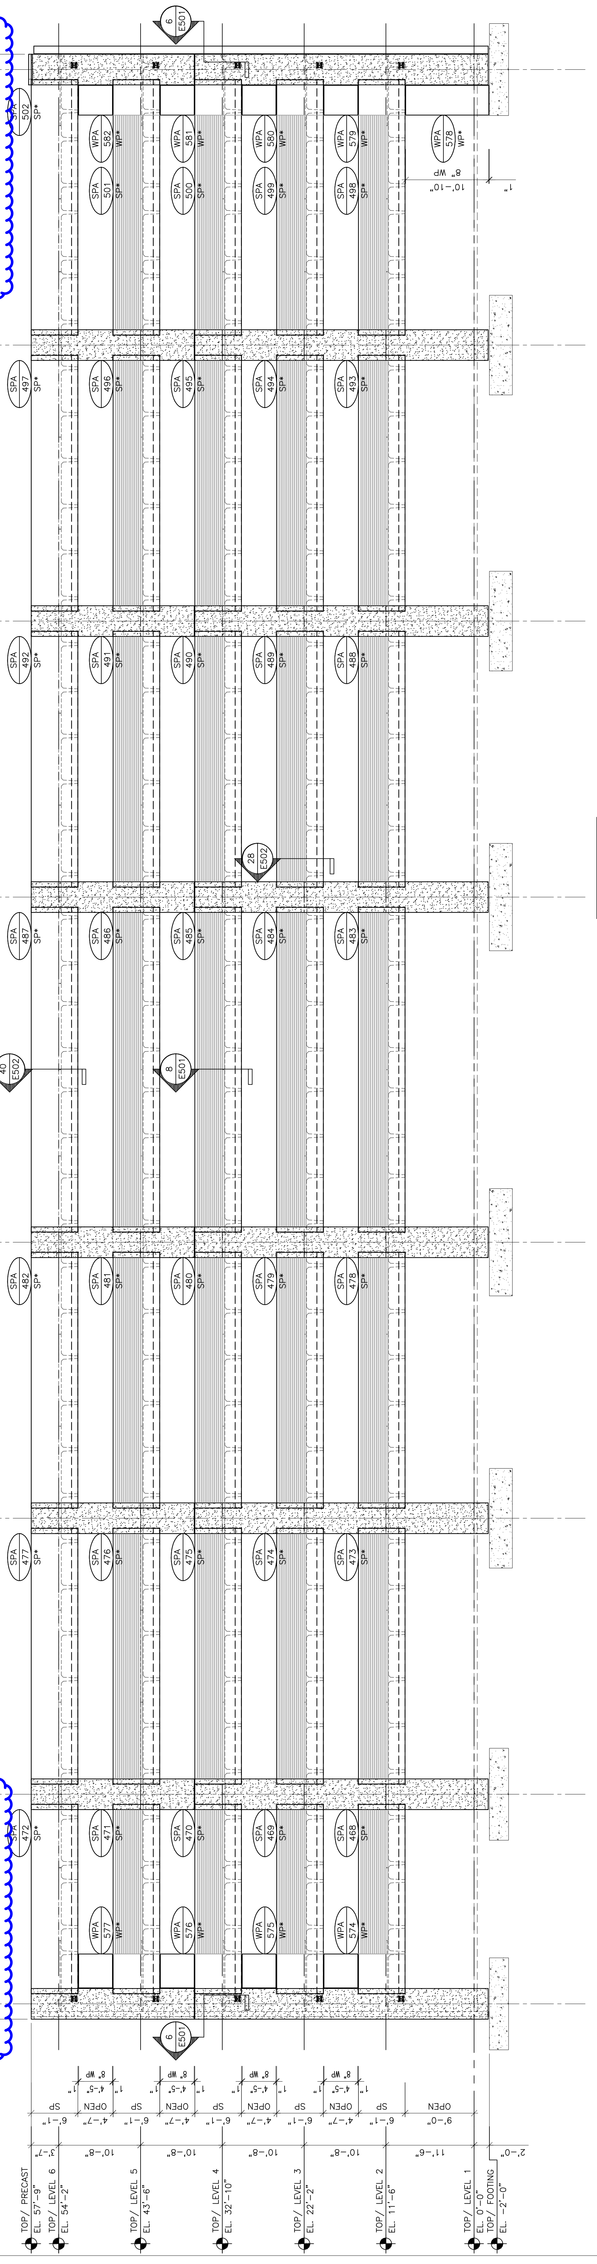

MATCHLINE – SEE 4/E3.02

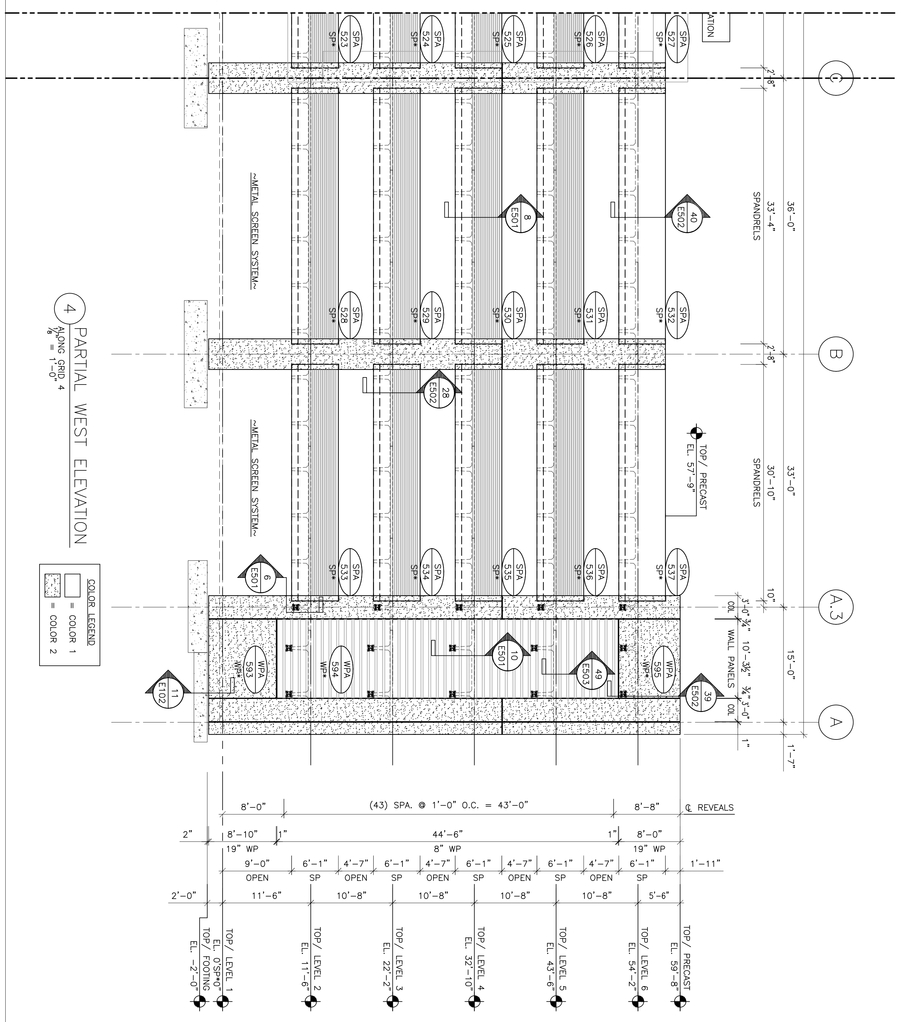

3 PARTIAL WEST ELEVATION
ALONG GRID 4
3/16" = 1'-0"

4 PARTIAL WEST ELEVATION
ALONG GRID 4
3/16" = 1'-0"

MATCHLINE – SEE 4/E3.02

Proprietary Note: This document contains information which may be confidential and proprietary to Metromont Corporation and shall not be reproduced or transferred to other documents, disclosed to others or used for any purpose other than that which it was obtained without the prior written authorization from Metromont Corporation.

METROMONT
20 TWO NOTCH ROAD
GREENVILLE, SOUTH CAROLINA 29605
(864) 295-0295

JOB NUMBER	20979
DRAWING NUMBER	E3.02
DRAWING COVERS	EXTERIOR ELEVATION
PROJECT	HCA FLORIDA ST. LUCIE HOSPITAL PD
LOCATION	PORT ST. LUCIE, FL
ARCH. OR ENG.	TMPARTNERS, PLLC
CONTRACTOR	BRASFIELD & GORRIE, LLC
DRAWN BY:	JCW
DATE:	06/21/2024
CHECKED BY:	LKC
DATE:	06/21/2024

Preliminary
07/12/2024 11:21:50 AM

*	JCW	1	**
DATE	BY	ISSUE	DESCRIPTION

DATE	BY	ISSUE	DESCRIPTION

DEVITA
ATLANTA • GREENVILLE • RICHMOND
877.4.DEVITA • corp@devitainc.com
Devita & Associates, Inc. Project

CONTROL NUMBERS USED: XXXX – XXXX
CONTROL NUMBERS NOT USED: XXXX – XXXX
CONTROL NUMBERS VOIDED: XXXX – XXXX

Proprietary Note: This document contains information which may be confidential and proprietary to Metromont Corporation and shall not be reproduced or transferred to other documents, disclosed to others or used for any purpose other than that which it was obtained without the prior written authorization from Metromont Corporation.

METROMONT
20 TWO NOTCH ROAD
GREENVILLE, SOUTH CAROLINA 29605
(864) 295-0295

JOB NUMBER 20979
DRAWING NUMBER E3.03

DRAWING COVERS	EXTERIOR ELEVATION
PROJECT	HCA FLORIDA ST. LUCIE HOSPITAL PD
LOCATION	PORT ST. LUCIE, FL
ARCH. OR ENG.	TMPARTNERS, PLLC
CONTRACTOR	BRASFIELD & GORRIE, LLC

DRAWN BY: JCW DATE: 06/21/2024 CHECKED BY: LKC DATE: 06/21/2024

DATE	BY	ISSUE	DESCRIPTION
*	JCW	1	**

Preliminary
07/12/2024 11:21:51 AM

DATE	BY	ISSUE	DESCRIPTION

DEVITA
ATLANTA • GREENVILLE • RICHMOND
877.4.DEVITA • corp@devitallc.com
Devita & Associates, Inc. Project :

CONTROL NUMBERS USED:
558 – 572, 596 – 607
CONTROL NUMBERS NOT USED: XXXX – XXXX
CONTROL NUMBERS VOIDED:
XXXX – XXXX
05 DARK NUMBER
05 CONTROL NUMBER

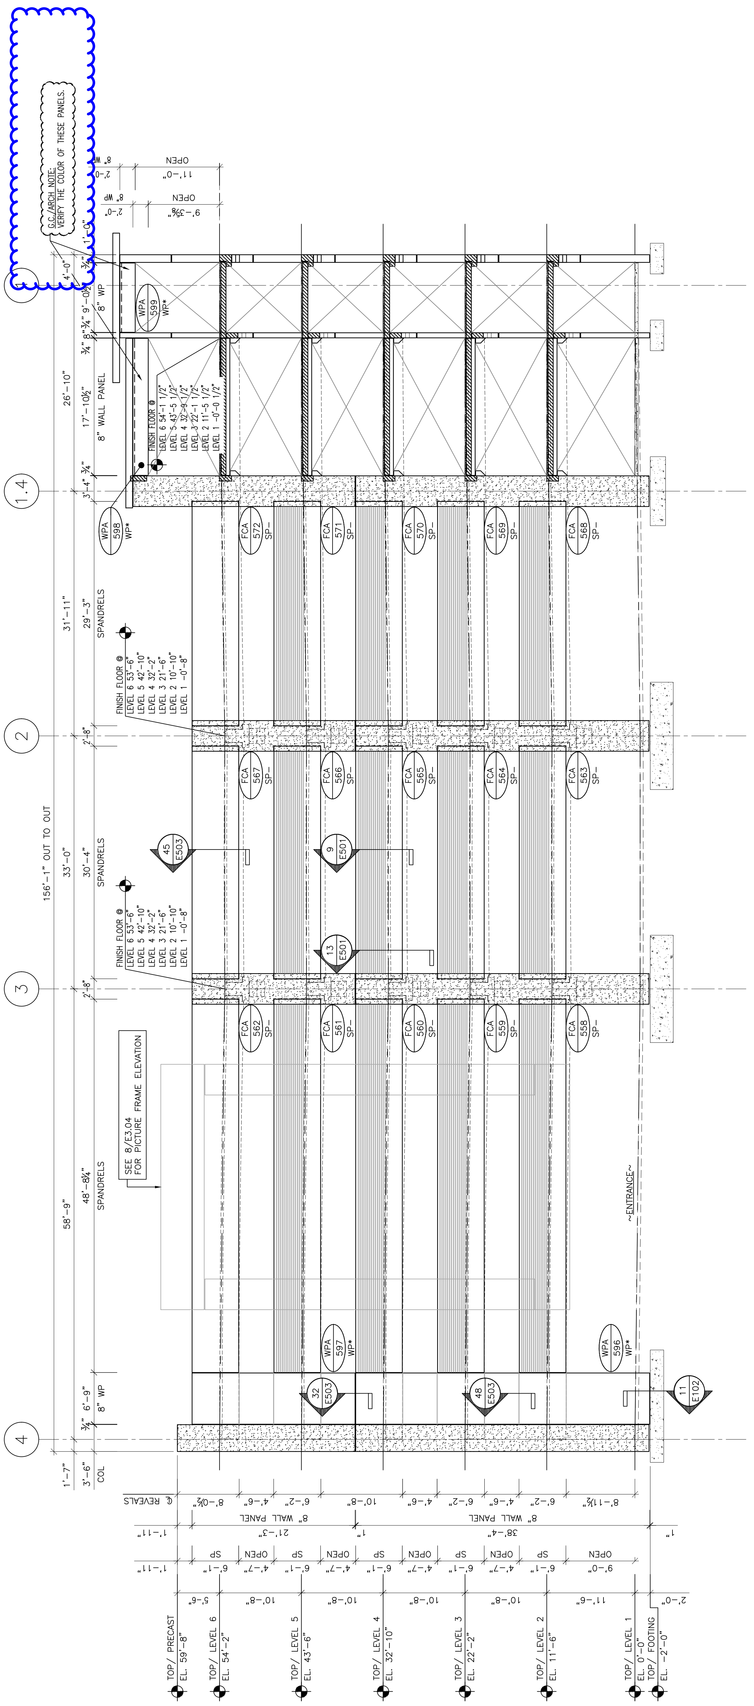

5 SOUTH ELEVATION
ALONG GRID A
⅛" = 1'-0"

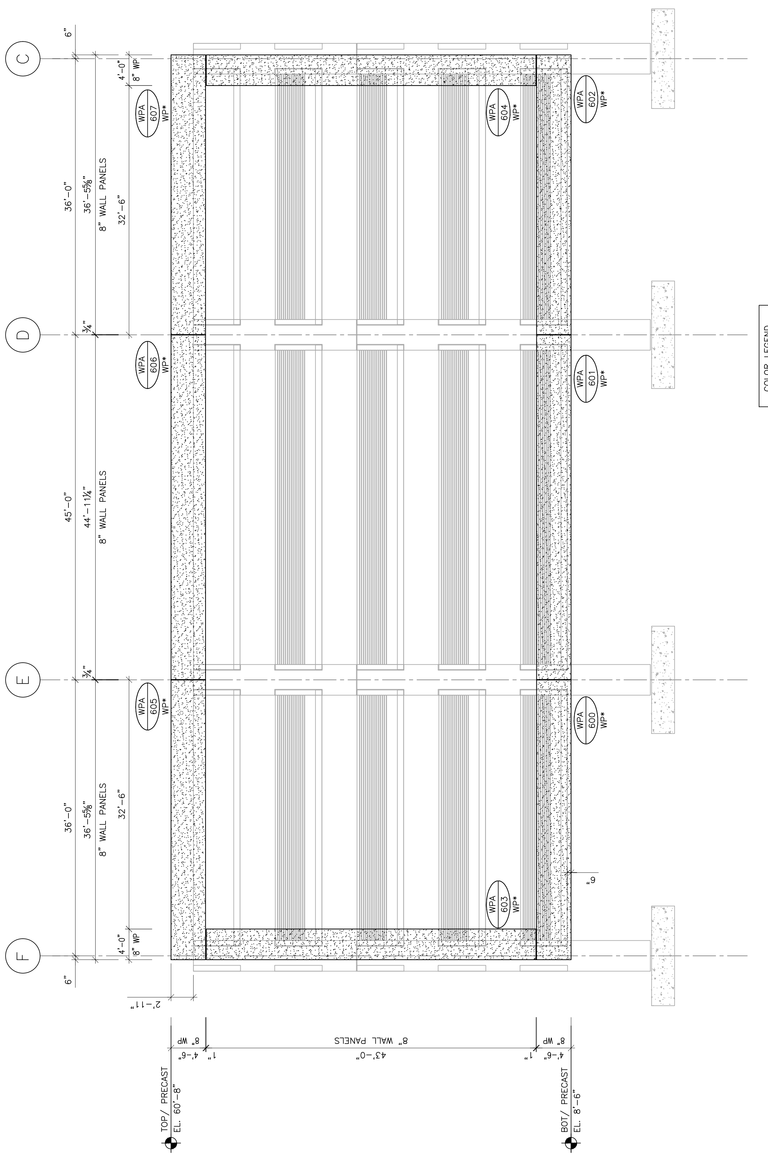

6 WEST ELEVATION
ALONG GRID 4
⅛" = 1'-0"

Proprietary Note: This document contains information which may be confidential and proprietary to Metromont Corporation and shall not be reproduced or transferred to other documents, disclosed to others or used for any purpose other than that which it was obtained without the prior written authorization from Metromont Corporation.

DRAWING COVERS	EXTERIOR/INTERIOR ELEVATION
PROJECT	HCA FLORIDA ST. LUCIE HOSPITAL PD
LOCATION	PORT ST. LUCIE, FL
ARCH. OR ENG.	TMPARTNERS, PLLC
CONTRACTOR	BRASFIELD & GORRIE, LLC
DRAWN BY: JCW	DATE: 06/21/2024 CHECKED BY: LKC DATE: 06/21/2024

METROMONT
20 TWO NOTCH ROAD
GREENVILLE, SOUTH CAROLINA 29605
(864) 295-0295

JOB NUMBER 20979

DRAWING NUMBER E3.04

DATE	BY	ISSUE	DESCRIPTION
*	JCW	1	**

Preliminary
07/12/2024 11:21:51 AM

DATE	BY	ISSUE	DESCRIPTION

DEVITA
ATLANTA • GREENVILLE • RICHMOND
877.4.DEVITA • corp@devitainc.com
Devita & Associates, Inc. Project :

CONTROL NUMBERS USED:
573, 608 – 615

CONTROL NUMBERS NOT USED: XXXX – XXXX

CONTROL NUMBERS VOIDED:
XXXX – XXXX

(00) MARK NUMBER
(000) CONTROL NUMBER

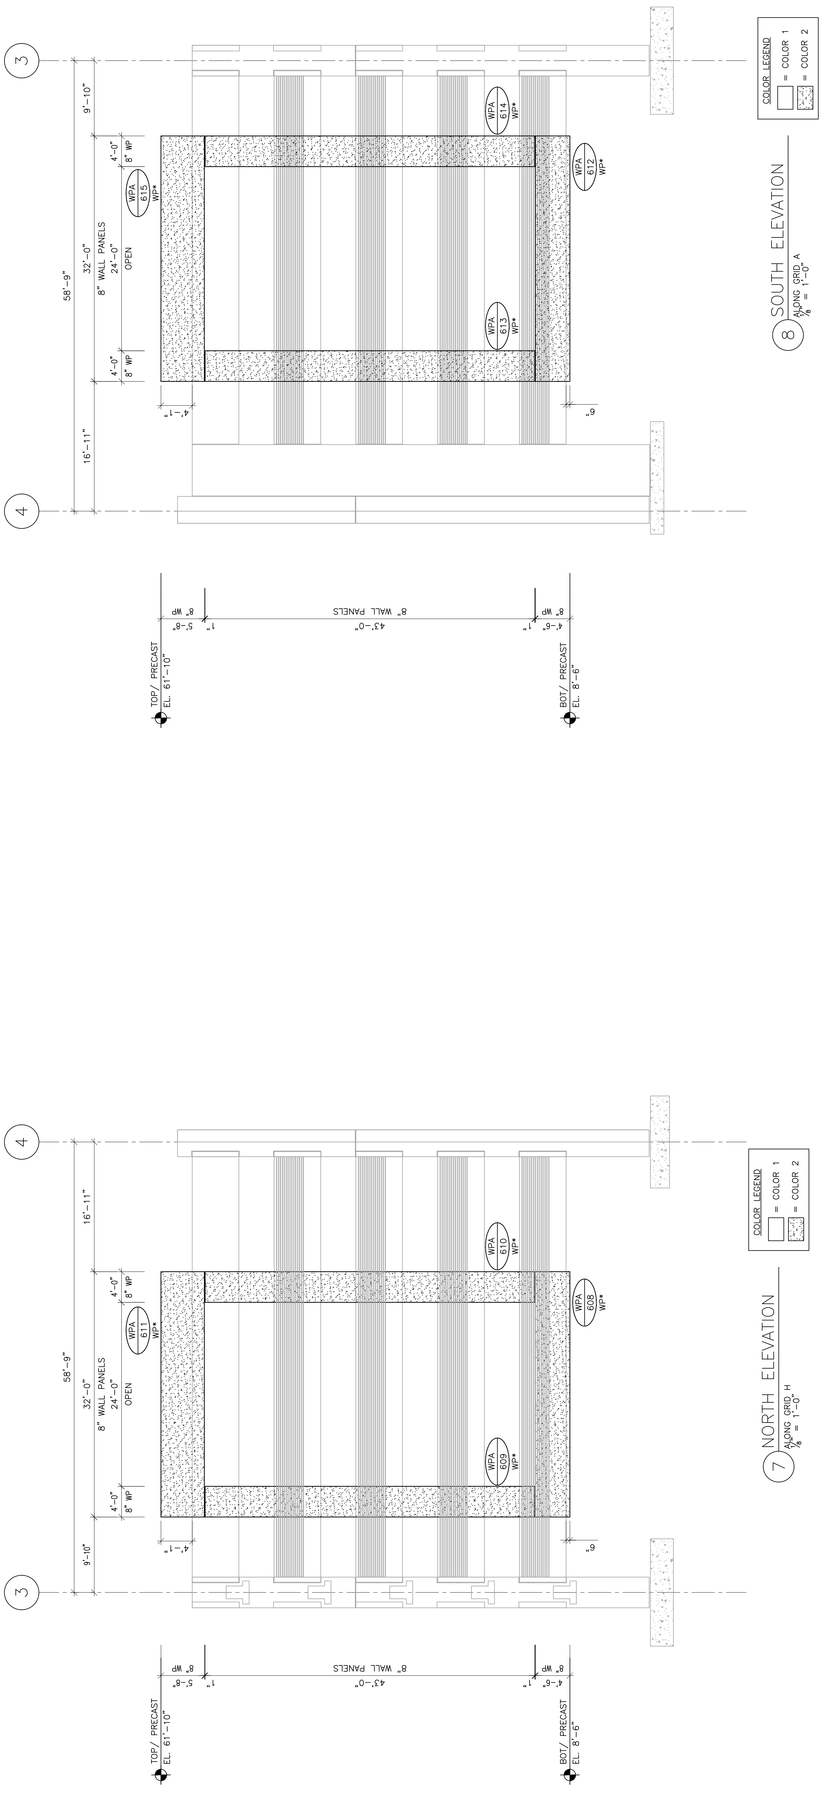

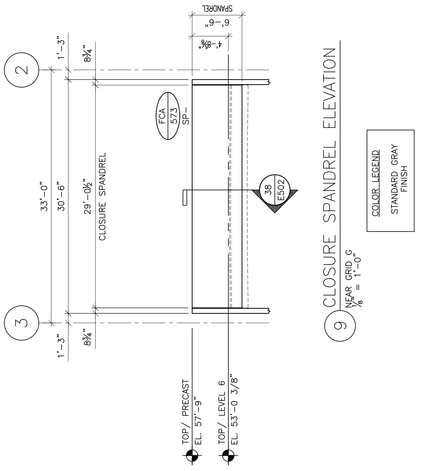

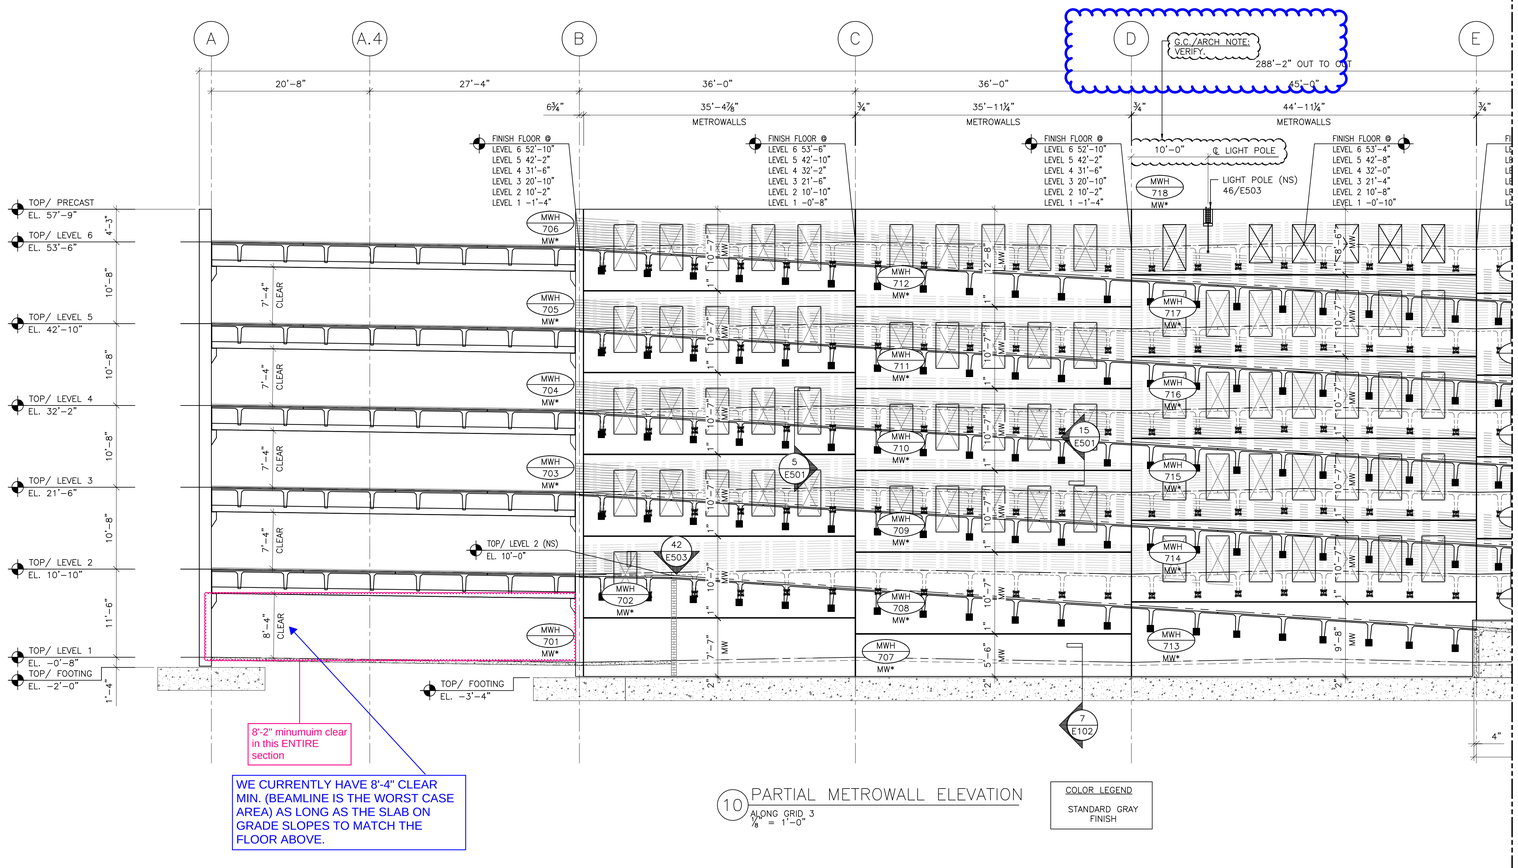

10 PARTIAL METROWALL ELEVATION
ALONG GRID 3
⅛" = 1'-0"

COLOR LEGEND
STANDARD GRAY FINISH

MATCHLINE – SEE 11/E3.05

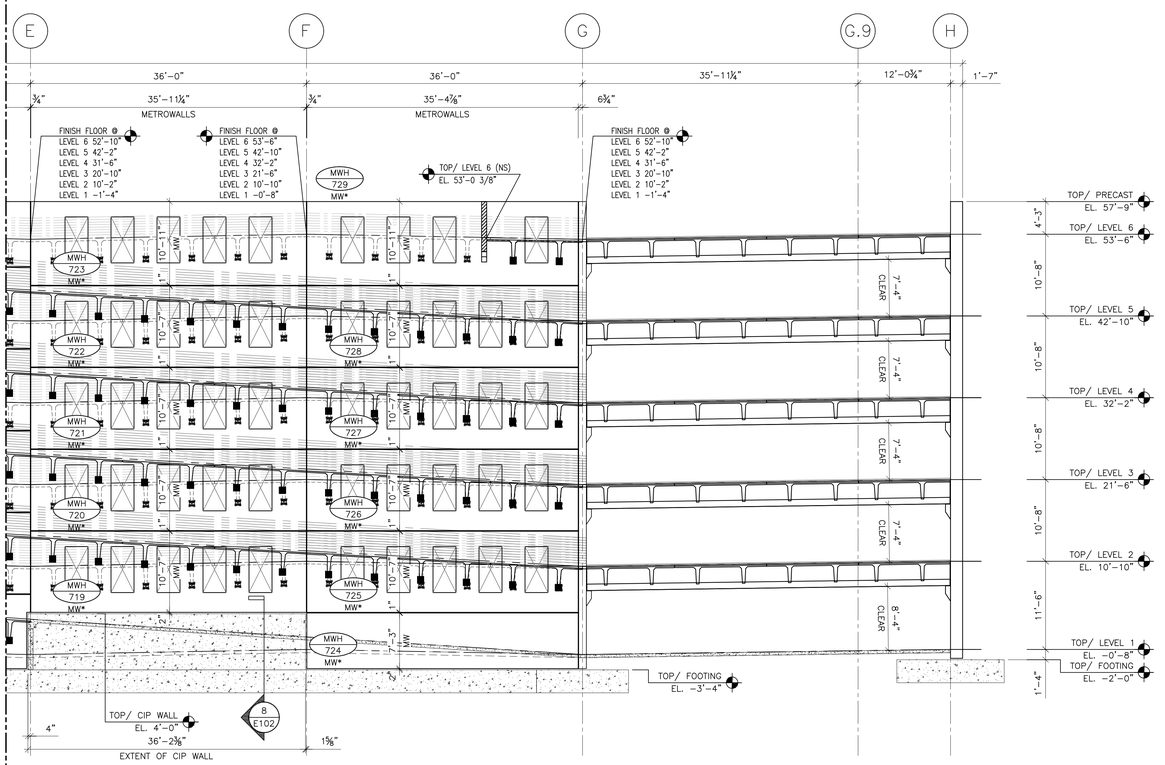

11 PARTIAL METROWALL ELEVATION
ALONG GRID 3
⅛" = 1'-0"

COLOR LEGEND
STANDARD GRAY FINISH

MATCHLINE – SEE 10/E3.05

CONTROL NUMBERS USED: 701 – 729
CONTROL NUMBERS NOT USED: XXXX – XXXX
CONTROL NUMBERS VOIDED: XXXX – XXXX
MARK NUMBER / CONTROL NUMBER

DEVITA
ATLANTA • GREENVILLE • RICHMOND
877.4.DEVITA • corp@devitainc.com
devita & associates, inc. / mepe

*	BY	DATE	DESCRIPTION
**	JCW	07/12/2024	Preliminary

*	BY	ISSUE	DESCRIPTION

Proprietary Note: This document contains information which may be confidential and proprietary to Metromont Corporation and shall not be reproduced or transferred to other documents, disclosed to others or used for any purpose other than that which it was obtained without the prior written authorization from Metromont Corporation.

DRAWING COVERS: INTERIOR ELEVATION
PROJECT: HCA FLORIDA ST. LUCIE HOSPITAL PD
LOCATION: PORT ST. LUCIE, FL
ARCH. OR ENG.: TMPARTNERS, PLLC
CONTRACTOR: BRASFIELD & GORRIE, LLC
DRAWN BY: JCW | DATE: 06/21/2024 | CHECKED BY: LKC | DATE: 06/21/2024

METROMONT
20 TWO NOTCH ROAD
GREENVILLE, SOUTH CAROLINA 29605
(864) 295-0295

JOB NUMBER 20979
DRAWING NUMBER E3.05

CONTROL NUMBERS USED:
730 – 758
CONTROL NUMBERS NOT USED:
XXX – XXX
CONTROL NUMBERS VOIDED:
XXXX – XXXX
DRAWN NUMBER
CONTROL NUMBER

DEVITA
ATLANTA • GREENVILLE • RICHMOND
877.4.DEVITA • corp@devitainc.com
Devita & Associates, Inc. Project

DESCRIPTION	DATE	BY	ISSUE

Preliminary
07/12/2024 11:21:51 AM

DESCRIPTION	ISSUE	BY	DATE
**	1	JCW	
*			

METROMONT
20 TWO NOTCH ROAD
GREENVILLE, SOUTH CAROLINA 29605
(864) 295-0295

DRAWING COVERS	INTERIOR ELEVATION
PROJECT	HCA FLORIDA ST. LUCIE HOSPITAL PD
LOCATION	PORT ST. LUCIE, FL
ARCH. OR ENG.	TMPARTNERS, PLLC
CONTRACTOR	BRASFIELD & GORRIE, LLC

DRAWN BY: JCW DATE: 06/21/2024 CHECKED BY: LKC DATE: 06/21/2024

JOB NUMBER 20979

DRAWING NUMBER E3.06

Proprietary Note: This document contains information which may be confidential and proprietary to Metromont Corporation and shall not be reproduced or transferred to other documents, disclosed to others or used for any purpose other than that which it was obtained without the prior written authorization from Metromont Corporation.

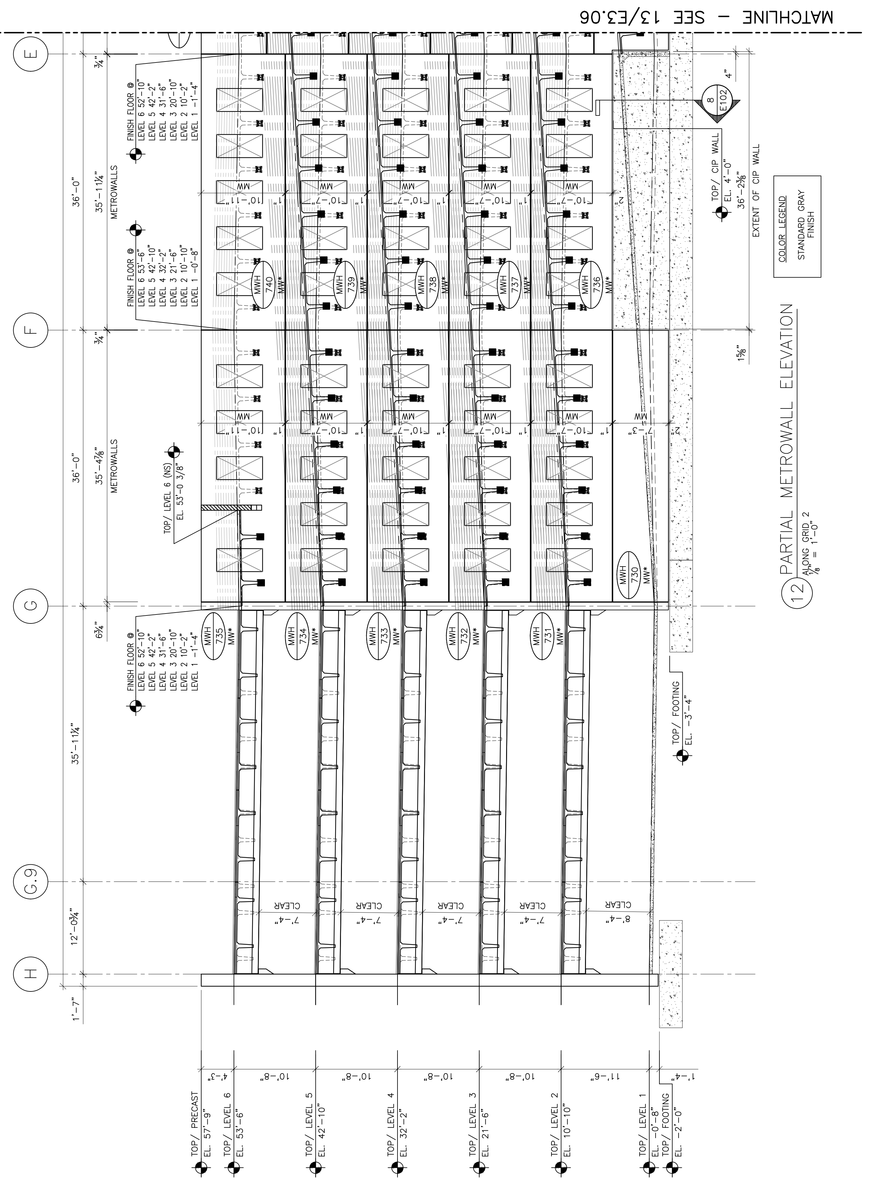

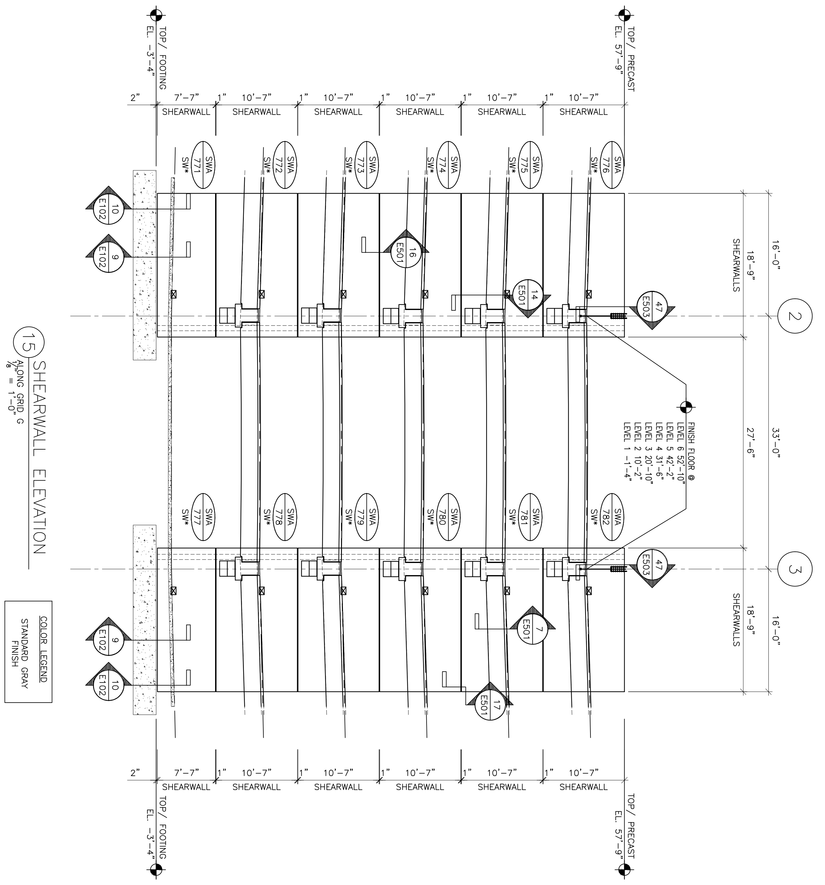

15 SHEARWALL ELEVATION
ALONG GRID G
1/8" = 1'-0"

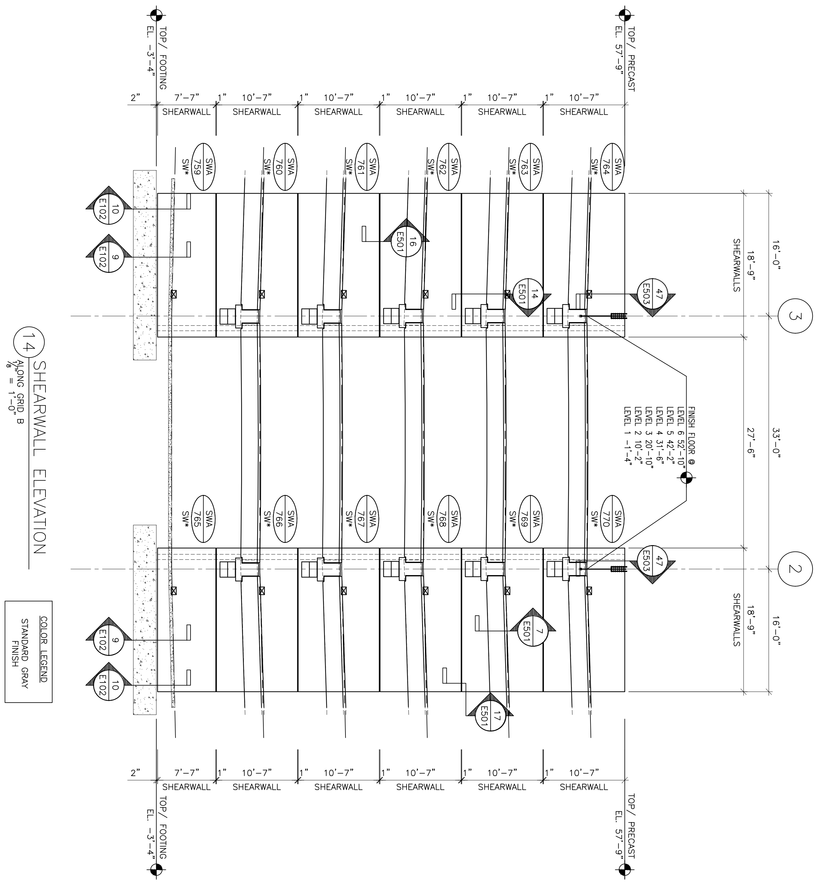

14 SHEARWALL ELEVATION
ALONG GRID B
1/8" = 1'-0"

COLOR LEGEND
STANDARD GRAY FINISH

COLOR LEGEND
STANDARD GRAY FINISH

Proprietary Note: This document contains information which may be confidential and proprietary to Metromont Corporation and shall not be reproduced or transferred to other documents, disclosed to others or used for any purpose other than that which it was obtained without the prior written authorization from Metromont Corporation.

JOB NUMBER 20979
DRAWING NUMBER E3.07

METROMONT™
20 TWO NOTCH ROAD
GREENVILLE, SOUTH CAROLINA 29605
(864) 295-0295

DRAWING COVERS	INTERIOR ELEVATION
PROJECT	HCA FLORIDA ST. LUCIE HOSPITAL PD
LOCATION	PORT ST. LUCIE, FL
ARCH. OR ENG.	TMPARTNERS, PLLC
CONTRACTOR	BRASFIELD & GORRIE, LLC
DRAWN BY: JCW	DATE: 06/21/2024 CHECKED BY: LKC DATE: 06/21/2024

Preliminary
07/12/2024 11:21:51 AM

	DATE	BY	ISSUE	DESCRIPTION
*		JCW	1	**

DATE	BY	ISSUE	DESCRIPTION

DEVITA
ATLANTA • GREENVILLE • RICHMOND
877.4.DEVITA • corp@devitainc.com
DeVita & Associates, Inc. Project :

CONTROL NUMBERS USED: XXXX – XXXX
CONTROL NUMBERS NOT USED: XXXX – XXXX
CONTROL NUMBERS VOIDED: XXXX – XXXX
CONTROL NUMBER

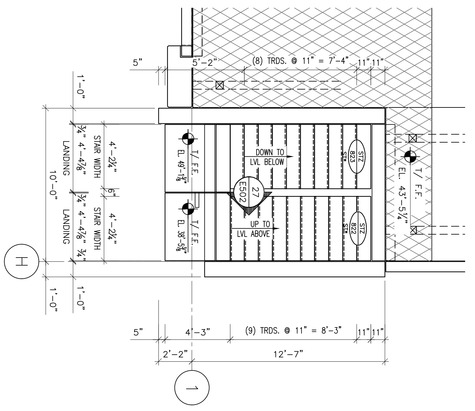

5 LEVEL 5 PLAN
¼" = 1'-0"

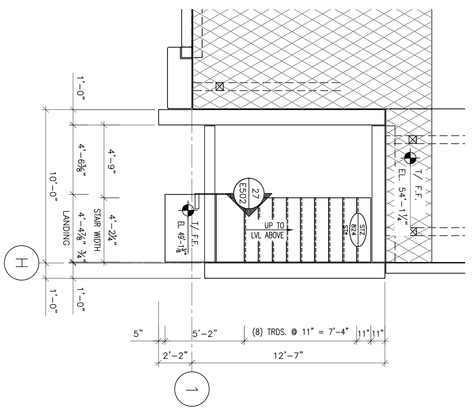

6 LEVEL 6 PLAN
¼" = 1'-0"

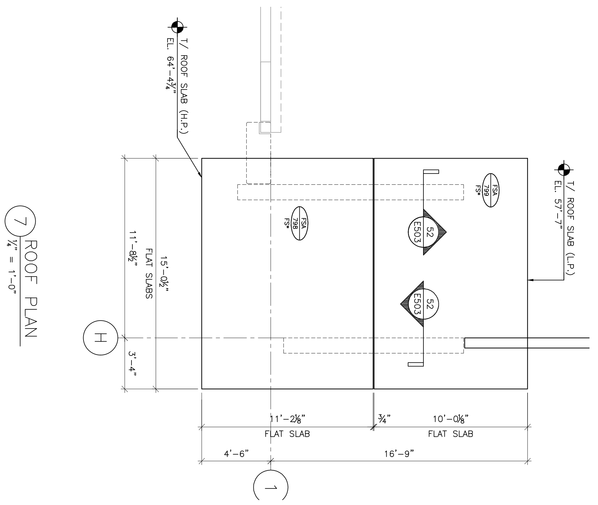

7 ROOF PLAN
¼" = 1'-0"

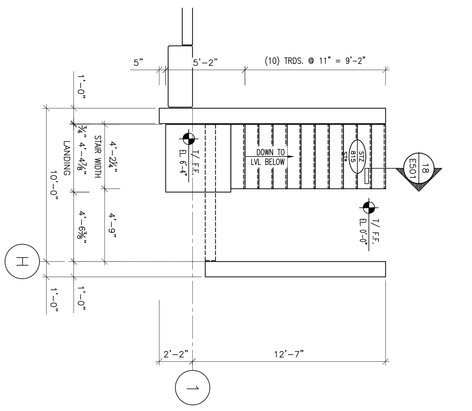

1 LEVEL 1 PLAN
¼" = 1'-0"

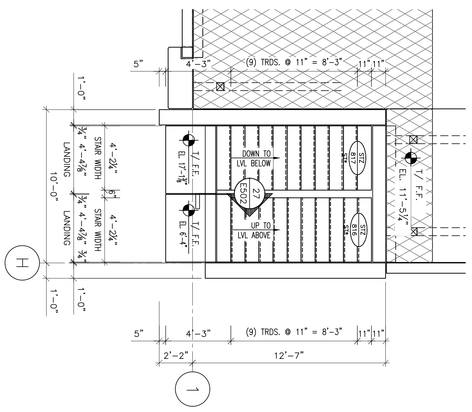

2 LEVEL 2 PLAN
¼" = 1'-0"

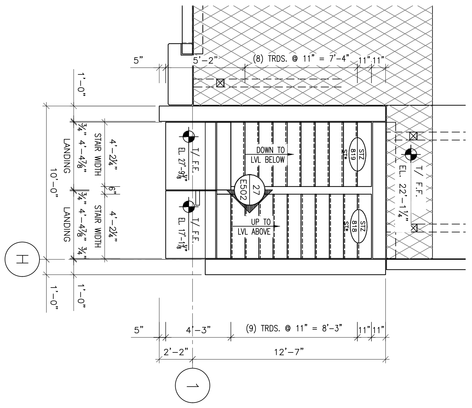

3 LEVEL 3 PLAN
¼" = 1'-0"

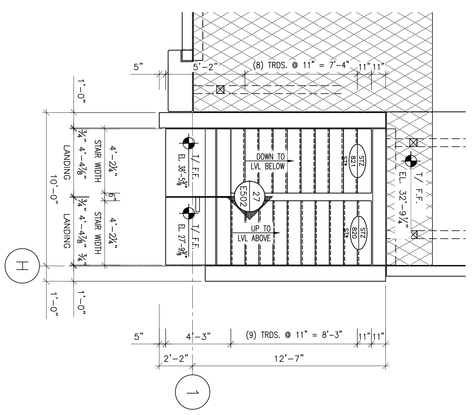

4 LEVEL 4 PLAN
¼" = 1'-0"

Proprietary Note: This document contains information which may be confidential and proprietary to Metromont Corporation and shall not be reproduced or transferred to other documents, disclosed to others or used for any purpose other than that which it was obtained without the prior written authorization from Metromont Corporation.

METROMONT
20 TWO NOTCH ROAD
GREENVILLE, SOUTH CAROLINA 29605
(864) 295-0295

JOB NUMBER 20979
DRAWING NUMBER E4.01

DRAWING COVERS	STAIR #2 PLANS
PROJECT	HCA FLORIDA ST. LUCIE HOSPITAL PD
LOCATION	PORT ST. LUCIE, FL
ARCH. OR ENG.	TMPARTNERS, PLLC
CONTRACTOR	BRASFIELD & GORRIE, LLC
DRAWN BY: JCW	DATE: 06/26/2024 CHECKED BY: LKC DATE: 06/26/2024

DATE	BY	ISSUE	DESCRIPTION
*	JCW	1	**

Preliminary
07/12/2024 11:21:51 AM

DATE	BY	ISSUE	DESCRIPTION

DEVITA
ATLANTA • GREENVILLE • RICHMOND
877.4.DEVITA • corp@devitainc.com
DeVita & Associates, Inc. Project :

CONTROL NUMBERS USED: 8777-1579
CONTROL NUMBERS NOT USED: XXXX – XXXX
CONTROL NUMBERS VOIDED: XXXX – XXXX

SEAL
NAME
DATE
SIGNATURE
REGISTRATION NUMBER

Proprietary Note: This document contains information which may be confidential and proprietary to Metromont Corporation and shall not be reproduced or transferred to other documents, disclosed to others or used for any purpose other than that which it was obtained without the prior written authorization from Metromont Corporation.

DRAWING COVERS	STAIR #2 ELEVATIONS
PROJECT	HCA FLORIDA ST. LUCIE HOSPITAL PD
LOCATION	PORT ST. LUCIE, FL
ARCH. OR ENG.	TMPARTNERS, PLLC
CONTRACTOR	BRASFIELD & GORRIE, LLC
DRAWN BY: JCW	DATE: 06/26/2024 CHECKED BY: LKC DATE: 06/26/2024

METROMONT
20 TWO NOTCH ROAD
GREENVILLE, SOUTH CAROLINA 29605
(864) 295-0295

JOB NUMBER 20979

DRAWING NUMBER E4.02

DATE	BY	ISSUE	DESCRIPTION
*	JCW	1	**

Preliminary
07/12/2024 11:21:51 AM

DATE	BY	ISSUE	DESCRIPTION

DEVITA
ATLANTA • GREENVILLE • RICHMOND
877.4.DEVITA • corp@devitainc.com
Devita & Associates, Inc. Project :

CONTROL NUMBERS USED:
616 – 622
CONTROL NUMBERS NOT USED: XXX – XXX
CONTROL NUMBERS VOIDED:
XXXX – XXXX
(00) MARK NUMBER
(000) CONTROL NUMBER

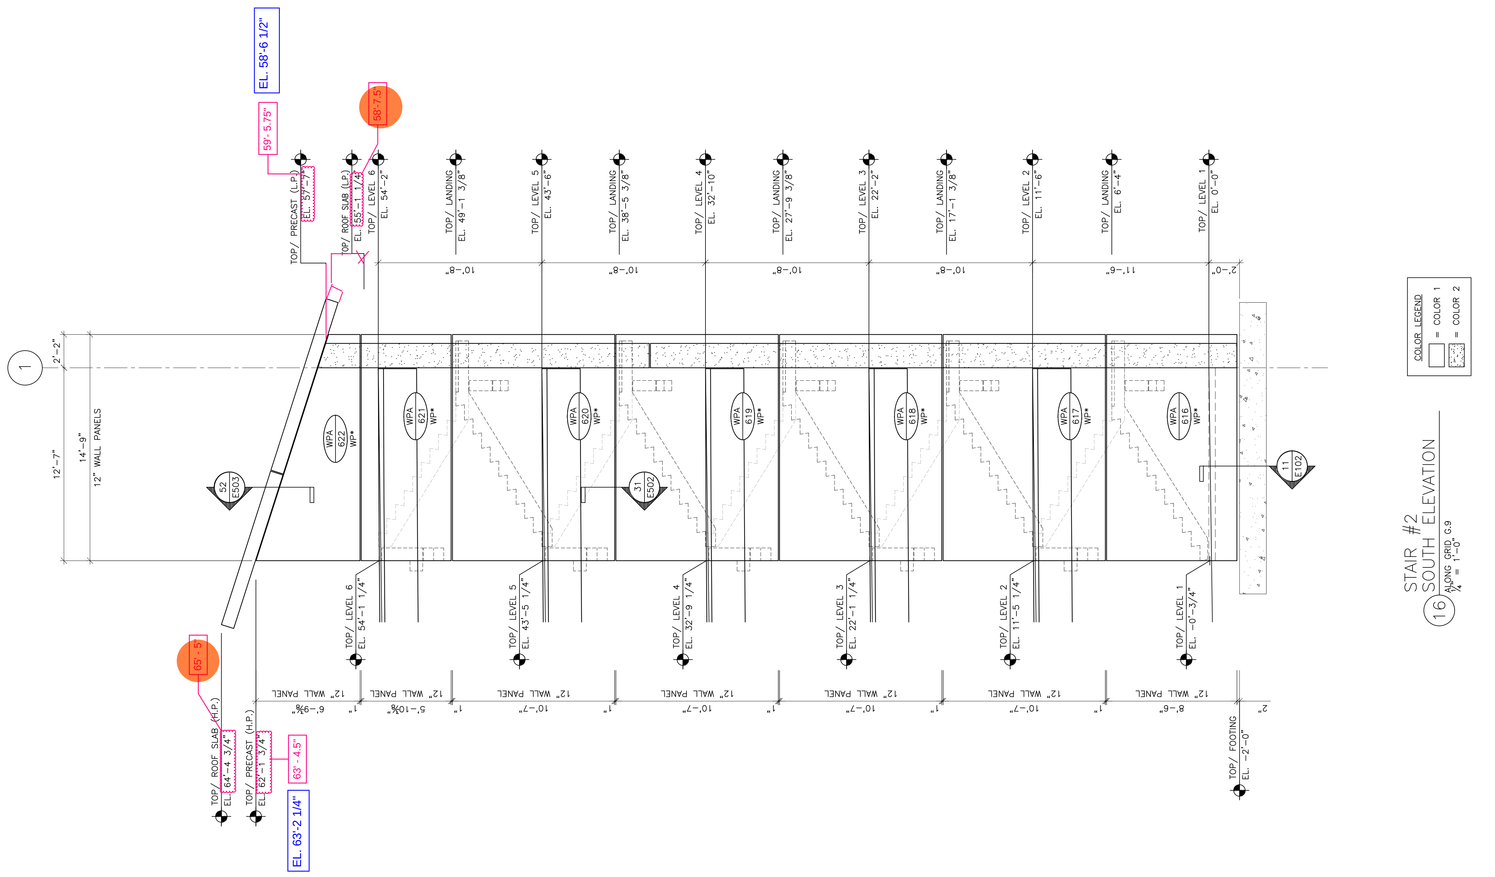

STAIR #2
SOUTH ELEVATION
16 ALONG GRID G.9
1/4" = 1'-0"

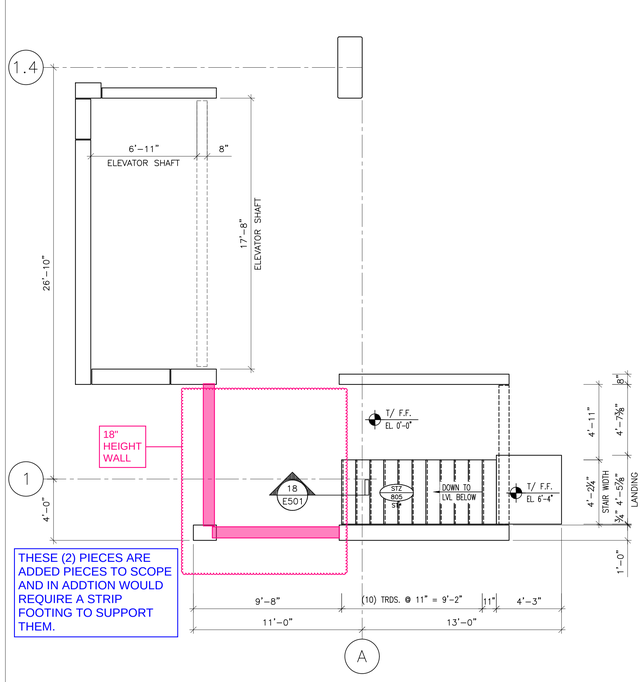

1 LEVEL 1 PLAN
¼" = 1'-0"

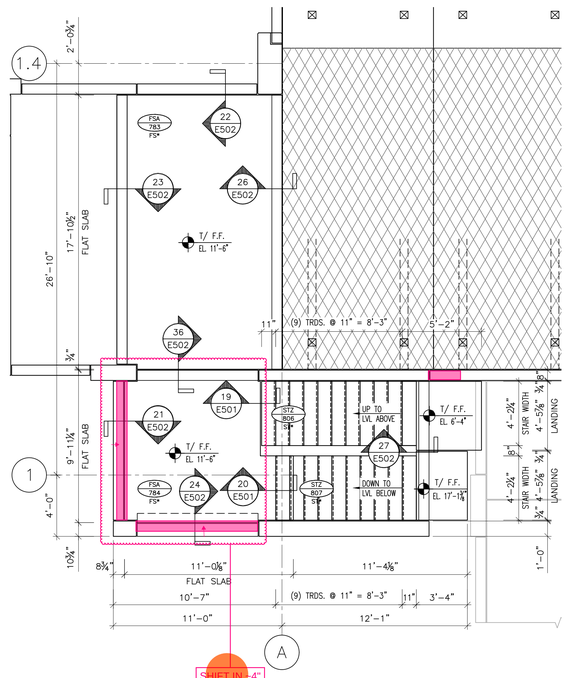

2 LEVEL 2 PLAN
¼" = 1'-0"

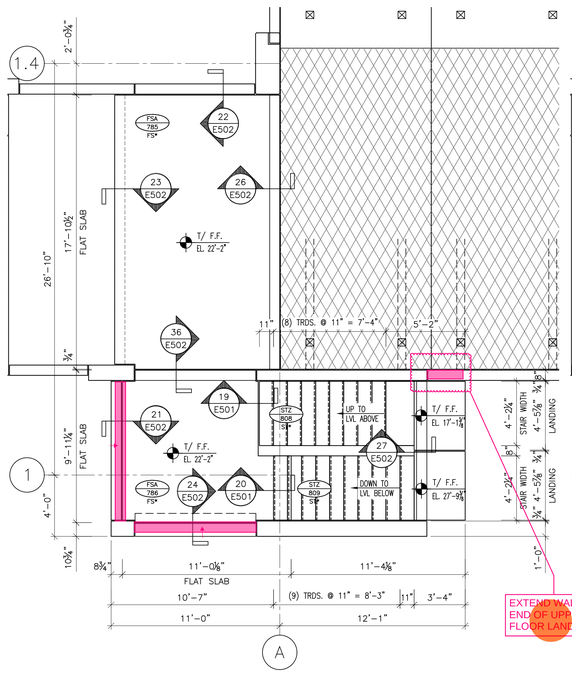

3 LEVEL 3 PLAN
¼" = 1'-0"

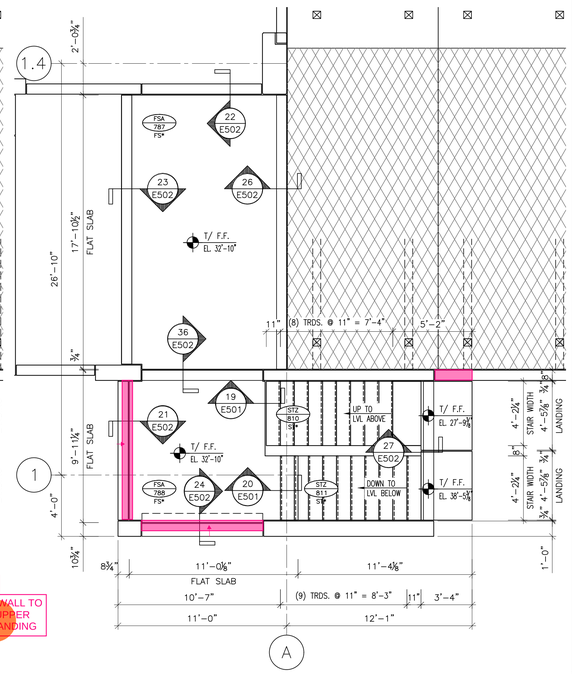

4 LEVEL 4 PLAN
¼" = 1'-0"

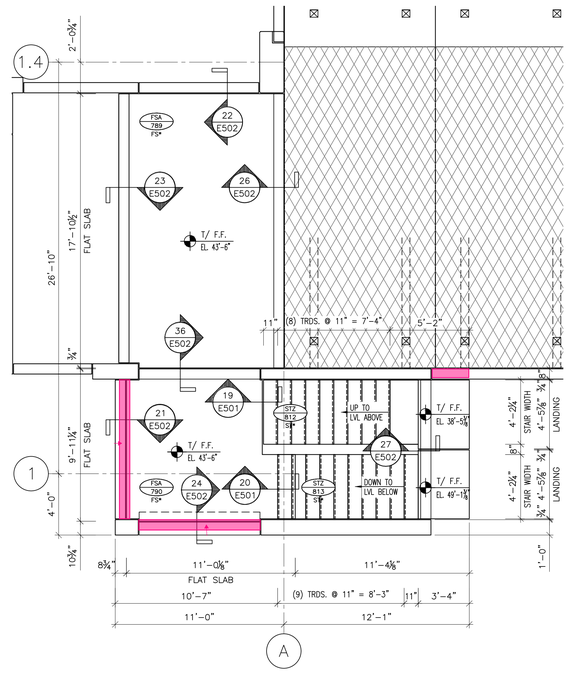

5 LEVEL 5 PLAN
¼" = 1'-0"

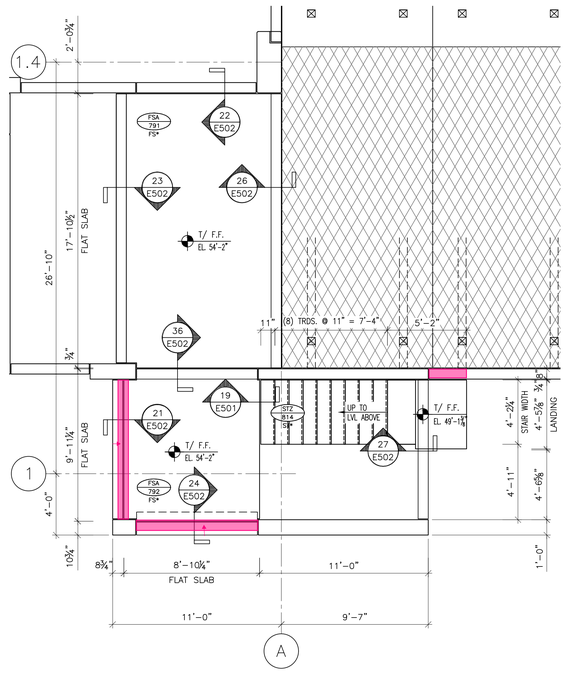

6 LEVEL 6 PLAN
¼" = 1'-0"

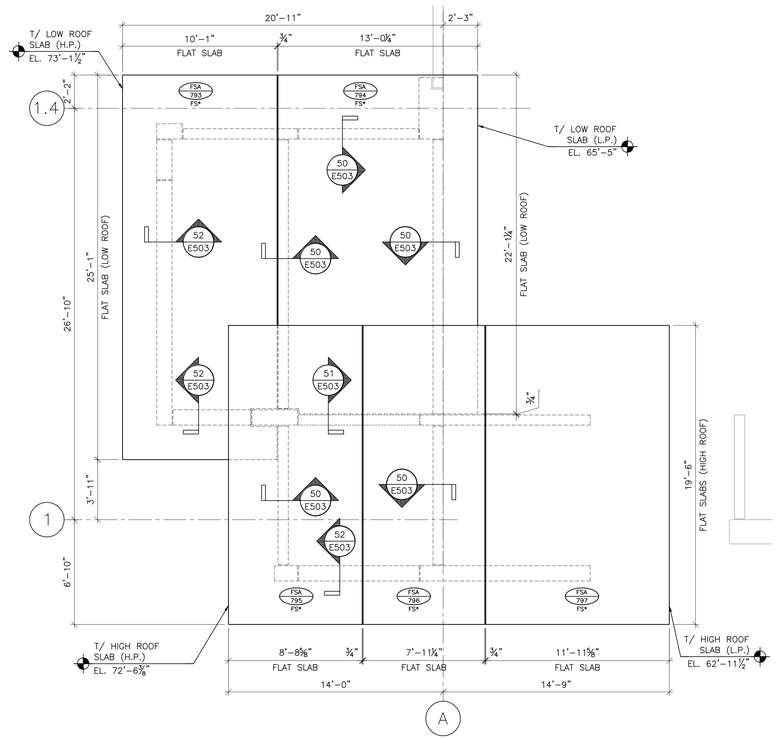

7 ROOF PLAN
¼" = 1'-0"

CONTROL NUMBERS USED:
783 – 797, 805 – 814

CONTROL NUMBERS NOT
USED: XXXX – XXXX

CONTROL NUMBERS VOIDED:
XXXX – XXXX

MARK NUMBER
CONTROL NUMBER

DEVITA
ATLANTA • GREENVILLE • RICHMOND
877.4.DEVITA • corp@devitainc.com
devita & associates, inc. / mepe1

DESCRIPTION	ISSUE	BY	DATE

Preliminary
07/12/2024 11:21:52 AM

DESCRIPTION	ISSUE	BY	DATE
*	1	JCW	06/26/2024

DRAWING COVERS	STAIR #1 PLANS
PROJECT	HCA FLORIDA ST. LUCIE HOSPITAL PD
LOCATION	PORT ST. LUCIE, FL
ARCH. OR ENG.	TMPARTNERS, PLLC
CONTRACTOR	BRASFIELD & GORRIE, LLC
DRAWN BY:	JCW DATE: 06/26/2024 CHECKED BY: LKC DATE: 06/26/2024

METROMONT
20 TWO NOTCH ROAD
GREENVILLE, SOUTH CAROLINA 29605
(864) 295-0295

JOB NUMBER
20979

DRAWING NUMBER
E4.03

Proprietary Note: This document contains information which may be confidential and proprietary to Metromont Corporation and shall not be reproduced or transferred to other documents, disclosed to others or used for any purpose other than that which it was obtained without the prior written authorization from Metromont Corporation.

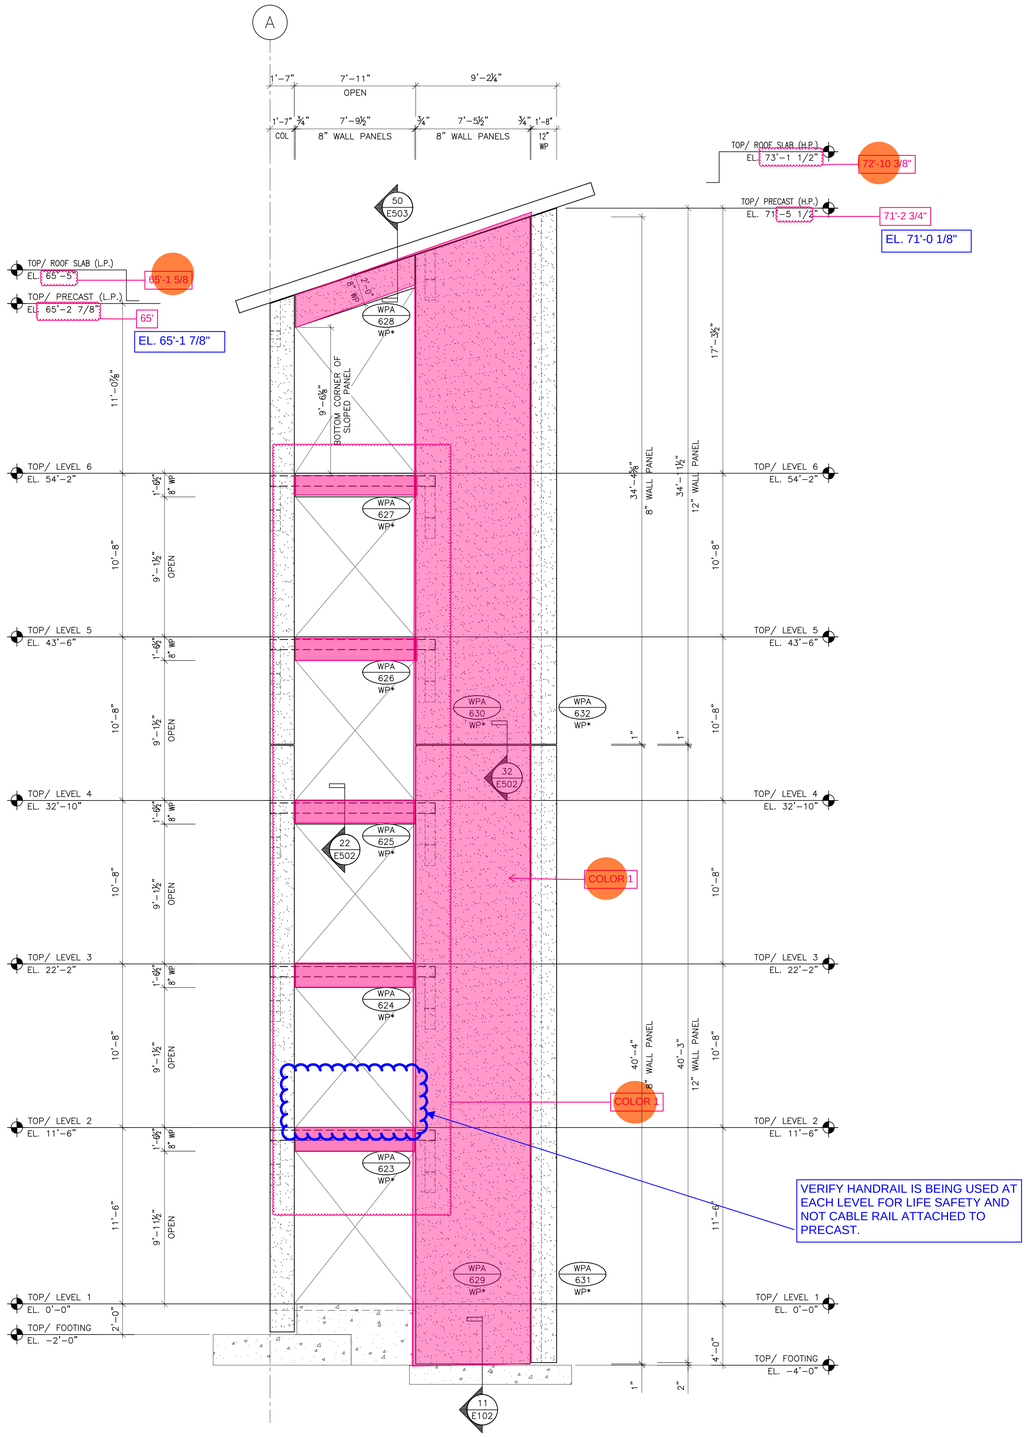

17 ELEVATOR WEST ELEVATION

ALONG GRID 1.4

¼" = 1'-0"

COLOR LEGEND

= COLOR 1

= COLOR 2

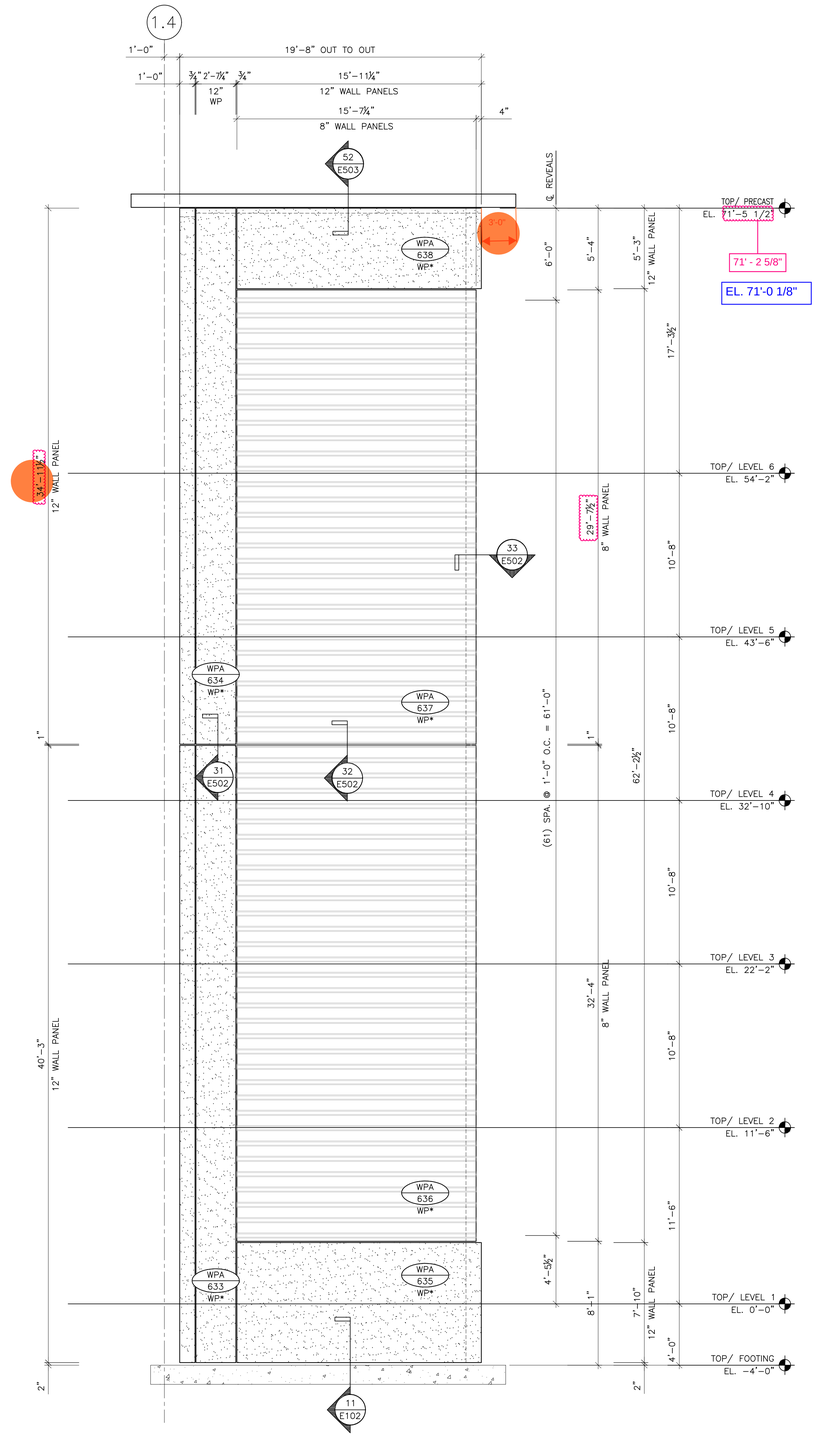

18 ELEVATOR SOUTH ELEVATION

NEAR GRID A

¼" = 1'-0"

COLOR LEGEND

= COLOR 1

= COLOR 2

CONTROL NUMBERS USED: 623 – 638

CONTROL NUMBERS NOT USED: XXXX – XXXX

CONTROL NUMBERS VOIDED: XXXX – XXXX

MARK NUMBER / CONTROL NUMBER

DEVITA
ATLANTA • GREENVILLE - RICHMOND
877.4.DEVITA • corp@devitainc.com
devita & associates, inc. / report

NO	DESCRIPTION	DATE	BY	ISSUE
*		DATE	BY	ISSUE
1	**	JCW		

Preliminary
07/12/2024 11:21:52 AM

DRAWING COVERS: ELEVATOR ELEVATIONS
PROJECT: HCA FLORIDA ST. LUCIE HOSPITAL PD
LOCATION: PORT ST. LUCIE, FL
ARCH. OR ENG.: TMPARTNERS, PLLC
CONTRACTOR: BRASFIELD & GORRIE, LLC
DRAWN BY: JCW DATE: 06/26/2024 CHECKED BY: LKC DATE: 06/26/2024

Proprietary Note: This document contains information which may be confidential and proprietary to Metromont Corporation and shall not be reproduced or transferred to other documents, disclosed to others or used for any purpose other than that which it was obtained without the prior written authorization from Metromont Corporation.

METROMONT
20 TWO NOTCH ROAD
GREENVILLE, SOUTH CAROLINA 29605
(864) 295-0295

JOB NUMBER 20979

DRAWING NUMBER E4.04

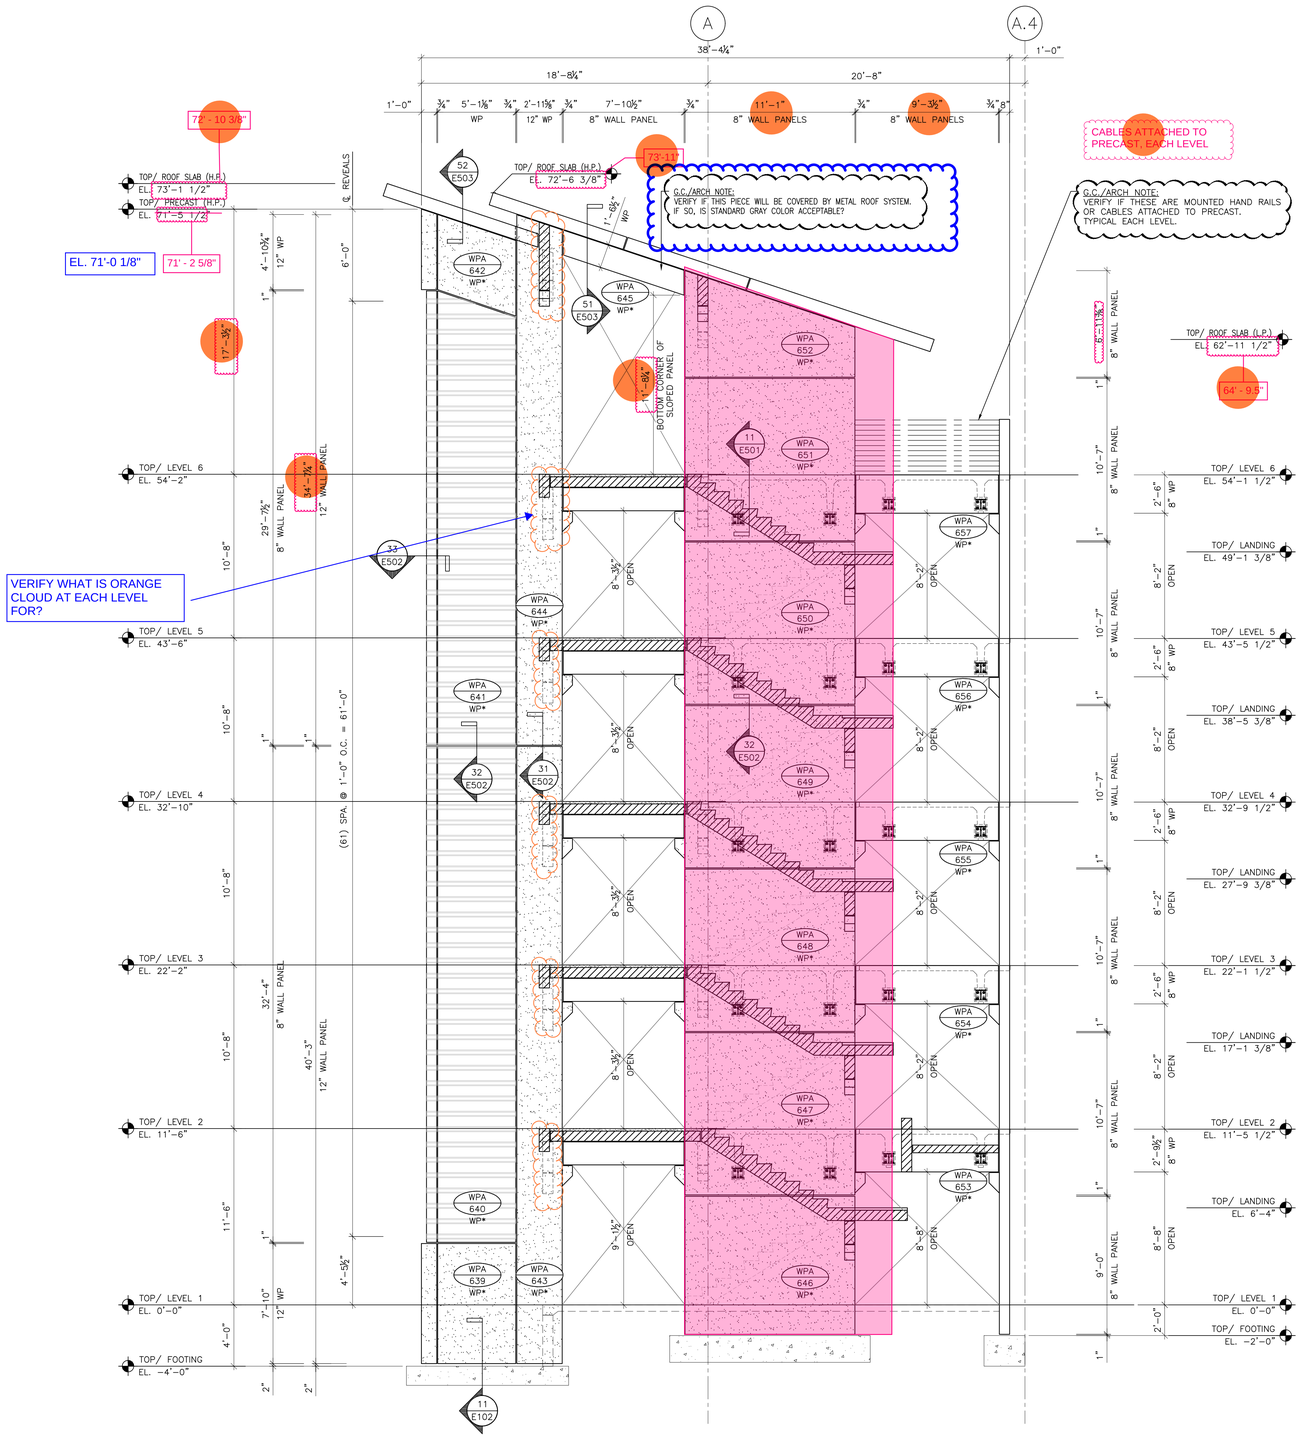

19 ELEVATOR/STAIR #1 EAST ELEVATION
NEAR GRID 1
3/4" = 1'-0"

COLOR LEGEND
= COLOR 1
= COLOR 2

CONTROL NUMBERS USED: 639 – 657
CONTROL NUMBERS NOT USED: XXXX – XXXX
CONTROL NUMBERS VOIDED: XXXX – XXXX
MARK NUMBER / CONTROL NUMBER

DEVITA
ATLANTA • GREENVILLE • RICHMOND
877.4.DEVITA • corp@devitainc.com
devita & associates, inc. / mepe1

*	DATE	BY	ISSUE
1	**	JCW	0

DESCRIPTION

Preliminary
07/12/2024 11:21:52 AM

DESCRIPTION

Proprietary Note: This document contains information which may be confidential and proprietary to Metromont Corporation and shall not be reproduced or transferred to other documents, disclosed to others or used for any purpose other than that which it was obtained without the prior written authorization from Metromont Corporation.

DRAWING COVERS: ELEVATOR/STAIR #1 ELEVATIONS
PROJECT: HCA FLORIDA ST. LUCIE HOSPITAL PD
LOCATION: PORT ST. LUCIE, FL
ARCH. OR ENG.: TMPARTNERS, PLLC
CONTRACTOR: BRASFIELD & GORRIE, LLC
DRAWN BY: JCW | DATE: 06/26/2024 | CHECKED BY: LKC | DATE: 06/26/2024

METROMONT
20 TWO NOTCH ROAD
GREENVILLE, SOUTH CAROLINA 29605
(864) 295-0295

JOB NUMBER
20979

DRAWING NUMBER
E4.05

Proprietary Note: This document contains information which may be confidential and proprietary to Metromont Corporation and shall not be reproduced or transferred to other documents, disclosed to others or used for any purpose other than that which it was obtained without the prior written authorization from Metromont Corporation.

CONTROL NUMBERS USED:	658 – 679
CONTROL NUMBERS NOT USED:	XXX – XXX
CONTROL NUMBERS VOIDED:	XXXX – XXXX

DEVITA
ATLANTA • GREENVILLE • RICHMOND
877.4.DEVITA • corp@devitainc.com
Devita & Associates, Inc. Project:

DESCRIPTION	ISSUE	BY	DATE

Preliminary
07/12/2024 11:21:52 AM

DESCRIPTION	ISSUE	BY	DATE
**	1	JCW	
*			

DRAWING COVERS	ELEVATOR/STAIR #1 ELEVATIONS
PROJECT	HCA FLORIDA ST. LUCIE HOSPITAL PD
LOCATION	PORT ST. LUCIE, FL
ARCH. OR ENG.	TMPARTNERS, PLLC
CONTRACTOR	BRASFIELD & GORRIE, LLC

DRAWN BY: JCW DATE: 06/26/2024 CHECKED BY: LKC DATE: 06/26/2024

METROMONT
20 TWO NOTCH ROAD
GREENVILLE, SOUTH CAROLINA 29605
(864) 295-0295

JOB NUMBER 20979

DRAWING NUMBER E4.06

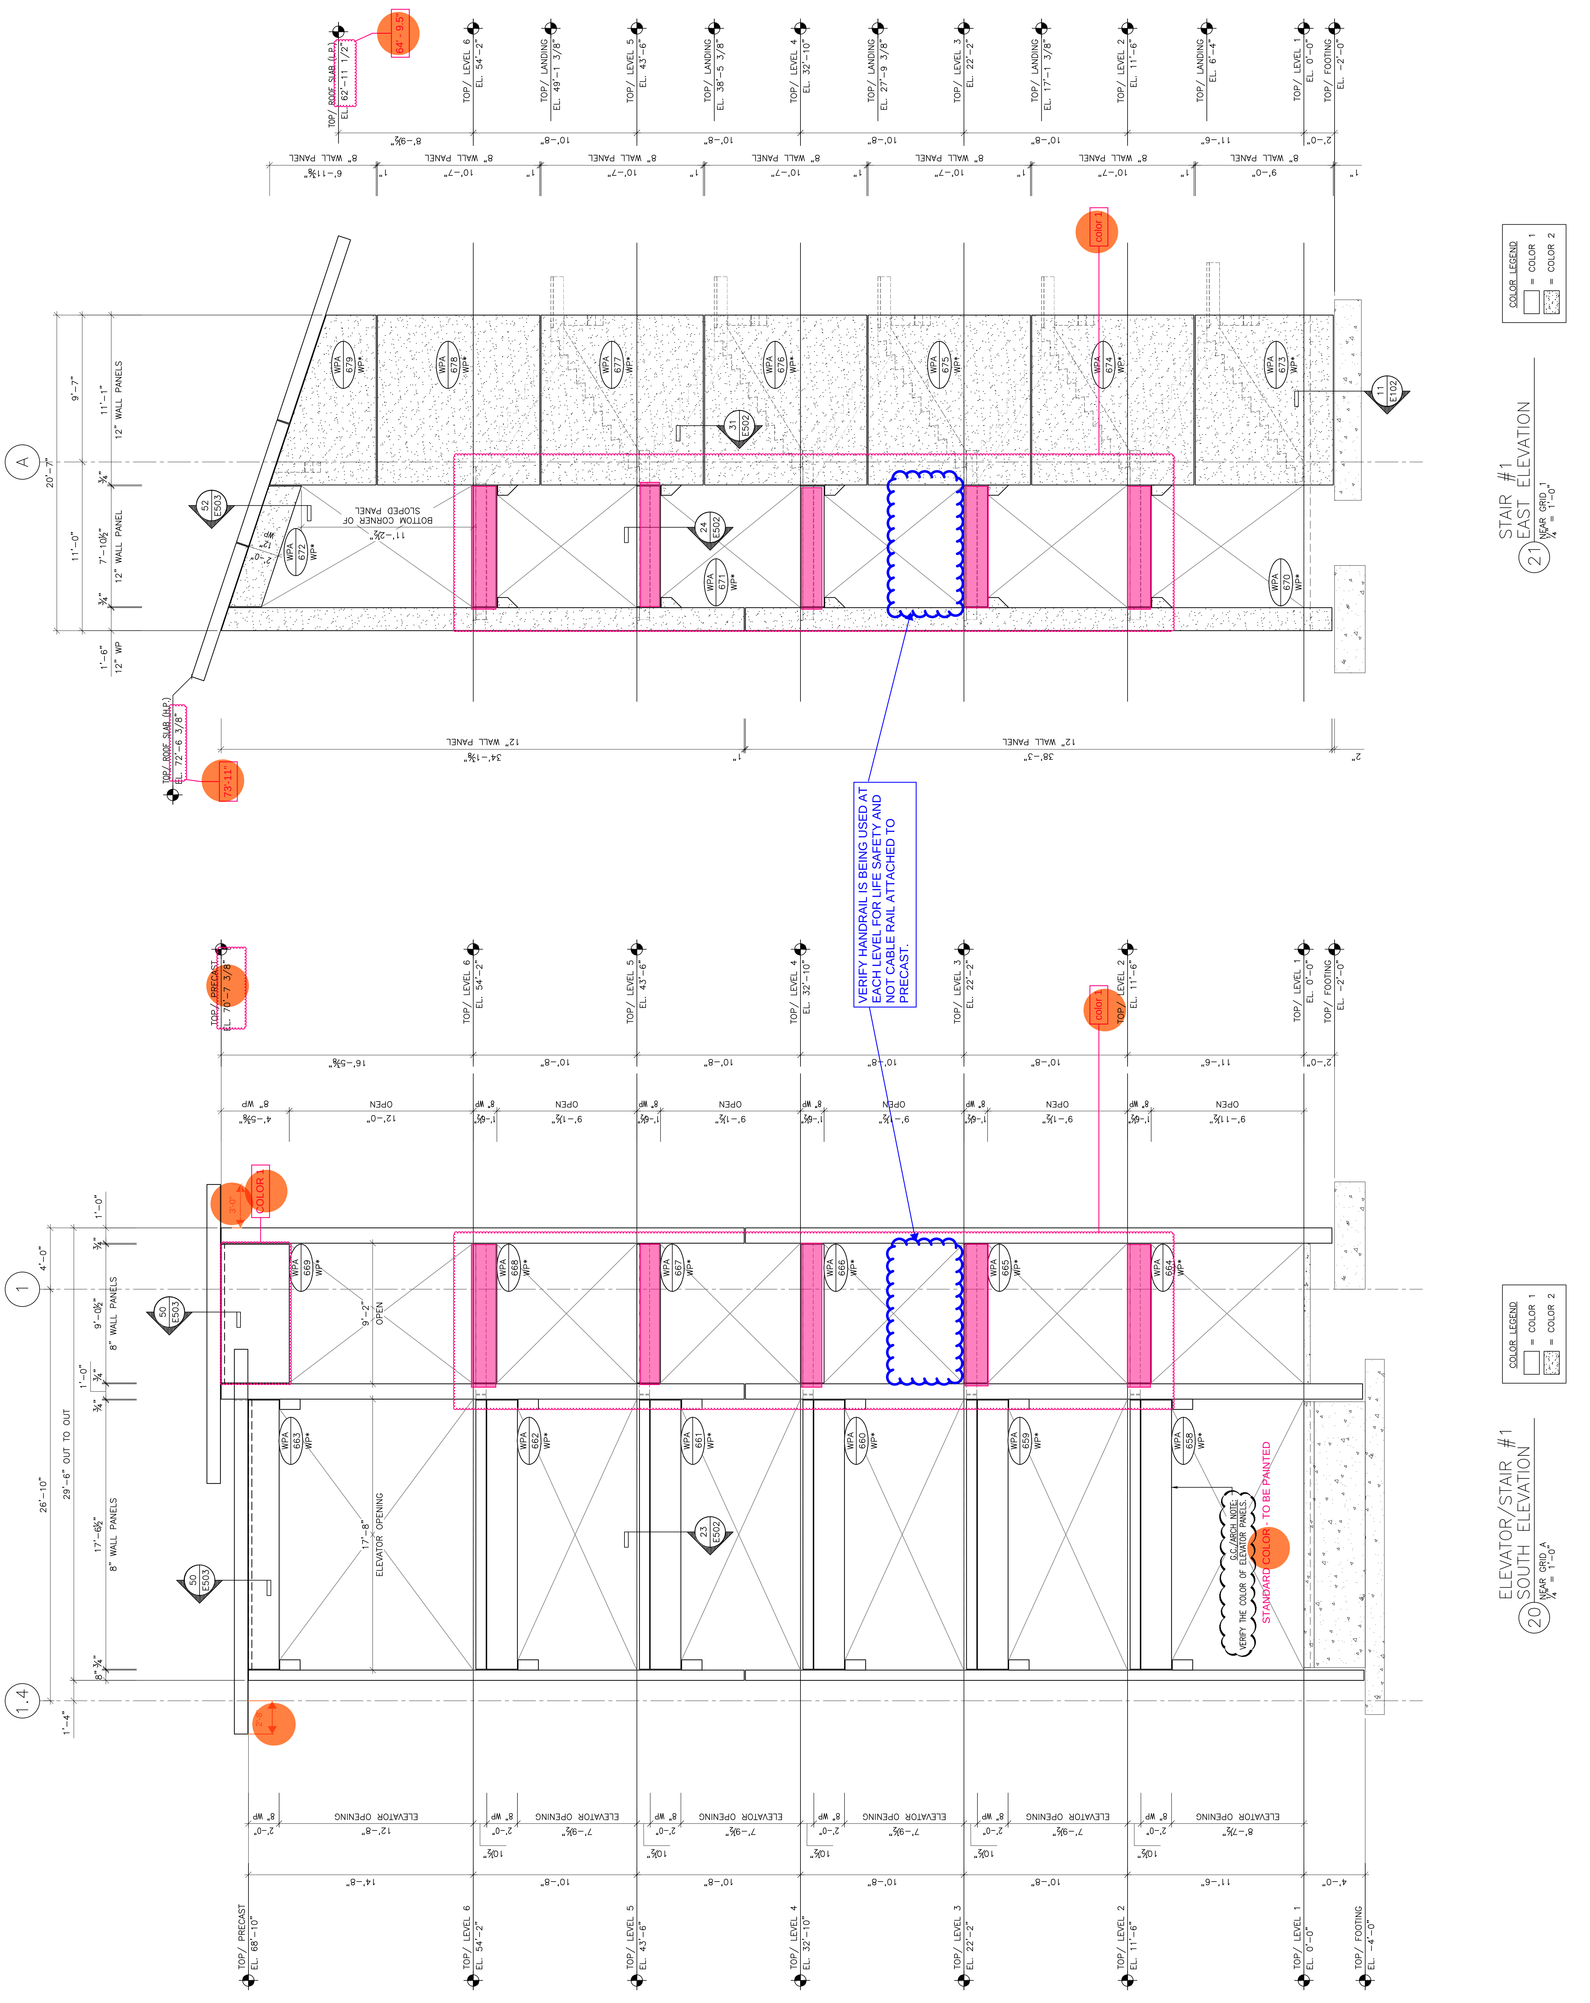

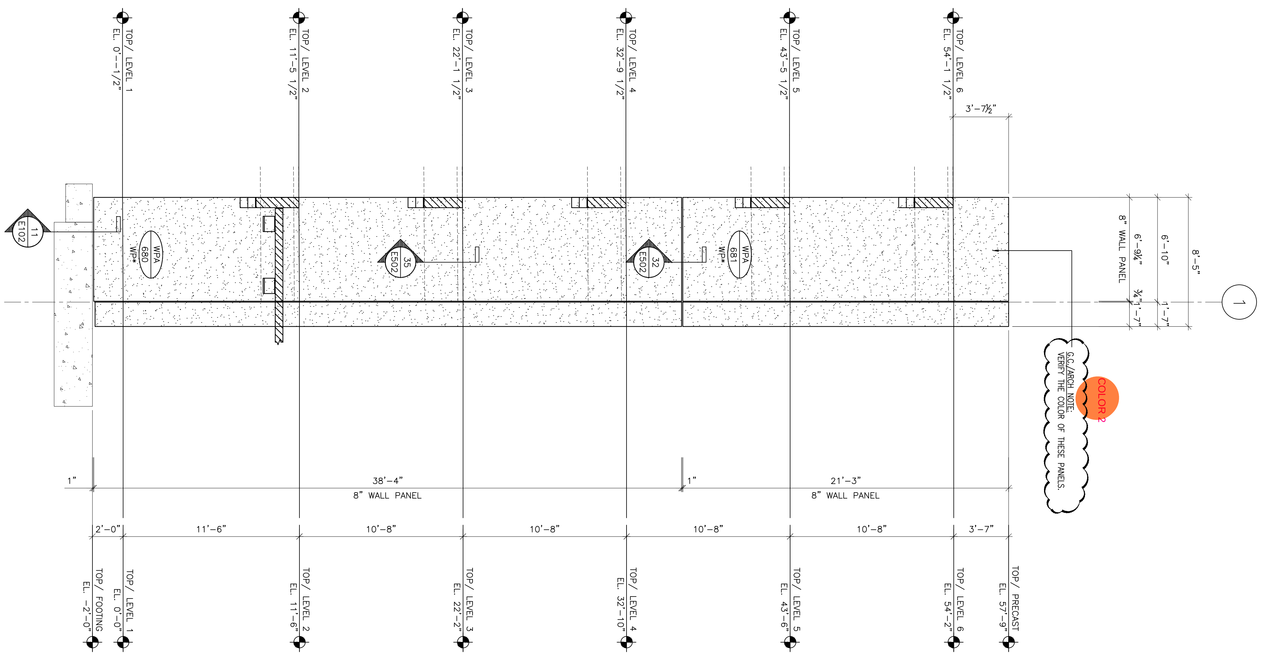

STAIR #1 SOUTH ELEVATION

22 ALONG GRID A-4

1/4" = 1'-0"

COLOR LEGEND
= COLOR 1
= COLOR 2

Proprietary Note: This document contains information which may be confidential and proprietary to Metromont Corporation and shall not be reproduced or transferred to other documents, disclosed to others or used for any purpose other than that which it was obtained without the prior written authorization from Metromont Corporation.

DRAWING NUMBER E4.07

JOB NUMBER 20979

METROMONT™
20 TWO NOTCH ROAD
GREENVILLE, SOUTH CAROLINA 29605
(864) 295-0295

DRAWING COVERS	STAIR #1 ELEVATIONS
PROJECT	HCA FLORIDA ST. LUCIE HOSPITAL PD
LOCATION	PORT ST. LUCIE, FL
ARCH. OR ENG.	TMPARTNERS, PLLC
CONTRACTOR	BRASFIELD & GORRIE, LLC
DRAWN BY: JCW	DATE: 06/26/2024 CHECKED BY: LKC DATE: 06/26/2024

Preliminary
07/12/2024 11:21:52 AM

DATE	BY	ISSUE	DESCRIPTION
*	JCW	1	**

DATE	BY	ISSUE	DESCRIPTION

DEVITA
ATLANTA • GREENVILLE • RICHMOND
877.4.DEVITA • corp@devitainc.com
DeVita & Associates, Inc. Project

CONTROL NUMBERS USED:
XXXX – XXXX
CONTROL NUMBERS NOT USED: XXXX – XXXX
CONTROL NUMBERS VOIDED: XXXX – XXXX

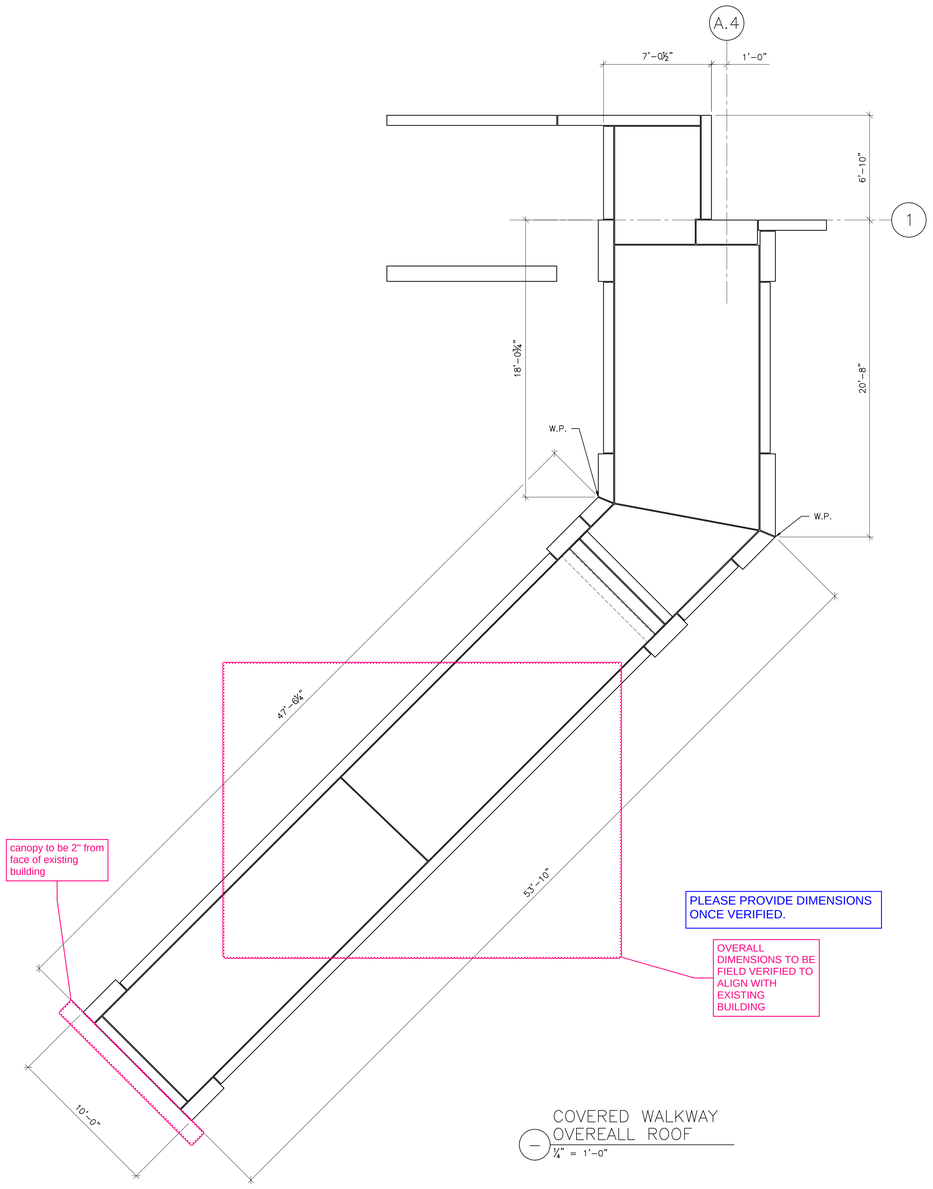

COVERED WALKWAY
OVEREALL ROOF
¼" = 1'-0"

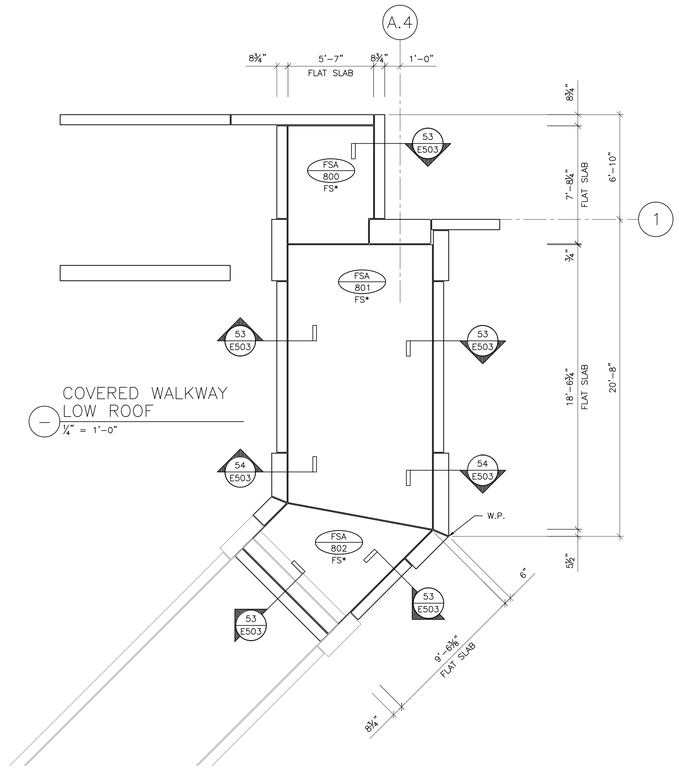

COVERED WALKWAY
LOW ROOF
¼" = 1'-0"

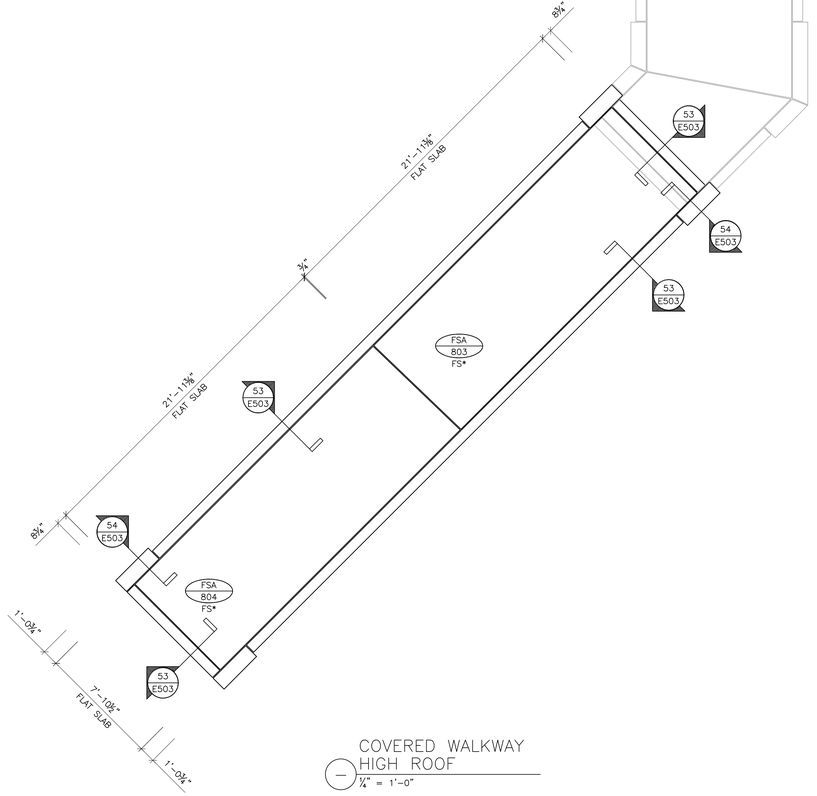

COVERED WALKWAY
HIGH ROOF
¼" = 1'-0"

CONTROL NUMBERS USED: 800 – 804

CONTROL NUMBERS NOT USED: XXXX – XXXX

CONTROL NUMBERS VOIDED: XXXX – XXXX

MARK NUMBER / CONTROL NUMBER

DEVITA
ATLANTA • GREENVILLE • RICHMOND
877.4.DEVITA • corp@devitainc.com
devita & associates, inc. / report

*	DATE	BY	ISSUE	DESCRIPTION
**	07/12/2024	JCW	1	Preliminary

Proprietary Note: This document contains information which may be confidential and proprietary to Metromont Corporation and shall not be reproduced or transferred to other documents, disclosed to others or used for any purpose other than that which it was obtained without the prior written authorization from Metromont Corporation.

DRAWING COVERS: COVERED WALKWAY PLANS
PROJECT: HCA FLORIDA ST. LUCIE HOSPITAL PD
LOCATION: PORT ST. LUCIE, FL
ARCH. OR ENG.: TMPARTNERS, PLLC
CONTRACTOR: BRASFIELD & GORRIE, LLC
DRAWN BY: JCW DATE: 06/26/2024 CHECKED BY: LKC DATE: 06/26/2024

METROMONT
20 TWO NOTCH ROAD
GREENVILLE, SOUTH CAROLINA 29605
(864) 295-0295

JOB NUMBER
20979

DRAWING NUMBER
E4.08

PLEASE CLARIFY WHAT A "SMALL TEXTURE" MEANS SO THIS CAN BE DISCUSSED WITH METROMONT.

panels to have small texture

field verify

12'-8" ADJUST

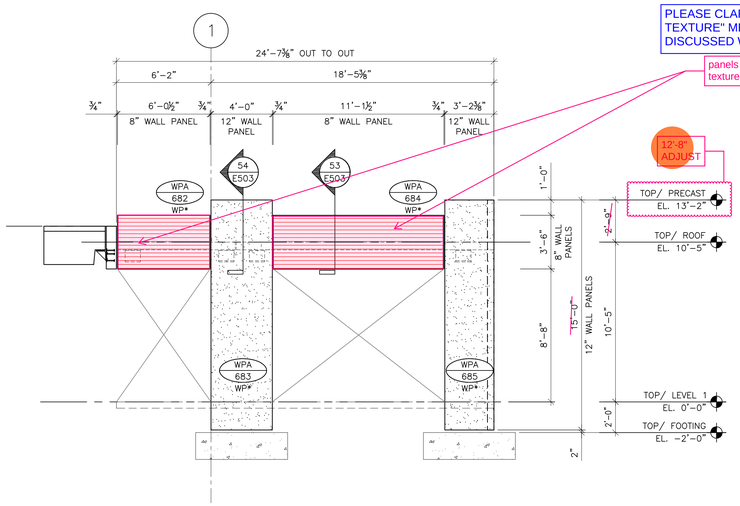

23 COVERED WALKWAY SOUTH ELEVATION
NEAR GRID A
¼" = 1'-0"

COLOR LEGEND
= COLOR 1
= COLOR 2

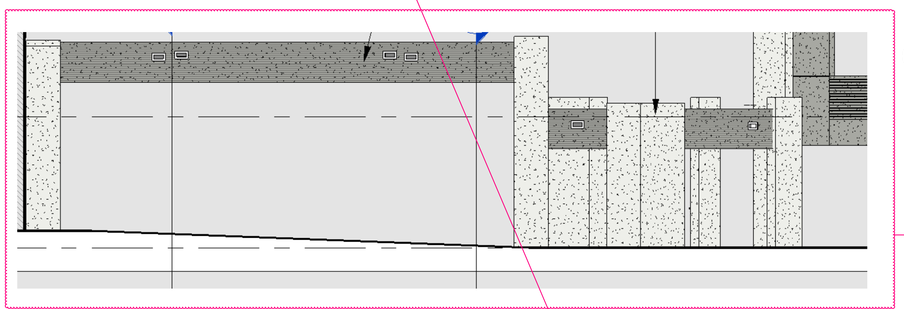

SCUPPERS TO BE LOCATED IN PRECAST WALLS

PLEASE PROVIDE SIZE AND LOCATION OF SCUPPERS.
DD DRAWINGS ON FILE AND LATEST MODEL RECEIVE DOES NOT MATCH THIS MARK UP.

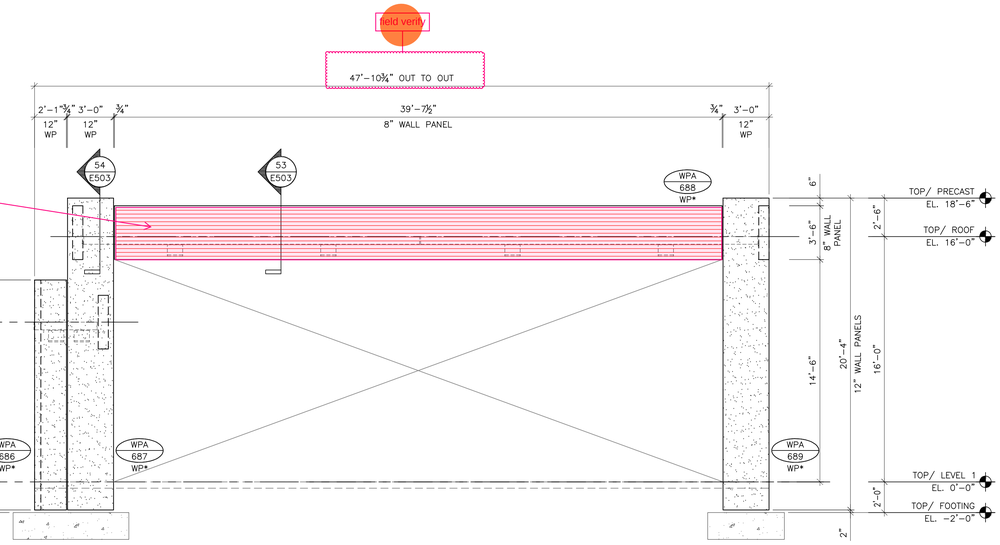

24 COVERED WALKWAY SOUTHEAST ELEVATION
NEAR GRID A
¼" = 1'-0"

COLOR LEGEND
= COLOR 1
= COLOR 2

scuppers

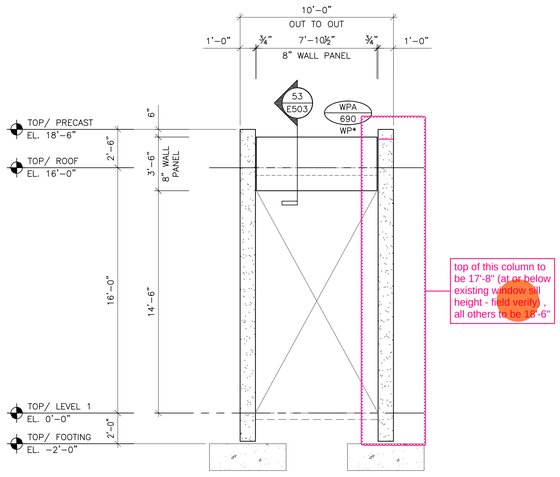

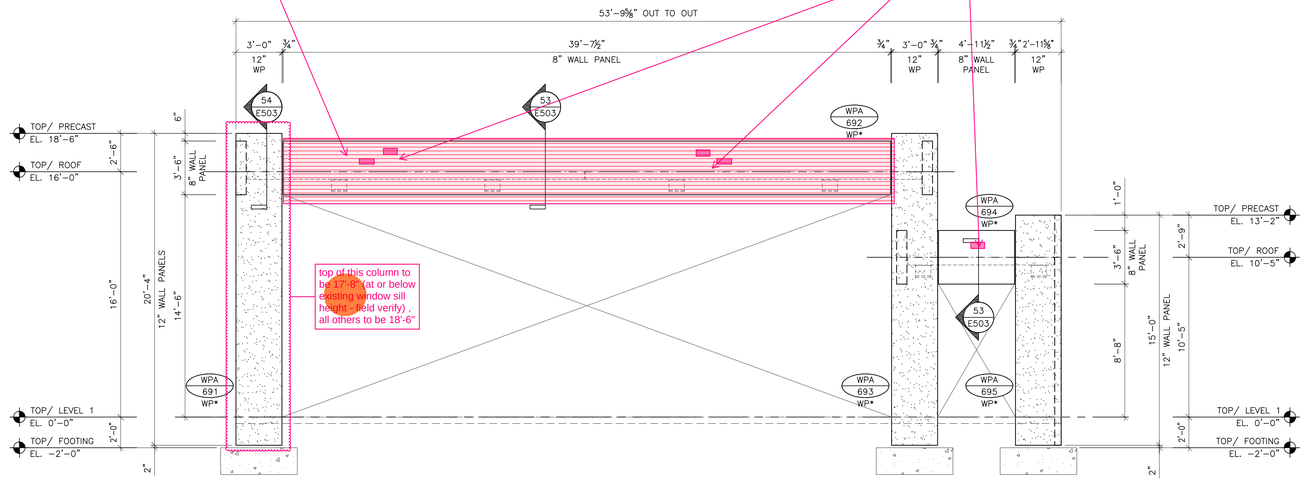

25 COVERED WALKWAY EAST ELEVATION
¼" = 1'-0"

COLOR LEGEND
= COLOR 1
= COLOR 2

26 COVERED WALKWAY NORTHEAST ELEVATION
NEAR GRID A
¼" = 1'-0"

COLOR LEGEND
= COLOR 1
= COLOR 2

CONTROL NUMBERS USED: 682 – 695
CONTROL NUMBERS NOT USED: XXXX – XXXX
CONTROL NUMBERS VOIDED: XXXX – XXXX
MARK NUMBER / CONTROL NUMBER

DEVITA
ATLANTA • GREENVILLE • RICHMOND
877.4.DEVITA • corp@devitainc.com
devita & associates, inc. / mep+i

*	DATE	BY	ISSUE
1	**	JCW	DESCRIPTION

Preliminary
07/12/2024 11:21:52 AM

DRAWING COVERS	COVERED WALKWAY ELEVATIONS
PROJECT	HCA FLORIDA ST. LUCIE HOSPITAL PD
LOCATION	PORT ST. LUCIE, FL
ARCH. OR ENG.	TMPARTNERS, PLLC
CONTRACTOR	BRASFIELD & GORRIE, LLC
DRAWN BY:	JCW DATE: 06/26/2024
CHECKED BY:	LKC DATE: 06/26/2024

METROMONT
20 TWO NOTCH ROAD
GREENVILLE, SOUTH CAROLINA 29605
(864) 295-0295

JOB NUMBER
20979

DRAWING NUMBER
E4.09

Proprietary Note: This document contains information which may be confidential and proprietary to Metromont Corporation and shall not be reproduced or transferred to other documents, disclosed to others or used for any purpose other than that which it was obtained without the prior written authorization from Metromont Corporation.

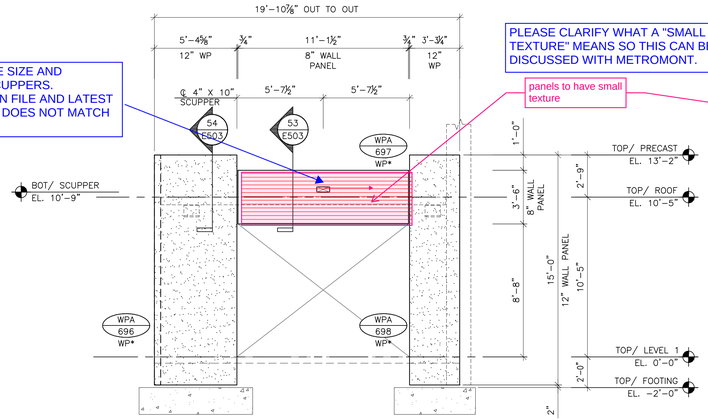

PLEASE PROVIDE SIZE AND LOCATION OF SCUPPERS. DD DRAWINGS ON FILE AND LATEST MODEL RECEIVE DOES NOT MATCH THIS MARK UP.

PLEASE CLARIFY WHAT A "SMALL TEXTURE" MEANS SO THIS CAN BE DISCUSSED WITH METROMONT.

panels to have small texture

27 COVERED WALKWAY NORTH ELEVATION
NEAR GRID A.4
¼" = 1'-0"

COLOR LEGEND
= COLOR 1
= COLOR 2

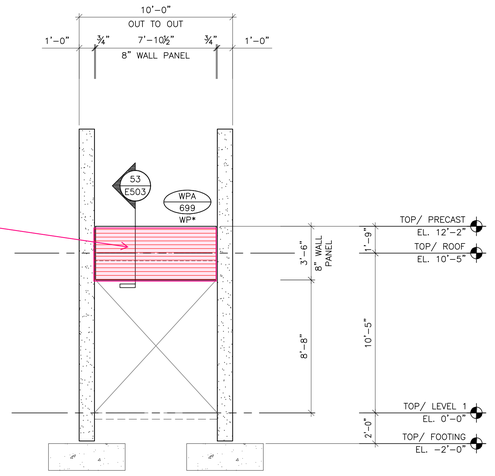

28 COVERED WALKWAY EAST ELEVATION
¼" = 1'-0"

COLOR LEGEND
= COLOR 1
= COLOR 2

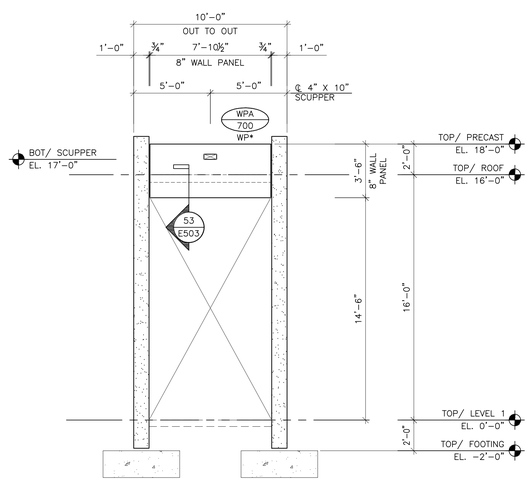

29 COVERED WALKWAY WEST ELEVATION
¼" = 1'-0"

COLOR LEGEND
= COLOR 1
= COLOR 2

CONTROL NUMBERS USED: 696 – 700

CONTROL NUMBERS NOT USED: XXXX – XXXX

CONTROL NUMBERS VOIDED: XXXX – XXXX

MARK NUMBER / CONTROL NUMBER

DEVITA
ATLANTA • GREENVILLE • RICHMOND
877.4.DEVITA • corp@devitainc.com
devita & associates, inc. / mepe1

*	BY	DATE	DESCRIPTION
**	JCW	07/12/2024	Preliminary
1	JCW	07/12/2024	11:21:52 AM

Proprietary Note: This document contains information which may be confidential and proprietary to Metromont Corporation and shall not be reproduced or transferred to other documents, disclosed to others or used for any purpose other than that which it was obtained without the prior written authorization from Metromont Corporation.

METROMONT
20 TWO NOTCH ROAD
GREENVILLE, SOUTH CAROLINA 29605
(864) 295-0295

DRAWING COVERS	COVERED WALKWAY ELEVATIONS
PROJECT	HCA FLORIDA ST. LUCIE HOSPITAL PD
LOCATION	PORT ST. LUCIE, FL
ARCH. OR ENG.	TMPARTNERS, PLLC
CONTRACTOR	BRASFIELD & GORRIE, LLC
DRAWN BY: JCW	DATE: 06/26/2024
CHECKED BY: LKC	DATE: 06/26/2024

JOB NUMBER
20979

DRAWING NUMBER
E4.10

Proprietary Note: This document contains information which may be confidential and proprietary to Metromont Corporation and shall not be reproduced or transferred to other documents, disclosed to others or used for any purpose other than that which it was obtained without the prior written authorization from Metromont Corporation.

DRAWING COVERS: SECTIONS & DETAILS
PROJECT: HCA FLORIDA ST. LUCIE HOSPITAL PD
LOCATION: PORT ST. LUCIE, FL
ARCH. OR ENG.: TMPARTNERS, PLLC
CONTRACTOR: BRASFIELD & GORRIE, LLC
DRAWN BY: JCW DATE: 06/17/2024 CHECKED BY: LKC DATE: 06/17/2024

METROMONT
20 TWO NOTCH ROAD
GREENVILLE, SOUTH CAROLINA 29605
(864) 295-0295

JOB NUMBER 20979
DRAWING NUMBER E5.01

DATE	BY	ISSUE	DESCRIPTION
*	JCW	1	Preliminary 07/12/2024 11:21:53 AM
**			

DATE	BY	ISSUE	DESCRIPTION

DEVITA
ATLANTA • GREENVILLE • RICHMOND
877.4.DEVITA • corp@devitallc.com
Devita & Associates, Inc. Project

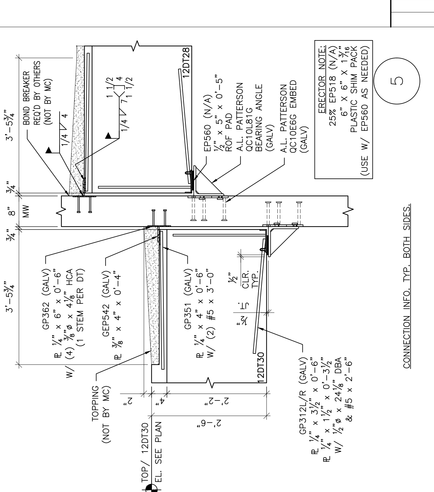

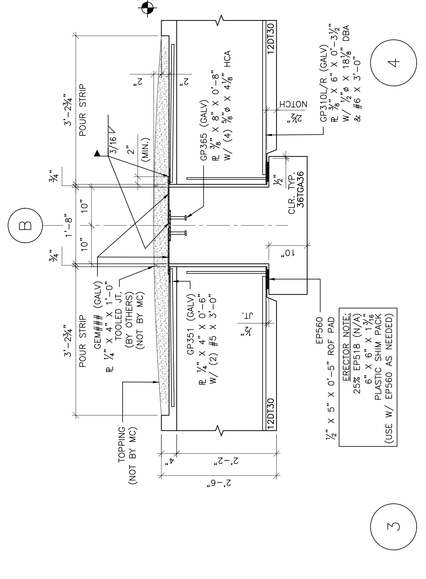

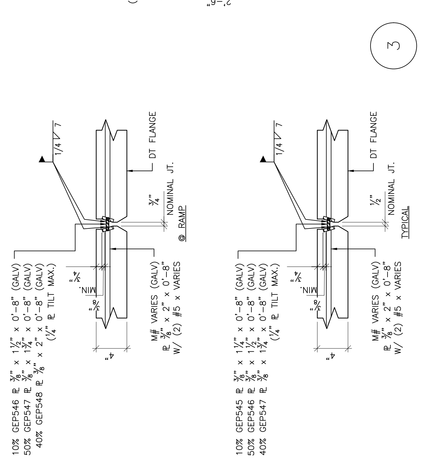

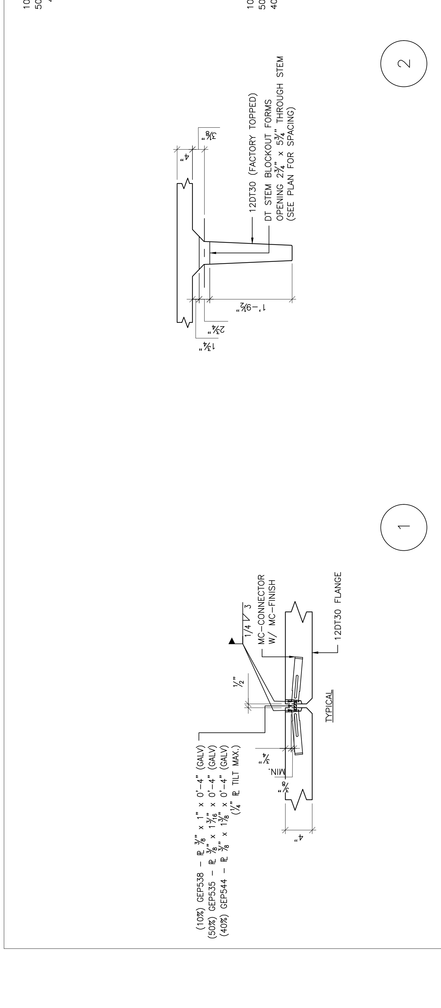

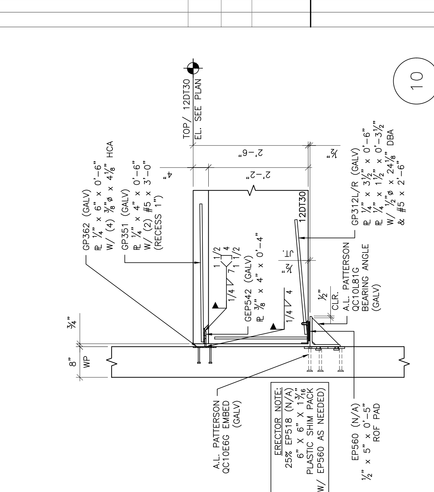

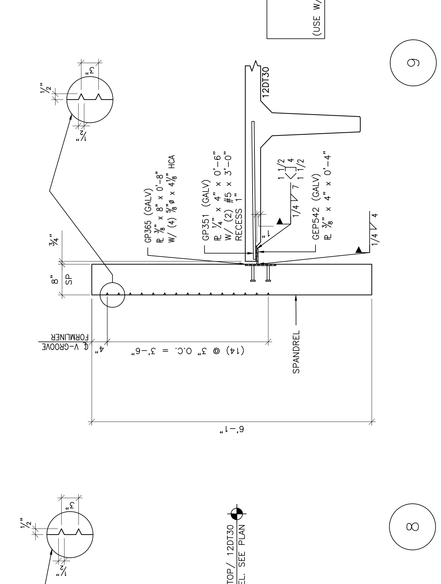

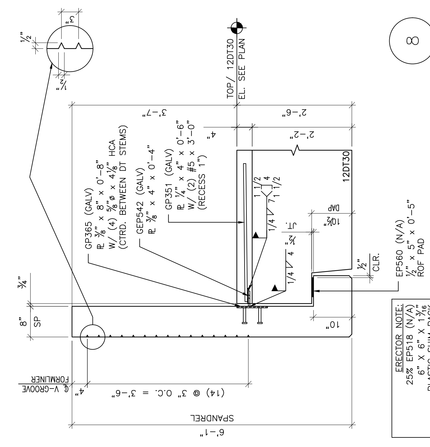

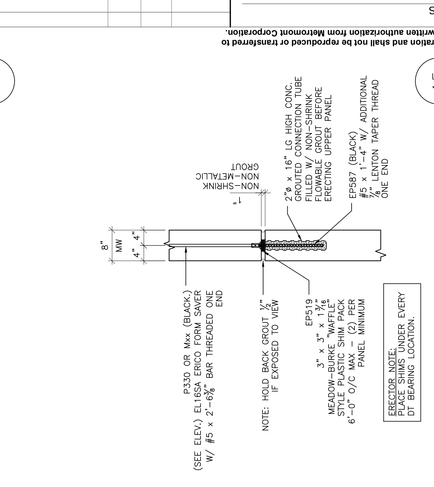

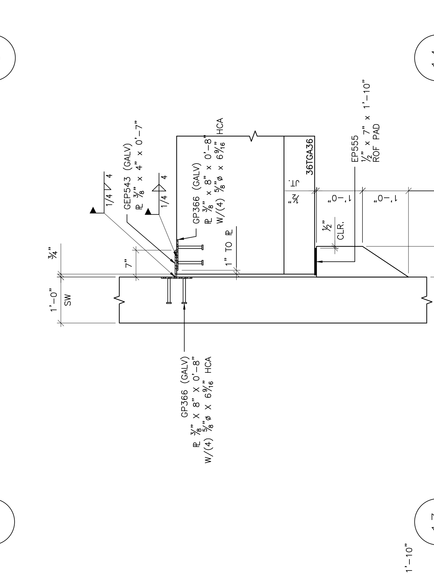

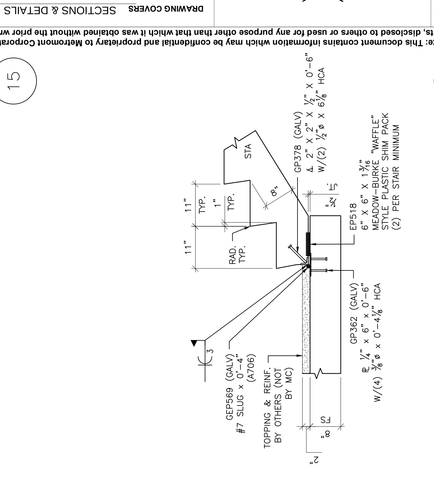

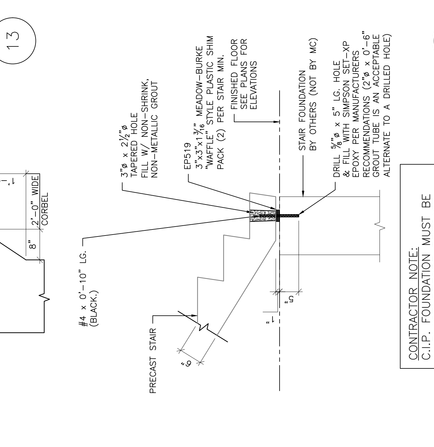

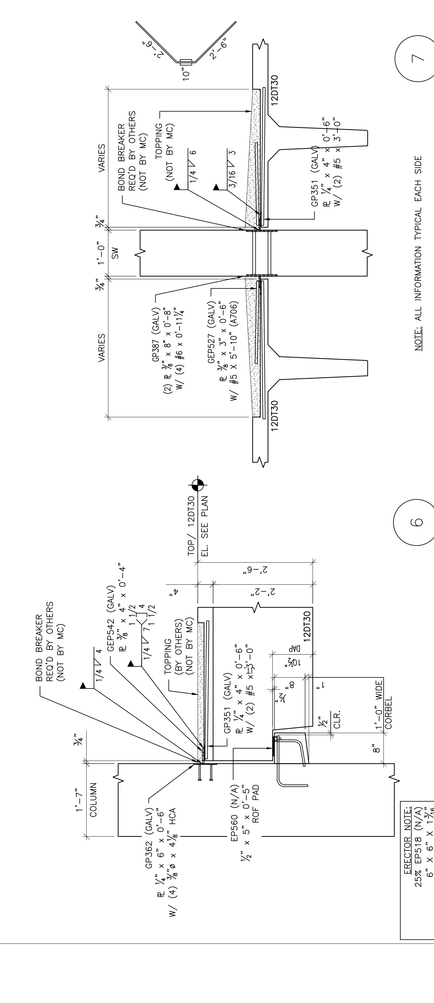

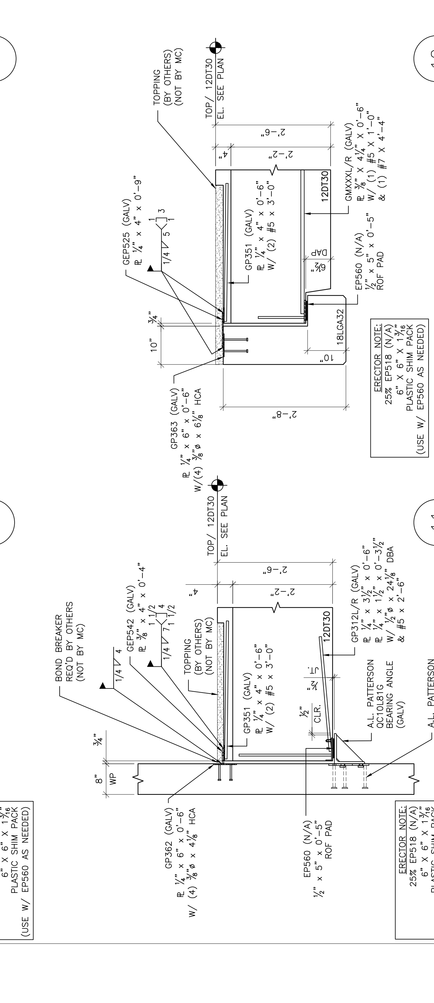

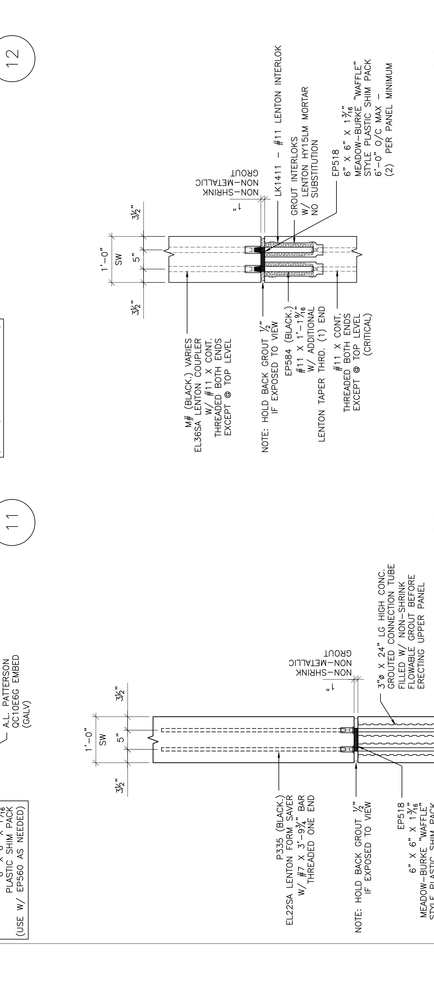

Proprietary Note: This document contains information which may be confidential and proprietary to Metromont Corporation and shall not be reproduced or transferred to other documents, disclosed to others or used for any purpose other than that which it was obtained without the prior written authorization from Metromont Corporation.

METROMONT
20 TWO NOTCH ROAD
GREENVILLE, SOUTH CAROLINA 29605
(864) 295-0295

JOB NUMBER 20979

DRAWING NUMBER E5.02

DRAWING COVERS	SECTIONS & DETAILS
PROJECT	HCA FLORIDA ST. LUCIE HOSPITAL PD
LOCATION	PORT ST. LUCIE, FL
ARCH. OR ENG.	TMPARTNERS, PLLC
CONTRACTOR	BRASFIELD & GORRIE, LLC
DRAWN BY: JCW	DATE: 06/17/2024 CHECKED BY: LKC DATE: 06/17/2024

Preliminary
07/12/2024 11:21:53 AM

DATE	BY	ISSUE	DESCRIPTION
*	JCW	1	**

DATE	BY	ISSUE	DESCRIPTION

DEVITA
ATLANTA • GREENVILLE • RICHMOND
877.4.DEVITA • corp@devitainc.com
Devita & Associates, Inc. Project :

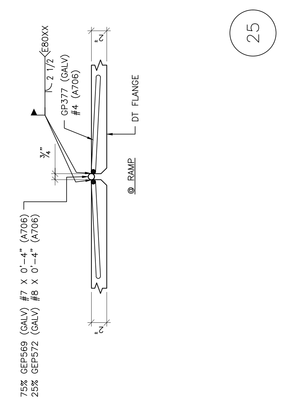

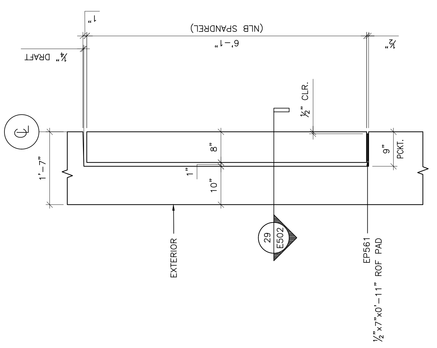

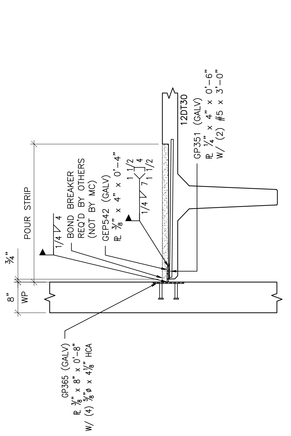

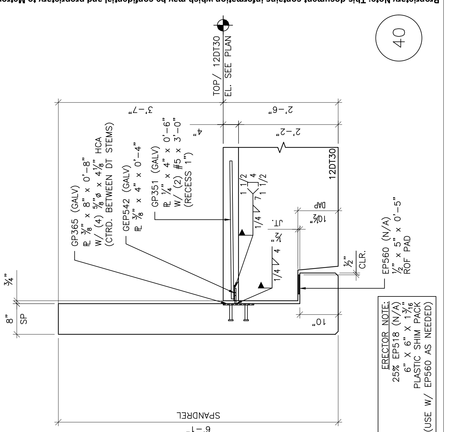

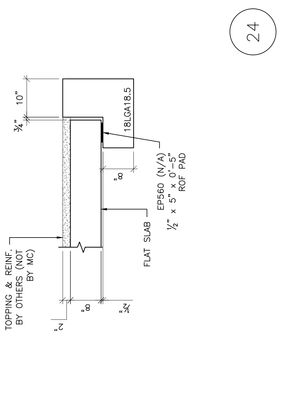

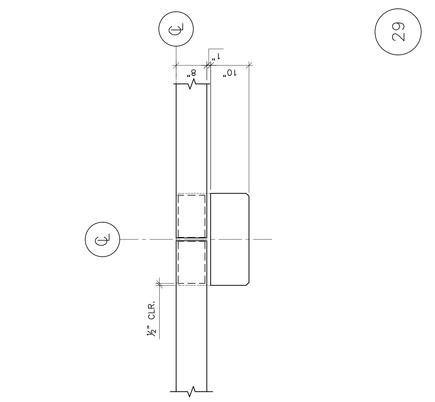
℄
1'-7"
1"
10"
8"
1/2" CLR.
29
E502
29

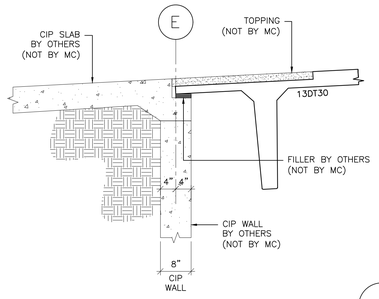

41

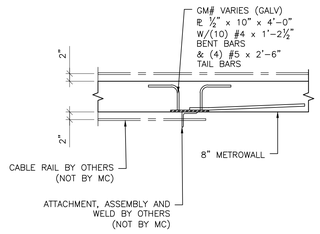

42

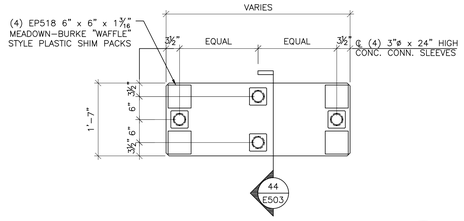

43

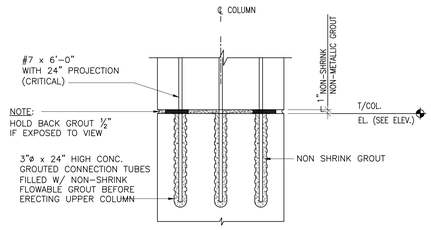

44

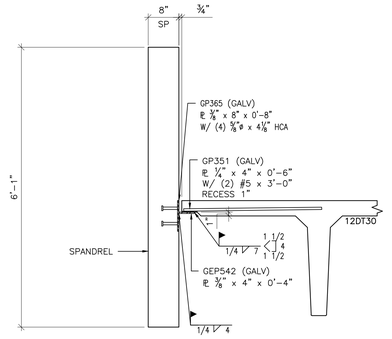

45

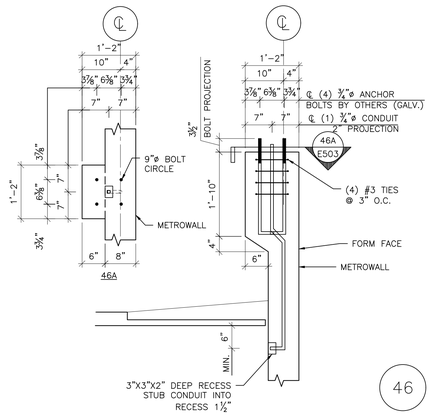

46

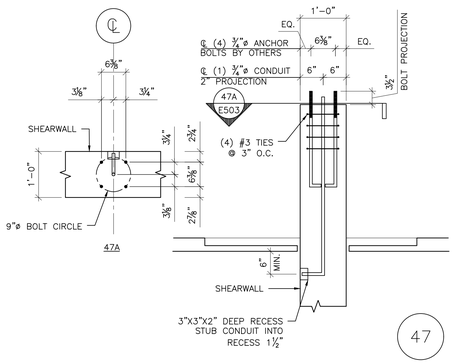

47

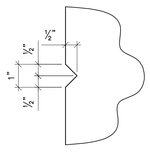

REVEAL PROFILE

48

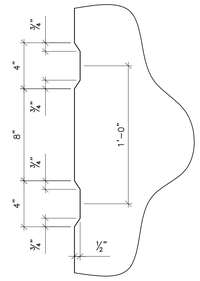

REVEAL PROFILE

49

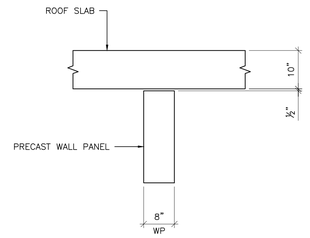

50

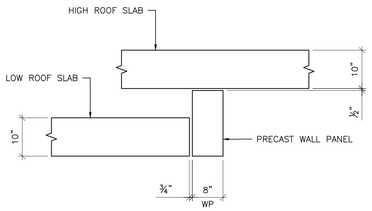

51

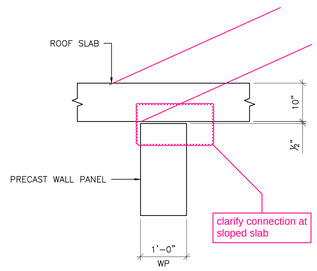

THIS CONNECTION IS NOT
CURRENTLY DESIGNED.

52

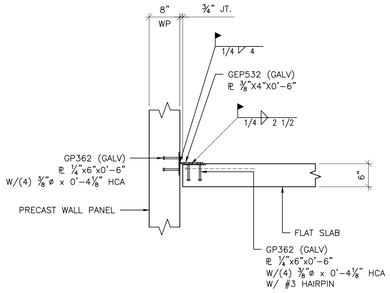

53

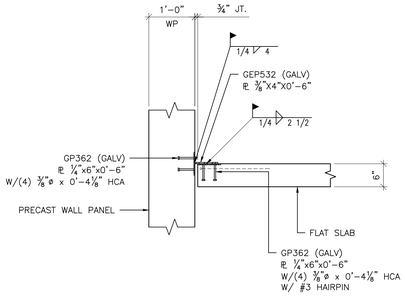

54

55

56

57

58

59

60

503

DEVITA
ATLANTA • GREENVILLE • RICHMOND
877.4.DEVITA • corp@devitainc.com
devita & associates, inc. / mepec

	DESCRIPTION	DATE	BY	ISSUE
*			JCW	1
**		07/12/2024		

Preliminary
07/12/2024 11:21:53 AM

DRAWING COVERS	SECTIONS & DETAILS
PROJECT	HCA FLORIDA ST. LUCIE HOSPITAL PD
LOCATION	PORT ST. LUCIE, FL
ARCH. OR ENG.	TMPARTNERS, PLLC
CONTRACTOR	BRASFIELD & GORRIE, LLC
DRAWN BY: JCW	DATE: 06/17/2024
CHECKED BY: LKC	DATE: 06/17/2024

METROMONT
20 TWO NOTCH ROAD
GREENVILLE, SOUTH CAROLINA 29605
(864) 295-0295

JOB NUMBER
20979

DRAWING NUMBER
E5.01

Proprietary Note: This document contains information which may be confidential and proprietary to Metromont Corporation and shall not be reproduced or transferred to other documents, disclosed to others or used for any purpose other than that which it was obtained without the prior written authorization from Metromont Corporation.