INDIAN RIVER COUNTY FIRE / EMS

STATION #15

9010 87th St
Vero Beach, FL 32967

INDEX TO DRAWINGS

ARCHITECTURAL

ABB	ABBREVIATIONS / GENERAL NOTES
ACC	ACCESSIBILITY DETAILS
A-1	PROPOSED SITE PLAN AND DETAILS
A-1A	SITE DETAILS
A-2	1/8" BUILDING PLAN
A-3	1/4" PARTIAL FLOOR PLAN AND WALL LEGEND
A-4	1/4" PARTIAL FLOOR PLAN AND WALL LEGEND
A-5	1/8" ELEVATIONS AND PAINT SCHEDULE
A-6	1/8" ELEVATIONS
A-7	ROOF PLAN AT 1/8" SCALE AND DETAILS
A-8	REFLECTED CEILING PLAN, LEGEND AND TILE SCHEDULE
A-9	SECTIONS AND DETAILS
A-10	SECTIONS AND DETAILS
A-11	DOOR, WINDOW AND FINISH SCHEDULES
A-12	INTERIOR ELEVATIONS AND DETAILS
A-13	DETAILS
A-14	DETAILS

INTERIOR

I-1	INTERIORS PLAN AND MATERIALS SCHEDULE

LIFE SAFETY

LS-1	LIFE SAFETY PLAN AND CODE DATA
~~LS-2~~	~~LIFE SAFETY DETAILS~~ DELETED (1)

STRUCTURAL

S-1.1	GENERAL STRUCTURAL NOTES
S-1.2	WIND DESIGN DATA AND LOAD SCHEDULE
S-1.3	WIND DESIGN DATA AND LOAD SCHEDULE
S-2.1	FOUNDATION - OVERALL PLAN
S-2.1A	FOUNDATION PLAN - AREA A
S-2.1B	FOUNDATION PLAN - AREA B
S-2.1C	FOUNDATION PLAN - AREA C
S-2.2	SLAB ON GRADE - OVERALL PLAN
S-2.2A	SLAB ON GRADE - AREA A
S-2.2B	SLAB ON GRADE - AREA B
S-2.2C	SLAB ON GRADE - AREA C
S-2.3	ROOF PLAN - OVERALL
S-2.3A	ROOF PLAN - AREA A
S-2.3B	ROOF PLAN - AREA B
S-2.3C	ROOF PLAN - AREA C
S-2.4	DUMPSTER PLAN AND SECTION

(2)

STRUCTURAL (CONTINUED)

S-3.1	TYPICAL DETAILS
S-3.2	TYPICAL DETAILS
S-3.3	TYPICAL DETAILS
S-3.4	TYPICAL DETAILS
S-4.1	SECTIONS AND DETAILS
S-4.2	SECTIONS AND DETAILS
S-4.3	SECTIONS AND DETAILS
S-4.4	SECTIONS AND DETAILS
S-4.5	SECTIONS AND DETAILS
S-5.1	ELEVATIONS
S-5.2	ELEVATIONS
S-5.3	ELEVATIONS
S-5.4	ELEVATIONS
S-5.5	ELEVATIONS
S-6.1	SCHEDULE

MECHANICAL

M-0	HVAC - GENERAL NOTES LEGEND AND AIR BALANCE
M1-0	BUILDING PLAN - HVAC
M1-A	MECHANICAL ROOM PLANS
M2-0	HVAC DETAILS
M3-0	HVAC DETAILS
M4-0	HVAC SCHEDULES
M5-0	HVAC CONTROLS
M6-0	KITCHEN EQUIPMENT PLANS - HVAC
M7-0	KITCHEN EQUIPMENT PLANS - HVAC

ELECTRICAL

E-0	ELECTRICAL - SYMBOLS LEGEND, SCHEDULE AND NOTES
E0-1	SITE PLAN - ELECTRICAL
E0-1A	SITE PLAN PHOTOMETRICS
E1-0	BUILDING PLAN - LIGHTING
E2-0	BUILDING PLAN - POWER
E4-0	PANEL SCHEDULES - ELECTRICAL
E5-0	ELECTRICAL DETAILS
E6-0	ELECTRICAL DETAILS
E7-0	ELECTRICAL DETAILS

PLUMBING

P-0	PLUMBING - FIXTURE SCHEDULE, DETAILS AND NOTES
P1-0	BUILDING PLAN - PLUMBING
P2-0	SANITARY RISER DIAGRAM
P3-0	DOMESTIC WATER DIAGRAM
P4-0	GAS RISER DIAGRAM
P5-0	PLUMBING DETAILS
P6-0	PLUMBING DETAILS
P7-0	PLUMBING DETAILS
P8-0	PLUMBING SCHEDULES

CIVIL

C1	COVER SHEET
C2	GENERAL NOTES
C3	EXISTING CONDITIONS
C4	EROSION CONTROL PLAN
C5	DEMOLITION PLAN
C6	OVERALL SITE PLAN
C7	SITE PLAN
C8	PAVING, GRADING AND DRAINAGE PLAN
C9	SITE CROSS SECTIONS
C10	UTILITY PLAN
C11	PRIVATE LIFT STATION DETAILS
C12	GENERAL DETAILS
C13	EROSION CONTROL DETAILS
C14	FIRE DEPARTMENT PLAN
LA-1	OVERALL LANDSCAPE PLAN & LANDSCAPE DATA
LA-2	DETAIL LANDSCAPE PLAN
LA-3	TREE DISPOSITION PLAN
LA-4	LANDSCAPE DETAILS AND SPECS
IRR-1	IRRIGATION PLAN
IRR-2	IRRIGATION DETAILS

ARCHITECT

EDLUND · DRITENBAS · BINKLEY
ARCHITECTS AND ASSOCIATES, P.A.
65 Royal Palm Pointe, Suite D, Vero Beach, Florida 32960
Phone: (772) 569-4320 AR# AAC000886

MECHANICAL / ELECTRICAL

OCI ASSOCIATES, INC.
CONSULTING ENGINEERS
Ft. Pierce • West Palm Beach • Ft. Myers • Tampa • Washington D.C. Orlando
427 Centerpointe Circle, Suite 1825
Altamonte Springs, FL 32701
(407) 332-5110 Fax: (407) 332-7704
www.ociassociates.com
CERTIFICATE OF AUTHORIZATION #6261

CIVIL ENGINEER

MBV ENGINEERING, INC.
CONSULTING ENGINEERING
MOIA BOWLES VILLAMIZAR & ASSOCIATES
CONSULTING ENGINEERS – CA #3728
2455 – 14TH AVENUE VERO BEACH, FLORIDA 32960
PHONE (772) 569-0035
FAX (772) 778-3617

STRUCTURAL ENGINEER

MASTER CONSULTING ENGINEERS, INC.
5523 WEST CYPRESS ST., #200
TAMPA, FLORIDA 33607
813.287.3600 FAX 813.287.3622
www.mcengineers.com EB: 8426

BID SET

EDLUND · DRITENBAS · BINKLEY
ARCHITECTS AND ASSOCIATES, P.A.
AR-AA C000886
65 ROYAL PALM POINTE, SUITE "D"
VERO BEACH, FLORIDA 32960
PHONE: (772) 569-4320

SEAL:

PROJECT: STATION #15
FOR: INDIAN RIVER COUNTY FIRE RESCUE/EMS
9010 87TH ST
VERO BEACH, FL 32967

NO:	DATE	REVISIONS
1	6/23/2026	ADDENDUM REVISIONS
2	11/20/2025	BLDG DEPT REVISIONS

© JULY '25, THESE PLANS AND THE INFORMATION SHOWN HEREIN ARE THE PROPERTY OF EDLUND DRITENBAS BINKLEY ARCHITECTS, P.A. AND REPRODUCTIONS, DISCLOSURES OR USE THEREOF IN WHOLE OR IN PART IS EXPRESSLY PROHIBITED WITHOUT WRITTEN PERMISSION.

COMM. NO: 070424VB
DATE: JULY 2, 2025
BY: LJD
CH'KD: JPB


SHEET NO.
COVER
OF ONE

GENERAL NOTES


1. THE CONTRACTOR IS TO VERIFY ALL DIMENSIONS SHOWN ON THE CONSTRUCTION DOCUMENTS AND EXISTING CONDITIONS IN THE FIELD. ANY DISCREPANCIES IN THE ABOVE WILL CONSTITUTE A "STOP WORK" ORDER FOR THAT PORTION OF THE CONSTRUCTION ONLY. THE ARCHITECT IS TO BE NOTIFIED IMMEDIATELY FOR RESOLUTION.
2. EVERY ATTEMPT HAS BEEN MADE TO DELINEATE THE EXISTING CONDITIONS AND DETAILS, THE CONTRACTOR MUST VISIT THE SITE TO VISUALLY ESTABLISH THE COMPLETE SCOPE OF WORK AND CONDITIONS TO BE CONSTRUCTED.
3. THE GENERAL CONDITIONS OF THE CONTRACT FOR CONSTRUCTION SHALL BE AIA DOCUMENT A 201, 2007 EDITION, A COPY OF WHICH IS AVAILABLE FOR REVIEW AT THE ARCHITECTS OFFICE.
4. THE CONTRACTOR SHALL WARRANT AND GUARANTEE ALL MATERIALS AND WORKMANSHIP FOR A PERIOD OF 1 (ONE) YEAR FROM THE "DATE OF SUBSTANTIAL COMPLETION".
5. THE CONTRACTOR IS TO SECURE AND PAY FOR ALL PERMITS AND SHALL SECURE THE "CERTIFICATE OF OCCUPANCY".
6. THE CONTRACTOR(S) SHALL PROVIDE AND MAINTAIN COMPLETE WORKERS COMPENSATION, GENERAL LIABILITY AND BUILDERS RISK INSURANCE.
7. ALL MATERIALS UTILIZED SHALL BE NEW AND OF THE QUALITY SPECIFIED, SUBSTITUTIONS WILL BE ALLOWED ONLY WITH THE ARCHITECT'S PRIOR WRITTEN APPROVAL.
8. THE CONTRACTOR SHALL COORDINATE ALL WORK WITH THE MANUFACTURER'S INSTRUCTIONS AND CATALOG CUTS.
9. PRIOR TO FINAL PAYMENT, THE CONTRACTOR SHALL ISSUE TO THE OWNER. AN EXECUTED "FINAL RELEASE OF LIEN" FORMS FROM ALL PARTIES HAVING LIEN RIGHTS AGAINST THE OWNER.
10. ALL WORK IS TO BE PERFORMED IN ACCORDANCE WITH "BEST TRADE PRACTICES" FOR THE GEOGRAPHIC AREA IN WHICH THE PROJECT IS LOCATED.
11. UNLESS WHERE NOTED OTHERWISE, THE CONTRACTOR SHALL PROVIDE ALL THE NECESSARY LABOR, MATERIALS, EQUIPMENT AND INCIDENTALS FOR A COMPLETE AND OPERATING PROJECT.

LEGEND


DETAIL SECTION

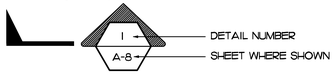

SECTIONS

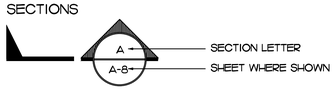

SPECIFIC DETAILS

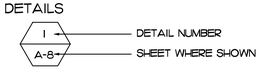

DETAIL TITLE
SCALE: NONE REF. WHERE CUT OCCURS 1 A-8

SECTION
SCALE: NONE REF. WHERE CUT OCCURS A A-8

M 1 MATCH LINE

MATCH LINE M 1

SYMBOL MARKS

DOORS, COLUMNS


FOOTINGS, TIE BEAMS

WINDOWS, WOOD LINTELS SPECIALTY

ROOM/SPACE IDENTIFICATION

101 ROOM/SPACE #

INTERIOR ELEVATIONS

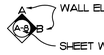

FINISH ELEVATIONS

FINISH FLOOR +0'-0" (ASSUMED ELEVATION OF FINISH FLOOR)
(ACTUAL ELEV. AS (N.G.V.D.) OR (N.A.V.D.)

REVISIONS

2 APPEARS ON DRAWING AS A CLOUDED REFERENCE, AT PLACE OF REVISION AND NOTED ON TITLE BLOCK REVISION COLUMN.

CONSTRUCTION ADMINISTRATION GUIDELINES

I. INSPECTION REQUIREMENTS
- A. BY ARCHITECT, PRIOR TO ALL CONCRETE POURS
- B. BEFORE COVERING WORK WITH DRYWALL AND PRIOR TO CEILING INSTALLATION: WHEN MECHANICAL, ELECTRICAL & PLUMBING ROUGH-INS ARE COMPLETED.
- C. TO ESTABLISH A PUNCH LIST (WHEN CONTRACTOR HAS TOTALLY COMPLETED HIS OWN ESTABLISHED PUNCH LIST AND AFTER CERTIFICATE OF OCCUPANCY.)
- D. AT FINAL INSPECTION, FOLLOWING COMPLETION OF PUNCH LIST.
- E. AT MONTHLY PAY REQUEST AND WEEKLY PROGRESS INSPECTIONS

NOTE: PROJECT SUPERINTENDENT SHOULD ALWAYS BE PRESENT AT INSPECTIONS

II. PAY REQUEST
- A. AS PER OWNER/ CONTRACTOR AGREEMENT UTILIZING AIA DOCUMENTS
- B. LIEN RELEASES REQUIRED (PARTIALS AND FINALS)
- C. FOR STORED MATERIALS - (CERTIFICATE OF INSURANCE REQUIRED)

III. OTHER REQUIREMENTS OF THE CONTRACTOR
- A. BAR GRAPH SCHEDULE OF PROGRESS TIME SCHEDULE AND PERIODICALLY UPDATE, AS REQUESTED
- B. A SCHEDULE OF VALUES (A.I.A. FORM #G-703)

IV. CONSTRUCTION PRIORITIES
- A. ESTABLISH DATE FOR THE PRECONSTRUCTION MEETING
- B. CHECK OUT LONG LEAD ITEMS - - ALLOW ORDERING TIME
- C. MAINTAIN CONSTRUCTION LOG DOCUMENTING RAIN DAYS WHEN SCHEDULED WORK COULD NOT BE PERFORMED.
- D. MAINTAIN A MARKED UP SET OF CONSTRUCTION PLANS W/ RED BALLPOINT PEN TO BE SUPPLIED TO ARCHITECT FOR USE IN ESTABLISHING AS BUILT DRAWINGS.

V. CHANGES / CORRESPONDENCE
- A. ALL CORRESPONDENCE OR DIRECTIVES THRU ARCHITECT AND COPIED TO OWNER
- B. NO DIRECTIVES FROM EMPLOYEES. ALL REQUESTS FOR INFORMATION OR CHANGES THRU ARCHITECT AND OWNER

VI. CHANGE ORDERS
- A. PROPER PROTOCOL MUST BE FOLLOWED IN REGARDS TO ANY CHANGE ORDERS, OWNER, ARCHITECT AND CONTRACTOR MUST SIGN OFF PRIOR TO ANY WORK BEING PERFORMED BY CONTRACTOR OR SUBS.
- B. GROUP ITEMS INTO ONE (1) CHANGE ORDER, RATHER THAN SEVERAL SINGLE ITEM CHANGE ORDERS.
- C. ANY WORK COMPLETED PRIOR TO A CHANGE ORDER BEING SIGNED BY ALL PARTIES IS AT CONTRACTOR'S RISK. CHANGE ORDERS SHALL BE SIGNED BEFORE WORK IS COMMENCED.

VII. SHOP DRAWING SUBMITTALS
- A. FOUR (4) COPIES (NOTE IN RED ANY CHANGES)
  ONE FOR OWNER
  ONE FOR ARCHITECT
  ONE FOR CONTRACTOR
  ONE FOR SUPPLIER
- B. CONTRACTOR TO REVIEW AND MARKUP ANY CHANGES ON ALL COPIES BEFORE SUBMITTING TO ARCHITECT. CONTRACTOR SHOULD PROVIDE HIS OR HER REVIEWERS SIGNATURE WITH DATE ON EACH SUBMITTAL.
- C. SUBMIT TO ARCHITECT AS SOON AS POSSIBLE
- D. NO SUBSTITUTES WITHOUT PRIOR APPROVAL BY ARCHITECT & OWNER.

VIII. CHANGES IN THE WORK
- A. DO NOT DEVIATE FROM PLANS WITHOUT ARCHITECTS APPROVAL.

IX. PROPER CONDUCT AT JOBSITES
- A. NO SWEARING
- B. NO LOUD RADIOS
- C. PROPERLY DRESSED FOR WORK
- D. KEEPING JOBSITE CLEAN AND SAFE EACH DAY IS SOLE RESPONSIBILITY OF THE CONTRACTOR.
- E. HARDHATS ARE REQUIRED PER OSHA REGULATIONS

X. RAIN DAY DOCUMENTATION
- A. SUBMIT RECORDED RAIN DAYS WITH EACH MONTHLY PAY REQUEST
- B. WHEN MORE THAN FOUR (4) DAYS ARE ACCUMULATED, A REQUEST FOR CHANGE ORDER SHOULD BE ISSUED. REQUEST ADDITIONAL DAYS TO BE ADDED TO ESTABLISHED CONTRACTUAL COMPLETION DATE.

ABBREVIATIONS

&	AND
∠	ANGLE
@	AT
Ø	DIAMETER OR ROUND
▲	WELD

A

ACOUS.	ACOUSTICAL
A.D.	AREA DRAIN
A.D.A.	AMERICANS WITH DISABILITIES ACT
ADJ.	ADJUSTABLE
A.F.F.	ABOVE FINISH FLOOR
AGGR.	AGGREGATE
A.H.U.	AIR HANDLING UNIT
ALUM.	ALUMINUM
A.C.I.	AMERICAN CONCRETE INSTITUTE
A.S.T.M.	AMERICAN SOCIETY OF TESTING AND MEASURES
A.W.P.A.	AMERICAN WOOD & PLYWOOD ASSOCIATION
A.B.	ANCHOR BOLTS
APPRVD.	APPROVED
APPROX.	APPROXIMATE
ARCH.	ARCHITECTURAL
A.C.C.M.P.	ASPHALT COATED CORRUGATED METAL PIPE
ASB.	ASBESTOS
ASPH.	ASPHALT
ASSY.	ASSEMBLY

B

BRG'(BRNG.)	BEARING
BD.	BOARD
BITUM.	BITUMINOUS
BLDG.	BUILDING
BLK.	BLOCK
BLK'G.	BLOCKING
BM.	BEAM
BOT.	BOTTOM
B.C.	BOTTOM CHORD
BLT.	BOLT

C

CAB.	CABINET
CANT.	CANTILEVER
C.B.	CATCH BASIN
CEM.	CEMENT
CER.	CERAMIC
C.I.	CAST IRON
C.G.	CORNER GUARD
CLG.	CEILING
CL.	CLOSET
CLR.	CLEAR
C.O.	CASED OPENING
COL.	COLUMN
CONC.	CONCRETE
CONN.	CONNECTION
CONSTR.	CONSTRUCTION
CONT.	CONTINUOUS
CORR.	CORRIDOR
CPT.	CARPET
CTSK.	COUNTERSUNK
CNTR.	COUNTER
CTR.	CENTER
℄	CENTERLINE
C/C.	CENTER TO CENTER
C.T.	CERAMIC TILE
CKT.	CIRCUIT
C.O.	CLEAN OUT
C.C.C.L.	COASTAL CONSTRUCTION CONTROL LINE
C.	COLD
C.W.	COLD WATER
C.B.S.	CONCRETE BLOCK CONSTRUCTION
C.M.U.	CONCRETE MASONRY UNIT
C.M.	CONCRETE MONUMENT
C.J	CONTROL JOINT
COND.	CONDENSATE OR CONDUIT
CU.	COPPER
C.J.C.	CORNER JACK
C.M.P.	CORRUGATED METAL PIPE
C.F.M.	CUBIC FEET PER MINUTE
C.Y.	CUBIC YARD
CU.V.	CU.VERT

D

D.L.	DEAD LOAD
DBL.	DOUBLE
D.C.G.	DIRT CONTROL GRATING
DEPT.	DEPARTMENT
D.F.	DRINKING FOUNTAIN
DEL.	DELAYED
DET.	DETAIL
DIA.	DIAMETER
DIM.	DIMENSION
DISP.	DISPENSER
DN.	DOWN
D.O.	DOOR OPENING
DWR.	DRAWER
DS.	DOWNSPOUT
D.SP.	DRY STANDPIPE
DWG.	DRAWING
D...I	DECK-A-JOINT
DP.	DEEP
D.O.E.	DEPARTMENT OF EDUCATION
D.E.R.	DEPARTMENT OF ENVIRONMENTAL REGULATION
D.E.P.	DEPARTMENT OF ENVIRONMENTAL PROTECTION
DW	DISHWASHER
DBL.	DOUBLE
D.H.	DOUBLE HUNG
DN.	DOWN
D	DRYER

E

E.	EAST
EA.	EACH
E.B.	EXPANSION BOLT
E.E.R.	ENERGY EFFICIENCY RATIO
E.F.	EXHAUST FAN
E.G.	EMERGENCY GENERATOR
E..I	EXPANSION JOINT
EL.	ELEVATION
EL.	EMERGENCY LIGHT
ELEC.	ELECTRICAL
ELEV.	ELEVATOR
EMER.	EMERGENCY
ENCL.	ENCLOSURE
E.P.	ELECTRICAL PANELBOARD
EQ.	EQUAL
EQPT.	EQUIPMENT
E.S.P.	ELECTRO STATIC PAINT
E.W.	EACH WAY
E.W.C.	ELECTRIC WATER COOLER
E.W.H.	ELECTRIC WATER HEATER
EXP.	EXPANSION
EXP.BLTS.	EXPANSION BOLTS
EX.	EXISTING
EXT.	EXTERIOR OR EXTENSION

F

F.A.	FIRE ALARM
F.A.C.	FLORIDA ACCESSIBILITY CODE
F.B.	FLAT BAR
F.B.C.	FLORIDA BUILDING CODE
F.P.C.	FLORIDA PLUMBING CODE
F.D.	FLOOR DRAIN
FDN.	FOUNDATION
F.E.	FIRE EXTINGUISHER
F.E.C.	FIRE EXTINGUISHER CAB.
F.H.C.	FIRE HOSE CABINET
FIN.	FINISH
FL.	FLOOR
FLASH.	FLASHING
FLUOR.	FLUORESCENT
F.O.C.	FACE OF CONCRETE
F.O.F.	FACE OF FINISH
F.O.S.	FACE OF STUDS
FPRF.	FIREPROOF
FG.	FIBERGLASS
FIN. FL.	FINISHED FLOOR
FXD.	FIXED
F.G.	FLOOR GIRDER
F.S.	FULL SIZE
FT.	FOOT OR FEET
F.T.A.	FEDERAL TRANSIT AUTHORITY
FTG.	FOOTING
FURR.	FURRING
FUT.	FUTURE
F.D.O.T.	FLORIDA DEPARTMENT OF TRANSPORTATION
F.D.E.P.	FLORIDA DEPARTMENT OF ENVIRONMENTAL PROTECTION

G

GA.	GAUGE
GALV.	GALVANIZED
G.B.	GRAB BAR
GL.	GLASS
GND.	GROUND
GR.	GRADE
GYP.	GYPSUM
GAL.	GALLON
G.F.I.	GROUND FAULT INTERRUPT

H

HCP.	HANDICAPPED
HDR.	HEADER
H.R.U.	HEAT RECOVERY UNIT
HD.	HEAVY DUTY
H.P.S.	HIGH PRESSURE SODIUM
H.J.	HIP JACK
H.C.	HOLLOW CORE
H.B.	HOSE BIBB
H.C.	HOLLOW CORE
HDWD.	HARDWOOD
HDWR	HARDWARE
H.M.	HOLLOW METAL
HORIZ.	HORIZONTAL
HR.	HOUR
H.C.	HOLLOW CORE
H.M.	HOLLOW METAL
H.M.F.	HOLLOW METAL FRAME
HK.	HOOK
H.P.	HORSE POWER & HIGH POINT
H.	HOT
H.D.G.	HOT DIPPED GALVANIZED

I

I.D.	INSIDE DIAMETER (DIM.)
INSUL.	INSULATION
INT.	INTERIOR
INV.	INVERT
I.P.	IRON PIPE

J

JAN.	JANITOR
JT.	JOINT

K

KIT.	KITCHEN
KW.	KILOWATT
K.T.	KEYBOARD TRAY

L

LAB.	LABORATORY
LAM.	LAMINATE
LAV.	LAVATORY
LB.	POUND
LEED	LEADERSHIP IN ENERGY AND ENVIRONMENTAL DESIGN
L.F.	LINEAL FEET
LG.	LONG
LGT.	LIGHT
L.P.	LIQUID PROPANE
LKR.	LOCKER
L.L.	LIVE LOAD
L.L.V.	LONG LEG VERTICAL
L.S.C.	LATCH SIDE CLEARANCE
L.T.	LAUNDRY TUB

M

MAX.	MAXIMUM
M.C.	MEDICINE CABINET
MECH.	MECHANICAL
MEMB.	MEMBRANE
MTL.	METAL
MFR.	MANUFACTURER
MH.	MAN-HOLE
MIN.	MINIMUM
MIRR.	MIRROR
MISC.	MISCELLANEOUS
MTD.	MOUNTED
M.B.	MACHINE BOLT
M.D.	MAIN DISCONNECT
M.D.F.	MEDIUM DENSITY FIBERBOARD
M.D.P.	MAIN DISTRIBUTION PANEL
MD.	MAIN DRAIN
M.O.	MASONRY OPENING
M.S.L.	MEAN SEA LEVEL
M.C.	MEDICINE CABINET
M.V.	MERCURY VAPOR
MS.	METAL SADDLE
M.T.	METAL TH-RESHOLD
M.P.H.	MILES PER HOUR
M.R.	MOISTURE RESISTANT
MLD'G.	MOULDING

N

N/A	NOT APPLICABLE
N	NORTH
N.A.V.D.	NORTH AMERICAN VERTICAL DATUM
N.I.C.	NOT IN CONTRACT
NO. OR #	NUMBER
NOM.	NOMINAL
N.T.S.	NOT TO SCALE
N.E.C.	NATIONAL ELECTRIC CODE
N.G.V.D.	NATIONAL GEODETIC VERTICAL DATUM
NL.	NIGHT LIGHT

O

O.A.	OVERALL
OBS.	OBSCURE
O.C.	ON CENTER
O.D.	OUTSIDE DIAMETER (DIM.)
OFF.	OFFICE
OPNG.	OPENING
OPP.	OPPOSITE
O.B.D.	OPPOSED BLADE DAMPER
O.A.	OUTSIDE AIR
O.H.	OVER HANG
O.H.D.	OVER-HEAD DOOR
O.E.	OVER-HEAD ELECTRIC

P

P.V.C.	POLY VINYL CHLORIDE
P.E.B.	PAINTED EXPOSED BLOCK
P.S.I.	POUNDS PER SQUARE INCH
P.S.F.	POUNDS PER SQUARE FOOT
PL.	PLATE
P.LAM.	PLASTIC LAMINATE
PLAS.	PLASTER
PLY.	PLYWOOD
PR.	PAIR
PT.	POINT
P.T.D.	PAPER TOWEL DISPENSER
P.T.D/R	COMBINATION PAPER TOWEL DISPENSER & RECEPTACLE
PTN.	PARTITION
P.T.	PRESSURE TREATED
P.T.R.	PAPER TOWEL RECEPTACLE
P.T.H.	PAPER TOWEL HOLDER
PERF.	PERFORATED
P	PROPERTY LINE
P.C.	PULL CHAIN
P.B.	PUSH BUTTON
P.P.	POWER POLE
P.H.W.	PARTIAL HEIGHT WALL
PORC.	PORCELAIN TILE

Q

Q.T.	QUARRY TILE

R

R.	RISER
RAD.	RADIUS
R.D.	ROOF DRAIN
REF.	REFERENCE
REFR.	REFRIGERATOR
REG.	REGISTER
REINF.	REINFORCED
REQ.	REQUIRED
RESIL.	RESILIENT
RM.	ROOM
R.O.	ROUGH OPENING
RWD.	REDWOOD
R.W.L.	RAIN WATER LEADER
R.C.P.	REINFORCED CONCRETE PIPE
REQ'D.	REQUIRED
R/A	RETURN AIR
REV.	REVERSE
R.O.W.	RIGHT OF WAY
R. AND S.	ROD & SHELF
R.O.	ROUGH OPENING
R.S.	ROUGH SAW

S

S.	SOUTH
S.A.	SUPPLY AIR
S.A.T.	SUSPENDED ACOUSTICAL TILE
S.C.	SOLID CORE
S.C.D.	SEAT COVER DISPENSER
SCHED.	SCHEDULE
S.D.	SOAP DISPENSER
SECT.	SECTION
SH.	SHELF
SHR.	SHOWER
SHT.	SHEET
SI-L	SINGLE HUNG
SIM.	SIMILAR
SLD. CONC.	SEALED CONCRETE
S.L.V.	SHORT LEG VERTICAL
S.N.D.	SANITARY NAPKIN DISPENSER
S.N.R.	SANITARY NAPKIN RECEPTACLE
SPEC.	SPECIFICATION
SQ.	SQUARE
S.S.	STAINLESS STEEL
S.SK.	SERVICE SINK
STA.	STATION
STD.	STANDARD
STL.	STEEL
STOR.	STORAGE
STRL.	STRUCTURAL
SUSP.	SUSPENDED
SYM.	SYMMETRICAL
S4S.	SANDED 4 SIDES
SIS2E.	SANDED ONE SIDE AND TWO EDGES
S.S.	SANITARY SEWER
SEER	SEASONAL ENERGY EFFICIENCY RATED
SH.	SINGLE HUNG
SLDG. GLS.	SLIDING GLASS
S/D	SMOKE DETECTOR
S.Y.P.	SOUTHERN YELLOW PINE
☑	SQUARE FOOT DIMENSION
S.F.	SQUARE FOOT
S..I.	STEEL JOIST INSTITUTE
SYS.	SYSTEM
S.V.	SHEET VINYL

T

TRD.	TREAD
T.B.	TOWEL BAR
T.O.C.	TOP OF CURB
TEL.	TELEPHONE
TERR.	TERRAZZO
T.&G.	TONGUE AND GROOVE
THK.	THICK
T.O.P.	TOP OF PAVEMENT
T.P.D.	TOILET PAPER DISPENSER
T.V.	TELEVISION
T.O.W.	TOP OF WALL
TKB.	TACKBOARD
T.CL.	TIME CLOCK
TYP.	TYPICAL
T.C.	TOP OF CHORD
T.O.B.	TOP OF BEAM
T.L.	TOTAL LOAD
TRANSV.	TRANSVERSE
T.	TREAD
T.S.	TUBE SECTION

U

UNF.	UNFINISHED
U.N.O.	UNLESS NOTED OTHERWISE
U.C.	UNDER COUNTER
U.L.	UNDERWRITERS LAB
U.S.G.	UNITED STATES GYPSUM
U.S.G.B.C.	UNITED STATES GREEN BUILDING COUNCIL

V

VAC.	VACUUM
V.B.	VAPOR BARRIER
V.C.T.	VINYL COMPOSITION TILE
VERT.	VERTICAL
V.P.	VAPOR PROOF
V.R.	VAPOR RETARDER
V.T.R.	VENT THRU ROOF

W

W.	WEST
W	WASHER
W/	WITH
W.C.	WATER CLOSET
WD.	WOOD
W/O	WITH-OUT
WP.	WATERPROOF
WSCT.	WAINSCOT
WT.	WEIGHT
WSHR.	WASHER
W.I.C.	WALK IN CLOSET
W.G.	WALL GIRDER
W.W.F.	WELDED WIRE FABRIC
W.W.M.	WELDED WIRE MESH
W.P.	WORKING POINT
WDW.	WINDOW

SOME TERMS AND SYMBOLS MAY NOT APPLY TO THIS PROJECT.

BID SET

EDLUND · DRITENBAS · BINKLEY
ARCHITECTS AND ASSOCIATES, P.A.
AR-AA C000886
65 ROYAL PALM POINTE, SUITE "D"
VERO BEACH, FLORIDA 32960
PHONE: (772) 569-4320

EDB ARCHITECTS AND ASSOCIATES

SEAL: STATE OF FLORIDA JEFFREY P. BINKLEY 8545 REGISTERED ARCHITECT

PROJECT: STATION #15


FOR: INDIAN RIVER COUNTY FIRE RESCUE/EMS
9010 87TH ST
VERO BEACH, FL 32967

NO:	DATE	REVISIONS


© JULY '25 THESE PLANS AND THE INFORMATION SHOWN HEREIN ARE THE PROPERTY OF EDLUND DRITENBAS BINKLEY ARCHITECTS, P.A. AND REPRODUCTIONS, DISCLOSURES OR USE THEREOF IN WHOLE OR IN PART IS EXPRESSLY PROHIBITED WITHOUT WRITTEN PERMISSION.

COMM. NO: 070424VB
DATE: JULY 2, 2025
BY: LJD
CH'KD: JPB


SHEET NO. ABB OF ONE

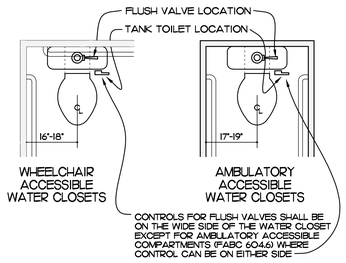


FIXTURE LOCATIONS AND FLUSH VALVE LOCATION

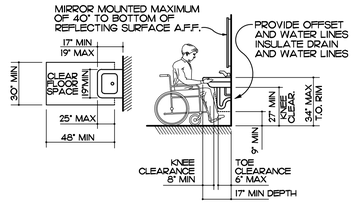


LAVATORY CLEARANCES

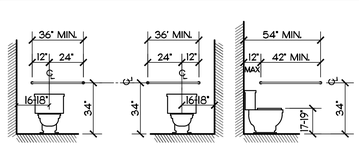


GRAB BARS AT WATER CLOSETS IN TOILET ROOMS

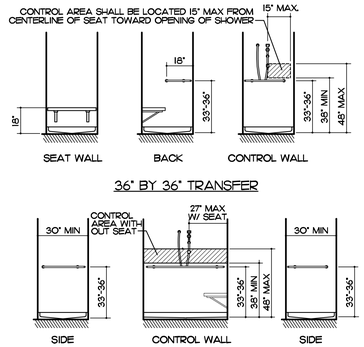



GRAB BARS AT SHOWER STALLS

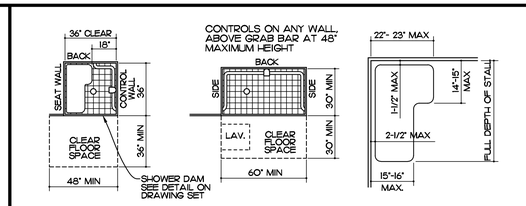


SHOWER SIZE, CLEARANCES AND SEAT DESIGN

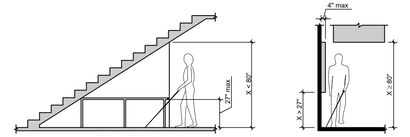

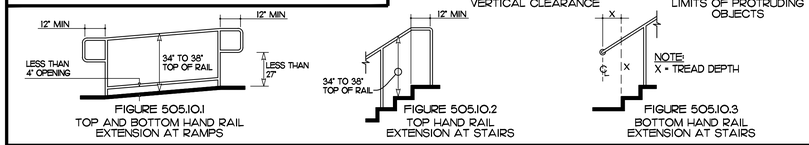


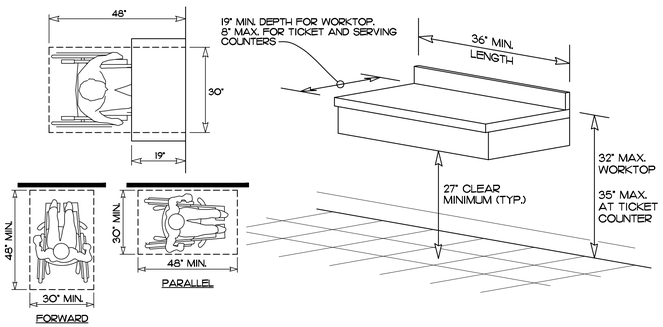

MOUNTING HEIGHT AND CLEARANCES FOR TICKET AND SERVING COUNTERS / WORKTOPS

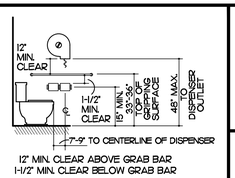


TOILET PAPER DISPENSER OUTLET LOCATION

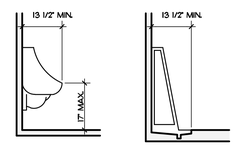


FLUSH CONTROLS SHALL COMPLY WITH FACBC 309

ACCESSIBLE URINAL

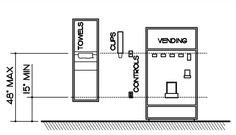


DISPENSER ACCESS

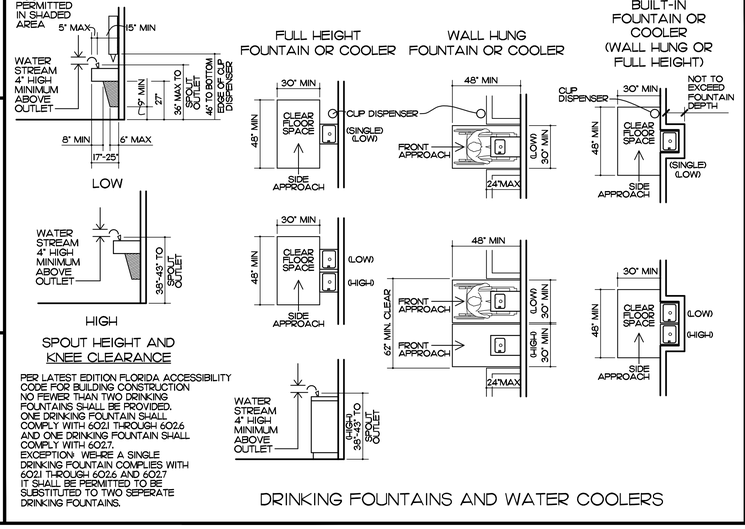

SPOUT HEIGHT AND KNEE CLEARANCE


PER LATEST EDITION FLORIDA ACCESSIBILITY CODE FOR BUILDING CONSTRUCTION NO FEWER THAN TWO DRINKING FOUNTAINS SHALL BE PROVIDED. ONE DRINKING FOUNTAIN SHALL COMPLY WITH 602.1 THROUGH 602.6 AND ONE DRINKING FOUNTAIN SHALL COMPLY WITH 602.7. EXCEPTION: WHERE A SINGLE DRINKING FOUNTAIN COMPLIES WITH 602.1 THROUGH 602.6 AND 602.7 IT SHALL BE PERMITTED TO BE SUBSTITUTED TO TWO SEPERATE DRINKING FOUNTAINS.


DRINKING FOUNTAINS AND WATER COOLERS

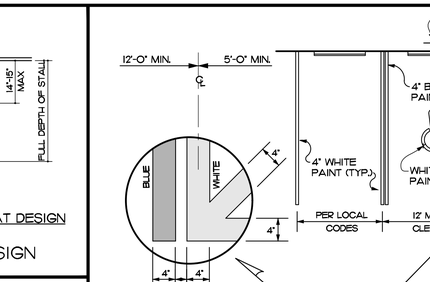


DISABLED PARKING STALL

NOTE:
PARALLEL PARKING ACCESSIBLE STALL AT 8' X 23' WITH 5 FT. AISLE ON PASSENGER SIDE

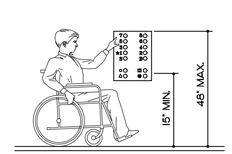


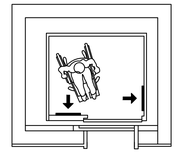

ALTERNATE LOCATIONS OF PANEL WITH SIDE OPENING DOOR

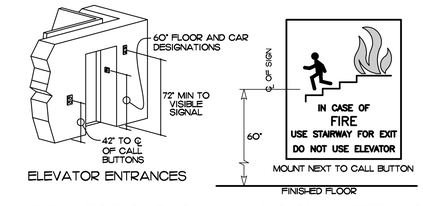

ELEVATOR CAB, CALL AND SIGNAL DETAILS

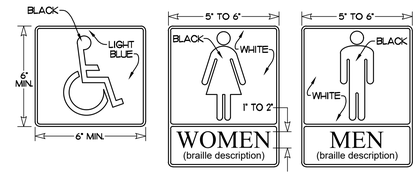



UNIVERSAL SYMBOLS
MOUNT AT 60" A.F.F. TO CENTERLINE

ADA / FACBC REFERENCE GUIDE


SITE WALKWAYS, RAMPS, AISLES, ETC.
NOTE: THESE ARE MAXIMUMS. LESS IS BETTER.

CHAPTER	
402.2	ACCESSIBLE ROUTE MAXIMUM SLOPE 1:20 (5%) OR IT'S A RAMP!
403.3	ACCESSIBLE ROUTE CROSS SLOPE MAXIMUM 1:48 (2%)
405.8	6" RISE MAX. / 6' RUN MAX. — NO HANDRAILS REQUIRED AS LONG AS GRADE ADJACENT IS FLUSH WITH RAMP. IF NOT FLUSH, A 2" HIGH CURB IS REQUIRED AT EDGE OF RAMP.
502.4	PARKING SPACE MAXIMUM SLOPE 1:48 (2%) IN ALL DIRECTIONS.
405.3	RAMP CROSS SLOPES MAXIMUM 1:48 (2%)
405.2	MAXIMUM RAMP SLOPE IS 1:12 (8.33%)
404.2.4.4	AREAS IN FRONT OF DOORS PER FIG. 25 ARE TO BE LEVEL (CAN BE ≤ 1:48 TO DRAIN PROPERLY)

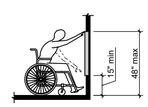

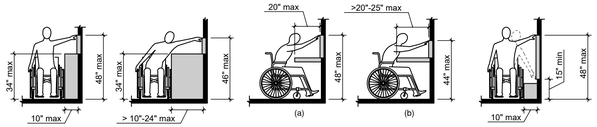

REACH LIMITS

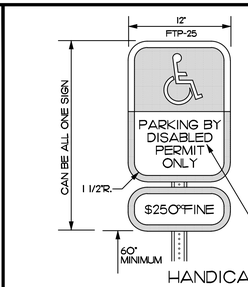

NOTES:

TOP PORTION OF FTP 25 AND 26 SHALL HAVE A REFLECTIVE BLUE BACKGROUND WITH WHITE REFLECTIVE SYMBOL AND BORDER.

BOTTOM PORTION SHALL HAVE A REFLECTIVE WHITE BACKGROUND WITH BLACK OPAQUE LEGEND AND BORDER.


FTP 25 AND 26 MAY BE FABRICATED ON ONE PANEL OR TWO.


FTP 25 MAY BE SUBSTITUTED FOR THE FTP 26 IN AREAS WHERE SPACE IS LIMITED.


SIGNS ARE TO BE MOUNTED AT STANDARD HEIGHT, (7' FROM PARKING SURFACE TO BOTTOM OF SIGN).

ALL LETTERS 1" SERIES 'C'


HANDICAP SIGNAGE

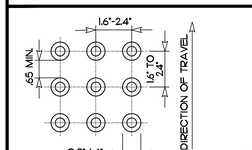

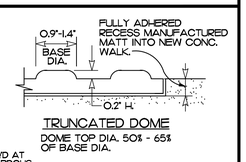

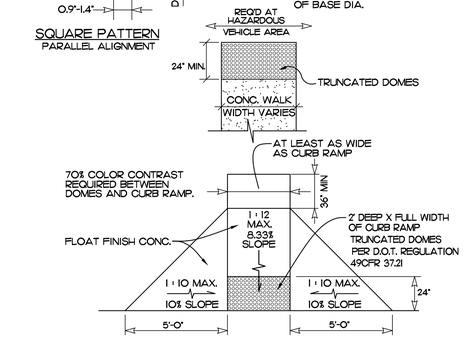


CURB RAMP SLOPES

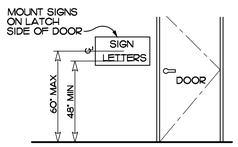

SIGNS MUST BE MOUNTED ON WALLS, NOT DOORS.
60" MAX ABOVE FINISHED FLOOR TO CENTERLINE OF SIGN.
TACTILE CHARACTERS TO BE LOCATED 48" A.F.F. MIN.
COLORS OF SIGN MUST HAVE CONTRAST WITH SURROUNDING AREA.

SIGN MOUNTING HEIGHT

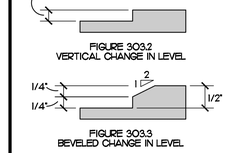

ADVISORY 303.3 BEVELED.
A CHANGE IN LEVEL OF 1/2 INCH (13 MM) IS PERMITTED TO BE 1/4 INCH (6.4 MM) VERTICAL PLUS 1/4 INCH (6.4 MM) BEVELED. HOWEVER, IN NO CASE MAY THE COMBINED CHANGE IN LEVEL EXCEED 1/2 INCH (13 MM). CHANGES IN LEVEL EXCEEDING 1/2 INCH (13 MM) MUST COMPLY WITH 405 (RAMPS) OR 406 (CURBS)

ACCESSIBILITY DETAILS

SOME TERMS, SYMBOLS AND SPECIFICATIONS MAY NOT APPLY TO THIS PROJECT.

UPDATED 24 FEBRUARY 2016

BID SET

EDLUND · DRITENBAS · BINKLEY
ARCHITECTS AND ASSOCIATES, P.A.
AR-AA C000886
65 ROYAL PALM POINTE, SUITE "D"
VERO BEACH, FLORIDA 32960
PHONE: (772) 569-4320

EDB ARCHITECTS AND ASSOCIATES

SEAL: STATE OF FLORIDA REGISTERED ARCHITECT JEFFREY P. BINKLEY 8545


PROJECT: STATION #15
FOR: INDIAN RIVER COUNTY FIRE RESCUE/EMS
9010 87TH ST
VERO BEACH, FL 32967

NO:	DATE	REVISIONS

© JULY '25 THESE PLANS AND THE INFORMATION SHOWN HEREIN ARE THE PROPERTY OF EDLUND DRITENBAS BINKLEY ARCHITECTS, P.A. AND REPRODUCTIONS, DISCLOSURES OR USE THEREOF IN WHOLE OR IN PART IS EXPRESSLY PROHIBITED WITHOUT WRITTEN PERMISSION.

COMM. NO: 070424VB
DATE: JULY 2, 2025
BY: LJD
CH'KD: JPB

SHEET NO.
ACC
OF ONE

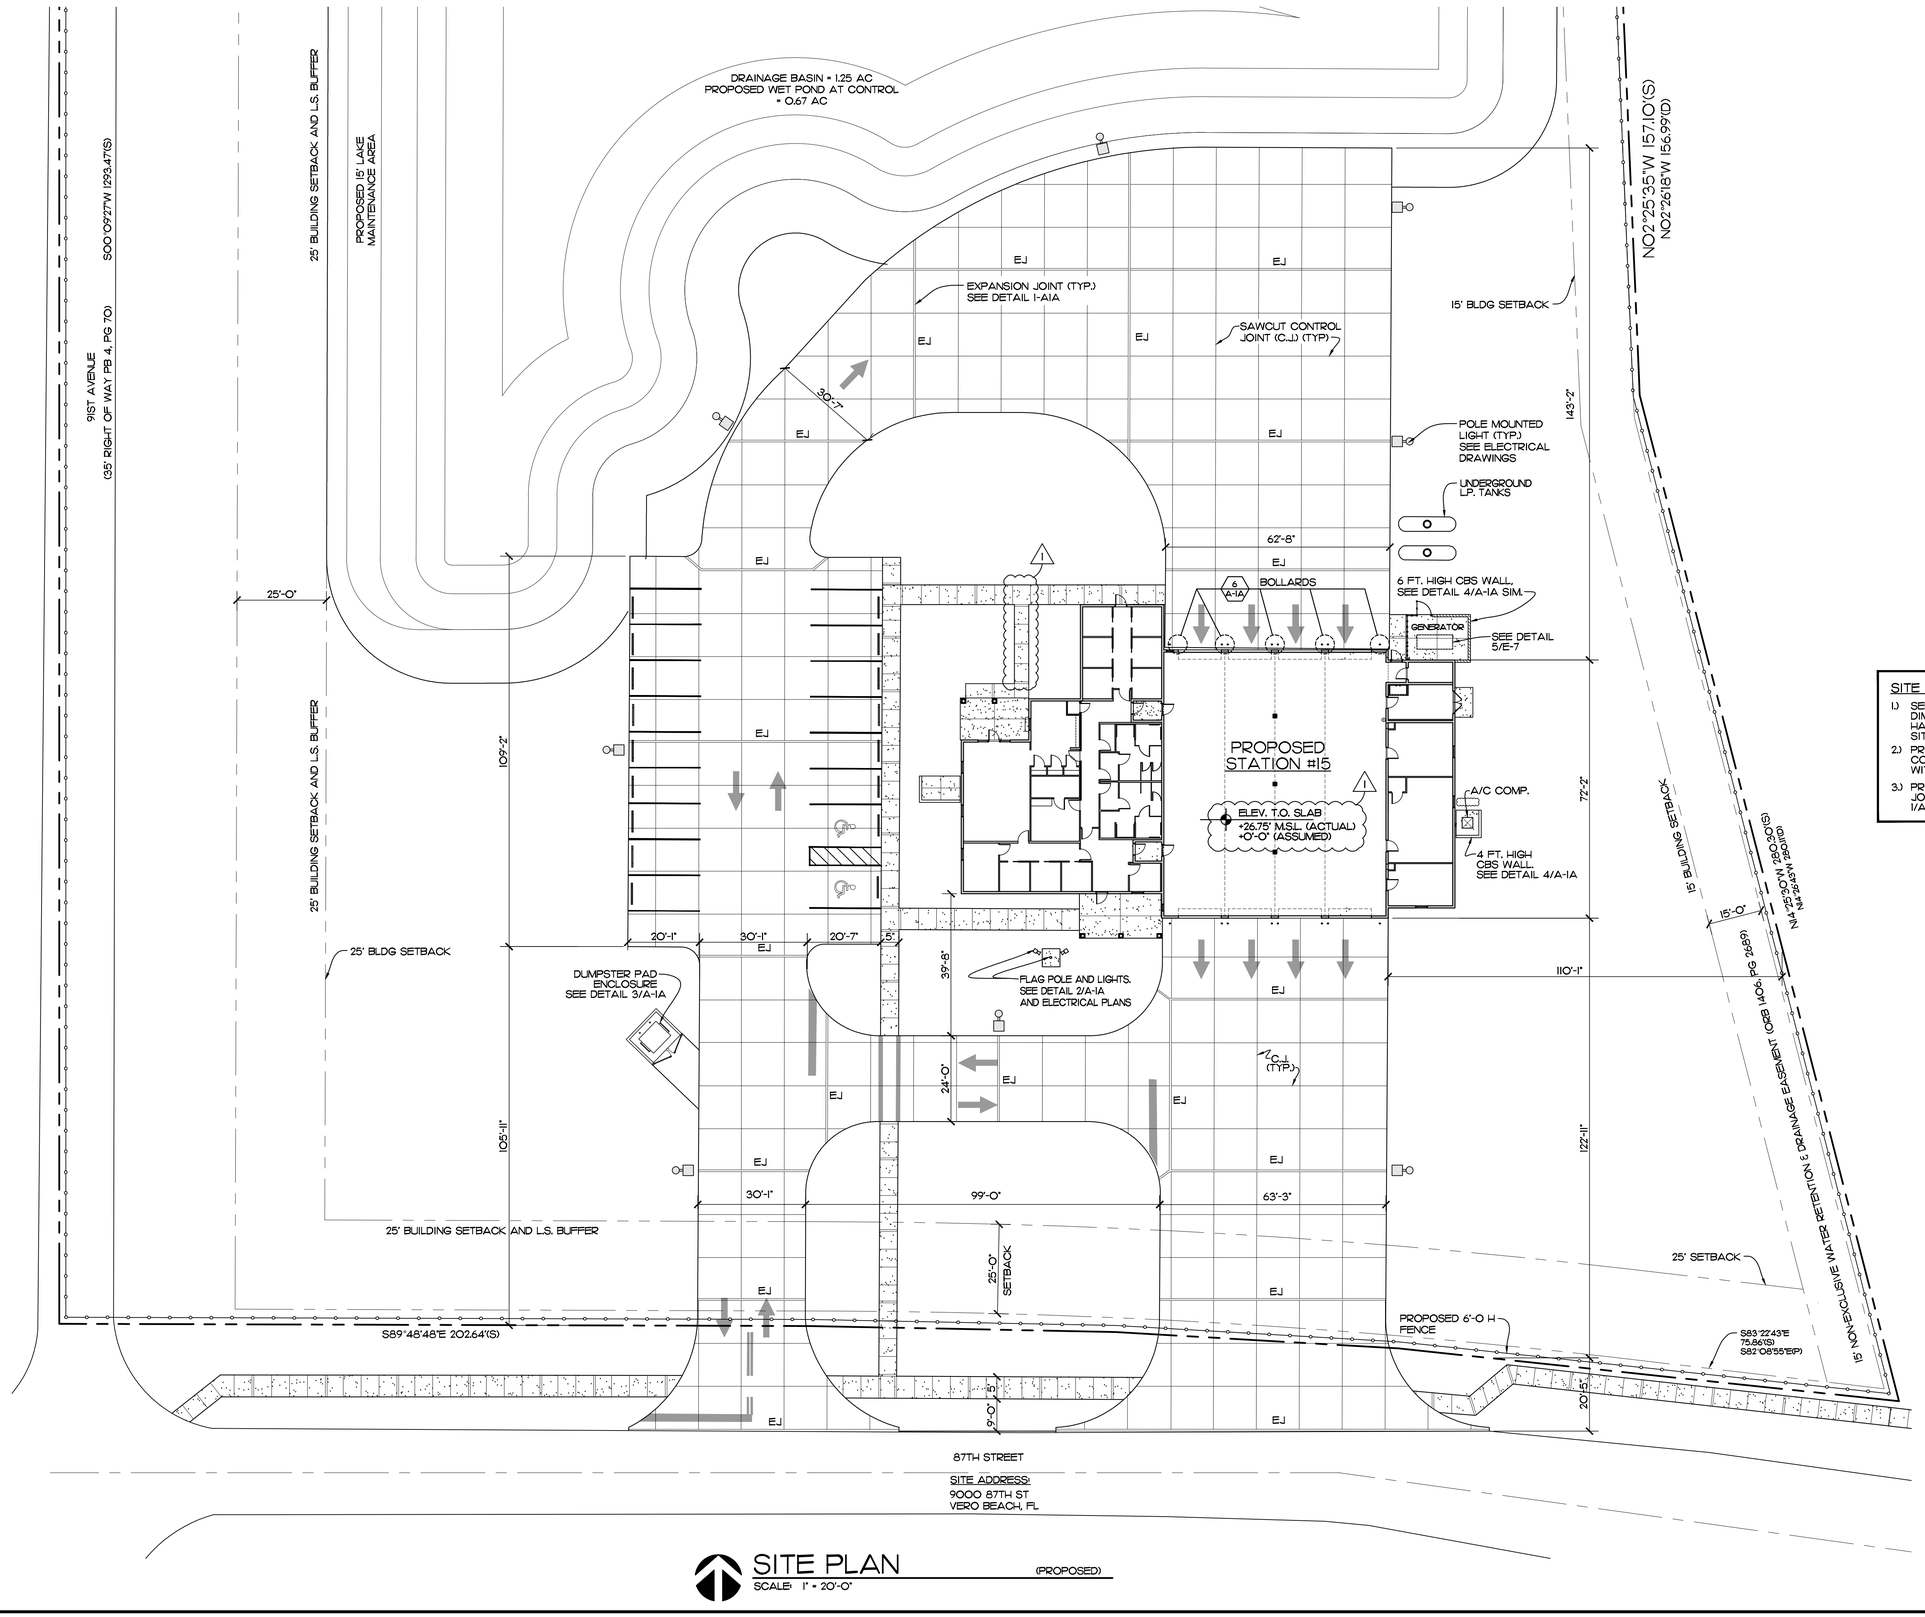

SITE ADDRESS:
9000 87TH ST
VERO BEACH, FL

SITE PLAN (PROPOSED)
SCALE: 1" = 20'-0"

SITE PLAN NOTES:
1.) SEE CIVIL DRAWINGS FOR ADDITIONAL DIMENSIONS, PAVING AND DRAINAGE PLANS, HARDSCAPE / IRRIGATION PLANS AND SITE DETAILS.
2.) PROVIDE 1/8" WIDE X 1" DEEP SAW CUT CONTROL JOINTS (C.J) WHERE INDICATED WITHIN 24 HOURS OF SLAB POURS.
3.) PROVIDE THRU THE SLAB EXPANSION JOINT (EJ) WHERE INDICATED. SEE DETAIL 1/A-1A

BID SET

EDLUND · DRITENBAS · BINKLEY
ARCHITECTS AND ASSOCIATES, P.A.
AR-AA C000886
65 ROYAL PALM POINTE, SUITE "D"
VERO BEACH, FLORIDA 32960
PHONE: (772) 569-4320

ARCHITECTS EDB AND ASSOCIATES

SEAL: STATE OF FLORIDA JAMES F. BINKLEY 8545 REGISTERED ARCHITECT JAMES F. BINKLEY


PROJECT: STATION #15
FOR: INDIAN RIVER COUNTY FIRE RESCUE/EMS
9010 87TH ST
VERO BEACH, FL 32967

NO:	DATE	REVISIONS
1	11/20/25	BLDG DEPT REVISIONS

© JULY '25. THESE PLANS AND THE INFORMATION SHOWN HEREIN ARE THE PROPERTY OF EDLUND DRITENBAS BINKLEY ARCHITECTS, P.A. AND REPRODUCTIONS, DISCLOSURES OR USE THEREOF IN WHOLE OR IN PART IS EXPRESSLY PROHIBITED WITHOUT WRITTEN PERMISSION.


COMM. NO: 070424VB
DATE: JULY 2, 2025
BY: LJD
CH'KD: JFB

SHEET NO. A-1 OF FOURTEEN

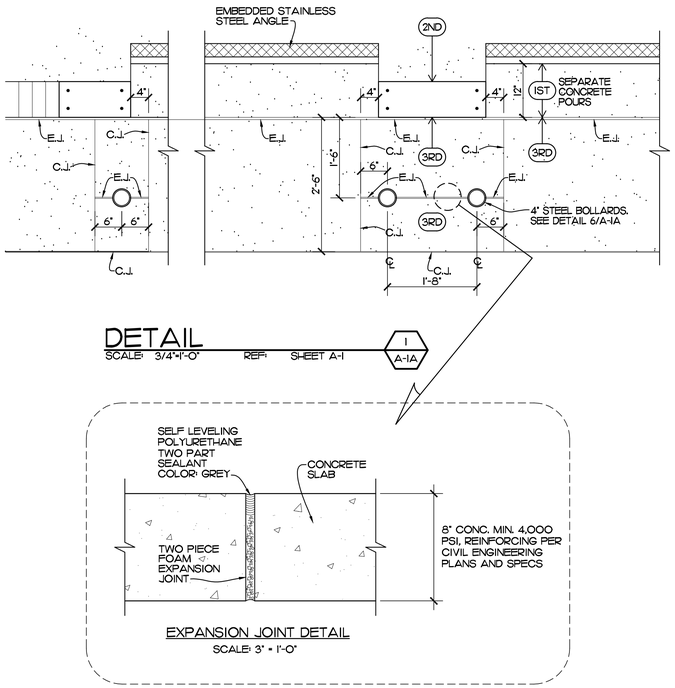


DETAIL
SCALE: 3/4"=1'-0" REF: SHEET A-1 — 1 / A-1A


EXPANSION JOINT DETAIL
SCALE: 3" = 1'-0"

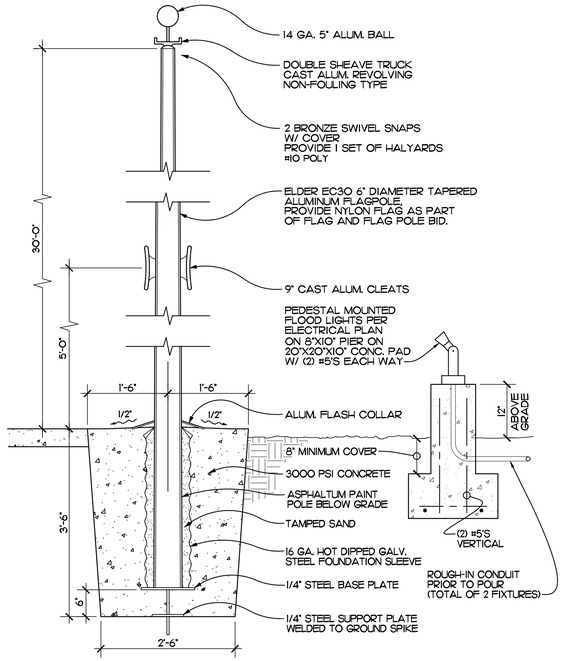


FLAGPOLE DETAIL
SCALE: 3/4"=1'-0" REF: SHEET A-1, A-3 — 2 / A-1A

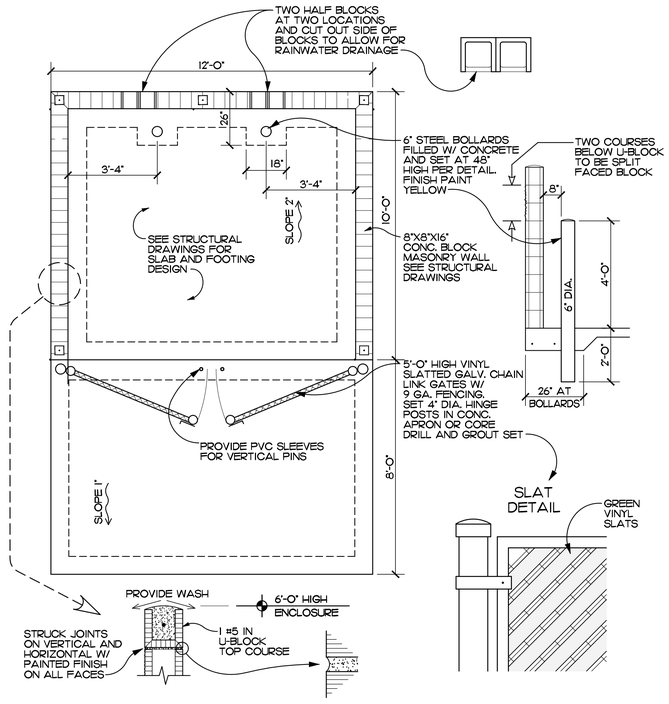


DETAIL
SCALE: 1"=20" DUMPSTER ENCLOSURE REF: SHEET A-1 — 3 / A-1A

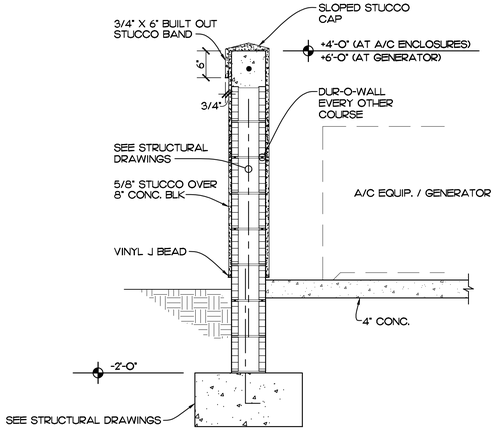

DETAIL
SCALE: 3/4" = 1'-0" REF: SHEET A-1 — 4 / A-1A

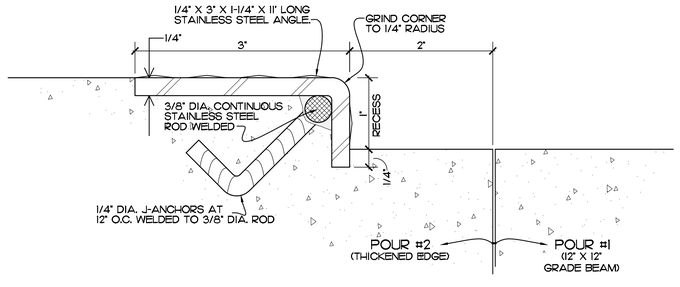

DETAIL
SCALE: 3" = 1'-0" REF: DETAIL 2/A-3 — 5 / A-1A

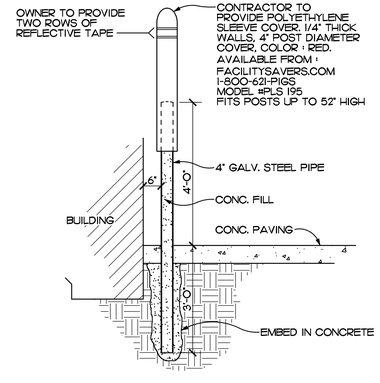

DETAIL
SCALE: 1/4" = 1'-0" REF: SHEETS A-1, A-2, A-4 — 6 / A-1A

BID SET

EDLUND · DRITENBAS · BINKLEY
ARCHITECTS AND ASSOCIATES, P.A.
AR-AA C000886
65 ROYAL PALM POINTE, SUITE "D"
VERO BEACH, FLORIDA 32960
PHONE: (772) 569-4320

ARCHITECTS EDB AND ASSOCIATES

SEAL: STATE OF FLORIDA — REGISTERED ARCHITECT — JOSEPH F. BINKLEY — 8545

PROJECT: STATION #15


FOR: INDIAN RIVER COUNTY FIRE RESCUE/EMS
9010 67TH ST
VERO BEACH, FL 32967


NO:	DATE	REVISIONS

© JULY '25 THOSE PLANS AND THE INFORMATION SHOWN HEREIN ARE THE PROPERTY OF EDLUND DRITENBAS BINKLEY ARCHITECTS, P.A. AND REPRODUCTIONS, DISCLOSURES OR USE THEREOF IN WHOLE OR IN PART IS EXPRESSLY PROHIBITED WITHOUT WRITTEN PERMISSION.

COMM. NO: 070424VB
DATE: JULY 2, 2025
BY: LJD
CH'KD: JFB

SHEET NO.
A-1A
OF FOURTEEN

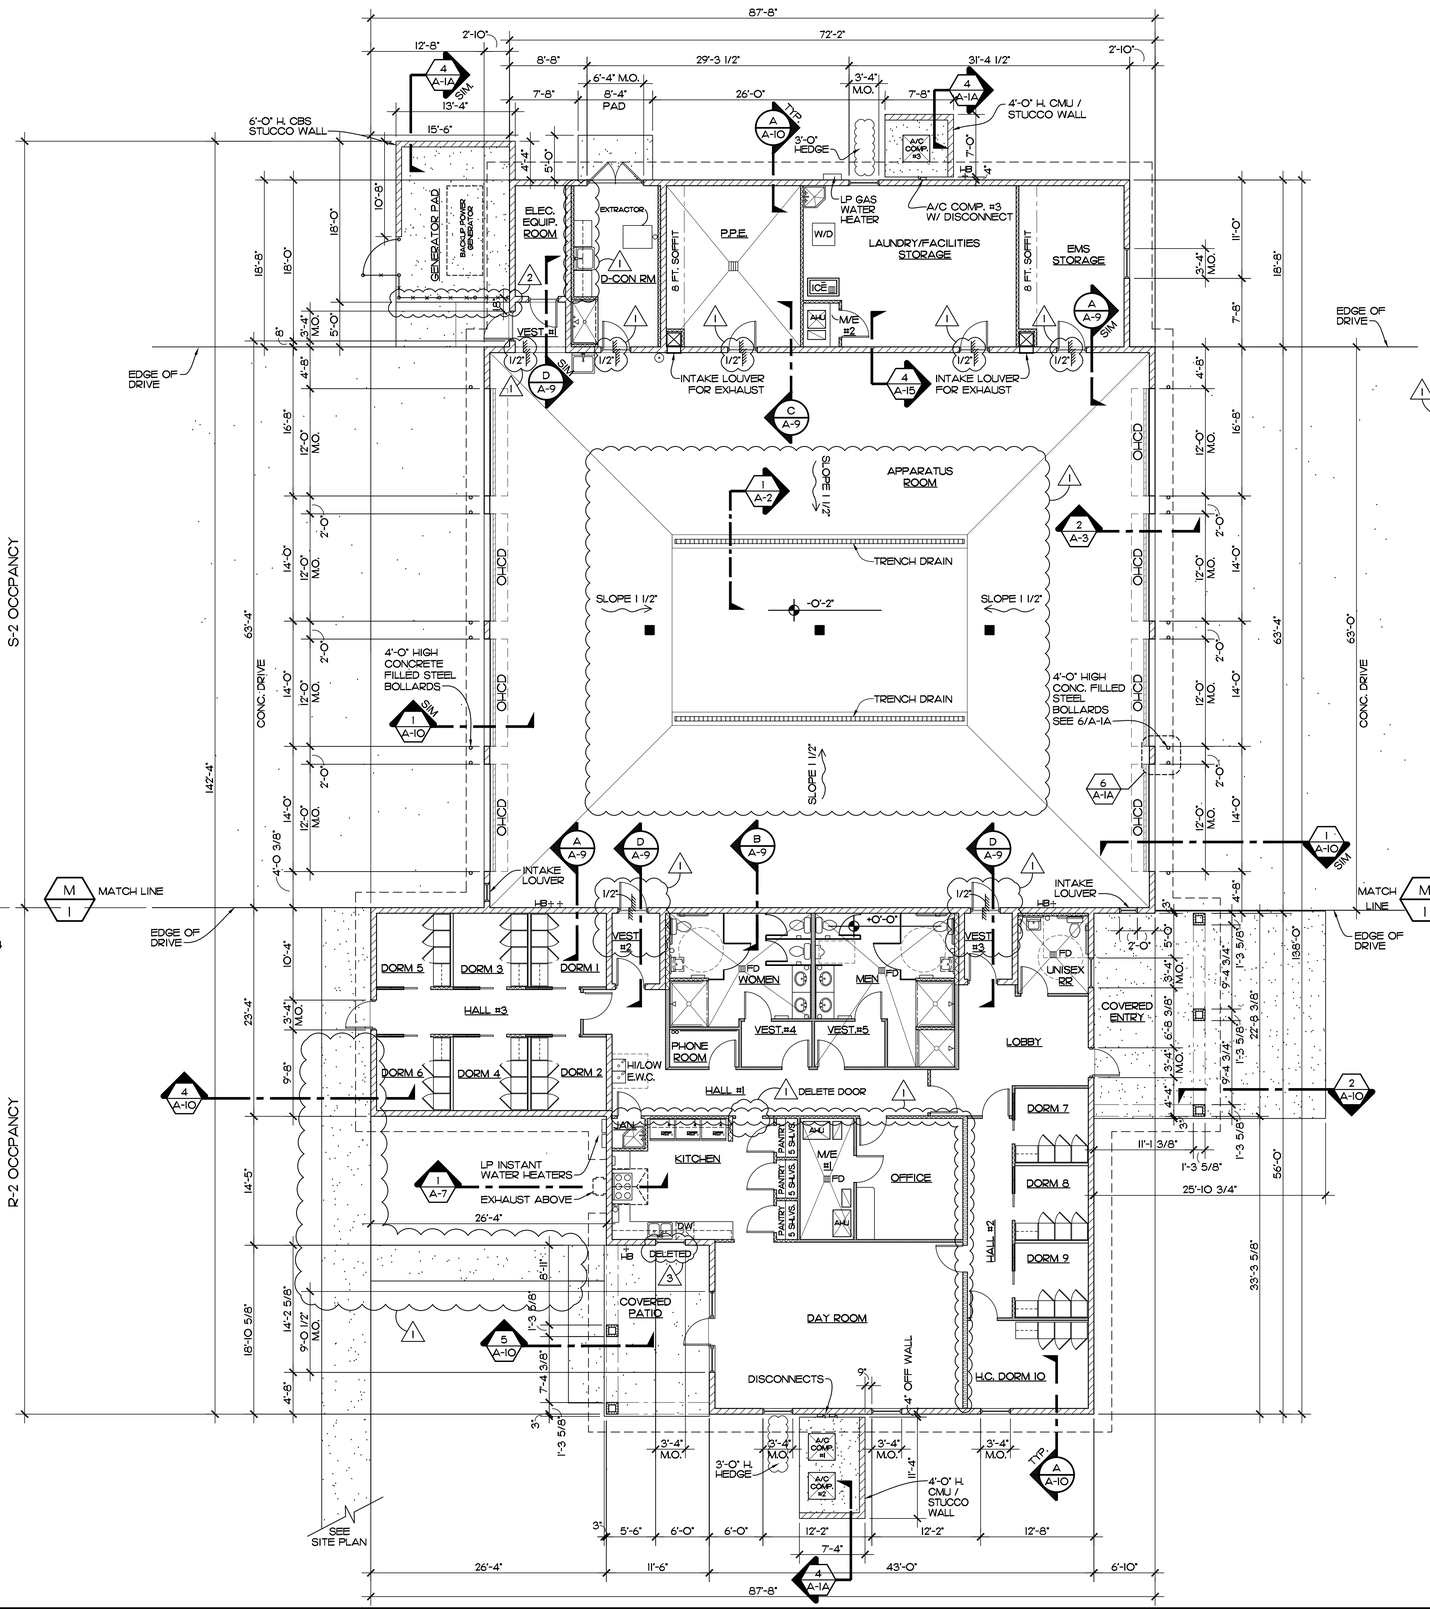

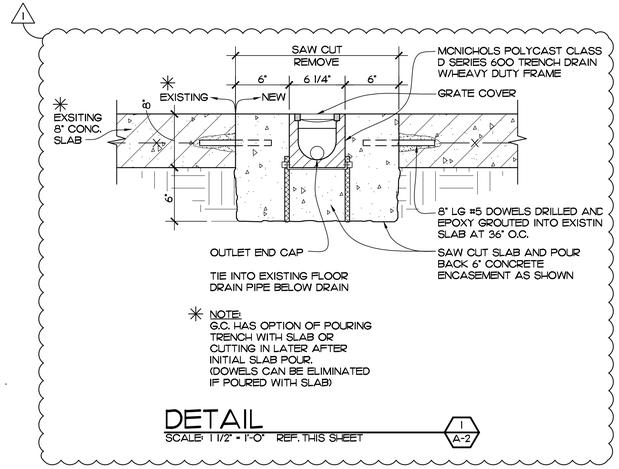

DETAIL

SCALE: 1 1/2" = 1'-0" REF. THIS SHEET

BUILDING AREA	
LODGING / ROOMING HOUSE	3,488 S.F.
STORAGE AREA (INCLUDES APP RM)	5,996 S.F.
APPARATUS ROOM	4,702 S.F.
COVERED AREA	499 S.F.
TOTAL UNDER ROOF	9,983 S.F.

LEGEND

- NEW CONCRETE BLOCK WALL
- NEW STEEL STUD FRAME WALL. 3-5/8" STL. STUD AT 16" O.C. W/ 3 1/2" SOUND BATT INSULATION
- NEW STEEL STUD FRAME WALL. 3-5/8" STL. STUD AT 16" O.C. W/ 1/2" GYP. BD. PAINT FINISH

BUILDING PLAN

SCALE: 1/8"= 1'-0"

NOTE:
SEE SHEETS A-3 AND A-4 FOR INTERIOR DIMENSIONS

EDLUND · DRITENBAS · BINKLEY
ARCHITECTS AND ASSOCIATES, P.A.
AR-AA C000886
65 ROYAL PALM POINTE, SUITE "D"
VERO BEACH, FLORIDA 32960
PHONE: (772) 569-4320

EDB ARCHITECTS AND ASSOCIATES

SEAL:

PROJECT: STATION #15


FOR: INDIAN RIVER COUNTY FIRE RESCUE/EMS
9010 67TH ST
VERO BEACH, FL 32967

NO:	DATE	REVISIONS
1	11/20/25	BLDG DEPT REVISIONS
2	1/8/26	BLDG DEPT REVISIONS
3	6/23/26	ADDENDUM REVISIONS

© JULY '25 THESE PLANS AND THE INFORMATION SHOWN HEREIN ARE THE PROPERTY OF EDLUND DRITENBAS BINKLEY ARCHITECTS, P.A. AND REPRODUCTIONS, DISCLOSURES OR USE THEREOF IN WHOLE OR IN PART IS EXPRESSLY PROHIBITED WITHOUT WRITTEN PERMISSION.

COMM. NO: 070424VB
DATE: JULY 2, 2025
BY: LJD
CH'KD: JFB

SHEET NO.
A-2
OF FOURTEEN

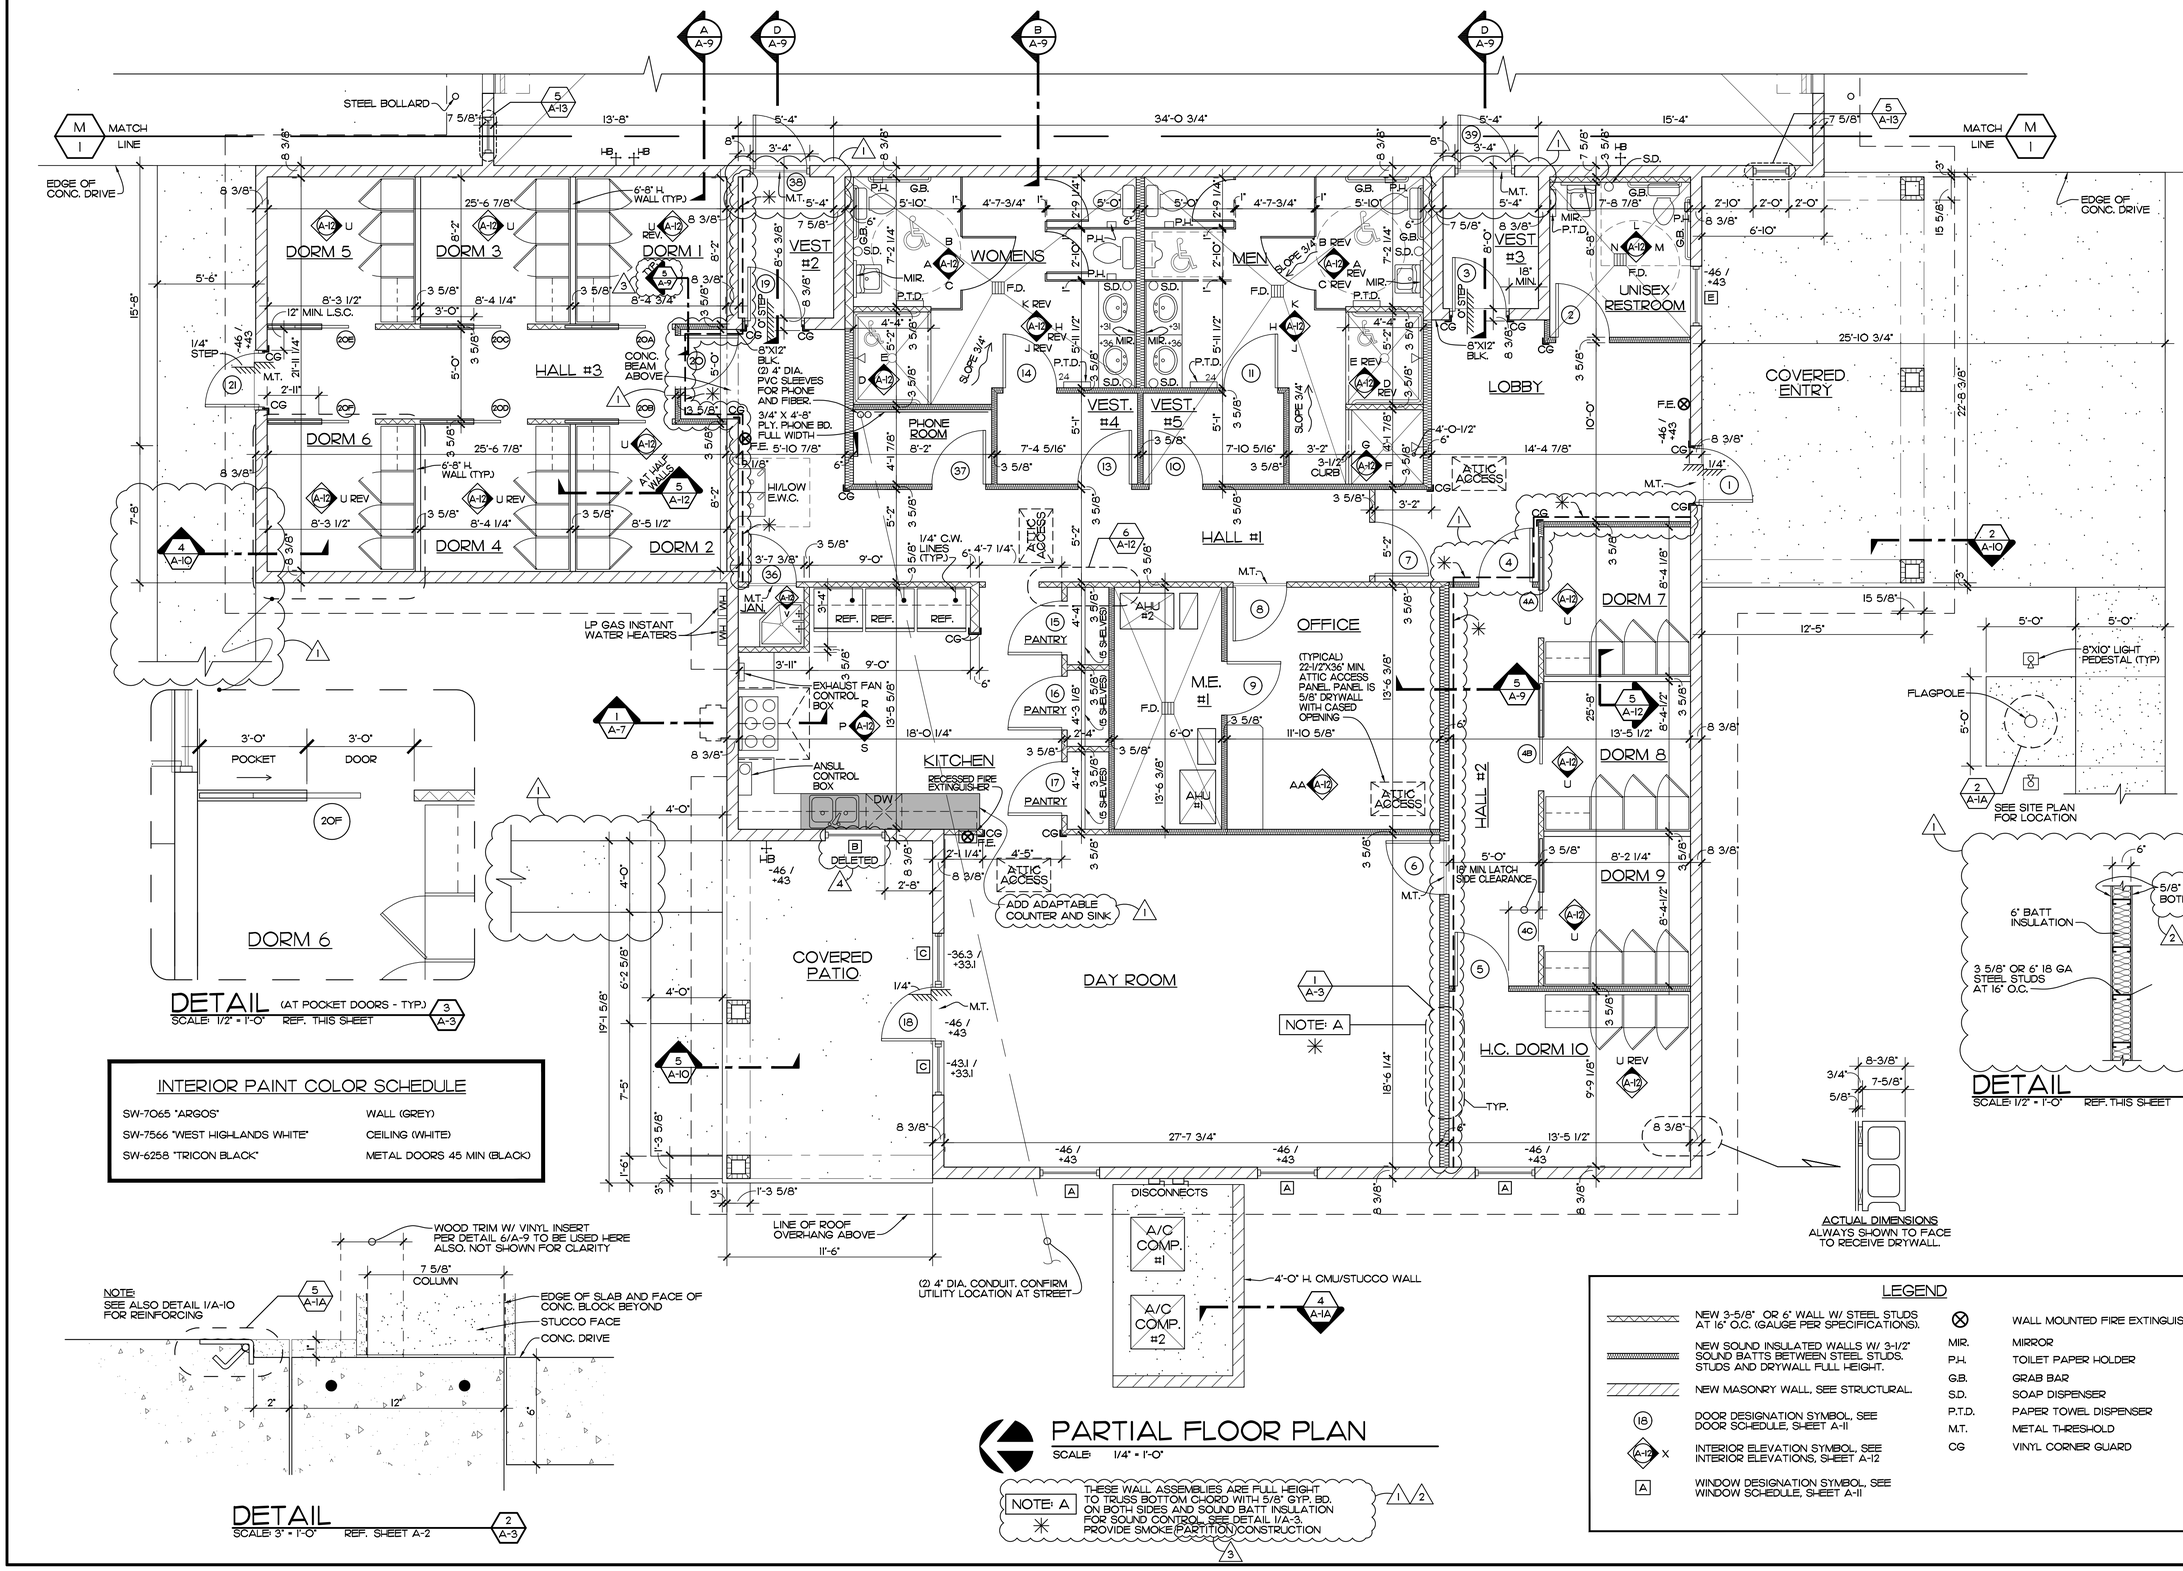

INTERIOR PAINT COLOR SCHEDULE

SW-7065 "ARGOS"	WALL (GREY)
SW-7566 "WEST HIGHLANDS WHITE"	CEILING (WHITE)
SW-6258 "TRICON BLACK"	METAL DOORS 45 MIN (BLACK)

PARTIAL FLOOR PLAN

SCALE: 1/4" = 1'-0"

NOTE: A — THESE WALL ASSEMBLIES ARE FULL HEIGHT TO TRUSS BOTTOM CHORD WITH 5/8" GYP. BD. ON BOTH SIDES AND SOUND BATT INSULATION FOR SOUND CONTROL. SEE DETAIL 1/A-3. PROVIDE SMOKE/PARTITION CONSTRUCTION 1 2 3

LEGEND

- NEW 3-5/8" OR 6" WALL W/ STEEL STUDS AT 16" O.C. (GAUGE PER SPECIFICATIONS).
- NEW SOUND INSULATED WALLS W/ 3-1/2" SOUND BATTS BETWEEN STEEL STUDS. STUDS AND DRYWALL FULL HEIGHT.
- NEW MASONRY WALL, SEE STRUCTURAL.
- (18) DOOR DESIGNATION SYMBOL, SEE DOOR SCHEDULE, SHEET A-11
- A-12 X INTERIOR ELEVATION SYMBOL, SEE INTERIOR ELEVATIONS, SHEET A-12
- A WINDOW DESIGNATION SYMBOL, SEE WINDOW SCHEDULE, SHEET A-11

⊗	WALL MOUNTED FIRE EXTINGUISHER
MIR.	MIRROR
P.H.	TOILET PAPER HOLDER
G.B.	GRAB BAR
S.D.	SOAP DISPENSER
P.T.D.	PAPER TOWEL DISPENSER
M.T.	METAL THRESHOLD
CG	VINYL CORNER GUARD

EDLUND · DRITENBAS · BINKLEY
ARCHITECTS AND ASSOCIATES, P.A.
AR-AA C000886
65 ROYAL PALM POINTE, SUITE "D"
VERO BEACH, FLORIDA 32960
PHONE: (772) 569-4320

ARCHITECTS EDB AND ASSOCIATES

SEAL:


PROJECT: STATION #15 — FOR: INDIAN RIVER COUNTY FIRE RESCUE/EMS
9010 87TH ST
VERO BEACH, FL 32967

NO:	DATE	REVISIONS
A	6/23/26	ADDENDUM REVISIONS
A	12/10/25	BLDG DEPT REVISIONS
A	12/8/25	FIRE PREVENTION COMMENTS REVISIONS
A	11/20/25	BLDG DEPT REVISIONS

© JULY '25 THESE PLANS AND THE INFORMATION SHOWN HEREIN ARE THE PROPERTY OF EDLUND DRITENBAS BINKLEY ARCHITECTS, P.A. AND REPRODUCTIONS, DISCLOSURES OR USE THEREOF IN WHOLE OR IN PART IS EXPRESSLY PROHIBITED WITHOUT WRITTEN PERMISSION.

COMM. NO: 070424VB
DATE: JULY 2, 2025
BY: LJD
CH'KD: JFB

SHEET NO. A-3 OF FOURTEEN

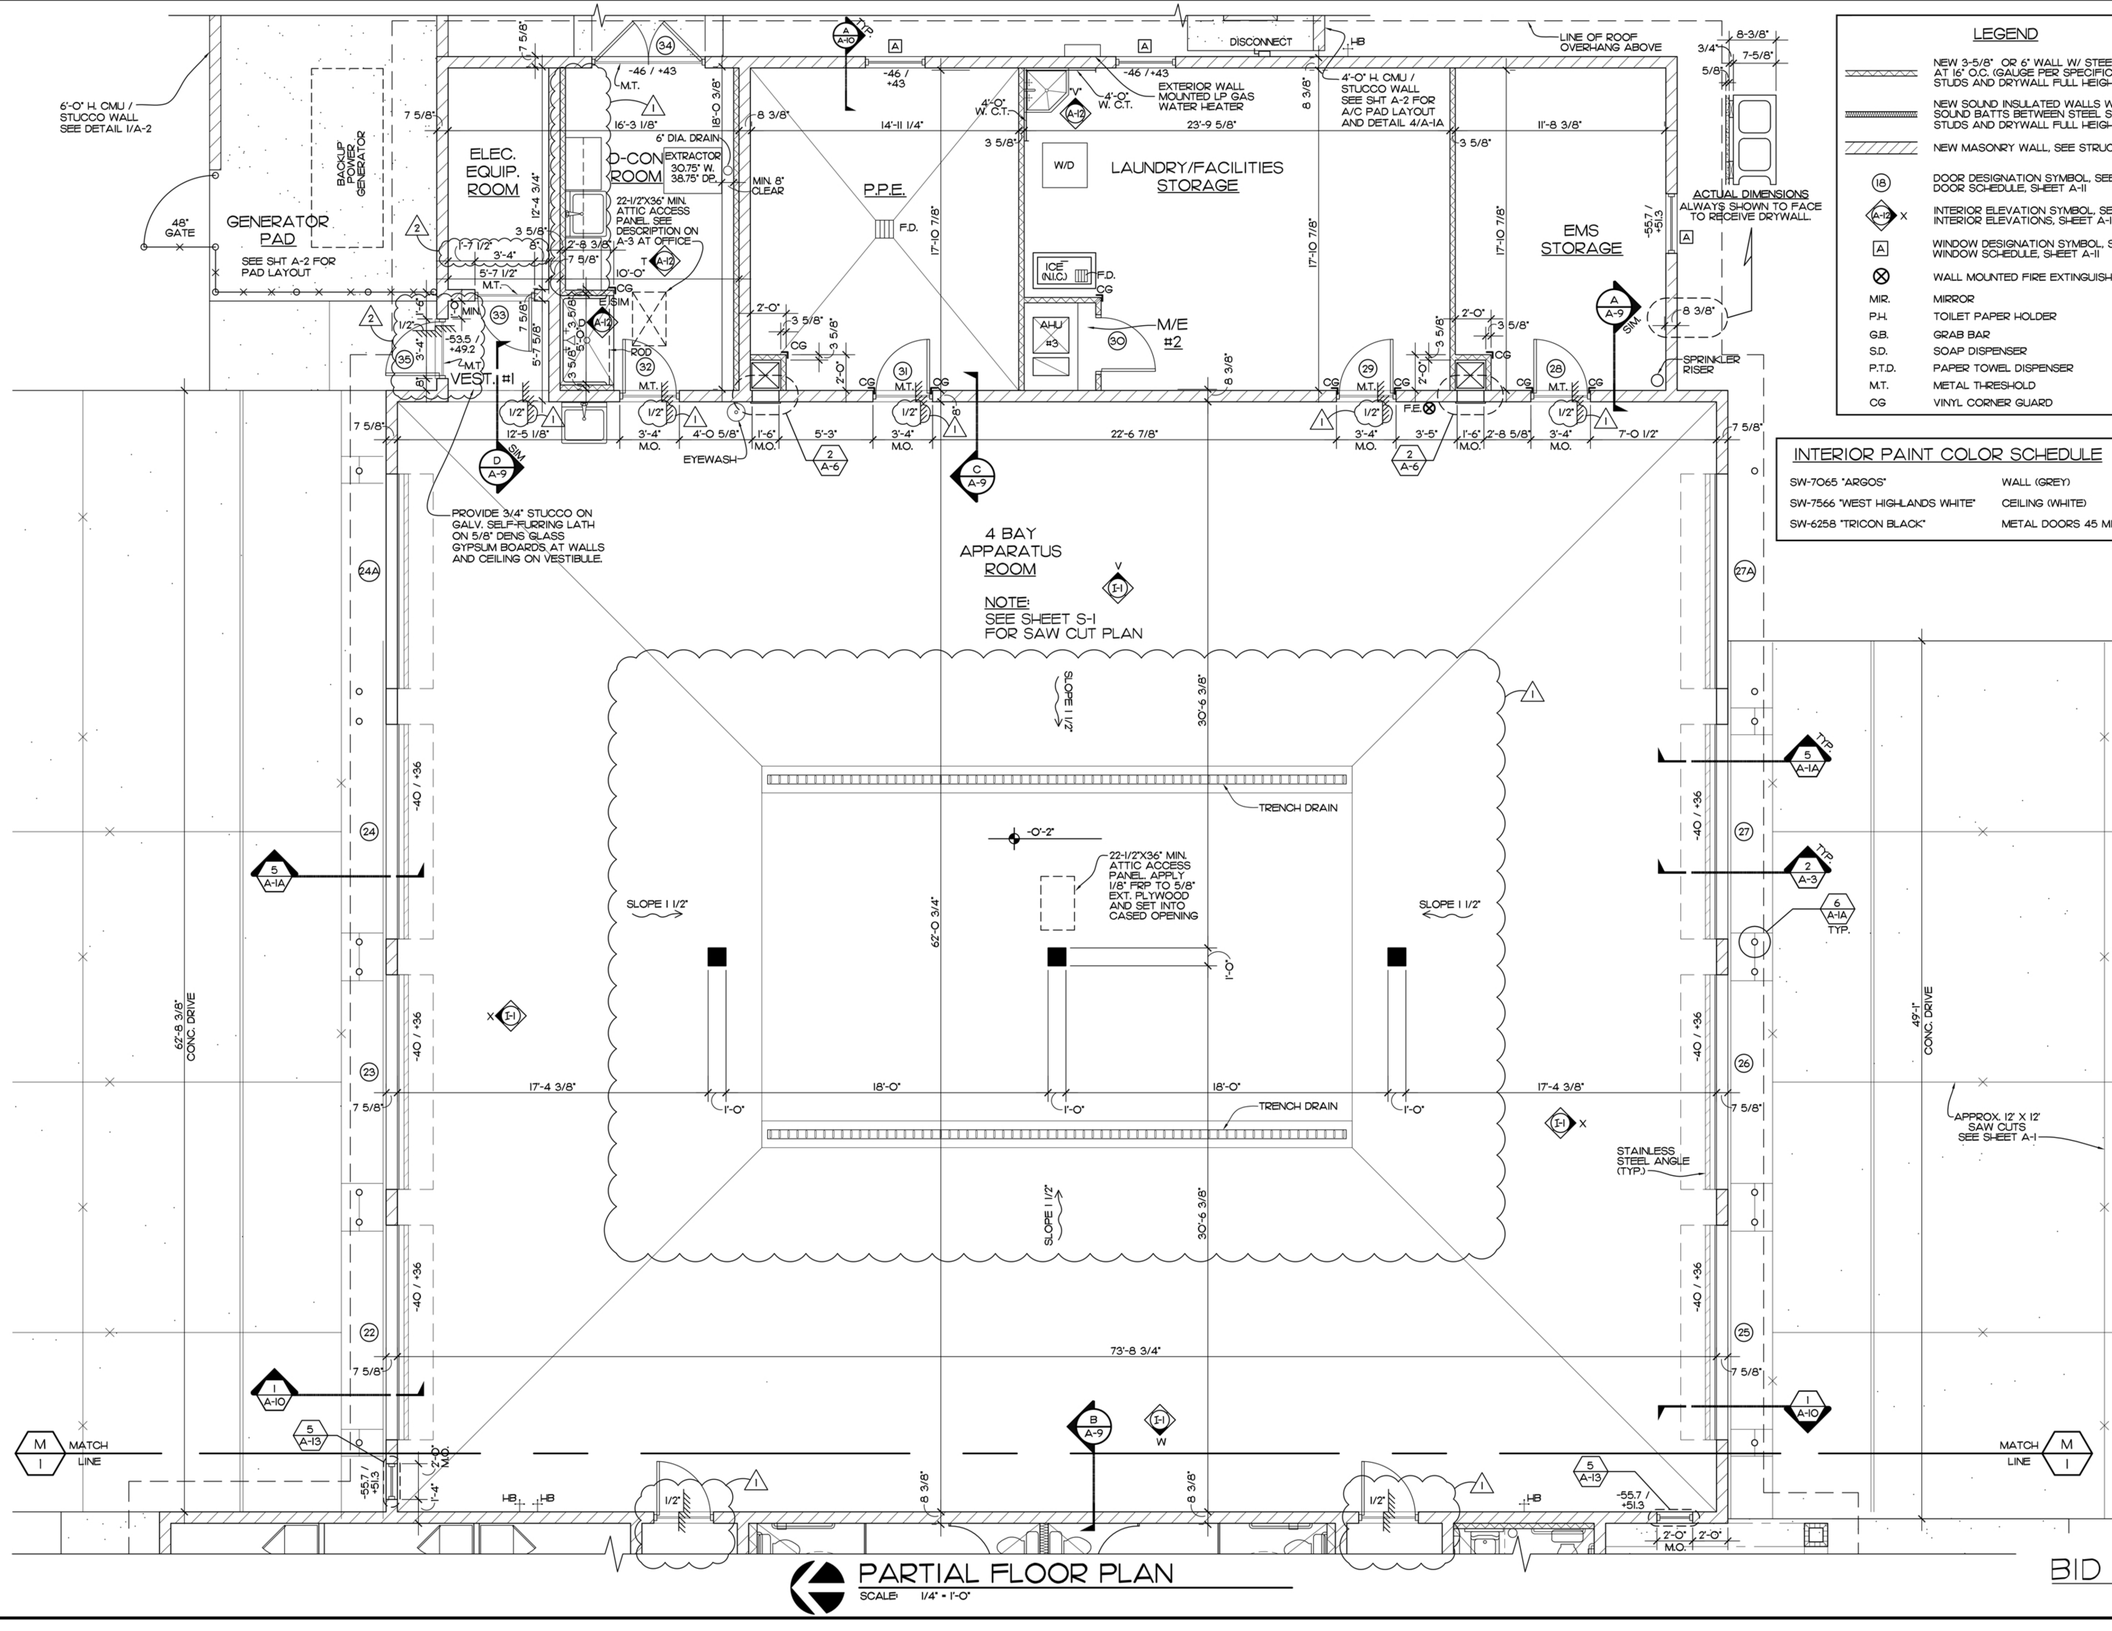

PARTIAL FLOOR PLAN

SCALE: 1/4" = 1'-0"

BID SET

LEGEND

- NEW 3-5/8" OR 6" WALL W/ STEEL STUDS AT 16" O.C. (GAUGE PER SPECIFICATIONS). STUDS AND DRYWALL FULL HEIGHT.
- NEW SOUND INSULATED WALLS W/ 3-1/2" SOUND BATTS BETWEEN STEEL STUDS. STUDS AND DRYWALL FULL HEIGHT.
- NEW MASONRY WALL, SEE STRUCTURAL.
- (18) DOOR DESIGNATION SYMBOL, SEE DOOR SCHEDULE, SHEET A-11
- (A-12 / X) INTERIOR ELEVATION SYMBOL, SEE INTERIOR ELEVATIONS, SHEET A-12
- [A] WINDOW DESIGNATION SYMBOL, SEE WINDOW SCHEDULE, SHEET A-11
- ⊗ WALL MOUNTED FIRE EXTINGUISHER
- MIR. MIRROR
- P.H. TOILET PAPER HOLDER
- G.B. GRAB BAR
- S.D. SOAP DISPENSER
- P.T.D. PAPER TOWEL DISPENSER
- M.T. METAL THRESHOLD
- CG VINYL CORNER GUARD

INTERIOR PAINT COLOR SCHEDULE

SW-7065 "ARGOS"	WALL (GREY)
SW-7566 "WEST HIGHLANDS WHITE"	CEILING (WHITE)
SW-6258 "TRICON BLACK"	METAL DOORS 45 MIN (BLACK)

EDLUND · DRITENBAS · BINKLEY
ARCHITECTS AND ASSOCIATES, P.A.
AR-AA C000886
65 ROYAL PALM POINTE, SUITE "D"
VERO BEACH, FLORIDA 32960
PHONE: (772) 569-4320

EDB ARCHITECTS AND ASSOCIATES

SEAL: STATE OF FLORIDA REGISTERED ARCHITECT 9548 JOHN P. BINKLEY

PROJECT: STATION #15


FOR: INDIAN RIVER COUNTY FIRE RESCUE/EMS
9010 87TH ST
VERO BEACH, FL 32967

NO:	DATE	REVISIONS
A	1/8/26	BLDG DEPT REVISIONS
1	11/20/25	BLDG DEPT REVISIONS

© E.D.B. '25. THESE PLANS AND THE INFORMATION SHOWN HEREIN ARE THE PROPERTY OF EDLUND DRITENBAS BINKLEY ARCHITECTS, P.A. AND REPRODUCTIONS, DISCLOSURES OR USE THEREOF IN WHOLE OR IN PART IS EXPRESSLY PROHIBITED WITHOUT WRITTEN PERMISSION.


COMM. NO: 070424VB
DATE: JULY 2, 2025
BY: LJD
CH'KD: JFB

SHEET NO.
A-4
OF FOURTEEN

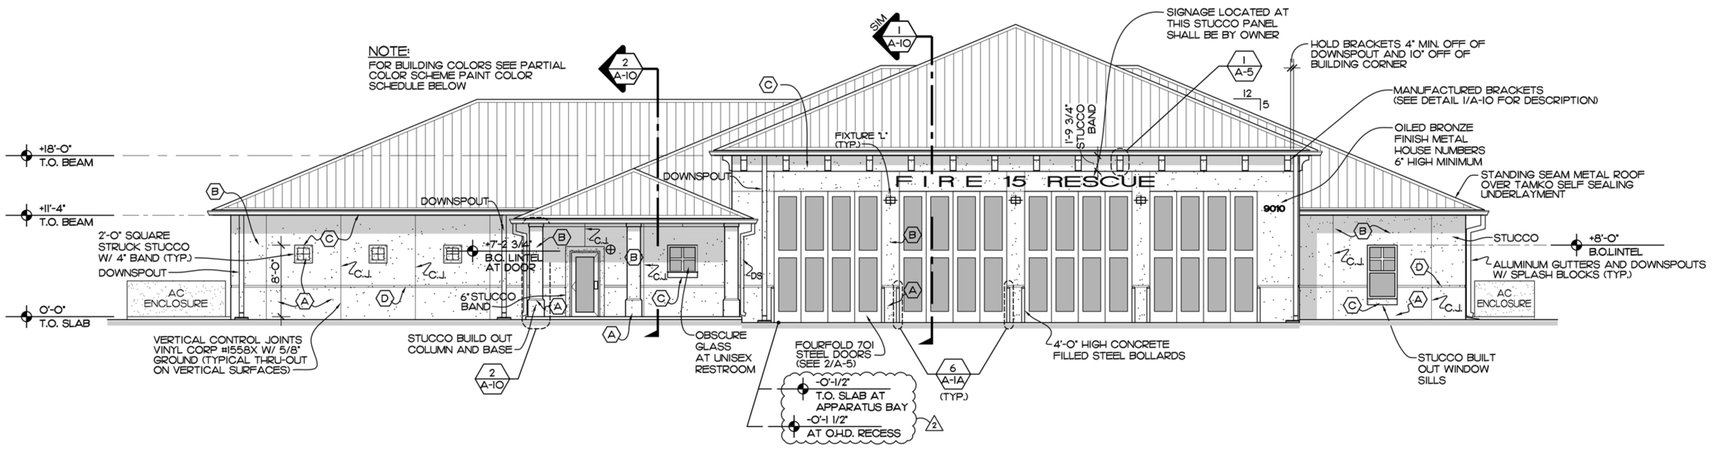


SOUTH ELEVATION

SCALE: 1/8" = 1'-0"

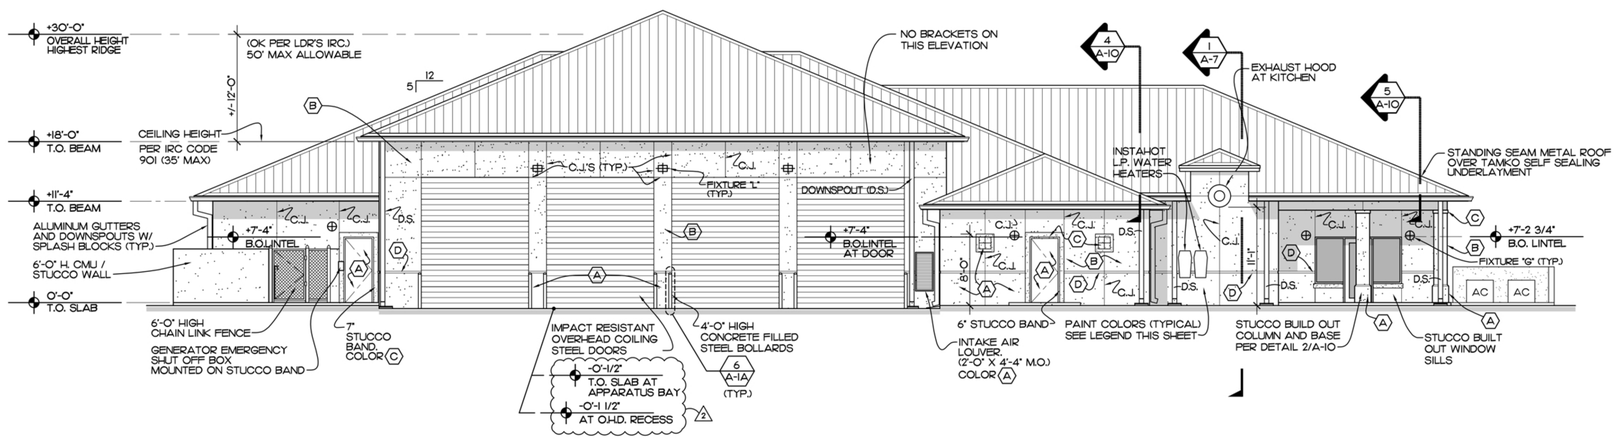


NORTH ELEVATION

SCALE: 1/8" = 1'-0"

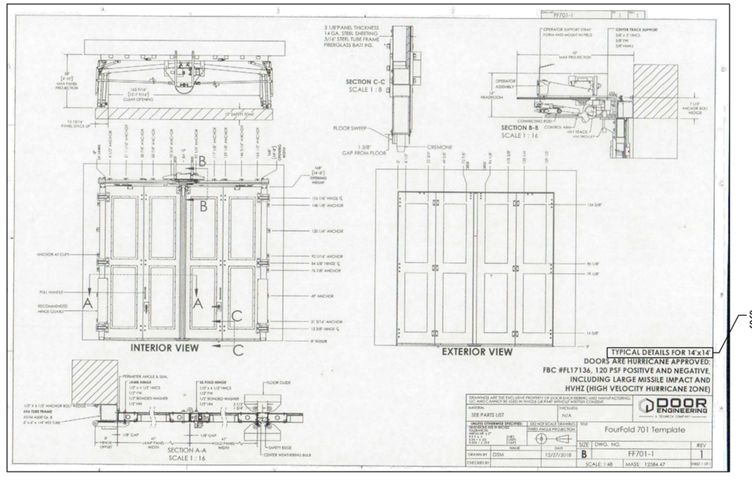

DETAIL

SCALE: NTS REF. THIS SHEET, A-11 (2/A-5)

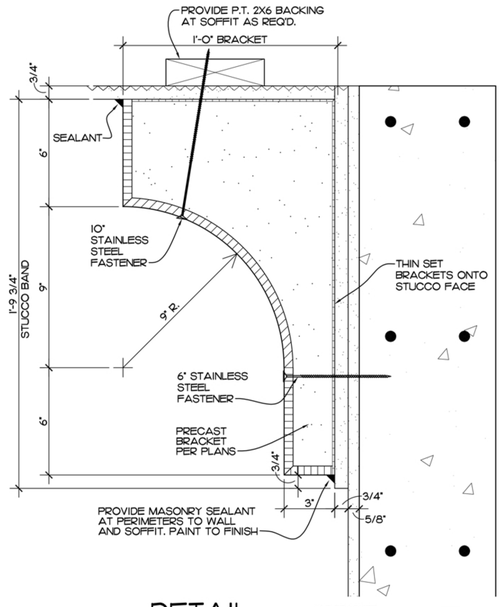

DETAIL

(AT BRACKET)

SCALE: 3" = 1'-0" REF. THIS SHEET, DTL 1/A-10 (1/A-5)

GENERAL NOTE:
WHEN UTILIZING LIGHTWEIGHT FOAM BRACKETS, SECURE WITH STAINLESS STEEL FACE FASTENERS. GROUT HOLES AND PAINT.

LIGHT FIXTURE MOUNTING HEIGHTS

"L" WALL PACKS AT APPARATUS BAY +15'-0" A.F.F. ON REAR ELEVATION AND 13'-6" ON FRONT ELEVATION.
"G" WALL FIXTURES AT ENTRY/EXITS +7'-0" AND 9'-2" A.F.F.*

NOTE:
HEIGHTS SHOWN ARE TO BOTTOM OF J-BOX ROUGH-IN.

* 9'-2" AT DOOR TO ELECTRICAL EQUIPMENT ROOM.

PAINT COLOR SCHEDULE

A	SW-7518 "BEACH HOUSE"	BASE STUCCO COLOR STEEL DOORS/FRAMES
B	SW-7558 "MEDICI IVORY"	STUCCO FIELD COLOR
C	SW-7566 "WEST HIGHLANDS WHITE"	STUCCO TRIMS / BUILD OUTS / BRACKETS / FASCIA
D	SW-6868 "REAL RED"	PAINT STUCCO RECESS RED

NOTE:
ALL CONTROL JOINT INTERSECTIONS SHALL BE SET INTO SEALANT BED. SEALANT SHALL BE EXTERIOR RATED, PAINTABLE. DO NOT FILL TH-ROATS OF CONTROL JOINTS WITH SEALANT WHEN PAINTING STUCCOED WALLS.

BID SET

EDLUND · DRITENBAS · BINKLEY
ARCHITECTS AND ASSOCIATES, P.A.
AR-AA C000886
65 ROYAL PALM POINTE, SUITE "D"
VERO BEACH, FLORIDA 32960
PHONE: (772) 569-4320

ARCHITECTS EDB AND ASSOCIATES

SEAL: STATE OF FLORIDA REGISTERED ARCHITECT 9548 JOHN F. BINKLEY

PROJECT: STATION #15

FOR: INDIAN RIVER COUNTY FIRE RESCUE/EMS
9010 87TH ST
VERO BEACH, FL 32967


NO:	DATE	REVISIONS
2	12/10/25	BLDG DEPT REVISIONS
1	02JUL25	TRC COMMENTS

© JULY '25. THESE PLANS AND THE INFORMATION SHOWN HEREIN ARE THE PROPERTY OF EDLUND DRITENBAS BINKLEY ARCHITECTS, P.A. AND REPRODUCTIONS, DISCLOSURES OR USE THEREOF IN WHOLE OR IN PART IS EXPRESSLY PROHIBITED WITHOUT WRITTEN PERMISSION.

COMM. NO: 07042AVB
DATE: JULY 2, 2025
BY: LJD
CH'KD: JFB

SHEET NO.
A-5
OF FOURTEEN

NOTE:
FOR BUILDING PAINT COLORS
SEE REAR ELEVATION AND
PAINT SCHEDULE ON SHEET A-5

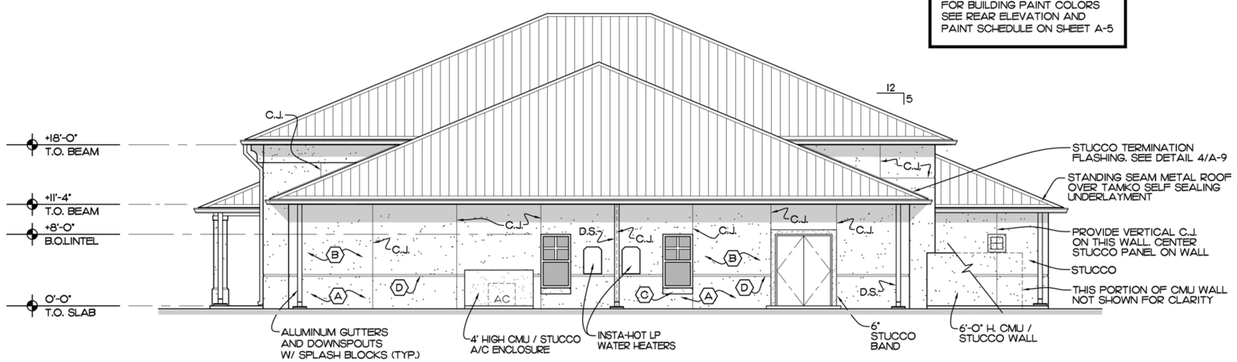


EAST ELEVATION

SCALE: 1/8" = 1'-0"


PAINT COLOR SCHEDULE

A	SW-7518 "BEACH HOUSE"	BASE STUCCO COLOR STEEL DOORS/FRAMES
B	SW-7558 "MEDICI IVORY"	STUCCO FIELD COLOR
C	SW-7566 "WEST HIGHLANDS WHITE"	STUCCO TRIMS / BUILD OUTS / BRACKETS / FASCIA
D	SW-6868 "REAL RED"	PAINT STUCCO RECESS RED

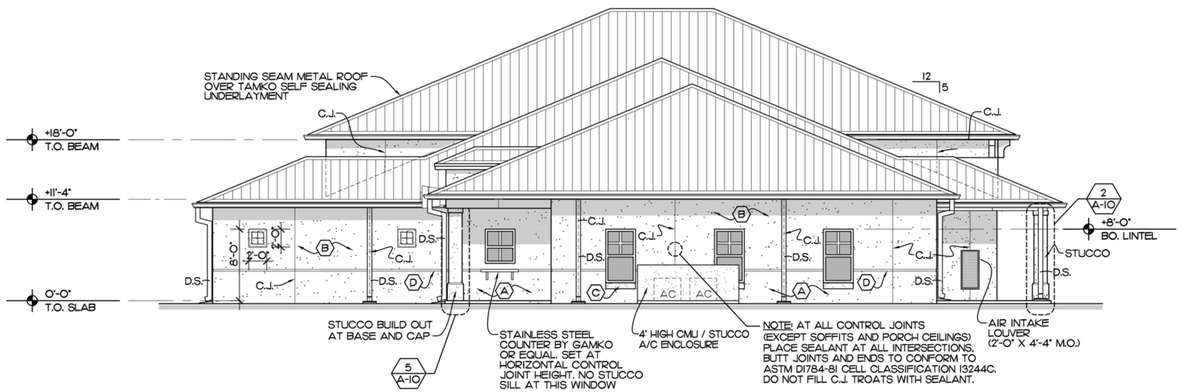

WEST ELEVATION

SCALE: 1/8" = 1'-0"

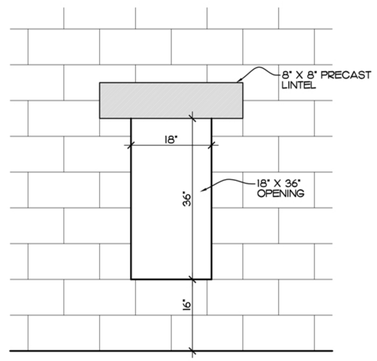

DETAIL

SCALE: 3/4" = 1'-0" REF. SHEET A-4 (2/A-6)

BID SET

EDLUND · DRITENBAS · BINKLEY
ARCHITECTS AND ASSOCIATES, P.A.
AR-AA C000886
65 ROYAL PALM POINTE, SUITE "D"
VERO BEACH, FLORIDA 32960
PHONE: (772) 569-4320

ARCHITECTS EDB AND ASSOCIATES

SEAL: STATE OF FLORIDA REGISTERED JOHN F. BINKLEY 5548


PROJECT: STATION #15
INDIAN RIVER COUNTY FIRE RESCUE/EMS
9010 87TH ST
VERO BEACH, FL 32967
FOR:

NO:	DATE	REVISIONS


© JULY '25. THESE PLANS AND THE INFORMATION SHOWN HEREIN ARE THE PROPERTY OF EDLUND DRITENBAS BINKLEY ARCHITECTS, P.A. AND REPRODUCTIONS, DISCLOSURES OR USE THEREOF IN WHOLE OR IN PART IS EXPRESSLY PROHIBITED WITHOUT WRITTEN PERMISSION.

COMM. NO: 070424VB
DATE: JULY 2, 2025
BY: LJD
CH'KD: JFB


SHEET NO.
A-6
OF FOURTEEN

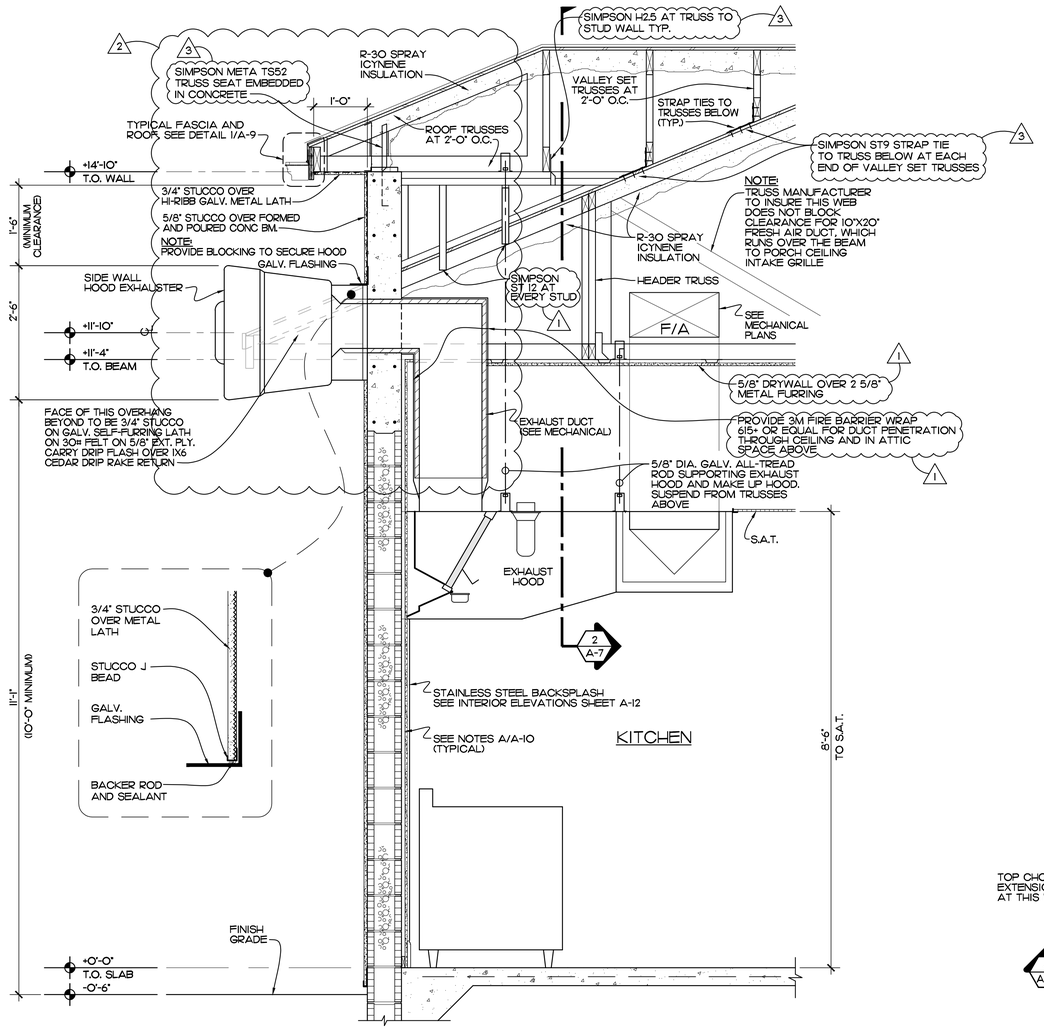


DETAIL
SCALE: 3/4" = 1'-0" REF. THIS SHEET 1 A-7

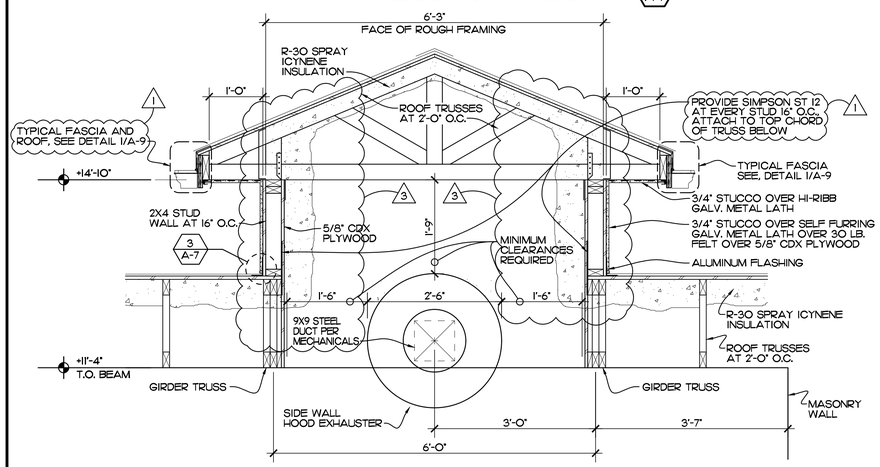

DETAIL
SCALE: 3/4" = 1'-0" REF. THIS SHEET 2 A-7

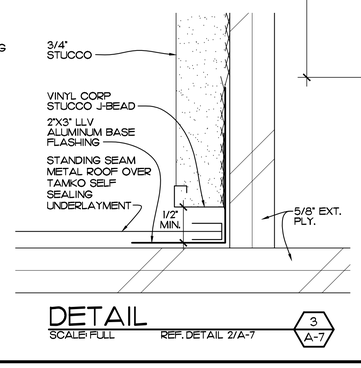

DETAIL
SCALE: FULL REF. DETAIL 2/A-7 3 A-7

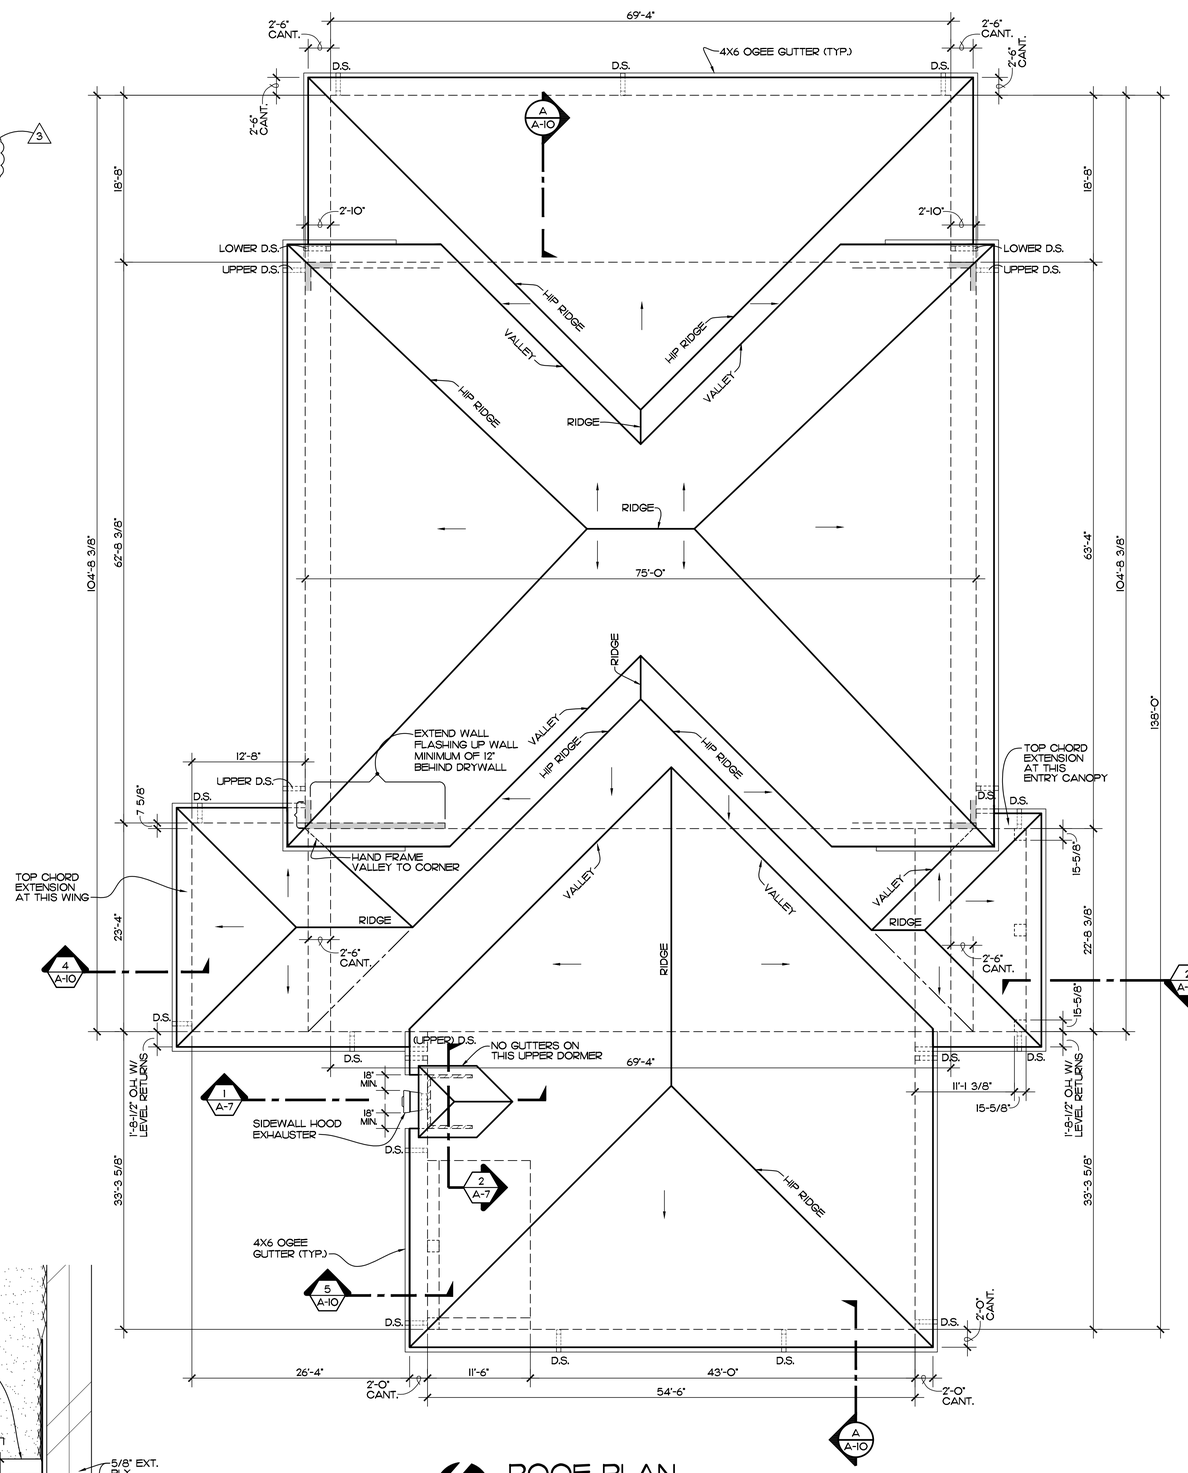

ROOF PLAN
SCALE: 1/8" = 1'-0"

NOTES:
D.S. = DOWNSPOUT

BID SET

EDLUND · DRITENBAS · BINKLEY
ARCHITECTS AND ASSOCIATES, P.A.
AR-AA C000886
65 ROYAL PALM POINTE, SUITE "D"
VERO BEACH, FLORIDA 32960
PHONE: (772) 569-4320

SEAL: STATE OF FLORIDA REGISTERED ARCHITECT 8545 JEFFREY P. BINKLEY


PROJECT: STATION #15
FOR: INDIAN RIVER COUNTY FIRE RESCUE/EMS
9010 57TH ST
VERO BEACH, FL 32967

NO:	DATE	REVISIONS
1	1/8/26	BLDG DEPT REVISIONS
2	12/10/25	BLDG DEPT REVISIONS
3	11/20/25	BLDG DEPT REVISIONS

© JULY 25 THESE PLANS AND THE INFORMATION SHOWN HEREIN ARE THE PROPERTY OF EDLUND DRITENBAS BINKLEY ARCHITECTS, P.A. AND REPRODUCTIONS, DISCLOSURES OR USE THEREOF IN WHOLE OR IN PART IS EXPRESSLY PROHIBITED WITHOUT WRITTEN PERMISSION.

COMM. NO: 070424VB
DATE: JULY 2, 2025
BY: LJD
CH'KD: JPB

SHEET NO.
A-7
OF FOURTEEN

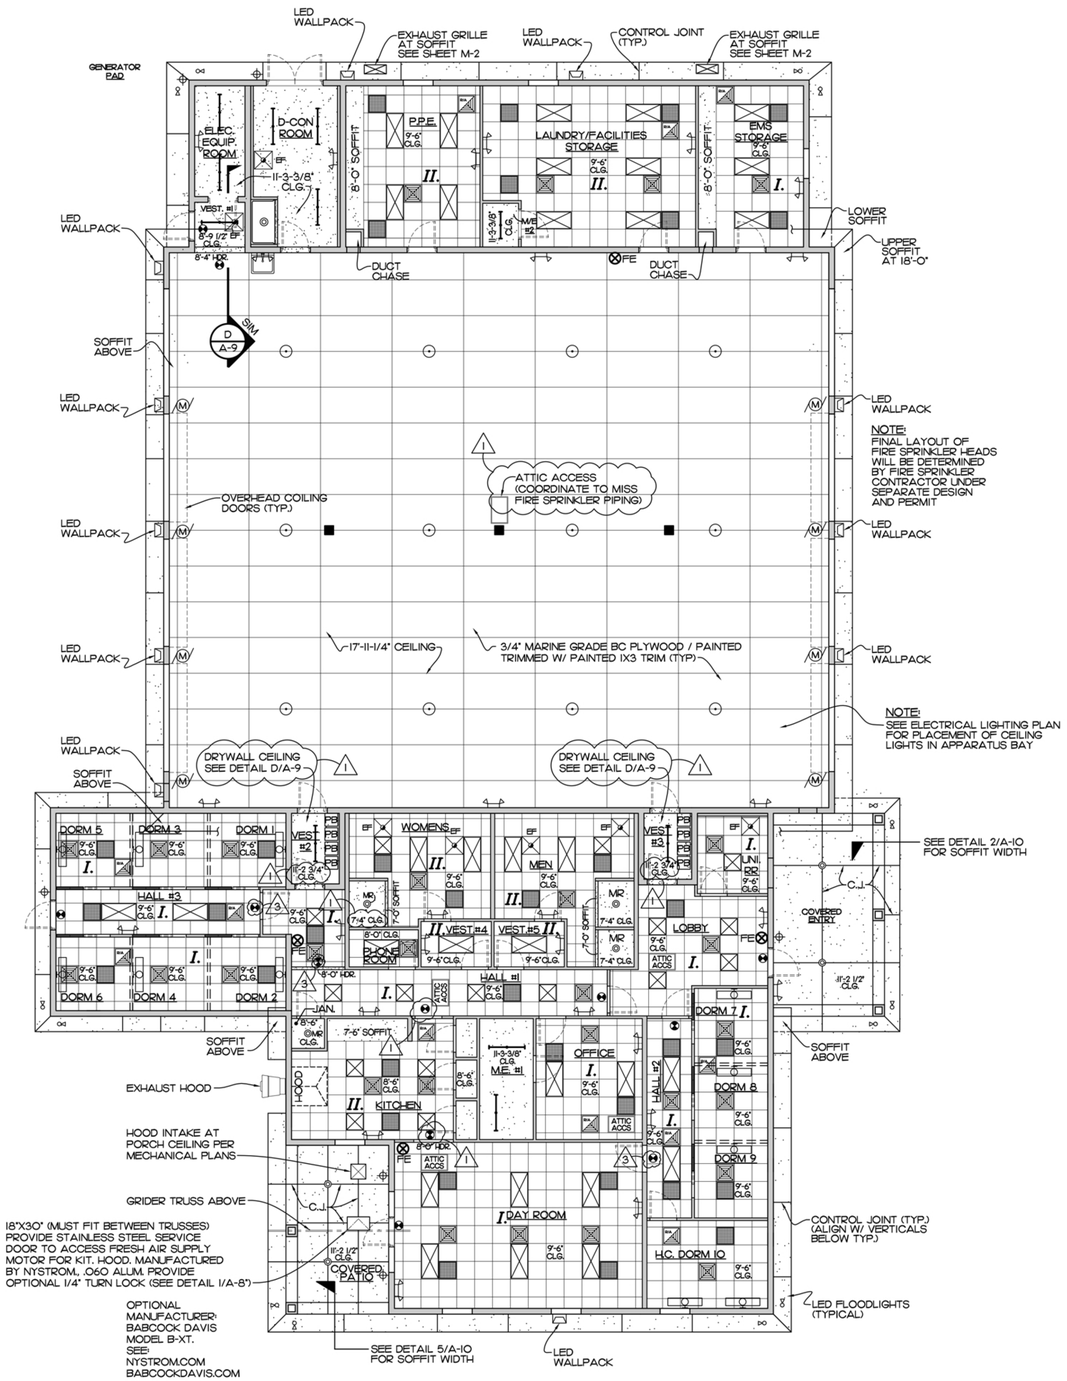

REFLECTED CEILING PLAN


SCALE: 1/8"= 1'-0"

CEILING TILE SCHEDULE

I.	TYPE I.	ARMSTRONG 24"X24"X7/8" CIRRUS OPEN PLAN 556, CLASS A WITH 15/16" ANGLED TEGULAR EDGE PROFILE. GRID - 15/16" PRELUDE. COLOR - WHITE.
II.	TYPE II.	ARMSTRONG 24"X24"X5/8" 607 CERAMIGUARD FINE FISSURED PERFORATED WITH WITH 15/16" SQUARE LAY-IN EDGE PROFILE. GRID - 15/16" AL PRELUDE PLUS XL. COLOR - WHITE.

LEGEND

RECESSED CAN LIGHT	
MOISTURE RESISTANT RECESSED CAN LIGHT	MR
PENDANT LIGHT	
SPRINKLER HEAD	
EMERGENCY EXIT LIGHT WITH BATTERY BACKUP	
2X4 LAY-IN LED LIGHT	
SURFACE MOUNTED LED LIGHT	
WALL MOUNTED LED LIGHT	
WALLPACK LIGHT FIXTURE	
SURFACE MOUNTED FLUORESCENT FIXTURE	
A/C REGISTER	
RETURN AIR REGISTER	
EXHAUST FAN	
WALL MOUNTED FIXTURE	
EXTERIOR SPOTLIGHT	
PUSH BUTTON SWITCH FOR OVER-HEAD DOOR	PB
OVER-HEAD DOOR MOTOR	M
MILK-WHITE EGG CRATE LAY-IN 24"X24" PANEL (FIELD LOCATE)	
EMERGENCY LIGHT W/BATTERY BACKUP	
WALL MOUNTED FIRE EXTINGUISHER	FE

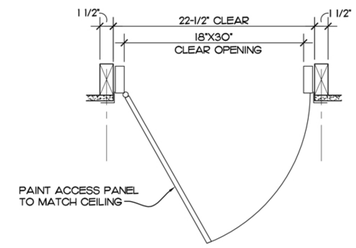

DETAIL (AT CEILING ACCESS) 1/A-8

SCALE: 1-1/2" = 1'-0" REF. THIS SHEET

BID SET

EDLUND · DRITENBAS · BINKLEY
ARCHITECTS AND ASSOCIATES, P.A.
AR-AA C000886
65 ROYAL PALM POINTE, SUITE "D"
VERO BEACH, FLORIDA 32960
PHONE: (772) 569-4320

ARCHITECTS EDB AND ASSOCIATES


PROJECT: STATION #15


FOR: INDIAN RIVER COUNTY FIRE RESCUE/EMS
9010 67TH ST
VERO BEACH, FL 32967

NO:	DATE	REVISIONS
1	11/20/25	BLDG DEPT REVISIONS


© JULY '25. THESE PLANS AND THE INFORMATION SHOWN HEREIN ARE THE PROPERTY OF EDLUND DRITENBAS BINKLEY ARCHITECTS, P.A. AND REPRODUCTIONS, DISCLOSURES OR USE THEREOF IN WHOLE OR IN PART IS EXPRESSLY PROHIBITED WITHOUT WRITTEN PERMISSION.

COMM. NO: 070424VB
DATE: JULY 2, 2025
BY: LJD
CH'KD: JPB


SHEET NO. A-8 OF FOURTEEN

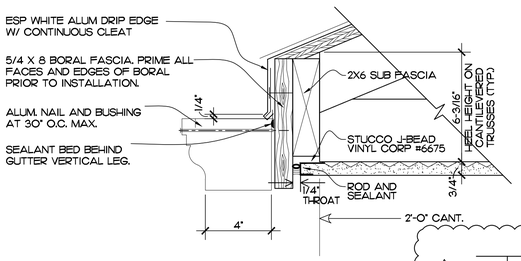


DETAIL
SCALE: 3" = 1'-0" REF. SECT. A/A-10 — 1 / A-9

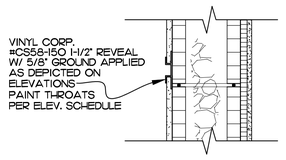


DETAIL
SCALE: 1-1/2" = 1'-0" REF. SECT. A/A-10 — 2 / A-9

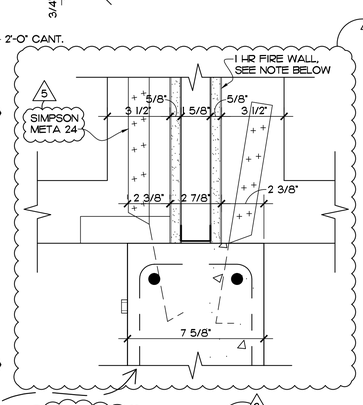

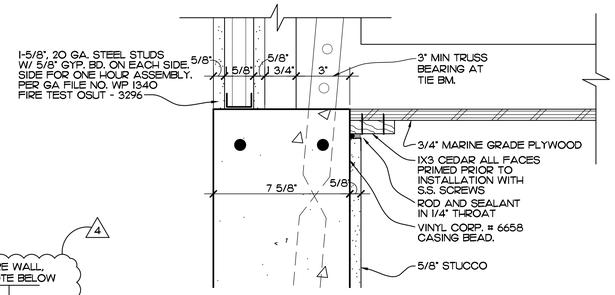


DETAIL
SCALE: 3" = 1'-0" REF. THIS SHEET — 3 / A-9


NOTE:
INFORM TRUSS FABRICATOR OF THIS CONDITION.

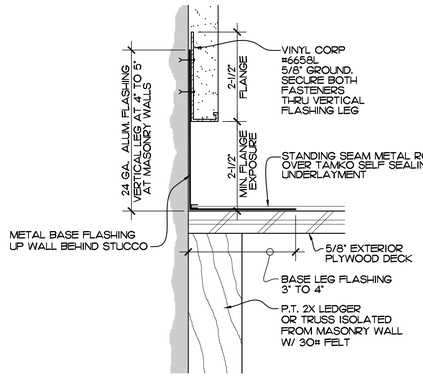


STUCCO TERMINATION AT ADJACENT WALLS
SCALE: HALF SIZE REF. SECTION A/A-9 — 4 / A-9

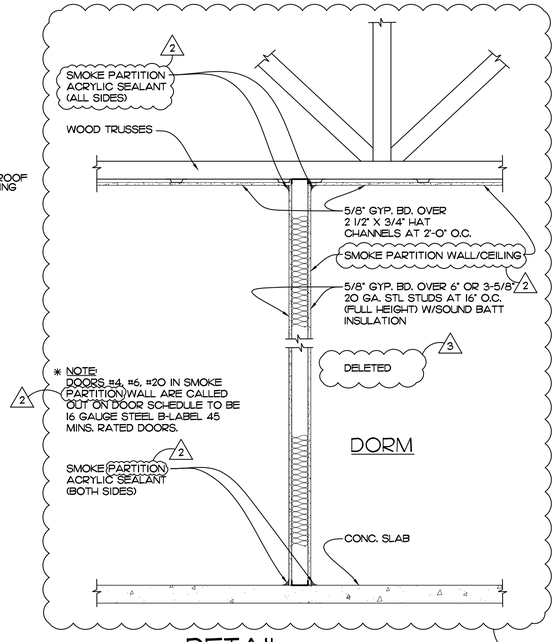

DETAIL
SCALE: 3/4" = 1'-0" REF. SHEET A-4 — 5 / A-9

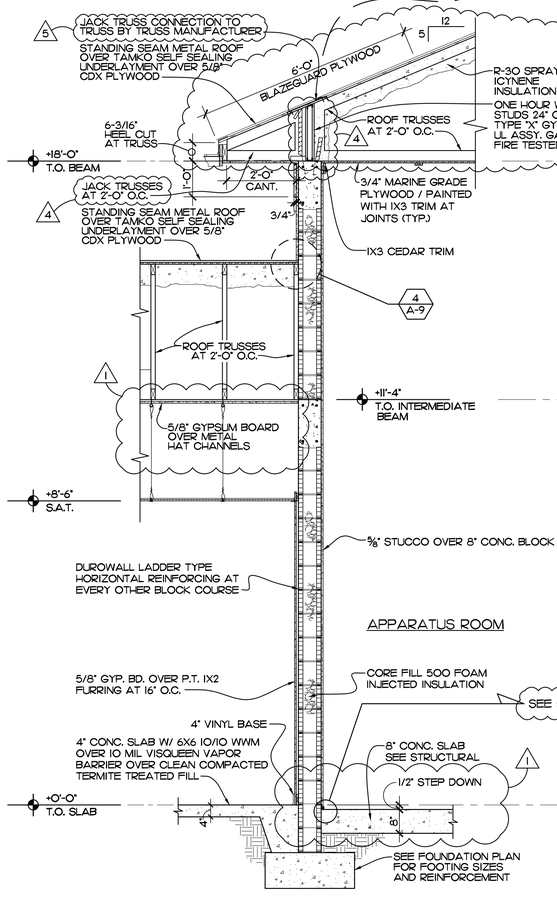


SECTION
SCALE: 1/2" = 1'-0" REF: A-2 — A / A-9

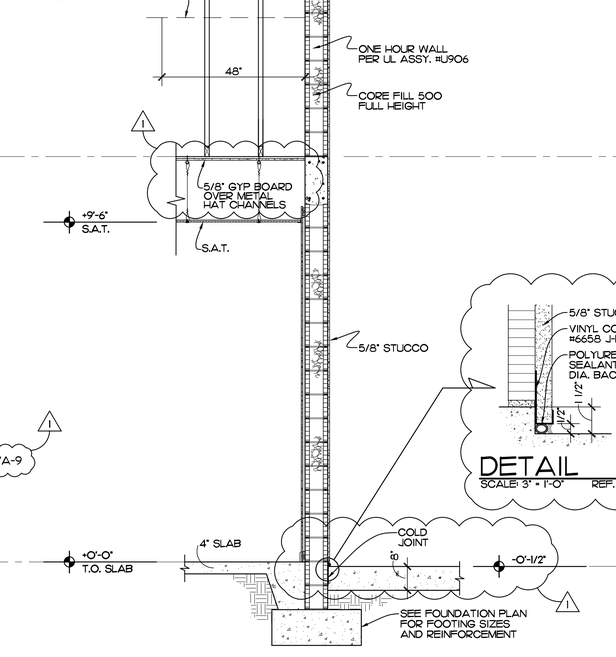


DETAIL
SCALE: 3" = 1'-0" REF. — 5 / A-9

SECTION
SCALE: 1/2" = 1'-0" REF: A-4 — B / A-9

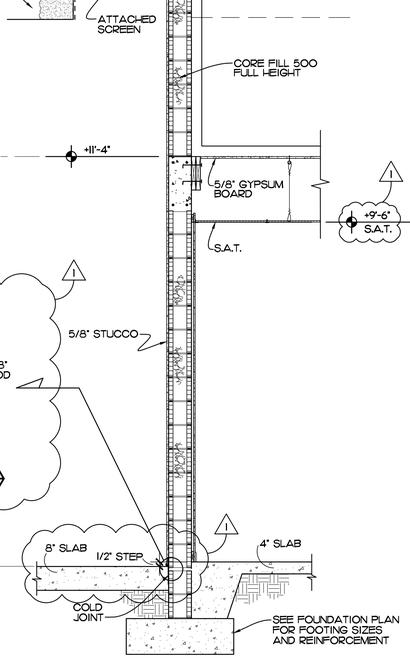

SECTION
SCALE: 1/2" = 1'-0" REF: A-4 — C / A-9

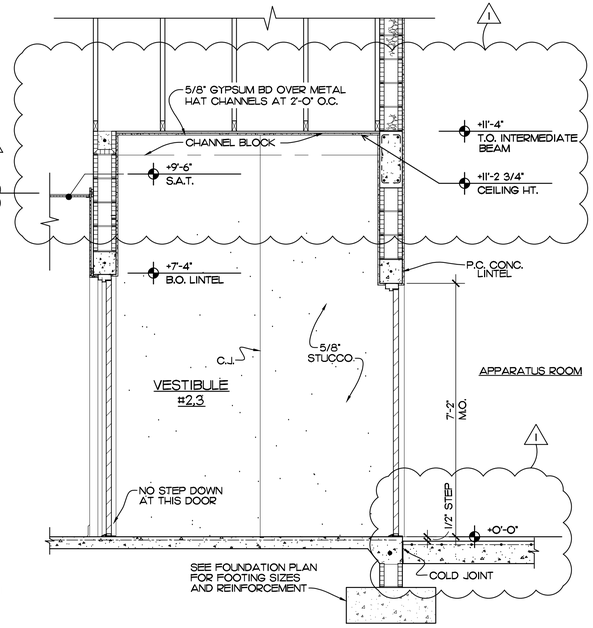

SECTION
SCALE: 1/2" = 1'-0" REF: A-3, A-4 — D / A-9

BID SET

EDLUND · DRITENBAS · BINKLEY
ARCHITECTS AND ASSOCIATES, P.A.
AR-AA C000886
65 ROYAL PALM POINTE, SUITE "D"
VERO BEACH, FLORIDA 32960
PHONE: (772) 569-4320

EDB ARCHITECTS AND ASSOCIATES

SEAL: STATE OF FLORIDA REGISTERED ARCHITECT JEFFREY F. BINKLEY 8545


PROJECT: STATION #15
FOR: INDIAN RIVER COUNTY FIRE RESCUE/EMS
9010 57TH ST
VERO BEACH, FL 32967

NO:	DATE	REVISIONS
6	2/26/26	BLDG DEPT REVISIONS
5	1/28/26	BLDG DEPT REVISIONS
4	1/8/26	BLDG DEPT REVISIONS
3	12/10/25	BLDG DEPT REVISIONS
2	11/20/25	BLDG DEPT REVISIONS
1		


© JULY 25 THESE PLANS AND THE INFORMATION SHOWN HEREIN ARE THE PROPERTY OF EDLUND DRITENBAS BINKLEY ARCHITECTS, P.A. AND REPRODUCTIONS, DISCLOSURES OR USE THEREOF IN WHOLE OR IN PART IS EXPRESSLY PROHIBITED WITHOUT WRITTEN PERMISSION.

COMM. NO: 070424VB
DATE: JULY 2, 2025
BY: LJD
CH'KD: JFB


SHEET NO.
A-9
OF FOURTEEN

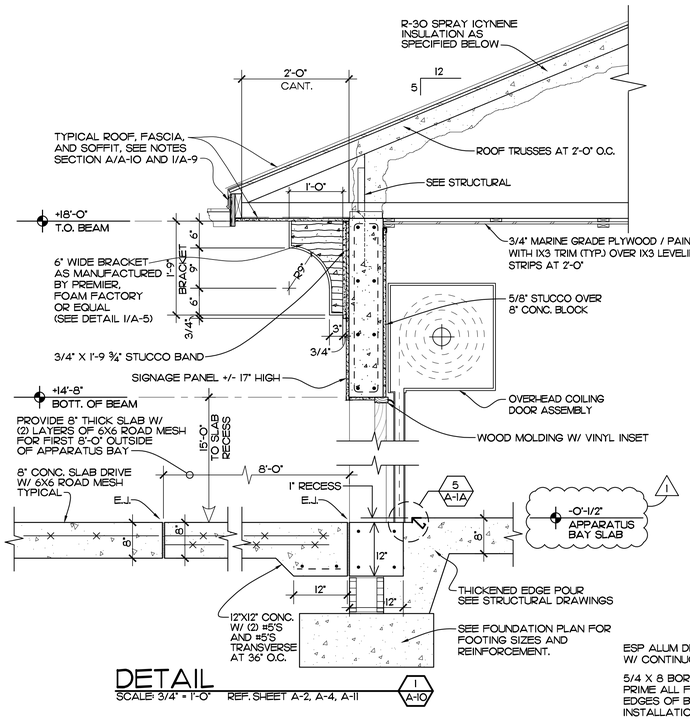


DETAIL
SCALE: 3/4" = 1'-0" REF. SHEET A-2, A-4, A-11 — 1 A-10

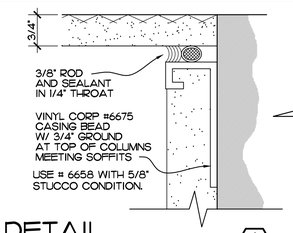


DETAIL
SCALE: FULL REF. THIS SHEET — 6 A-10

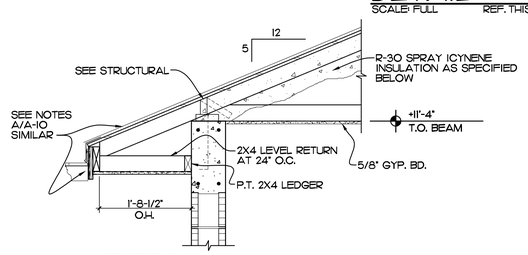


DETAIL
SCALE: 3/4" = 1'-0" REF. SHEET A-2 — 4 A-10

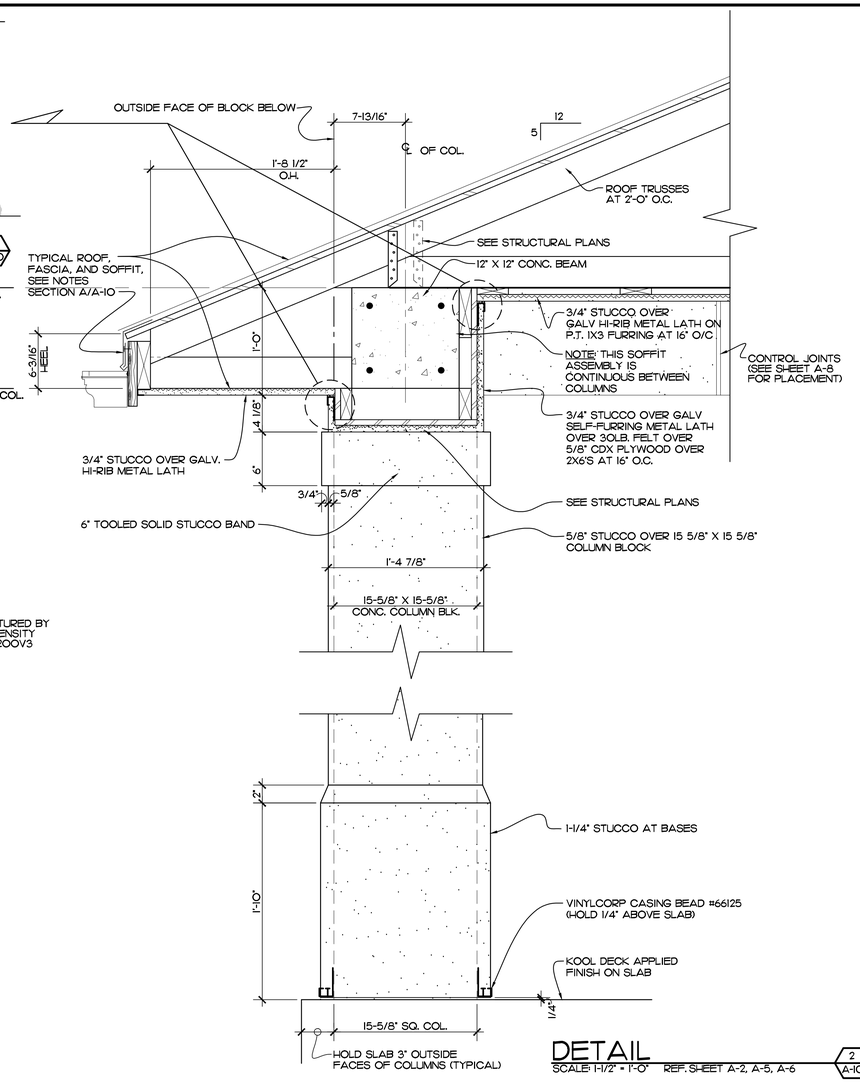

DETAIL
SCALE: 1-1/2" = 1'-0" REF. SHEET A-2, A-5, A-6 — 2 A-10

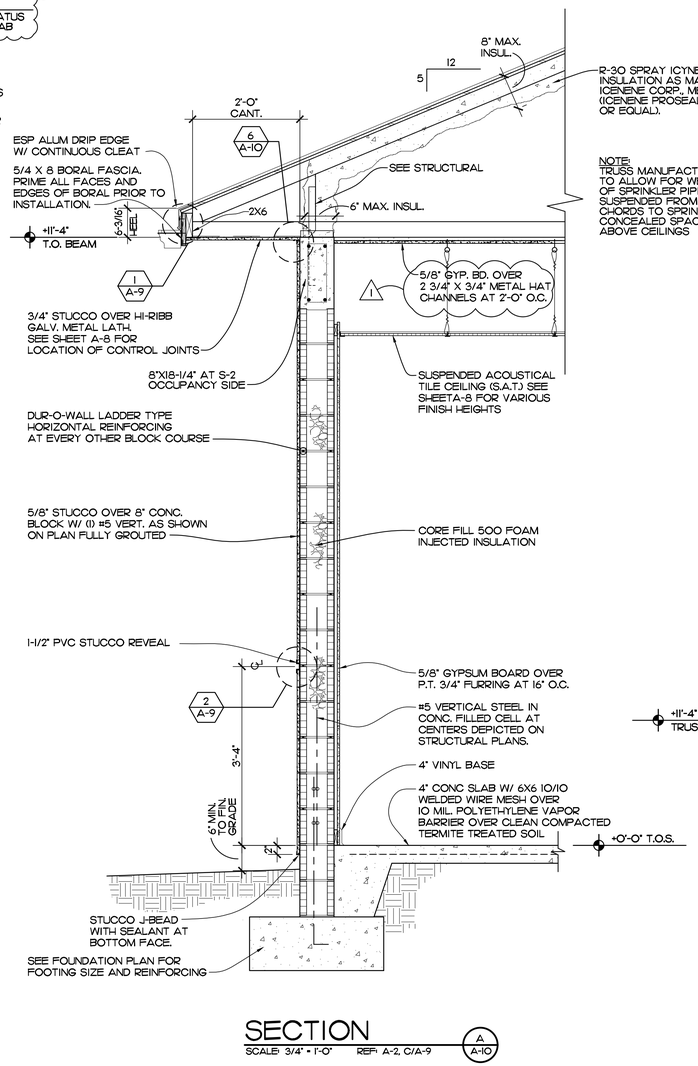

SECTION
SCALE: 3/4" = 1'-0" REF. A-2, C/A-9 — A A-10

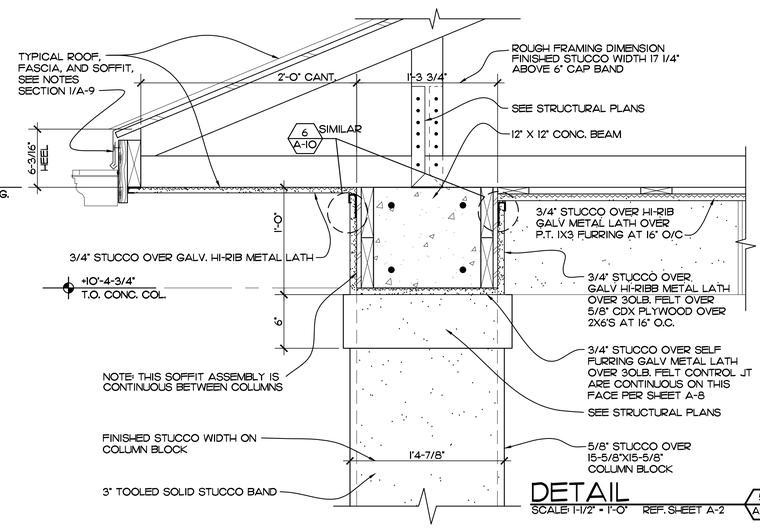

DETAIL
SCALE: 1-1/2" = 1'-0" REF. SHEET A-2 — 5 A-10

BID SET

EDLUND · DRITENBAS · BINKLEY
ARCHITECTS AND ASSOCIATES, P.A.
AR-AA C000886
65 ROYAL PALM POINTE, SUITE "D"
VERO BEACH, FLORIDA 32960
PHONE: (772) 569-4320

EDB ARCHITECTS AND ASSOCIATES

SEAL: STATE OF FLORIDA — REGISTERED ARCHITECT — JEFFREY F. BINKLEY — 8545

PROJECT: STATION #15
FOR: INDIAN RIVER COUNTY FIRE RESCUE/EMS
9010 67TH ST
VERO BEACH, FL 32967

NO:	DATE	REVISIONS
1	11/20/25	BLDG DEPT REVISIONS

© JULY '25 THESE PLANS AND THE INFORMATION SHOWN HEREIN ARE THE PROPERTY OF EDLUND DRITENBAS BINKLEY ARCHITECTS, P.A. AND REPRODUCTIONS, DISCLOSURES OR USE THEREOF IN WHOLE OR IN PART IS EXPRESSLY PROHIBITED WITHOUT WRITTEN PERMISSION.

COMM. NO: 07042418
DATE: JULY 2, 2025
BY: LJD
CH'KD: JFB

SHEET NO.
A-10
OF FOURTEEN

WINDOW SCHEDULE

MARK	SIZE (W X H)	MANUFACTURER	TYPE	DETAILS	SILL	REMARKS
A	3'-4" X 6'-0" M.O.	KAWNEER 350/500, HEAVY WALL IR LEVEL E STOREFRONT	FIXED STOREFRONT	5, 6 /A-14	MARBLE	ESP WHITE FRAME IMPACT RATED WITH DOUBLE APPLIED MUNTINS AT TOP PANEL ONLY
B	3'-4" X 3'-6" M.O.			5, 6 /A-14	MARBLE	ESP WHITE FRAME IMPACT RATED WITH DOUBLE APPLIED MUNTINS
C	3'-0" X 5'-0" FRAME DIMENSION SEE SHT. S-1 FOR M.O.			5, 6 /A-14	MARBLE	ESP WHITE FRAME, IMPACT RATED, DOUBLE APPLIED VERTICAL MUNTINS
✳ E	3'-4" X 3'-6" M.O.			5, 6 /A-14	MARBLE	ESP WHITE FRAME, IMPACT RATED, DOUBLE APPLIED VERTICAL MUNTINS

✳ PROVIDE OBSCURE GLASS AT UNISEX RESTROOM

NOTE: ALL WINDOWS AND STOREFRONT DOORS ARE IMPACT RATED TO MEET 2020 FBC SEVENTH EDITION REQUIREMENTS.

NOTE: ALL WINDOWS CLEAR GLASS WITH SHGC (SLAR HEAT GAIN COOEFFICIENT) OF .60 OR BETTER

ROOM FINISH SCHEDULE

ROOM/SPACE	FLOOR	BASE	SILLS	WALLS	CEILING	CLG. HGT.	REMARKS
LOBBY	FLOOR TILE	4" VINYL	—	5/8" GYP. BD., PAINT	S.A.T. W/ ALUMINUM GRID	9'-6"	PROVIDE ALUMINUM TRANSITION SADDLE PER DETAIL 7/A-13
UNISEX RESTROOM	FLOOR TILE	60" HIGH CERAMIC TILE WAINSCOT	MARBLE	60" HIGH CERAMIC TILE WAINSCOT			PROVIDE 5/8" CEMENT BACKER BOARD BEHIND ALL CER. TILE
DORM AREAS 1 THRU 10	LUXURY VINYL PLANK	4" VINYL		5/8" GYP. BD., PAINT			
DAY ROOM							
OFFICE			—				
VESTIBULE #1	POURED EPOXY	POURED EPOXY TURNED UP 4"	—			8'-9 1/2"	
VESTIBULE #2/#3	POURED EPOXY		—		5/8" GYP. BD., PAINT	11'-2 3/4"	
VESTIBULE #4/#5	FLOOR TILE	4" VINYL	—		S.A.T. W/ ALUMINUM GRID	9'-6"	
WOMENS RESTROOM		60" HIGH CERAMIC TILE WAINSCOT	—	60" HIGH CERAMIC TILE WAINSCOT		9'-6"	FULL HEIGHT CULTURED MARBLE WALL PANELS AT SHOWERS OVER 5/8" CEMENT BACKER BD. OR DENS SHIELD W/ MR. DRYWALL CLGS. AT 7'-4"
MENS RESTROOM			—			9'-6"	
JANITOR CLOSET	POURED EPOXY	POURED EPOXY TURNED UP 4"	—	5/8" GYP. BD. / PAINT ABOVE 48" HIGH CER. TILE ALL WALLS	5/8" GYP. BD., PAINT	8'-6"	1HR RATED CLG PER DESI... PROVIDE 5/8" CEMENT BACKER BOARD BEHIND ALL CER. TILE
MECH. EQUIP. #1	STAINED CONCRETE	4" VINYL	—	5/8" GYP. BD., PAINT		11'-3 3/8"	PROVIDE ALUMINUM SADDLE AT DOOR FOR 1/8" VCT TO CONCRETE TRANSITION
PANTRY	FLOOR TILE		—			8'-6"	
KITCHEN	FLOOR TILE		MARBLE	1/8" FRP OVER 1/2" PLYWOOD	S.A.T. W/ ALUMINUM GRID		PROVIDE FULL HEIGHT STAINLESS STEEL BACKSPLASH. SEE INTERIOR ELEVS. SHEET A-12
HALLS #1, #2, #3	LUXURY VINYL PLANK		—	5/8" GYP. BD., PAINT	S.A.T. W/ ALUMINUM GRID	9'-6"	
APPARATUS ROOM	POURED EPOXY	NO BASE AT STUCCO WALLS	—	5/8" STUCCO, PAINT	PRIMED AND PAINTED 1/2" BC PLYWOOD W/ 1X3 TRIM	17'-11 1/4"	TROWEL FINISH CONCRETE FLOORS. PROVIDE 1X3 LEVELING STRIPS AT 2'-0" O.C. AT CEILING
EMS STORAGE	4	POURED EPOXY TURNED UP 4"	MARBLE	5/8" GYP. BD., PAINT	S.A.T. W/ ALUMINUM GRID	8'-6"	
P.P.E.			MARBLE				
LAUNDRY/FACILITIES STORAGE	RUBBER FLOORING	4" VINYL	MARBLE		S.A.T. W/ ALUMINUM GRID		
D-CON ROOM	POURED EPOXY	POURED EPOXY TURNED UP 4"	—	PAINTED BLOCK	5/8" GYP. BD., PAINT	11'-3 3/8"	STRUCK JOINTS ON INTERIOR WALLS OF THIS ROOM. APPLY BLOCK FILLER PRIOR TO FINISH PAINT
ELEC. EQUIP. ROOM	STAINED CONCRETE	PAINTED BLOCK	—				
MECH. EQUIP. #2		4" VINYL	—	5/8" GYP. BD., PAINT	5/8" GYP. BD., PAINT		
PHONE ROOM			—		S.A.T. W/ ALUMINUM GRID	8'-0"	PROVIDE 4' H. X 8' LG. X 3/4" PLYWOOD ON BACK WALL. PRIME AND PAINT W/ FIRE RETARDANT PAINT
COVERED PATIO	CONCRETE W/ KOOL DECK TOPPING	STUCCO	—	5/8" STUCCO, PAINT	3/4" STUCCO ON P.T. 1X3 STRIPPING / PAINT	11'-2 1/2"	PROVIDE KOOL DECK VINYL ACRYLIC TOPPING IN KEYSTONE PATTERN
COVERED ENTRY			—				

NOTE:
✳ 5/8" GYPSUM BOARD IS TO BE APPLIED TO THE BOTTOM CHORD OF THE TRUSSES THROUGHOUT THE THE BUILDING EXCLUDING THE APPARATUS BAY, COVERED PATIO, AND COVERED ENTRY.

DOOR SCHEDULE

MARK	SIZE	DESCRIPTION	JAMB / FRAME	DETAILS	REMARKS
1	3'-0" W. X 7'-0" H. X 1-3/4"	KAWNEER 350 IR IMPACT RATED MEDIUM STYLE DOOR	ALUMINUM	1, 2/A-14 9/A-14	CLOSER, PROVIDE WHITE ESP FINISH, ADA BUMPER THRESHOLD.
2	3'-0" W. X 6'-8" H. X 1-3/4"	SOLID CORE WOOD WITH BIRCH VENEER-20 MIN RATED	16 GA. STEEL FRAME	2/A-13	ST. STEEL KICK PANEL ON EXTERIOR, WHITE MARBLE THRESHOLD, CLOSER AND WALL STOP
3	3'-0" W. X 7'-0" H. X 1-3/4"	45 MIN. B-LABEL, INSUL. 16 GA. STEEL	16 GA. STEEL FRAME W/ 4" HEAD	7/A-13 3, 4 /A-14 11/A-14	CLOSER, LATCH, UL ADA SADDLE W/SWEEP PROVIDE 6"X24" GLASS VISION PANEL
4	3'-0" W. X 6'-8" H. X 1-3/4"	SOLID CORE WOOD WITH BIRCH VENEER-20 MIN RATED	16 GA. STEEL FRAME	2/A-13	MUST MEET SMOKE PARTITION REQUIREMENTS PROVIDE WALL STOP, CLOSER, GASKETING TO MEET UL 1784
4A 4B 4C 20A 20B 20C 20D 20E 20F	3'-0" W. X 6'-8" H. X 1-3/4"	SOLID CORE WOOD WITH BIRCH VENEER	COMM. GRADE POCKET DOOR	2/A-13 SIM.	AS MANUFACTURED BY CAVITY SLIDERS USA INC. TRACK SYSTEM TO BE TOP MOUNT TRACK CAVI TRACK RANGE WITH CAVI LOCK. CL100 ADA LEVER W/PRIVACY LOCK W/NO SOFT OPEN/CLOSE OPTION.
5	3'-0" W. X 6'-8" H. X 1-3/4"	SOLID CORE WOOD WITH BIRCH VENEER-20 MIN RATED	16 GA. STEEL FRAME	2/A-13	WALL STOP
6	3'-0" W. X 6'-8" H. X 1-3/4"	SOLID CORE WOOD WITH BIRCH VENEER-20 MIN RATED	16 GA. STEEL FRAME	2/A-13	CLOSER, ST. STEEL KICK PLATE, LATCH, UL ADA SADDLE W/SWEEP MUST MEET SMOKE PARTITION REQUIREMENTS PROVIDE WALL STOP
7	3'-0" W. X 6'-8" H. X 1-3/4"	SOLID CORE WOOD WITH BIRCH VENEER-20 MIN RATED	16 GA. STEEL FRAME	2/A-13	WALL STOP
8	3'-0" W. X 6'-8" H. X 1-3/4"	SOLID CORE WOOD WITH BIRCH VENEER-20 MIN RATED	16 GA. STEEL FRAME	2/A-13	CLOSER, ST. STEEL KICK PLATE, LATCH, UL ADA SADDLE W/ SWEEP
9	3'-0" W. X 6'-8" H. X 1-3/4"	SOLID CORE WOOD WITH BIRCH VENEER-20 MIN RATED	16 GA. STEEL FRAME	2/A-13	—
10	3'-0" W. X 6'-8" H. X 1-3/4"	SOLID CORE WOOD WITH BIRCH VENEER-20 MIN RATED	16 GA. STEEL FRAME	2/A-13	PUSH PLATE, PULL HANDLE, CLOSER, ST. STEEL KICK PLATE ON PUSH SIDE, WALL STOP
11	3'-0" W. X 6'-8" H. X 1-3/4"	SOLID CORE WOOD WITH BIRCH VENEER-20 MIN RATED	16 GA. STEEL FRAME	2/A-13	PUSH PLATE, PULL HANDLE, CLOSER, ST. STEEL KICK PLATE ON PUSH SIDE, WHITE MARBLE THRESHOLD
DELETED					
13	3'-0" W. X 6'-8" H. X 1-3/4"	SOLID CORE WOOD WITH BIRCH VENEER-20 MIN RATED	16 GA. STEEL FRAME	2/A-13	PUSH PLATE, PULL HANDLE, CLOSER, ST. STEEL KICK PLATE ON PUSH SIDE, WALL STOP
14	3'-0" W. X 6'-8" H. X 1-3/4"	SOLID CORE WOOD WITH BIRCH VENEER-20 MIN RATED	16 GA. STEEL FRAME	2/A-13	PUSH PLATE, PULL HANDLE, CLOSER, ST. STEEL KICK PLATE ON PUSH SIDE, WHITE MARBLE THRESHOLD
15	3'-0" W. X 6'-8" H. X 1-3/4"	SOLID CORE WOOD W/ FULL LOUVER	16 GA. STEEL FRAME	2/A-13 SIM.	ALL 3 PANTRY DOORS SHALL HAVE LOCKSETS WITH NO LEVER HANDLES ON INTERIOR SIDE OF DOOR.
16	3'-0" W. X 6'-8" H. X 1-3/4"	SOLID CORE WOOD W/ FULL LOUVER	16 GA. STEEL FRAME	2/A-13 SIM.	
17	3'-0" W. X 6'-8" H. X 1-3/4"	SOLID CORE WOOD W/ FULL LOUVER	16 GA. STEEL FRAME	2/A-13 SIM.	
18	3'-0" W. X 7'-0" H. X 1-3/4"	KAWNEER 350 IR / 500 IR MEDIUM STYLE DOOR W/ SIDELITES PER WINDOW SCHEDULE	ALUMINUM	1, 2/A-14 9/A-14	CLOSER, PROVIDE WHITE ESP FINISH ADA BUMPER THRESHOLD
19	3'-0" W. X 7'-0" H. X 1-3/4"	45 MIN. B-LABEL, INSUL. 16 GA. STEEL	16 GA. STEEL FRAME W/ 4" HEAD	7/A-13 3, 4/A-14 11/A-14	CLOSER, LATCH, UL ADA SADDLE W/SWEEP PROVIDE 6"X24" GLASS VISION PANEL
20	3'-0" W. X 6'-8" H. X 1-3/4"	SOLID CORE WOOD WITH BIRCH VENEER-20 MIN RATED	16 GA. STEEL FRAME	2/A-13	MUST MEET SMOKE PARTITION REQUIREMENTS PROVIDE WALL STOP, CLOSER, GASKETING TO MEET UL 1784
21	3'-0" W. X 7'-0" H. X 1-3/4"	16 GA. STEEL INSULATED	16 GA. STEEL FRAME W/ 4" HEAD	3, 4/A-14 11/A-14	
22	12'-0"W X 15'-0" H.	OVER-HEAD COILING STEEL DOOR	STEEL	1/A-10	PROVIDE STANDARD POWDER COAT FINISH (COLOR AS SELECTED BY OWNER). DOOR IS OPERATED BY ELECTRIC MOTOR
23	12'-0"W X 15'-0" H.	OVER-HEAD COILING STEEL DOOR	STEEL	1/A-10	
24 24A	12'-0" W. X 15'-0" H.	OVER-HEAD COILING STEEL DOOR	STEEL	1/A-10	
25	12'-0" W. X 15'-0" H.	DOOR ENGINEERING FOUR FOLD 701 HURRICANE RATED W/(4) IMPACT RATED GLASSLITES	STEEL	2/A-5	ON NORTH ELEVATION ONLY PROVIDE MOTORIZED OPERATION
26	12'-0" W. X 15'-0" H.		STEEL	2/A-5	
27 27A	12'-0" W. X 15'-0" H.		STEEL	2/A-5	
28	3'-0" W. X 7'-0" H. X 1-3/4"	16 GA. STEEL INSULATED	16 GA. STEEL FRAME W/ 4" HEAD	3/A-14 11/A-14 4/A-14	LATCH AND CLOSER, THRESHOLD
29	3'-0" W. X 7'-0" H. X 1-3/4"	16 GA. STEEL INSULATED	16 GA. STEEL FRAME W/ 4" HEAD	3/A-14 11/A-14 4/A-14	LATCH AND CLOSER, THRESHOLD
30	3'-0" W. X 6'-8" H. X 1-3/4"	SOLID CORE WOOD WITH BIRCH VENEER-20 MIN RATED	16 GA. STEEL FRAME	2/A-13 10/A-14	LATCH AND CLOSER, THRESHOLD, ST. STL. KICK PLATE ON PUSH SIDE
31	3'-0" W. X 7'-0" H. X 1-3/4"	16 GA. STEEL INSULATED	16 GA. STEEL FRAME W/ 4" HEAD	3/A-14 11/A-14 4/A-14	LATCH AND CLOSER, THRESHOLD
32	3'-0" W. X 7'-0" H. X 1-3/4"	16 GA. STEEL INSULATED	16 GA. STEEL FRAME W/ 4" HEAD	1/A-13 6/A-13 4/A-14	LATCH AND CLOSER, THRESHOLD
33	3'-0" W. X 7'-0" H. X 1-3/4"	16 GA. STEEL INSULATED	16 GA. STEEL FRAME	1/A-13 3/A-13 6/A-13	CLOSER, UL ADA SADDLE PROVIDE PANIC HARDWARE 3
34	(2)3'-0" W. X 7'-0" H. X 1-3/4"	16 GA. STEEL INSULATED	16 GA. STEEL FRAME	1/A-13 3/A-13 6/A-13	
35	3'-0" W. X 7'-0" H. X 1-3/4"	16 GA. STEEL INSULATED	16 GA. STEEL FRAME W/ 4" HEAD	1/A-13 3/A-13 6/A-13	CLOSER, METAL THRESHOLD
36	3'-0" W. X 6'-8" H. X 1-3/4"	SOLID CORE WOOD WITH BIRCH VENEER-20 MIN RATED	16 GA. STEEL FRAME	2/A-13	LATCH AND CLOSER, UL ADA SADDLE W/ SWEEP 1
37	3'-0" W. X 6'-8" H. X 1-3/4"	SOLID CORE WOOD WITH BIRCH VENEER-20 MIN RATED	16 GA. STEEL FRAME	2/A-13	WALL STOP / STOREROOM SET
38	3'-0" W. X 7'-0" H. X 1-3/4"	45 MIN. B-LABEL, INSUL. 16 GA. STEEL	16 GA. STEEL FRAME W/ 4" HEAD	3, 4 /A-14 11/A-14	CLOSER, LATCH, UL ADA SADDLE W/SWEEP PROVIDE 6"X24" FIRELITE GLASS VISION PANEL
39	3'-0" W. X 7'-0" H. X 1-3/4"	45 MIN. B-LABEL, INSUL. 16 GA. STEEL	16 GA. STEEL FRAME W/ 4" HEAD	3, 4 /A-14 11/A-14	CLOSER, LATCH, UL ADA SADDLE W/SWEEP PROVIDE 6"X24" FIRELITE GLASS VISION PANEL

NOTES:
1.) FOR FINISH HARDWARE SPECIFICATIONS SEE SECTION 08700.
2.) DOOR HARDWARE SUBMITTALS REQUIRED FROM CONTRACTOR FOR ARCHITECTS REVIEW.

EDLUND · DRITENBAS · BINKLEY
ARCHITECTS AND ASSOCIATES, P.A.
AR-AA C000886
65 ROYAL PALM POINTE, SUITE "D"
VERO BEACH, FLORIDA 32960
PHONE: (772) 569-4320

SEAL:


PROJECT: STATION #15
FOR: INDIAN RIVER COUNTY FIRE RESCUE/EMS
9010 87TH ST
VERO BEACH, FL 32967

NO:	DATE	REVISIONS
4	6/23/26	ADDENDUM REVISIONS
3	2/4/26	BLDG DEPT REVISIONS
2	12/10/25	BLDG DEPT REVISIONS
1	11/20/25	BLDG DEPT REVISIONS


© JULY '25 THESE PLANS AND THE INFORMATION SHOWN HEREIN ARE THE PROPERTY OF EDLUND DRITENBAS BINKLEY ARCHITECTS, P.A. AND REPRODUCTIONS, DISCLOSURES OR USE THEREOF IN WHOLE OR IN PART IS EXPRESSLY PROHIBITED WITHOUT WRITTEN PERMISSION.

COMM. NO: 070424VB
DATE: JULY 2, 2025
BY: LJD
CH'KD: JPB


SHEET NO.
A-11
OF FOURTEEN

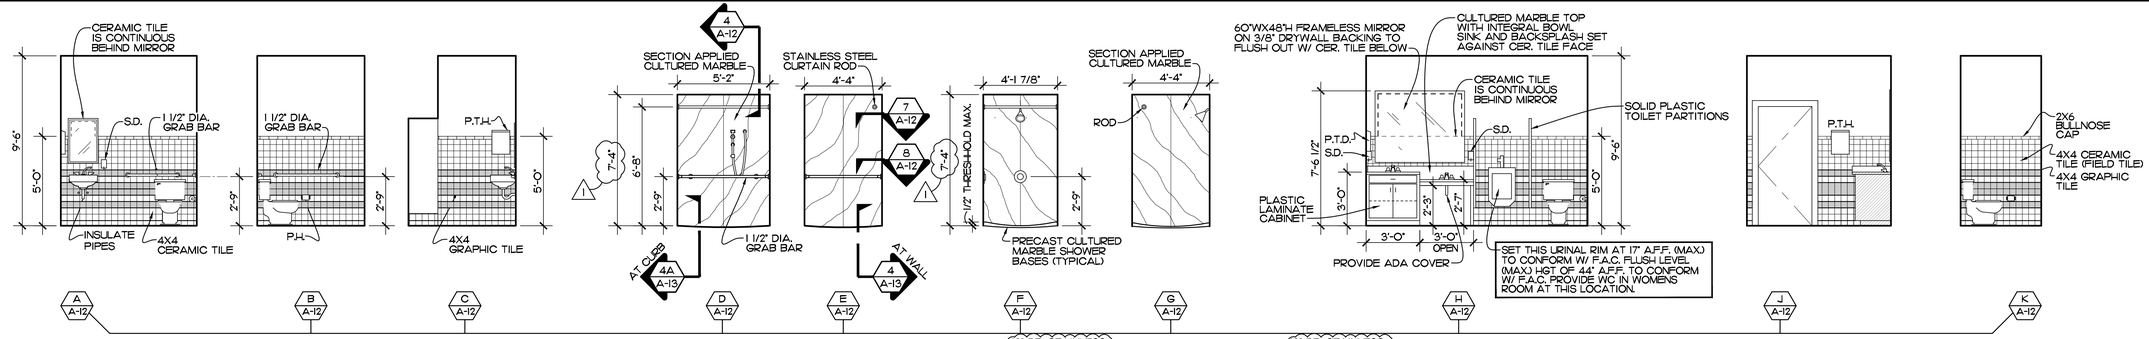


MENS RESTROOM (WOMENS SIMILAR)

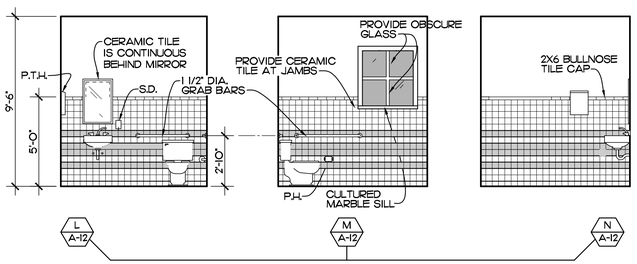


UNISEX RESTROOM

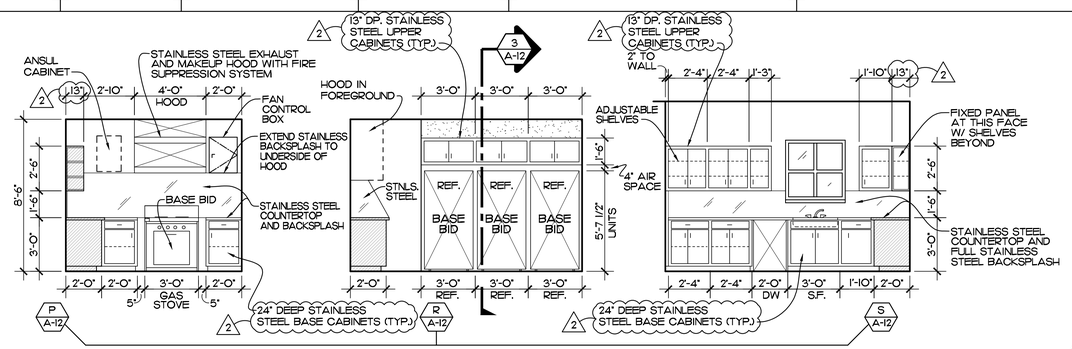


KITCHEN

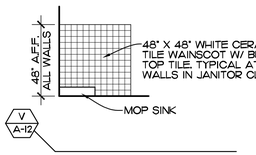


JAN. CLOSET

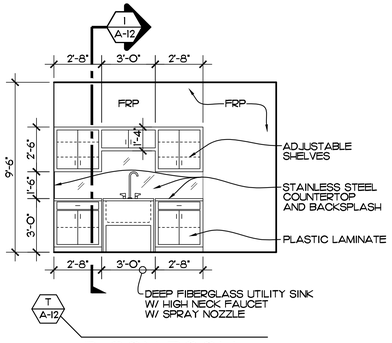

D-CON ROOM

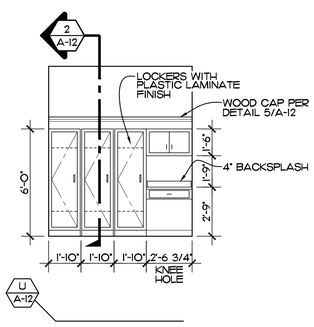

DORMS

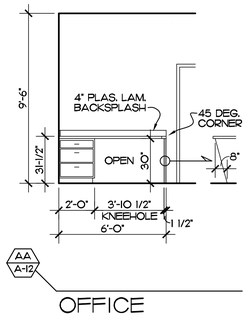

OFFICE


2

KITCHEN CABINETS NOTES:

1) PROVIDE STAINLESS STEEL CABINETS IN KITCHEN IN SIZES SHOWN, AS MANUFACTURED BY JW METAL CABINETS OR EQUAL, 1100 SERIES, SLAB DOOR STYLE, WITH 16 GA 304 STAINLESS STEEL WITH BRUSHED STAINLESS STEEL FINISH.


2) PROVIDE SHOP DRAWINGS MATCHING THE SIZES INDICATED.

3) PROVIDE 16 GA 304 STAINLESS STEEL TOPS AND BACKSPLASH

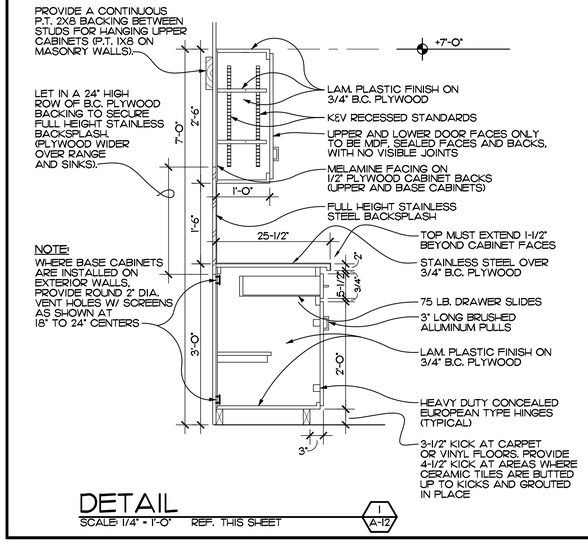


DETAIL
SCALE: 1/4" = 1'-0" REF. THIS SHEET
1 A-12


DETAIL
SCALE: 3/4" = 1'-0" REF. THIS SHEET
2 A-12

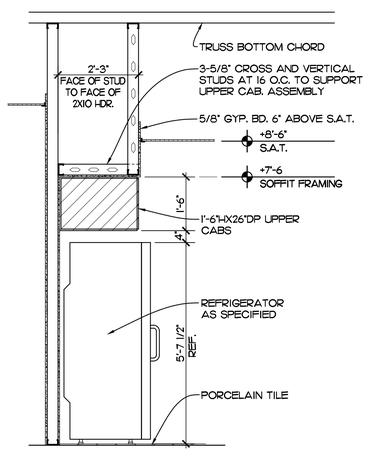


DETAIL AT REFRIG. SOFFIT
SCALE: 1/2"=1'-0" REF. SHEET A-3, A-14
3 A-12

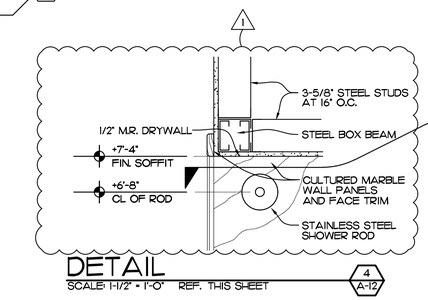


DETAIL
SCALE: 1-1/2" = 1'-0" REF. THIS SHEET
4 A-12

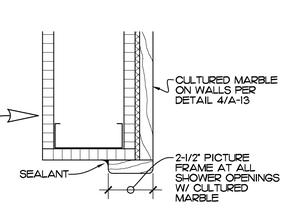


PLAN VIEW AT CORNERS ABOVE WAINSCOT
SCALE: 3"=1'-0"
7 A-12

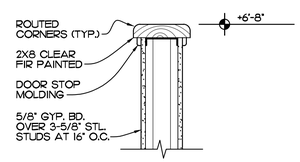

DETAIL WOOD CAP AT CUBICLE
SCALE: 1-1/2" = 1'-0" REF. THIS SHEET, A-3
5 A-12

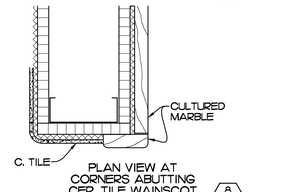

PLAN VIEW AT CORNERS ABUTTING CER. TILE WAINSCOT
SCALE: 3"=1'-0"
8 A-12

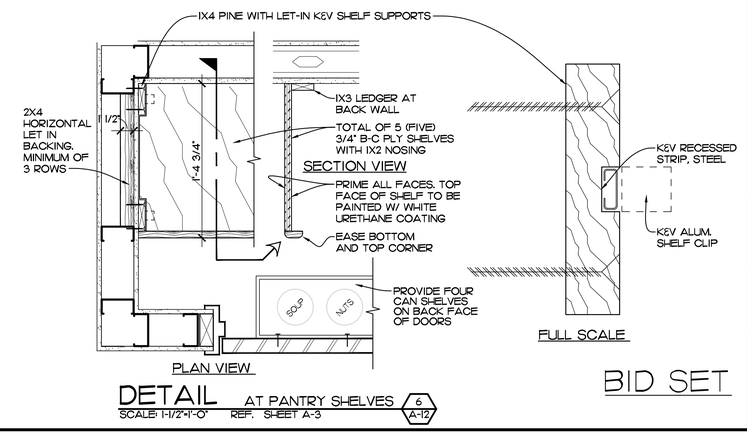

DETAIL AT PANTRY SHELVES
SCALE: 1-1/2"=1'-0" REF. SHEET A-3
6 A-12

BID SET

EDLUND · DRITENBAS · BINKLEY
ARCHITECTS AND ASSOCIATES, P.A.
AR-AA C000886
65 ROYAL PALM POINTE, SUITE "D"
VERO BEACH, FLORIDA 32960
PHONE: (772) 569-4320

EDB ARCHITECTS AND ASSOCIATES

SEAL:


PROJECT: STATION #15
FOR: INDIAN RIVER COUNTY FIRE RESCUE/EMS
9010 57TH ST
VERO BEACH, FL 32967

NO:	DATE	REVISIONS
1	11/20/25	BLDG DEPT REVISIONS
2	6/23/26	ADDENDUM REVISIONS

© JULY '25 THESE PLANS AND THE INFORMATION SHOWN HEREIN ARE THE PROPERTY OF EDLUND DRITENBAS BINKLEY ARCHITECTS, P.A. AND REPRODUCTIONS, DISCLOSURES OR USE THEREOF IN WHOLE OR IN PART IS EXPRESSLY PROHIBITED WITHOUT WRITTEN PERMISSION.


COMM. NO: 070424VB
DATE: JULY 2, 2025
BY: LJD
CH'KD: JPB

SHEET NO.
A-12
OF FOURTEEN

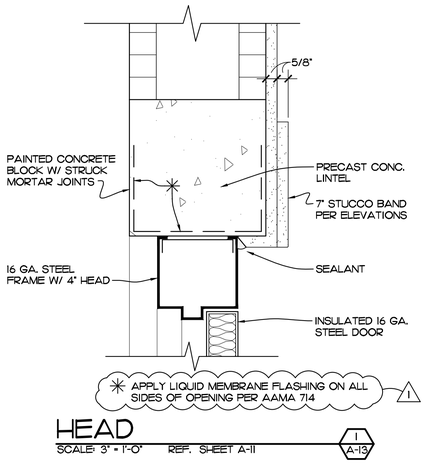

HEAD


SCALE: 3" = 1'-0" REF. SHEET A-11 — 1 / A-13

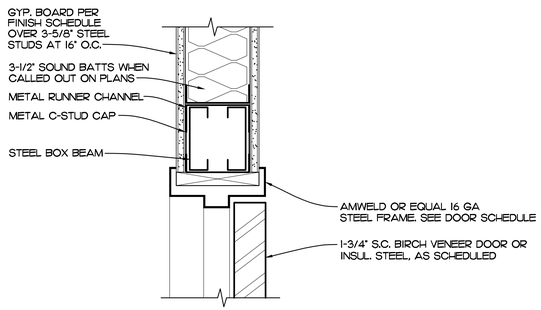

INTERIOR DOORHEAD


(JAMB SIMILAR)

SCALE: 3" = 1'-0" REF. SHEET A-11 — 2 / A-13

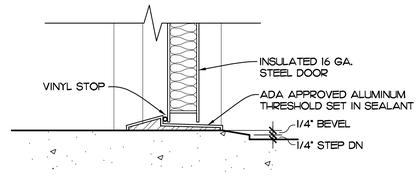

THRESHOLD


SCALE: 3" = 1'-0" REF. SHEET A-11 — 3 / A-13

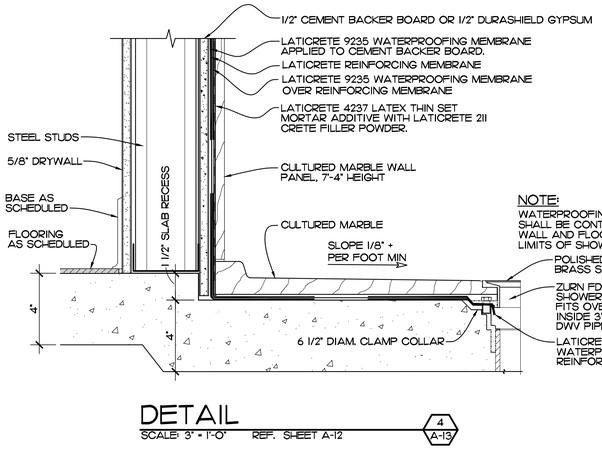

NOTE:
WATERPROOFING MEMBRANE ASSEMBLY SHALL BE CONTINUOUS BEHIND ALL WALL AND FLOOR PANELS WITHIN LIMITS OF SHOWER.

DETAIL


SCALE: 3" = 1'-0" REF. SHEET A-12 — 4 / A-13

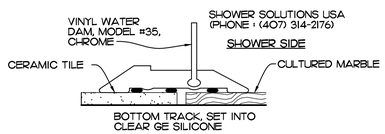

DETAIL

AT ADA CURB


SCALE: FULL REF. THIS SHEET, A-12 — 4A / A-13

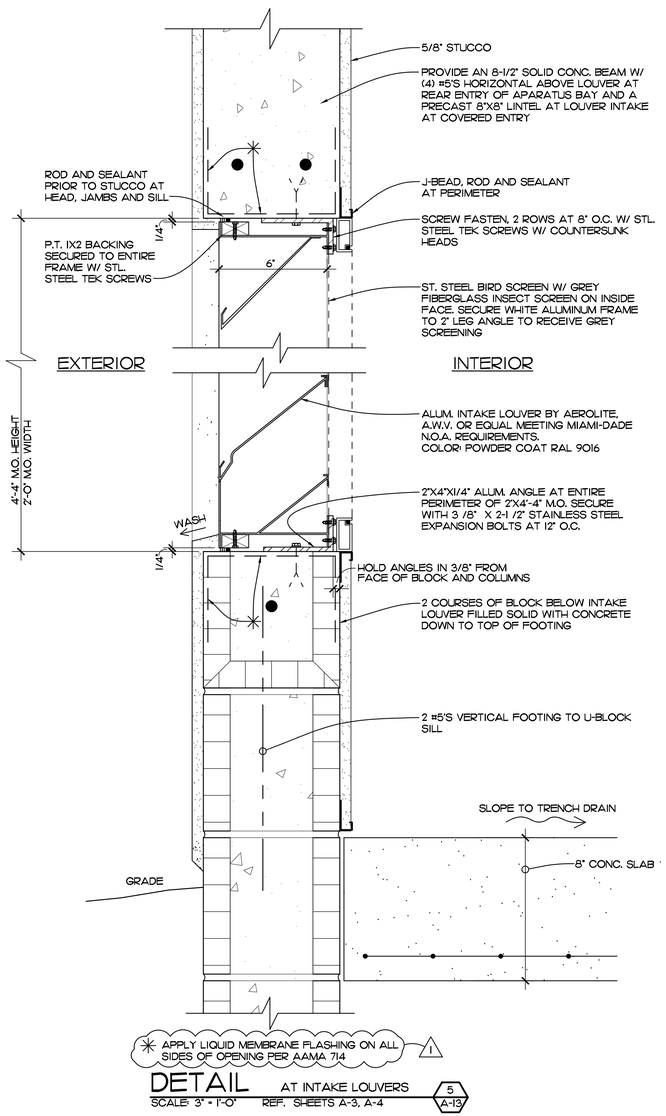

DETAIL


AT INTAKE LOUVERS

SCALE: 3" = 1'-0" REF. SHEETS A-3, A-4 — 5 / A-13

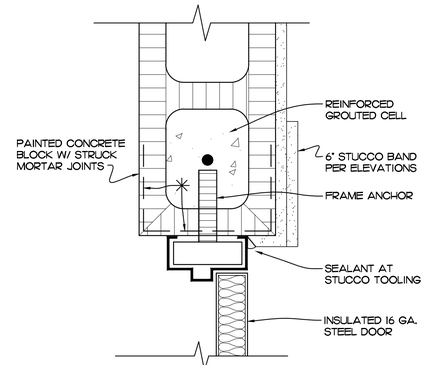

JAMB

SCALE: 3" = 1'-0" REF. SHEET A-11 — 6 / A-13

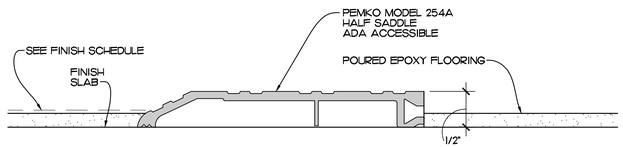

DETAIL

SCALE: 3" = 1'-0" REF. SHEET A-11 — 7 / A-13

EDLUND · DRITENBAS · BINKLEY
ARCHITECTS AND ASSOCIATES, P.A.
AR-AA C000886
65 ROYAL PALM POINTE, SUITE "D"
VERO BEACH, FLORIDA 32960
PHONE: (772) 569-4320

ARCHITECTS EDB AND ASSOCIATES

SEAL: STATE OF FLORIDA REGISTERED ARCHITECT 8545 JOSHUA F. BINKLEY

PROJECT: STATION #15
INDIAN RIVER COUNTY FIRE RESCUE/EMS
FOR: 9010 67TH ST
VERO BEACH, FL 32967


NO:	DATE	REVISIONS
1	11/20/25	BLDG DEPT REVISIONS

© JULY '25. THESE PLANS AND THE INFORMATION SHOWN HEREIN ARE THE PROPERTY OF EDLUND DRITENBAS BINKLEY ARCHITECTS, P.A. AND REPRODUCTIONS, DISCLOSURES OR USE THEREOF IN WHOLE OR IN PART IS EXPRESSLY PROHIBITED WITHOUT WRITTEN PERMISSION.


COMM. NO: 070424VB
DATE: JULY 2, 2025
BY: LJD
CH'KD: JFB

SHEET NO. A-13 OF FOURTEEN


BID SET

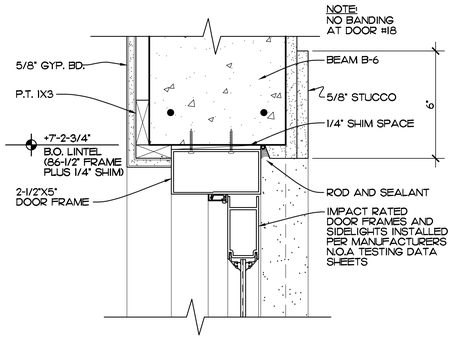


HEAD / JAMB SIMILAR
SCALE: 3" = 1'-0" REF. SHEET A-11 1 A-14

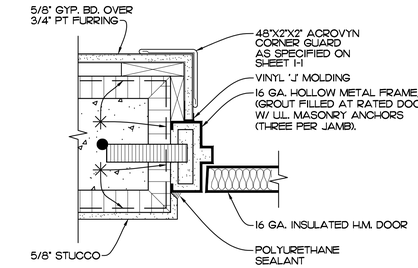


JAMB / HEAD SIMILAR
SCALE: 3" = 1'-0" REF. SHEET A-11 3 A-14

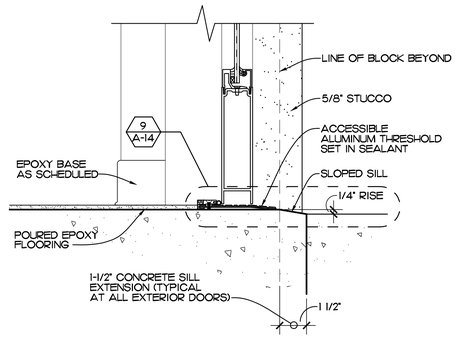


THRESHOLD
SCALE: 3" = 1'-0" REF. SHEET A-11 2 A-14

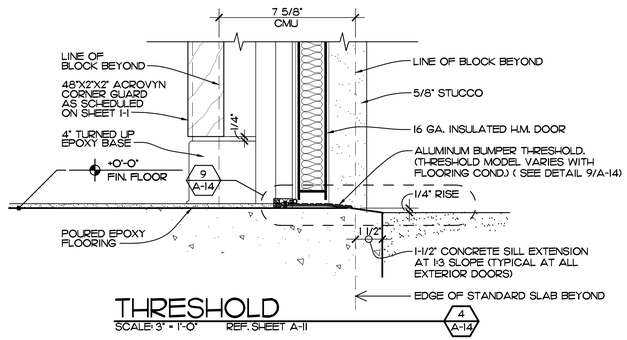


THRESHOLD
SCALE: 3" = 1'-0" REF. SHEET A-11 4 A-14

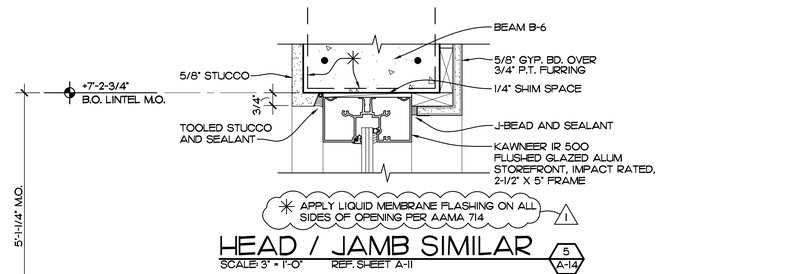


HEAD / JAMB SIMILAR
SCALE: 3" = 1'-0" REF. SHEET A-11 5 A-14

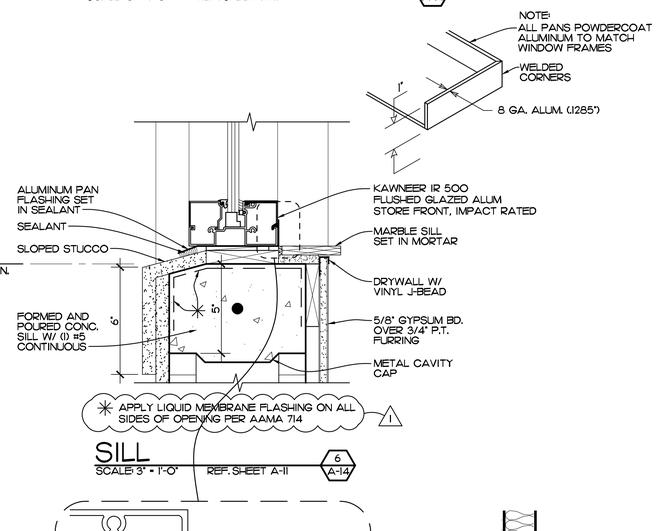


SILL
SCALE: 3" = 1'-0" REF. SHEET A-11 6 A-14

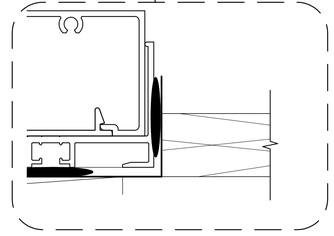


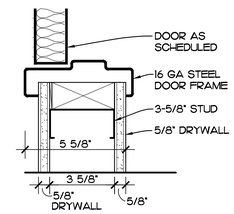

JAMB DETAIL
SCALE: 3" = 1'-0" REF. SHEET A-11 10 A-14

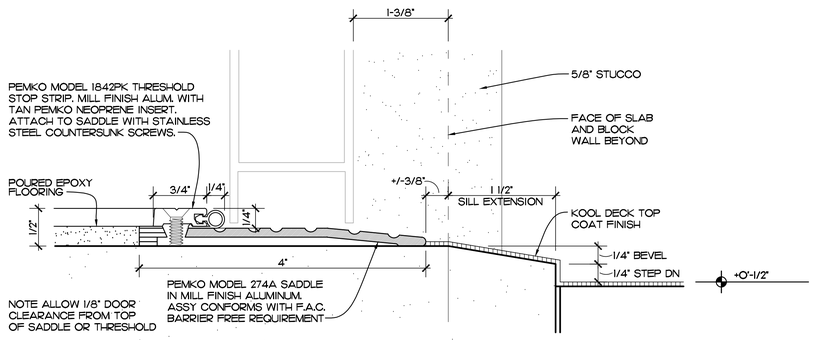

DETAIL
SCALE: FULL REF. 4/A-14 2 9 A-14

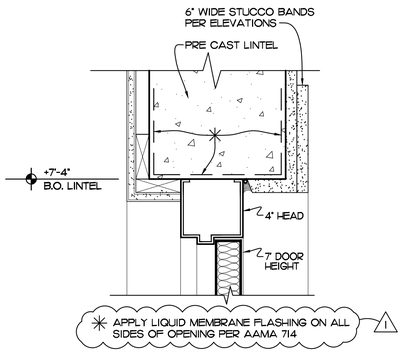

HEAD CONDITION
SCALE: 3" = 1'-0" REF. SHEET A-11 11 A-14

BID SET

EDLUND · DRITENBAS · BINKLEY
ARCHITECTS AND ASSOCIATES, P.A.
AR-AA C000886
65 ROYAL PALM POINTE, SUITE "D"
VERO BEACH, FLORIDA 32960
PHONE: (772) 569-4320

EDB ARCHITECTS AND ASSOCIATES

SEAL: STATE OF FLORIDA REGISTERED ARCHITECT 8545 JEFFREY F. BINKLEY

PROJECT: STATION #15
FOR: INDIAN RIVER COUNTY FIRE RESCUE/EMS
9010 67TH ST
VERO BEACH, FL 32967

NO:	DATE	REVISIONS
1	1/8/26	BLDG DEPT REVISIONS
2	11/20/25	BLDG DEPT REVISIONS

© JULY '25 THESE PLANS AND THE INFORMATION SHOWN HEREIN ARE THE PROPERTY OF EDLUND DRITENBAS BINKLEY ARCHITECTS, P.A. AND REPRODUCTIONS, DISCLOSURES OR USE THEREOF IN WHOLE OR IN PART IS EXPRESSLY PROHIBITED WITHOUT WRITTEN PERMISSION.

COMM. NO: 070424VB
DATE: JULY 2, 2025
BY: LJD
CH'KD: JFB

SHEET NO.
A-14
OF FOURTEEN