



7 CORNICE DETAIL

SCALE: 1-1/2"=1'-0" REFER: 1/A-3.3

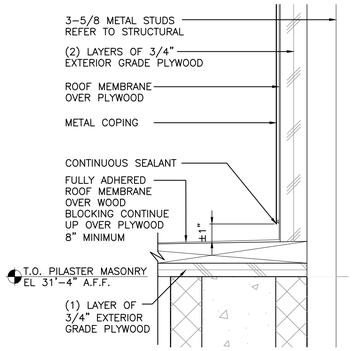


6 PILASTER DETAIL

SCALE: 3"=1'-0" REFER: 5/A-3.3

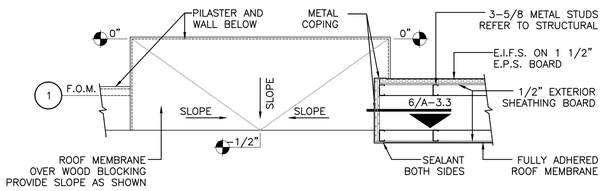


5 ENTRANCE DETAIL

SCALE: 1/2"=1'-0" REFER: A-3.3

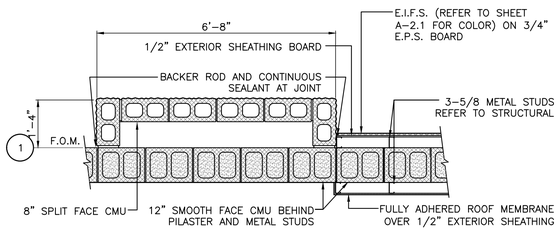


4 PILASTER DETAIL

SCALE: 1/2"=1'-0" REFER: A-3.3

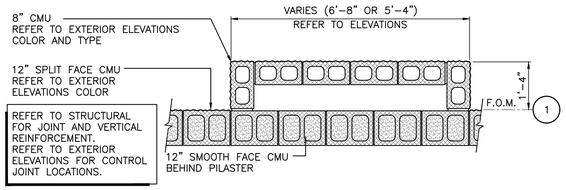

3 PILASTER DETAIL

SCALE: 1/2"=1'-0" REFER: A-3.3

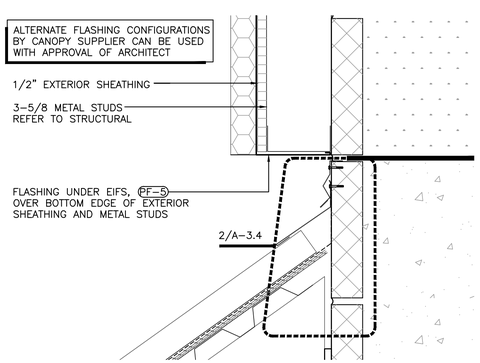

2 CANOPY DETAIL

SCALE: 3"=1'-0" REFER: A-3.3

GENERAL NOTES

1. INSTALL JOINT SEALANT OVER 1/2" EXPANSION JOINT FILLER AT ALL EXTERIOR WALL/PAVEMENT JOINTS AND AT ALL CUTS AND HOLES THROUGH PAVEMENT. (REFER TO SPECIFICATIONS)
2. REFER TO STRUCTURAL FOR LOCATION OF GROUTED CELLS AT STRUCTURAL CONNECTION.
3. PAINT EXTERIOR/EXPOSED GIRDERS, JOISTS AND MISCELLANEOUS STEEL ETC. WHITE (P-6)
4. REFER TO SHEET A-2.0 FOR EXTERIOR FINISHES.
5. PARAPET MEMBRANE FLASHING SHALL BE OF SAME MATERIAL AS SINGLE-PLY ROOFING MEMBRANE.
6. CANOPY FLASHING INSTALLATION SEQUENCE:
   - INSTALL FLASHING OVER BOTTOM EDGE OF EXTERIOR SHEATHING
   - INSTALL EIFS SYSTEM
   - INSTALL CANOPY TUBE STEEL FRAME
   - INSTALL FLASHING B, C, AND D IN ORDER WITH CONTINUOUS SEALANT BETWEEN A AND B AND AT TOP EDGE OF D
   - INSTALL METAL ROOF PANELS

1 MAIN ENTRY VESTIBULE SECTION

SCALE: 1/2"=1'-0" REFER: A-1.0, A-2.0, A-2.1

ORIGINAL	SECOND	FINAL

REVISIONS

◇ PRE-BID SET ISSUE DATE △ POST BID SET ISSUE DATE

DATE	DESCRIPTION
11.04.25	△ Plan Review Comments
10.07.26	△ Criteria Updates

STATE OF FLORIDA · PERRY M. PETRILLO · AR95158 · REGISTERED ARCHITECT

LICENSE:
NCARB No. 44-575
NEW JERSEY Lic. No. 12119
NEW YORK Lic. No. 024375-1
FLORIDA Lic. No. RA-015310-B
VIRGINIA Lic. No. 0401 011655
FLORIDA Lic. No. AR95158

PERRY M. PETRILLO ARCHITECTS PC
9 Park Avenue
Park Ridge, New Jersey (07656
Telephone (201) 307-6153
Facsimile (201) 307-6158

LOWE'S HOME CENTERS, LLC
1000 LOWE'S BOULEVARD
MOORESVILLE, NC 28117
704.758.1000 (PH.)

THIS DRAWING IS THE PROPERTY OF LOWE'S HOME CENTERS, LLC. ANY USE OR REPRODUCTION IN WHOLE OR PART IS PROHIBITED WITHOUT THE EXPRESSED WRITTEN CONSENT OF LOWE'S HOME CENTERS, LLC. COPYRIGHT 2025-2027 ALL RIGHTS RESERVED

LOWE'S

MAIN ENTRY VESTIBULE SECTIONS AND DETAILS
LOWE'S OF WESTLAKE
5683 SEMINOLE PRATT WHITNEY RD.
Westlake, Florida, 33470
PCN 77-40-43-01-28-000-2010
PROJECT No: 23.200 DRAWN BY: LDM CHECKED BY:

CRITERIA ISSUE DATE:	02-2025
PERMIT SET ISSUE DATE:	08-22-2025
CONSTRUCTION SET ISSUE DATE:	04-14-2025

DRAWING NUMBER:
A-3.3