


DOOR TYPES

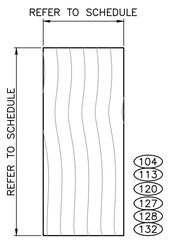


D-1
SOLID CORE WOOD

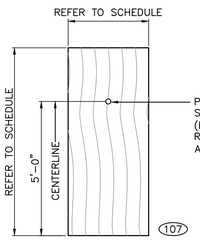


D-2
SOLID CORE WOOD W/ PEEP HOLE

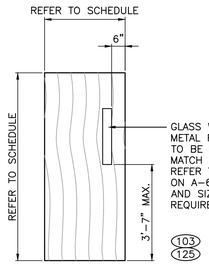


D-3
SOLID CORE WOOD W/ VIEW PANEL

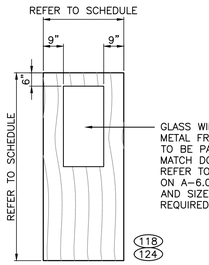


D-4
SOLID CORE WOOD W/ HALF GLASS

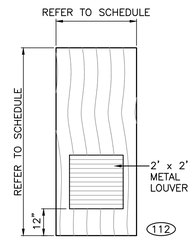


D-5
SOLID CORE WOOD W/ LOUVER

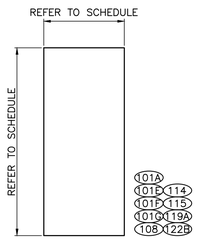


D-6
HOLLOW METAL

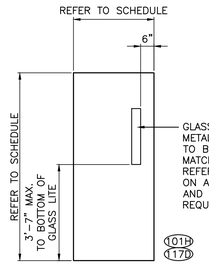

D-7
HOLLOW METAL W/ GLASS PANEL

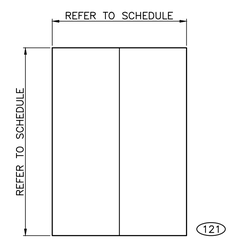


D-8
HOLLOW METAL – DOUBLE DOOR

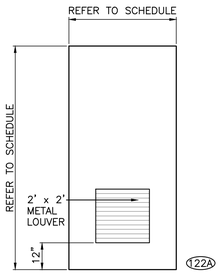

D-9
HOLLOW METAL W/ LOUVER




D-10
SECTIONAL OVERHEAD DOOR

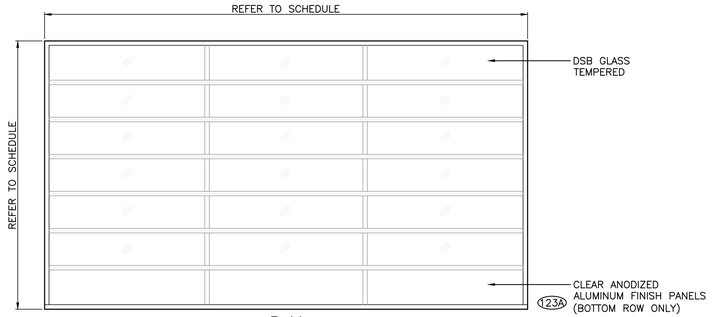



D-11
SECTIONAL OVERHEAD DOOR W/ GLASS PANELS



D-12
OVERHEAD COILING DOOR

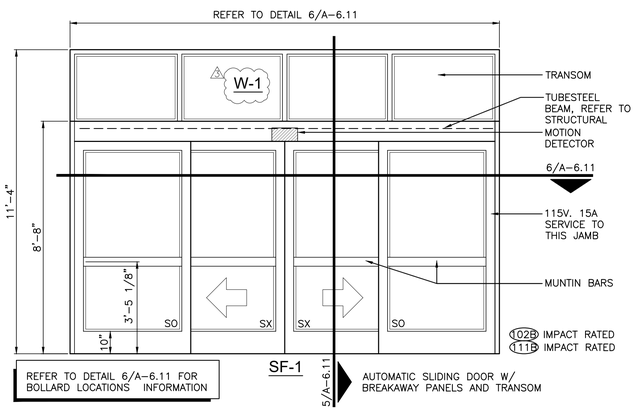


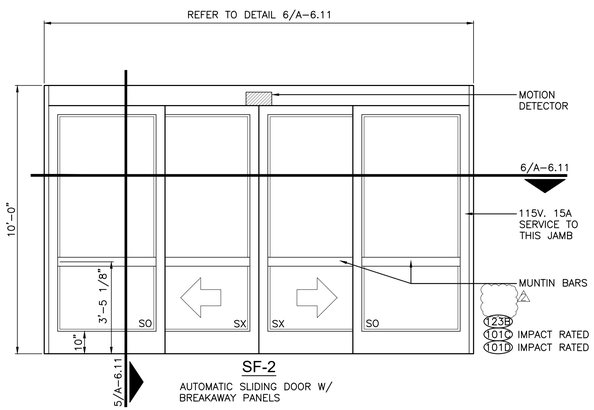


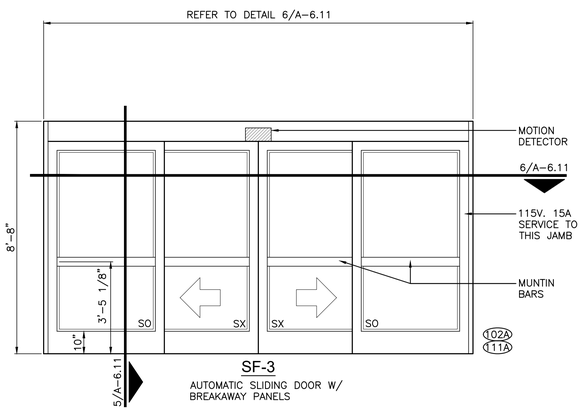


DOORS		
LP CODE 4		
DOOR NO.	1/4" TEMPERED GLASS	7/16" LAMINATED GLASS
101C	X	
101D	X	
102A	X	
102B		X
110	X	
111A	X	
111B		X
123B		X
TRANSOM GLAZING SHALL MATCH DOOR GLAZING (WINDOW TYPE W-1)		

WINDOW TYPES

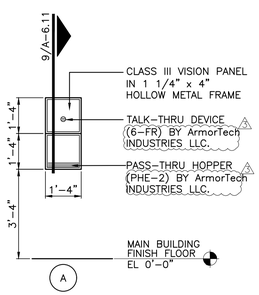

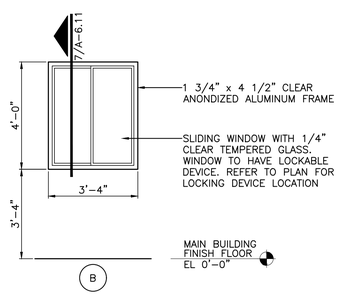

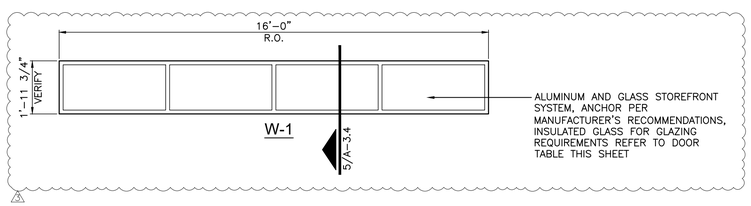

REVISIONS		
◇ PRE-BID SET ISSUE DATE		△ POST BID SET ISSUE DATE
DATE		DESCRIPTION
11.04.25	△1	Plan Review Comments
10.07.26	△2	Criteria Updates

STATE OF FLORIDA · PERRY M. PETRILLO · REGISTERED ARCHITECT · AR95158

LICENSE:
NCARB Cert. No. 44-575
NEW JERSEY Lic. No. 12119
NEW YORK Lic. No. 024375-1
PENNSYLVANIA Lic. No. RA-015310-B
VIRGINIA Lic. No. 0401 011655
FLORIDA Lic. No. AR95158

PERRY M. PETRILLO ARCHITECTS PC
9 Park Avenue
Park Ridge, New Jersey 07656
Telephone (201) 307-6153
Facsimile (201) 307-6158

LOWE'S HOME CENTERS, LLC
1000 LOWE'S BOULEVARD
MOORESVILLE, NC 28117
704.758.1000 (PH.)

THIS DRAWING IS THE PROPERTY OF LOWE'S HOME CENTERS, LLC. ANY USE OR REPRODUCTION IN WHOLE OR PART IS PROHIBITED WITHOUT THE EXPRESSED WRITTEN CONSENT OF LOWE'S HOME CENTERS, LLC. COPYRIGHT 2025-2027 ALL RIGHTS RESERVED

LOWE'S

DOOR AND WINDOW ELEVATIONS AND DETAILS

LOWE'S OF WESTLAKE
5683 SEMINOLE PRATT WHITNEY RD.
Westlake, Florida, 33470

PCN: 77-40-43-51-28-000-0010
PROJECT No: 23.200
DRAWN BY: LDM CHECKED BY:

CRITERIA	
ISSUE DATE:	02-2025
PERMIT SET	
ISSUE DATE:	08-22-2025
CONSTRUCTION SET	
ISSUE DATE:	04-14-2025

DRAWING NUMBER:

A-6.1

FINAL	ORIGINAL
SECOND	