

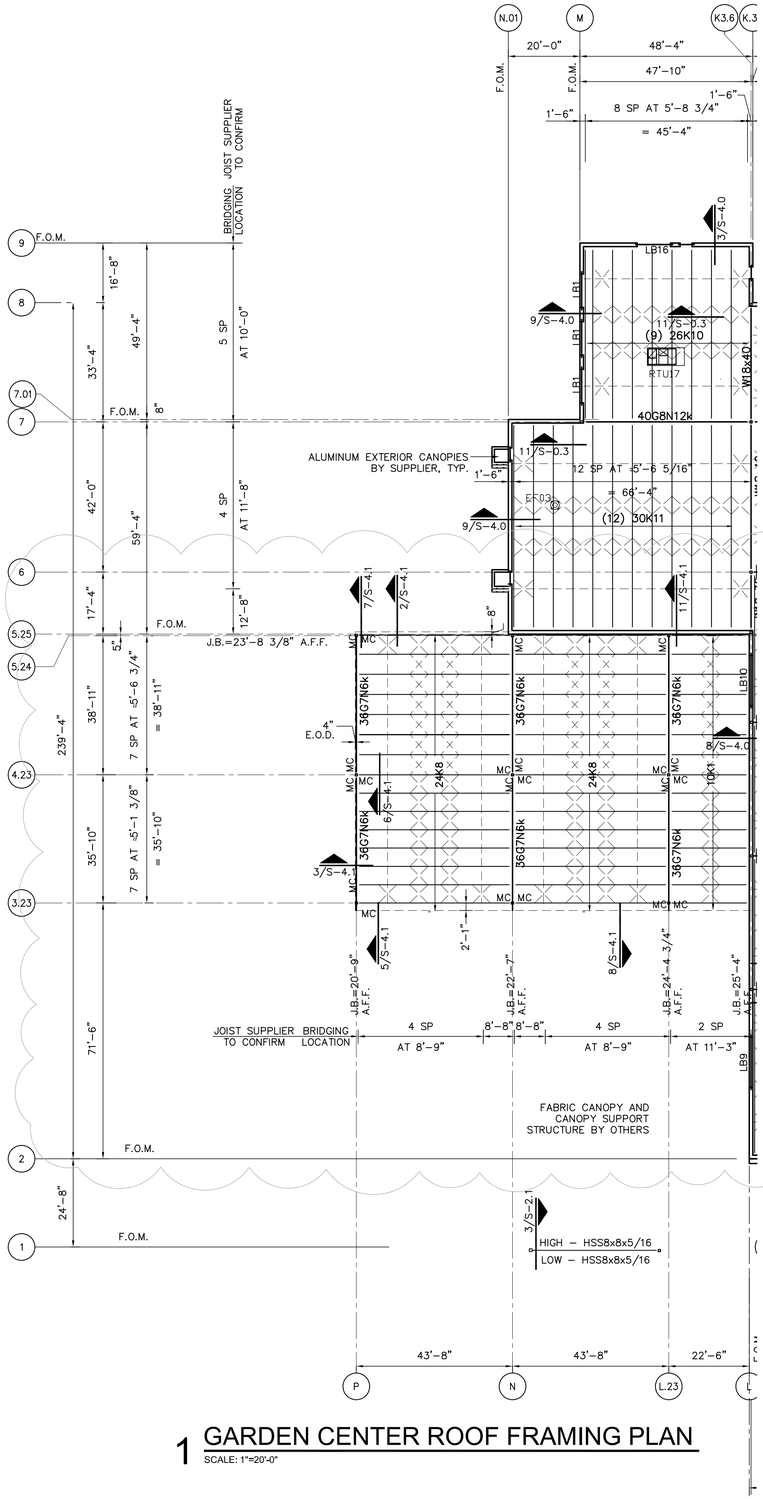


1 GARDEN CENTER ROOF FRAMING PLAN
SCALE: 1"=20'-0"

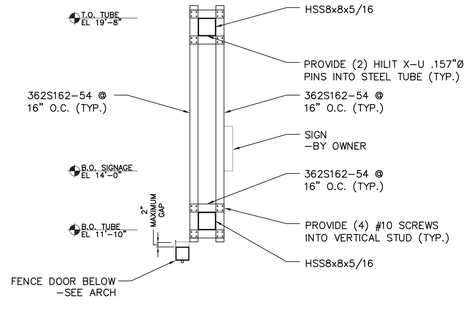

3 TUBES AT GARDEN CENTER SIGN
SCALE: 3/8" 3/S-2.1

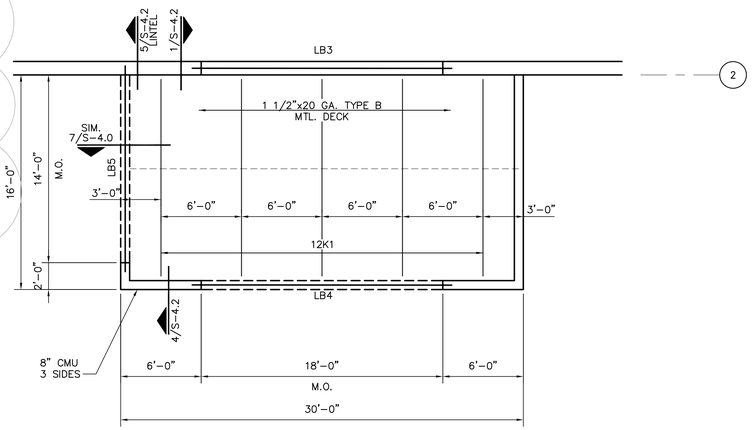

NOTE:
1. ATTACH METAL DECK PER ZONE A REQUIREMENTS SHOWN IN DETAIL 6/S-0.2.

2 CLC VESTIBULE FRAMING
SCALE: 3/16" S-2.0

ORIGINAL
SECOND
FINAL
0:\LOWE'S STORES\2564103.0 – LOWE'S OF WESTLAKE FL\STRUCT\REVIT – CAD\WESTLAKE FL-S2.1
10/7/2026 8:44:58 AM JHURD
10/7/2026 8:45:11 AM

REVISIONS
PRE-BID SET ISSUE DATE | POST BID SET ISSUE DATE

DATE		DESCRIPTION
11.04.25	1	Plan Review Comments
10.06.26	2	Criteria Updates

HSE
STRUCTURAL ENGINEERING CONSULTANTS
HERRICK-SAYLOR ENGINEERS, D.P.C.
50 Square Drive, Suite 110
Victor, New York 14564
(585)924-1700
www.herrick-saylor.com

PERRY M. PETRILLO ARCHITECTS PC
9 Park Avenue
Park Ridge, New Jersey 07656
Telephone (201) 307-6153
Facsimile (201) 307-6158

LOWE'S HOME CENTERS, LLC
1000 LOWE'S BOULEVARD
MOORESVILLE, NC 28117
704.758.1000 (PH.)

THIS DRAWING IS THE PROPERTY OF LOWE'S HOME CENTERS, LLC. ANY USE OR REPRODUCTION IN WHOLE OR PART IS PROHIBITED WITHOUT THE EXPRESSED WRITTEN CONSENT OF LOWE'S HOME CENTERS, LLC. COPYRIGHT 2025-2027 ALL RIGHTS RESERVED

LOWE'S

94K GARDEN CENTER
FRAMING PLAN
LOWE'S OF WESTLAKE
5683 SEMINOLE PRATT WHITNEY RD.
Westlake, Florida, 33470
PCN: 77-40-43-01-28-000.0010
PROJECT No: 23.200 DRAWN BY: LDM CHECKED BY:

CRITERIA
ISSUE DATE: 02-2025
PERMIT SET
ISSUE DATE: 08-22-2025
CONSTRUCTION SET
ISSUE DATE: 04-14-2025
DRAWING NUMBER:

S-2.1