

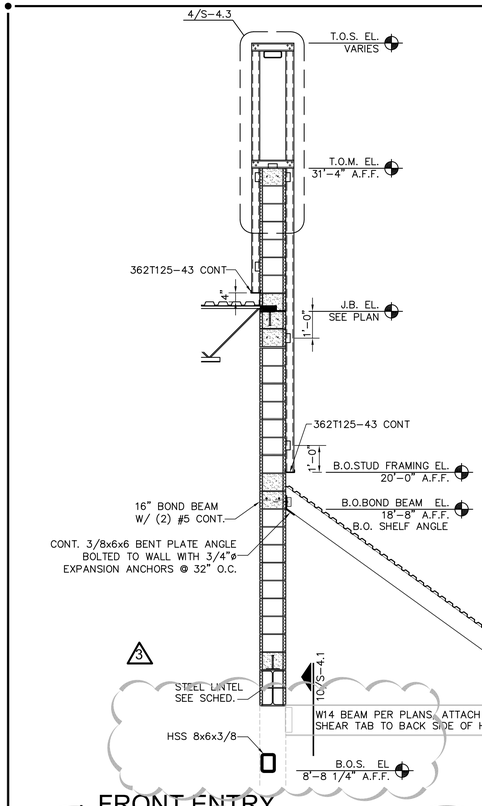


1 FRONT ENTRY
SCALE: 3/8" S-2.0


GENERAL CONTRACTOR TO VERIFY AND COORDINATE ALL ELEVATIONS WITH FINAL SEALED ARCHITECTURAL DRAWINGS

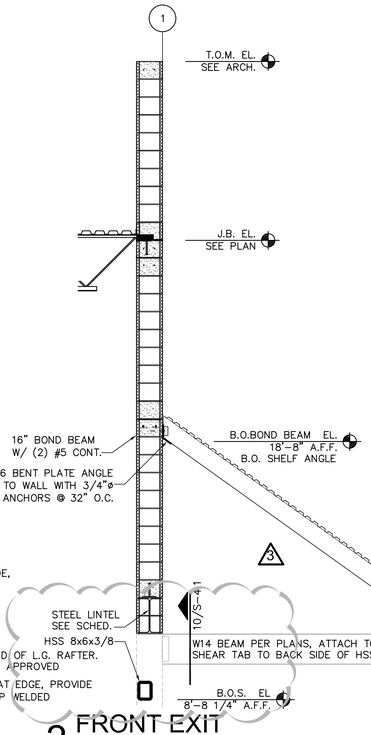


2 FRONT EXIT
SCALE: 3/8" S-2.0

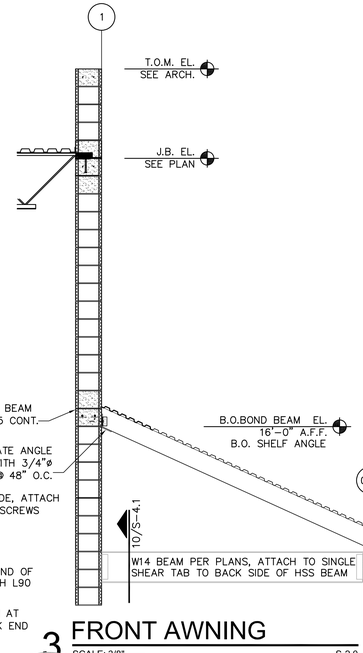

3 FRONT AWNING
SCALE: 3/8" S-2.0

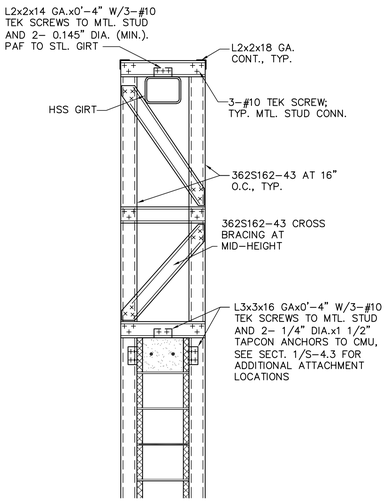


4 ENTRY PARAPET
SCALE: 3/4" 1/S-4.3

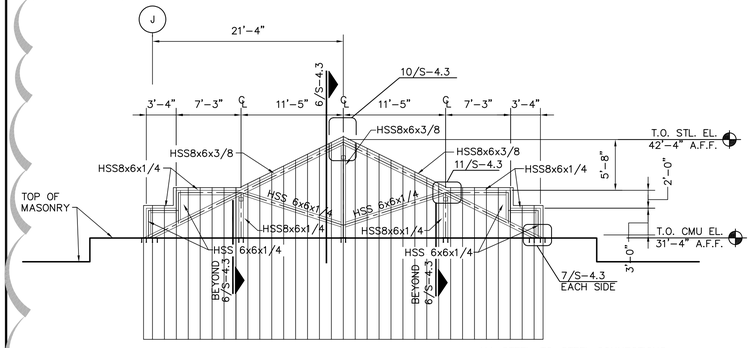


5 ENTRY ELEVATION
SCALE: 1/8" S-2.0


ALL STEEL-TO-STEEL CONNECTIONS TO BE FIELD WELDED ALL AROUND, 3/16" WELD TYPICAL

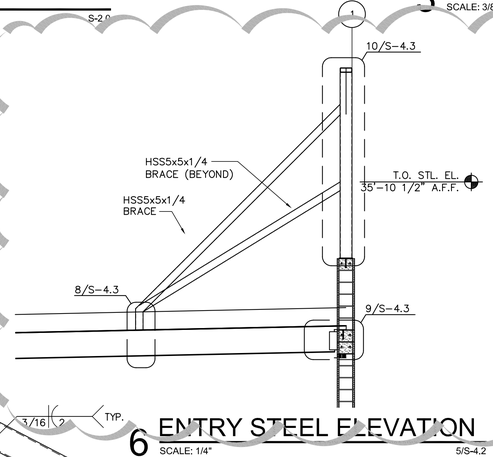


6 ENTRY STEEL ELEVATION
SCALE: 1/4" 5/S-4.2

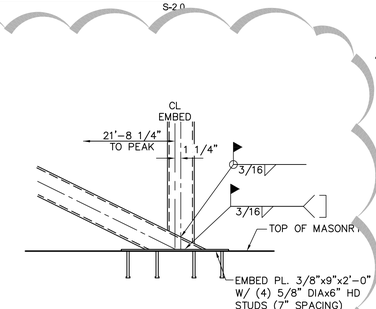


7 ENTRY STEEL CONNECTION
SCALE: 3/4" 5/S-4.3

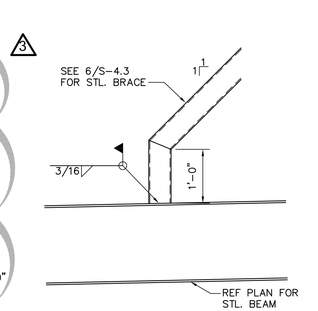


8 BRACE CONNECTION
SCALE: 3/4" 6/S-4.3

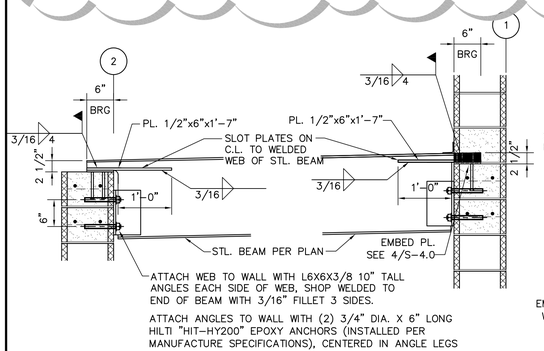


9 ENTRY BEAM CONNECTION
SCALE: 3/4" S-2.0, 6/S-4.3

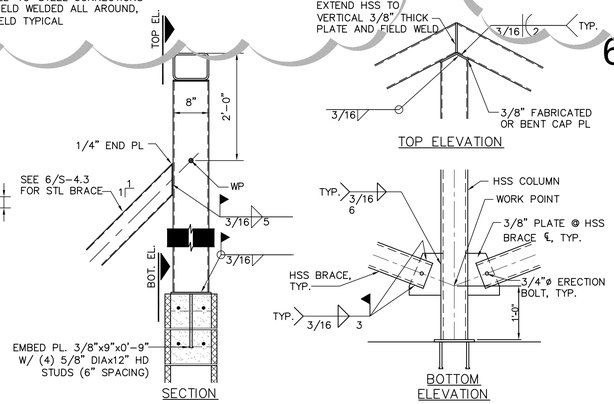

10 ENTRY STEEL CONNECTION
SCALE: 3/4" 6/S-4.3

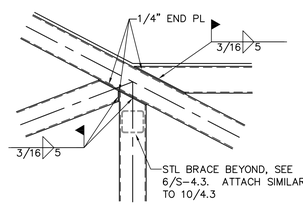

11 ENTRY STEEL CONNECTION
SCALE: 3/4" 5/S-4.3

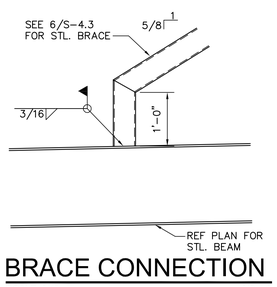

12 BRACE CONNECTION
SCALE: 3/4" 6/S-4.3

REVISIONS		
◇ PRE-BID SET ISSUE DATE		△ POST BID SET ISSUE DATE
DATE		DESCRIPTION
11.04.25	1	Plan Review Comments
10.6.26	2	CRITERIA UPDATE

HSE
STRUCTURAL ENGINEERING CONSULTANTS
HERRICK-SAYLOR ENGINEERS, D.P.C.
50 Square Drive, Suite 110
Victor, New York 14564
(585) 678-7170
www.herrick-saylor.com

PERRY M. PETRILLO ARCHITECTS PC
9 Park Avenue
Park Ridge, New Jersey 07656
Telephone (201) 307-6153
Facsimile (201) 307-6158

LOWE'S HOME CENTERS, LLC
1000 LOWE'S BOULEVARD
MOORESVILLE, NC 28117
704.758.1000 (PH.)

THIS DRAWING IS THE PROPERTY OF LOWE'S HOME CENTERS, LLC, ANY USE OR REPRODUCTION IN WHOLE OR PART IS PROHIBITED WITHOUT THE EXPRESSED WRITTEN CONSENT OF LOWE'S HOME CENTERS, LLC. COPYRIGHT 2025-2027 ALL RIGHTS RESERVED

94K
FRONT FRAMING DETAILS
LOWE'S OF WESTLAKE
5683 SEMINOLE PRATT WHITNEY RD.
Westlake, Florida, 33470

JOB NO: 25-250-25000
PROJECT No: 25-250
DRAWN BY: LDM | CHECKED BY:

CRITERIA	
ISSUE DATE:	02-2025
PERMIT SET	
ISSUE DATE:	08-22-2025
CONSTRUCTION SET	
ISSUE DATE:	04-14-2025

DRAWING NUMBER:

S-4.3

ORIGINAL	
SECOND	
FINAL	

10/6/2026 10:02:10 AM JHURD
O:\LOWE'S STORES\25640103.0 - LOWE'S OF WESTLAKE FL\STRUCT\REVIT - CAD\WESTLAKE FL-S4.3
10/6/2026 10:02:45 AM