
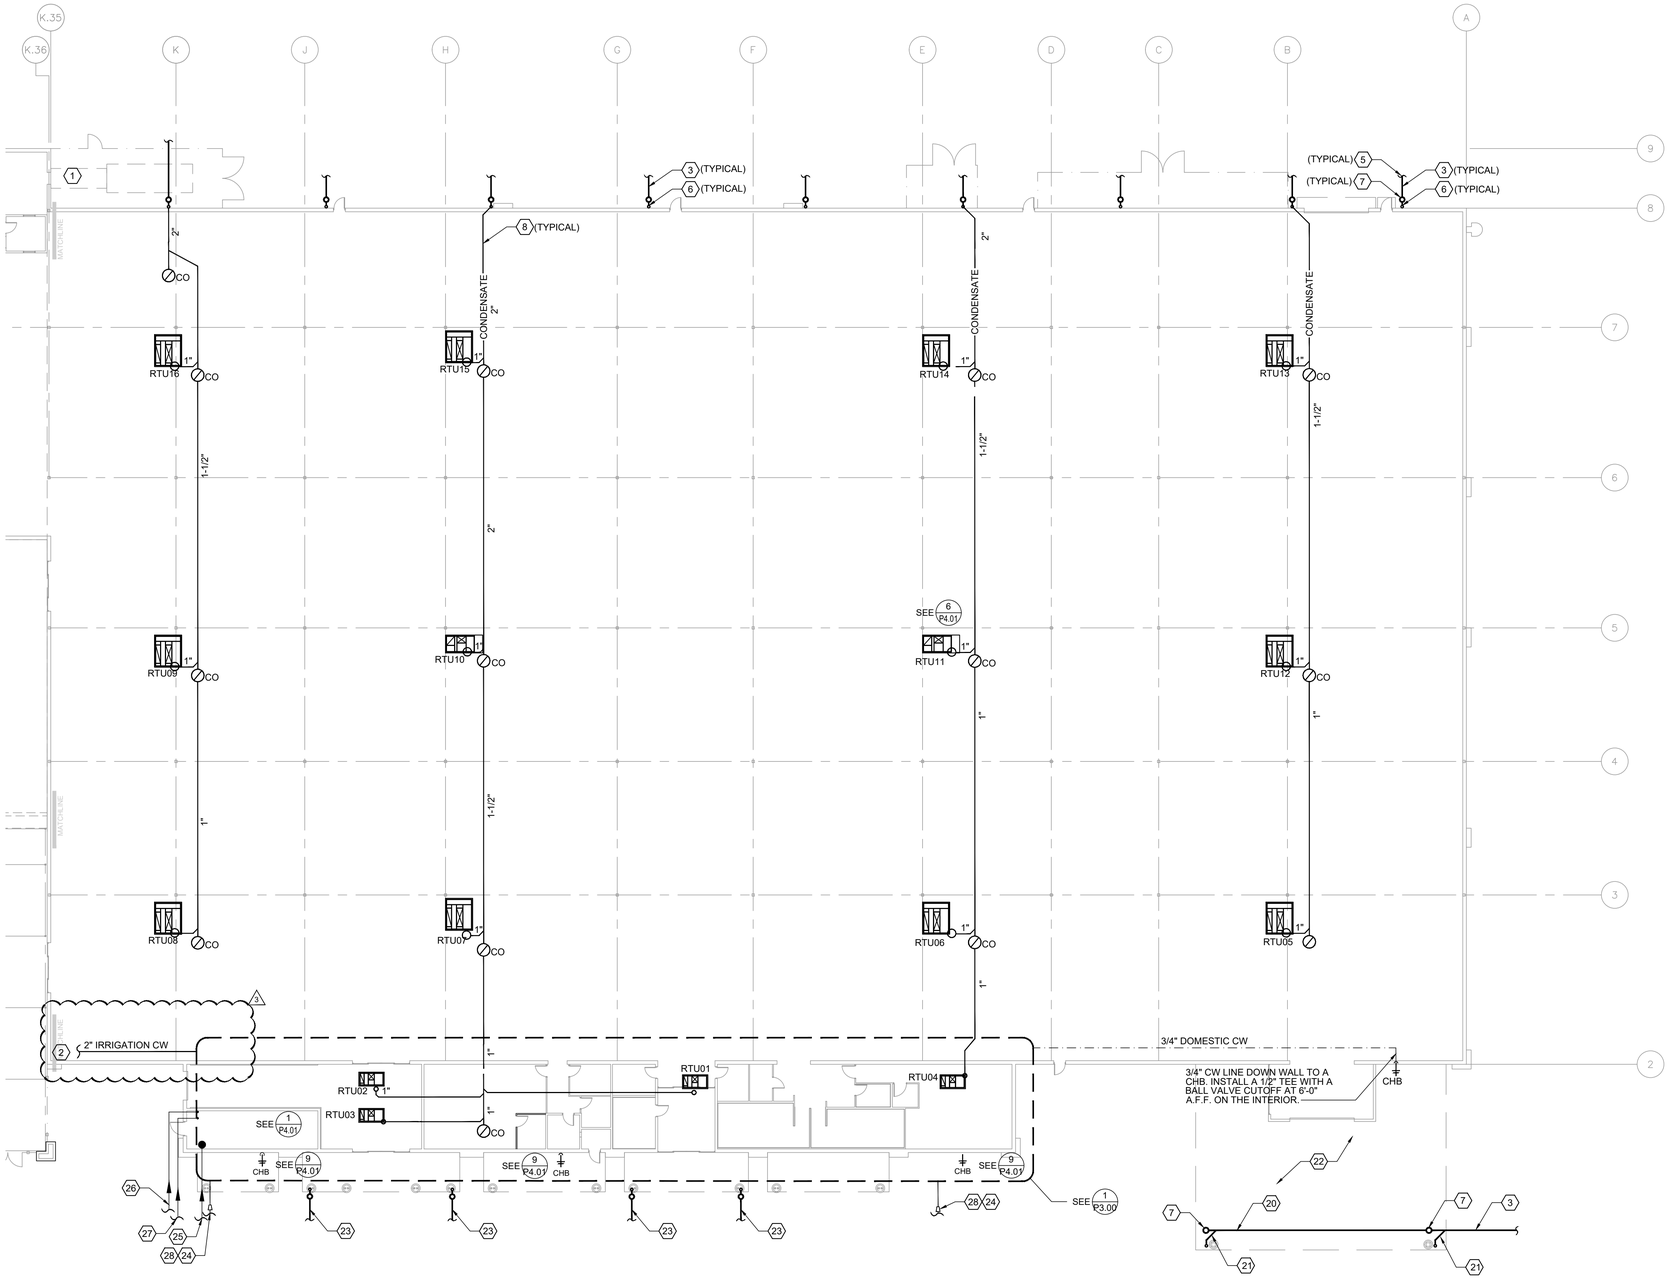


SHEET NOTES

1. SEE GENERAL NOTES ON SHEET P1.00.
2. FOR GARDEN CENTER CONTINUATION SEE SHEET P2.01.
3. COORDINATE WITH THE MECHANICAL CONTRACTOR THE EXACT LOCATION OF THE CONDENSATE PIPINGPIPING SHALL MAINTAIN A MINIMUM HORIZONTAL SLOPE IN THE DIRECTION OF DISCHARGE OF NOT LESS THAN ONE-EIGHTH UNIT VERTICAL IN 12 UNITS HORIZONTAL (1-PERCENT SLOPE). THE BRAND RTU PROVIDED MAY CAUSE THE LOCATION OF THE GAS AND/OR CONDENSATE TO BE DIFFERENT FROM WHAT IS SHOWN ON THIS SHEET.

KEYED NOTES

1. SEE P2.01 FOR TRENCH DRAIN PLUMBING.
2. SEE P2.01 FOR GARDEN CENTER PLUMBING.
3. 10" STORM DRAINAGE LINE.
4. NOT USED.
5. STORM DRAINAGE LINE SHALL BE STUBBED 5'-0" BEYOND THE BUILDING LIMITS LINE. SEE CIVIL DRAWINGS FOR CONTINUATION. BUILDING GC SHALL MAKE CONNECT TO SITE DRAINAGE LINE.
6. SEE ARCHITECTURAL DRAWINGS FOR DOWNSPOUT DETAIL.
7. DOWNSPOUT CLEAN OUT.
8. CONDENSATE PIPED TO DOWNSPOUT.
9. NOT USED.
10. NOT USED.
11. NOT USED.
12. NOT USED.
13. NOT USED..
14. AUTOMATIC TRAP PRIMER. SEE DETAIL 1-P4.01.
15. NOT USED.
16. NOT USED.
17. 2" VENT TO ROOF.
18. NOT USED.
19. NOT USED.
20. 8" STORM DRAINAGE LINE.
21. 6" STORM DRAINAGE LINE.
22. COORDINATE CLC ROOF DRAIN LOCATIONS WITH ARCHITECTURAL PLANS.
23. 4" STORM DRAINAGE LINE.
24. 4" SANITARY SEWER LINE TO BE STUBBED 5'-0" BEYOND THE BUILDING LIMITS LINE. SEE CIVIL DRAWINGS FOR CONTINUATION.
25. FIRE LINE TO BUILDING FIRE PROTECTION SYSTEM (BY OTHERS).
26. 2" DOMESTIC WATER SERVICE LINE TO BE STUBBED 5'-0" BEYOND THE BUILDING LIMITS LINE. SEE CIVIL DRAWINGS FOR CONTINUATION.
27. 2" SITE IRRIGATION WATER LINE TO BE STUBBED 5'-0" BEYOND THE BUILDING LIMITS LINE. SEE CIVIL DRAWINGS FOR CONTINUATION.
28. 4" TO 6" TRANSITION, BY PLUMBING CONTRACTOR.

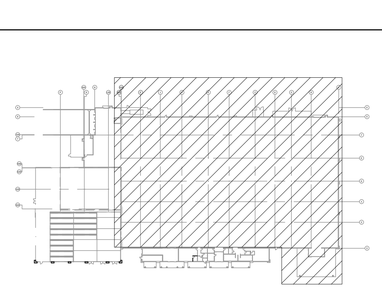

REVISIONS

DATE		DESCRIPTION
10.10.2025	1	PLAN REVIEW COMMENTS
10.07.2026	3	CRITERIA UPDATES

PRE-BID SET ISSUE DATE ◇ POST BID SET ISSUE DATE △

Ryan Crawford
Digitally signed by Ryan Crawford
DN: c=US, o=Page, ou=Interworks, cn=Ryan Crawford, 0.9.2342.19200300.100.1.1=ryan.crawford@pagethinkgo.com
Date: 2026.10.05 10:36:29-04'00'
STATE OF FLORIDA PROFESSIONAL ENGINEER
10.05.2026

PAGE
INTERWORKS, P.A.
ENGINEERS & CONSULTANTS
723 MAIN STREET, NORTH WILKESBORO, NC 28659
PHONE: 336-667-4225

LICENSE:
NCARB
REG. No. 44575
NEW JERSEY
Lic. No. 12114
NEW YORK
Lic. No. 094875-1
FLORIDA No. 44575
Lic. No. RA-0019010-B
VIRGINIA
Lic. No. 0401 011655
FLORIDA AR95159

PERRY M. PETRILLO ARCHITECTS PC
9 Park Avenue
Park Ridge, New Jersey 07656
Telephone (201) 307-6153
Facsimile (201) 307-6158

LOWE'S HOME CENTERS, LLC
1000 LOWE'S BOULEVARD
MOORESVILLE, NC 28117
704.758.1000 (PH.)

THIS DRAWING IS THE PROPERTY OF LOWE'S HOME CENTERS, LLC. ANY USE OR REPRODUCTION IN WHOLE OR PART IS PROHIBITED WITHOUT THE EXPRESSED WRITTEN CONSENT OF LOWE'S HOME CENTERS, LLC. ©COPYRIGHT 2025-2027 ALL RIGHTS RESERVED.

LOWE'S

SALES FLOOR PLUMBING PLAN AND NOTES

LOWE'S OF WESTLAKE
5683 SEMINOLE PRATT WHITNEY RD.
Westlake, Florida, 33470

PCN: 77-49-43-31-29-000-0010
PROJECT No: 24309 | DRAWN BY: JBM | CHECKED BY: RJC

CRITERIA	
ISSUE DATE:	02-2025
PERMIT SET	
ISSUE DATE:	08-22-2025
CONSTRUCTION SET	
ISSUE DATE:	04-14-2025

DRAWING NUMBER:
P2.00

ORIGINAL | SECOND | FINAL

SALES FLOOR - PLUMBING PLAN — SCALE: 1"=20'-0" — 01

KEY PLAN — SCALE: NTS