
NOTE: SEE PLUMBING SCHEDULE SHEET P1.00 FOR WASTE AND VENT FIXTURE CONNECTION SIZES.

SCHEMATIC ONLY NOTE: ALL HORIZONTAL DRAINAGE PIPING OVER 3" SHALL HAVE A MIN. 1/8" SLOPE AS REQUIRED BY IPC TABLE 704.1

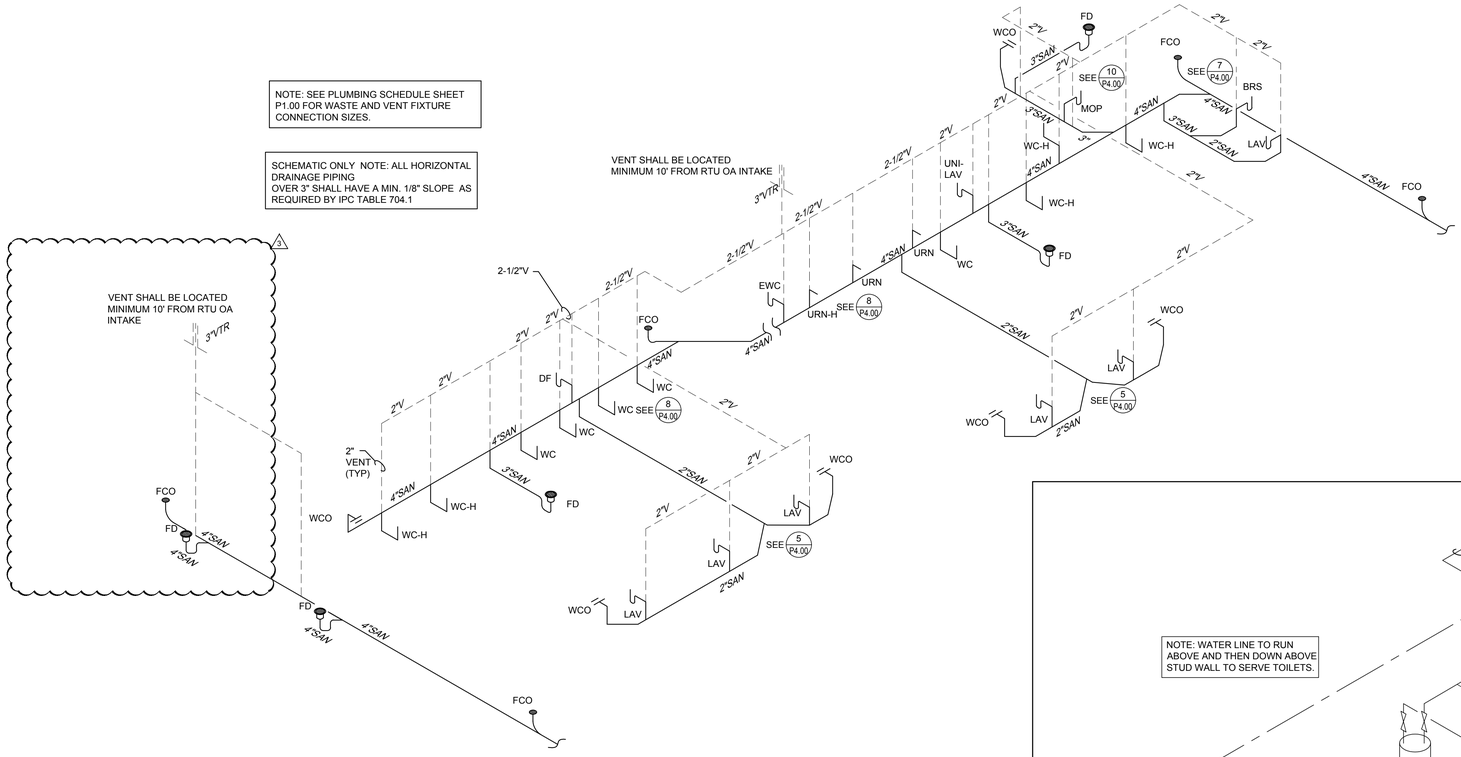


WASTE AND VENT RISER DIAGRAM

SCALE: NTS

02

NOTE: WATER LINE TO RUN ABOVE AND THEN DOWN ABOVE STUD WALL TO SERVE TOILETS.

NOTE: SEE PLUMBING SCHEDULE SHEET P1.00 FOR CW AND HW FIXTURE CONNECTION SIZES.

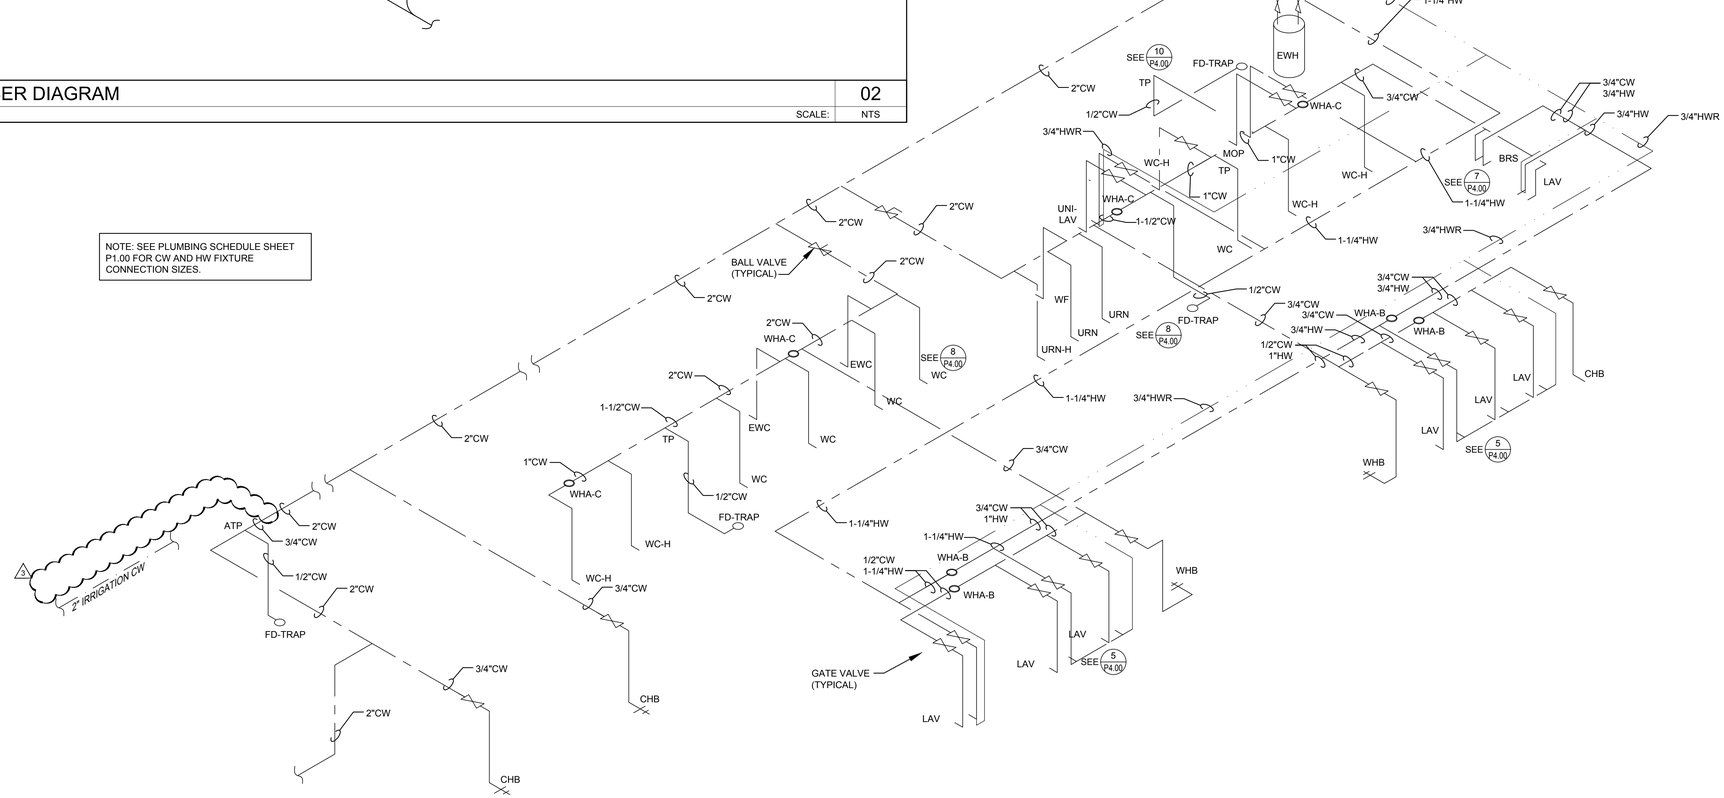

DOMESTIC WATER RISER DIAGRAM

SCALE: NTS

01

REVISIONS		
◇ PRE-BID SET ISSUE DATE		△ POST BID SET ISSUE DATE
DATE		DESCRIPTION
10.10 2025	1	PLAN REVIEW COMMENTS
10.06 2026	3	CRITERIA UPDATES

Ryan Crawford
No. 89248
STATE OF FLORIDA
PROFESSIONAL ENGINEER
10.07.2026

PAGE
INTERWORKS, P.A.
ENGINEERS & CONSULTANTS
7223 MAIN STREET, NORTH WILKESBORO, NC 28659
PHONE: 336-667-4225

LICENSE:
NCARB Cert. No. 44575
NEW JERSEY
Lic. No. 12114
NEW YORK
Lic. No. 024475-1
FLORIDA PE No. 86815
Lic. No. RA-0019010-B
VIRGINIA
Lic. No. 0401 019655
FLORIDA AR95159
Lic. No.

PERRY M. PETRILLO ARCHITECTS PC
9 Park Avenue
Park Ridge, New Jersey 07656
Telephone (201) 307-6153
Facsimile (201) 307-6158

LOWE'S HOME CENTERS, LLC
1000 LOWE'S BOULEVARD
MOORESVILLE, NC 28117
704.758.1000 (PH.)

THIS DRAWING IS THE PROPERTY OF LOWE'S HOME CENTERS, LLC. ANY USE OR REPRODUCTION IN WHOLE OR PART IS PROHIBITED WITHOUT THE EXPRESSED WRITTEN CONSENT OF LOWE'S HOME CENTERS, LLC. COPYRIGHT 2025-2027 ALL RIGHTS RESERVED

LOWE'S

PLUMBING WASTE AND WATER RISERS AND NOTES

LOWE'S OF WESTLAKE
5683 SEMINOLE PRATT WHITNEY RD.
Westlake, Florida, 33470

PCN: 77-40-43-01-29-000-0010
PROJECT No: 24209 | DRAWN BY: JBM | CHECKED BY: RJC

CRITERIA
ISSUE DATE: 02-2025
PERMIT SET
ISSUE DATE: 08-22-2025
CONSTRUCTION SET
ISSUE DATE: 04-14-2025
DRAWING NUMBER:

P3.01

ORIGINAL	
SECOND	
FINAL	