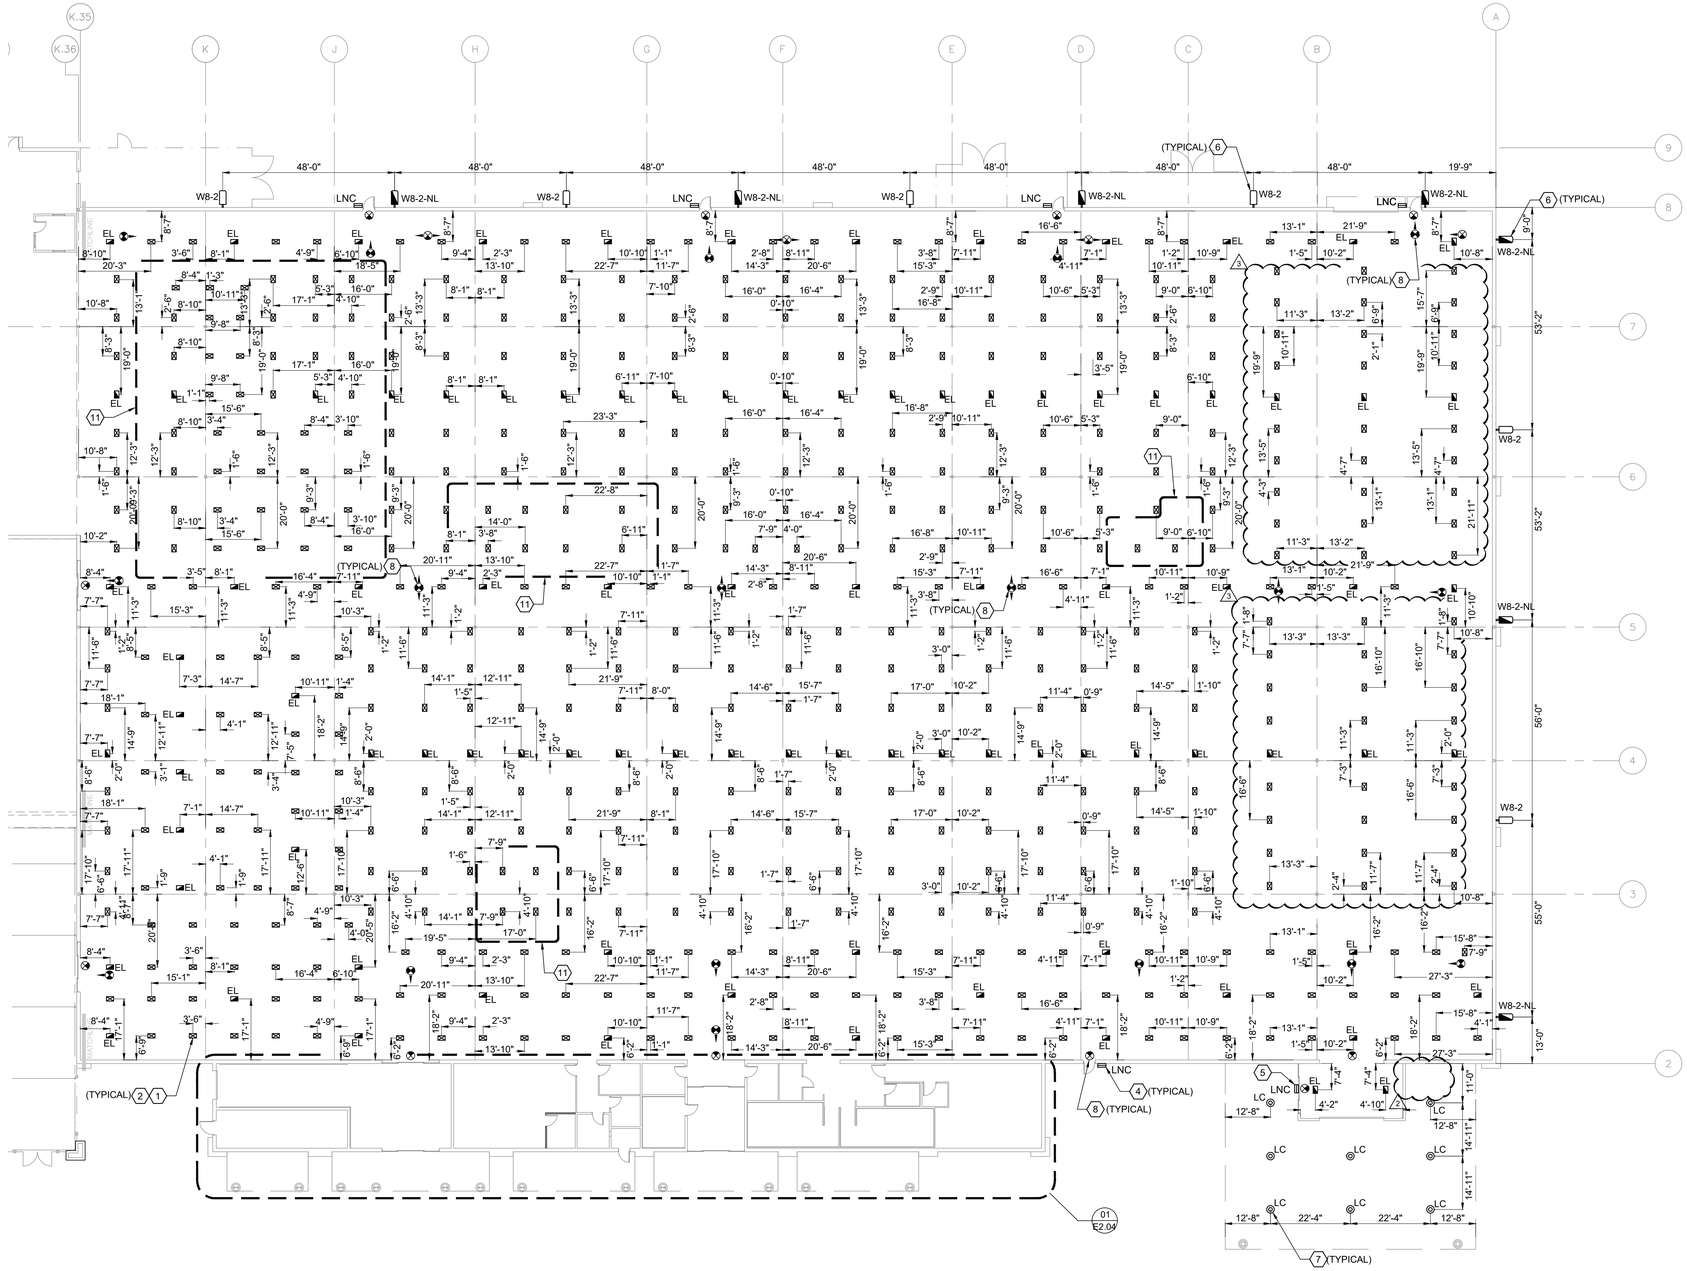

SHEET NOTES

1. SEE GENERAL NOTES ON SHEET E1.00.
2. FOR GARDEN CENTER FIXTURE LOCATION CONTINUATION SEE SHEET E2.01.
3. FOR OFFICE LIGHTING FIXTURE LOCATION PLAN SEE 1-E2.04.
4. LIGHT FIXTURES ARE DIMENSIONED SO THAT THEY WILL BE CENTERED IN THE AISLES OF THE LOWE'S RACK PLAN. EVERY EFFORT SHALL BE MADE TO INSTALL THE LIGHTS AS CLOSE TO THESE DIMENSIONS AS IS PHYSICALLY PRACTICAL. DO NOT ROTATE LIGHTS FROM ORIGINAL POSITION SHOWN WITHOUT CONSULTING WITH LOWE'S CONSTRUCTION MANAGER. FOR ALL LIGHTS SHOWN WITHOUT DIMENSIONS, INSTALL USING DIMENSIONS OF ADJACENT ROWS OF LIGHTS AND ALIGN FIXTURES AS INDICATED.
5. ONCE ALL DISPLAYS AND STORE FIXTURES ARE IN PLACE MOUNT EXIT SIGNS SUCH THAT NO POINT IN THE EXIT ACCESS IS MORE THAN 100 FEET FROM THE NEAREST VISIBLE SIGN. BACK-MOUNT FIXTURES OVER DOORS OR CHAIN MOUNT EXIT SIGNS TO 12'-0" AFF AS APPLICABLE. SEE MOUNTING DETAIL 06-E6.00.
6. THE ELECTRICAL SUBCONTRACTOR SHALL VERIFY TO THE ENGINEER OF RECORD, AFTER FINAL RACK PLACEMENT, THAT ALL PATHS OF EGRESS ARE ILLUMINATED TO A MINIMUM OF 1.0 FOOTCANDLE AT FLOOR LEVEL. THE ELECTRICAL CONTRACTOR SHALL RELOCATE OR ADD ADDITIONAL "EL" FIXTURES TO OBTAIN THE REQUIRED FOOTCANDLE LEVELS.
7. ALL LIGHTING FIXTURES AND ASSOCIATED MATERIALS SHALL BE NEW, UL LABELED, AND USED ACCORDING TO THE LISTING OF THE MATERIAL FOR THE INTENDED PURPOSE.
8. THE ELECTRICAL SUBCONTRACTOR SHALL PROVIDE LAMPS FOR ANY LIGHT FIXTURES THAT ARE NOT INCLUDED IN THE LOWE'S NATIONAL ACCOUNT LIGHTING PACKAGE AS INDICATED IN THE LIGHT FIXTURE SCHEDULE ON SHEET E1.01.
9. THE LOWE'S NATIONAL ACCOUNT LIGHTING VENDOR HAS PROVIDED A MATERIAL WARRANTY TO LOWE'S. THE ELECTRICAL SUBCONTRACTOR SHALL PROVIDE A LABOR WARRANTY FOR REPLACING ALL NON-OPERATIONAL FIXTURES AND/OR FAILED DRIVERS WITHIN 1 YEAR FOLLOWING KEY TURNOVER, AND SHALL CONTACT THE LIGHT FIXTURE VENDOR FOR THE NECESSARY PARTS OR REPLACEMENT FIXTURES.
10. ELECTRICAL CONTRACTOR SHALL PROVIDE AND INSTALL ANY AND ALL REQUIRED SLOTTED ANGLE AND/OR UNISTRUT FOR FIXTURE AND EQUIPMENT MOUNTING.

KEYED NOTES

1. ALL FIXTURES ARE TYPE 'L1' EXCEPT AS NOTED OTHERWISE IN DETAIL 01-E2.00.
2. TYPE 'L1' FIXTURES SHALL BE MOUNTED ABOVE BOTTOM CHORD OF ROOF JOISTS. SEE DETAIL 02-E6.00.
3. NOT USED.
4. TYPE 'LNC' FIXTURES AT THE EGRESS DOORS SHALL BE CENTERED 7'-4" AFF AND 18" FROM OPENING TO CENTER OF FIXTURE. (TYPICAL EXCEPT PROVISIONS WILL NEED TO BE MADE FOR AWNINGS)
5. TYPE 'LNC' FIXTURE AT THE LUMBER VESTIBULE IS CENTERED ABOVE DOOR AT ELEVATION OF 12'-0" TO CENTER OF FIXTURE.
6. TYPE 'W8-2' FIXTURES SHALL BE WALL MOUNTED AT 20'-0" ABOVE FINISHED FLOOR TO BOTTOM OF LENS. SEE DETAIL 06-E6.01 (MASONRY WALL MOUNTING) AND 05-E6.01 (STEEL COLUMN MOUNTING).
7. TYPE 'LC' FIXTURES SHALL BE MOUNTED ON A 4" SQUARE JUNCTION BOX SECURED TO UNI-STRUT WHICH IS MOUNTED TO LUMBER CANOPY JOISTS. SEE DETAIL 05-E6.03.
8. EXIT SIGNS SHALL BE WALL MOUNTED AT 6" ABOVE TOP OF DOOR HEADER TO BOTTOM OF FIXTURE OR SUSPENDED WITH CHAINS WHEN LOCATED AWAY FROM WALLS. SEE DETAIL 06-E6.00.
9. NOT USED.
10. NOT USED.
11. ADDITIONAL ACCENT LIGHTING SHALL BE INSTALLED IN THESE AREAS UNDER SEPARATE CONTRACT.

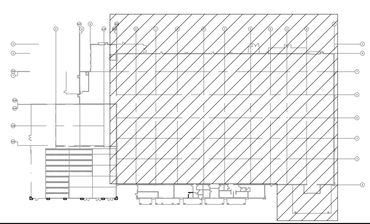

REVISIONS

◇ PRE-BID SET ISSUE DATE	△ POST BID SET ISSUE DATE	DATE	DESCRIPTION
	1	10.10.2025	PLAN REVIEW COMMENTS
	2	10.31.2025	CITY REVIEW COMMENTS
	3	10.07.2026	CRITERIA UPDATES

Carl Page
Digitally signed by Carl Page
DN: C=US, E=cpage@page-pmi.com, O=Carl Page, CN=Carl Page
Reason: I am the author of this document
Date: 2026.03.05 10:40:53-05'00'

PROFESSIONAL ENGINEER
No. 0050265
STATE OF FLORIDA
10.05.2026

PAGE
INTERWORKS, P.A.
ENGINEERS & CONSULTANTS
7223 MAIN STREET, NORTH WILKESBORO, NC 28659
PHONE: 336-667-4225

LICENSE:
NCARB 44575
NEW JERSEY
Lic. No. 12114
NEW YORK
Lic. No. 0224575-1
FLORIDA
Lic. No. RA-0019010-B
VIRGINIA
Lic. No. 0401 019655
FLORIDA AR95169
Lic. No.

PERRY M. PETRILLO ARCHITECTS PC
9 Park Avenue
Park Ridge, New Jersey 07656
Telephone (201) 307-6153
Facsimile (201) 307-6158

LOWE'S HOME CENTERS, LLC
1000 LOWE'S BOULEVARD
MOORESVILLE, NC 28117
704.758.1000 (PH.)

THIS DRAWING IS THE PROPERTY OF LOWE'S HOME CENTERS, LLC. ANY USE OR REPRODUCTION IN WHOLE OR PART IS PROHIBITED WITHOUT THE EXPRESSED WRITTEN CONSENT OF LOWE'S HOME CENTERS, LLC. ©COPYRIGHT 2025-2027 ALL RIGHTS RESERVED

LOWE'S

SALES FLOOR LIGHTING
FIXTURE PLAN AND NOTES

LOWE'S OF WESTLAKE
5683 SEMINOLE PRATT WHITNEY RD.
Westlake, Florida, 33470

PCN: 77-45-43-01-28-000.0010
PROJECT No: 24209 DRAWN BY: JBM CHECKED BY: CARP

CRITERIA	
ISSUE DATE:	02-2025
PERMIT SET	
ISSUE DATE:	08-22-2025
CONSTRUCTION SET	
ISSUE DATE:	04-14-2025

DRAWING NUMBER:
E2.00

FINAL | SECOND | ORIGINAL

SALES FLOOR - LIGHTING FIXTURE LOCATION PLAN — 01 — SCALE: 1"=20'-0"

KEY PLAN — SCALE: NTS